

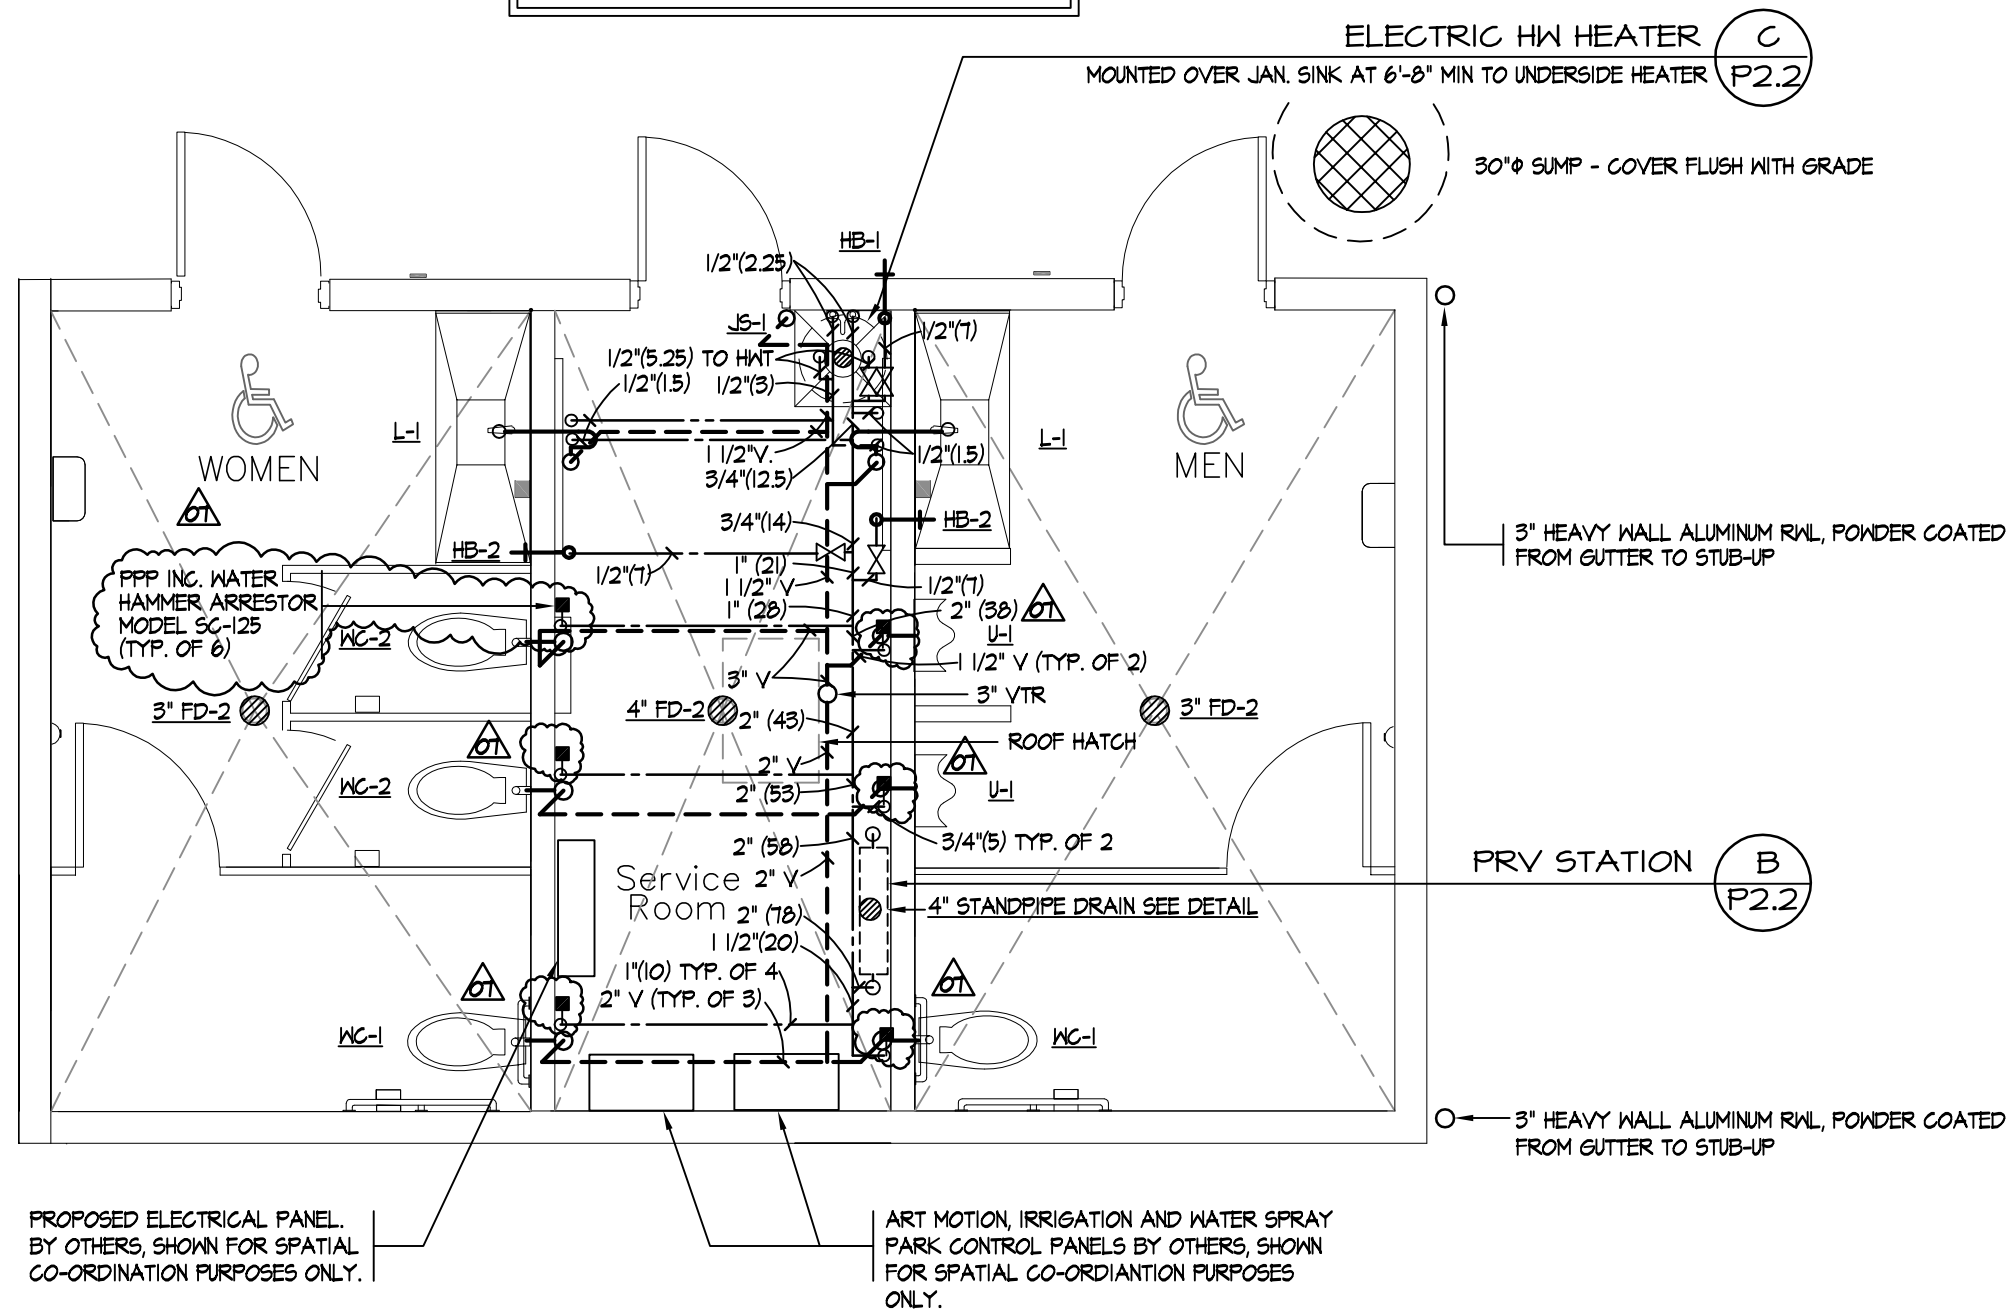


NOTE:  
 1) ALL PLUMBING PIPING SHALL BE COORDINATED WITH ALL OTHER EQUIPMENT AND DUCTWORK TO AVOID CONFLICTS PRIOR TO INSTALLATION.  
 2) MAINTAIN 6'-8" CLEAR HEADROOM IN MECHANICAL ROOM BELOW ALL PIPING ETC. DO NOT BLOCK ROOF ACCESS HATCH.

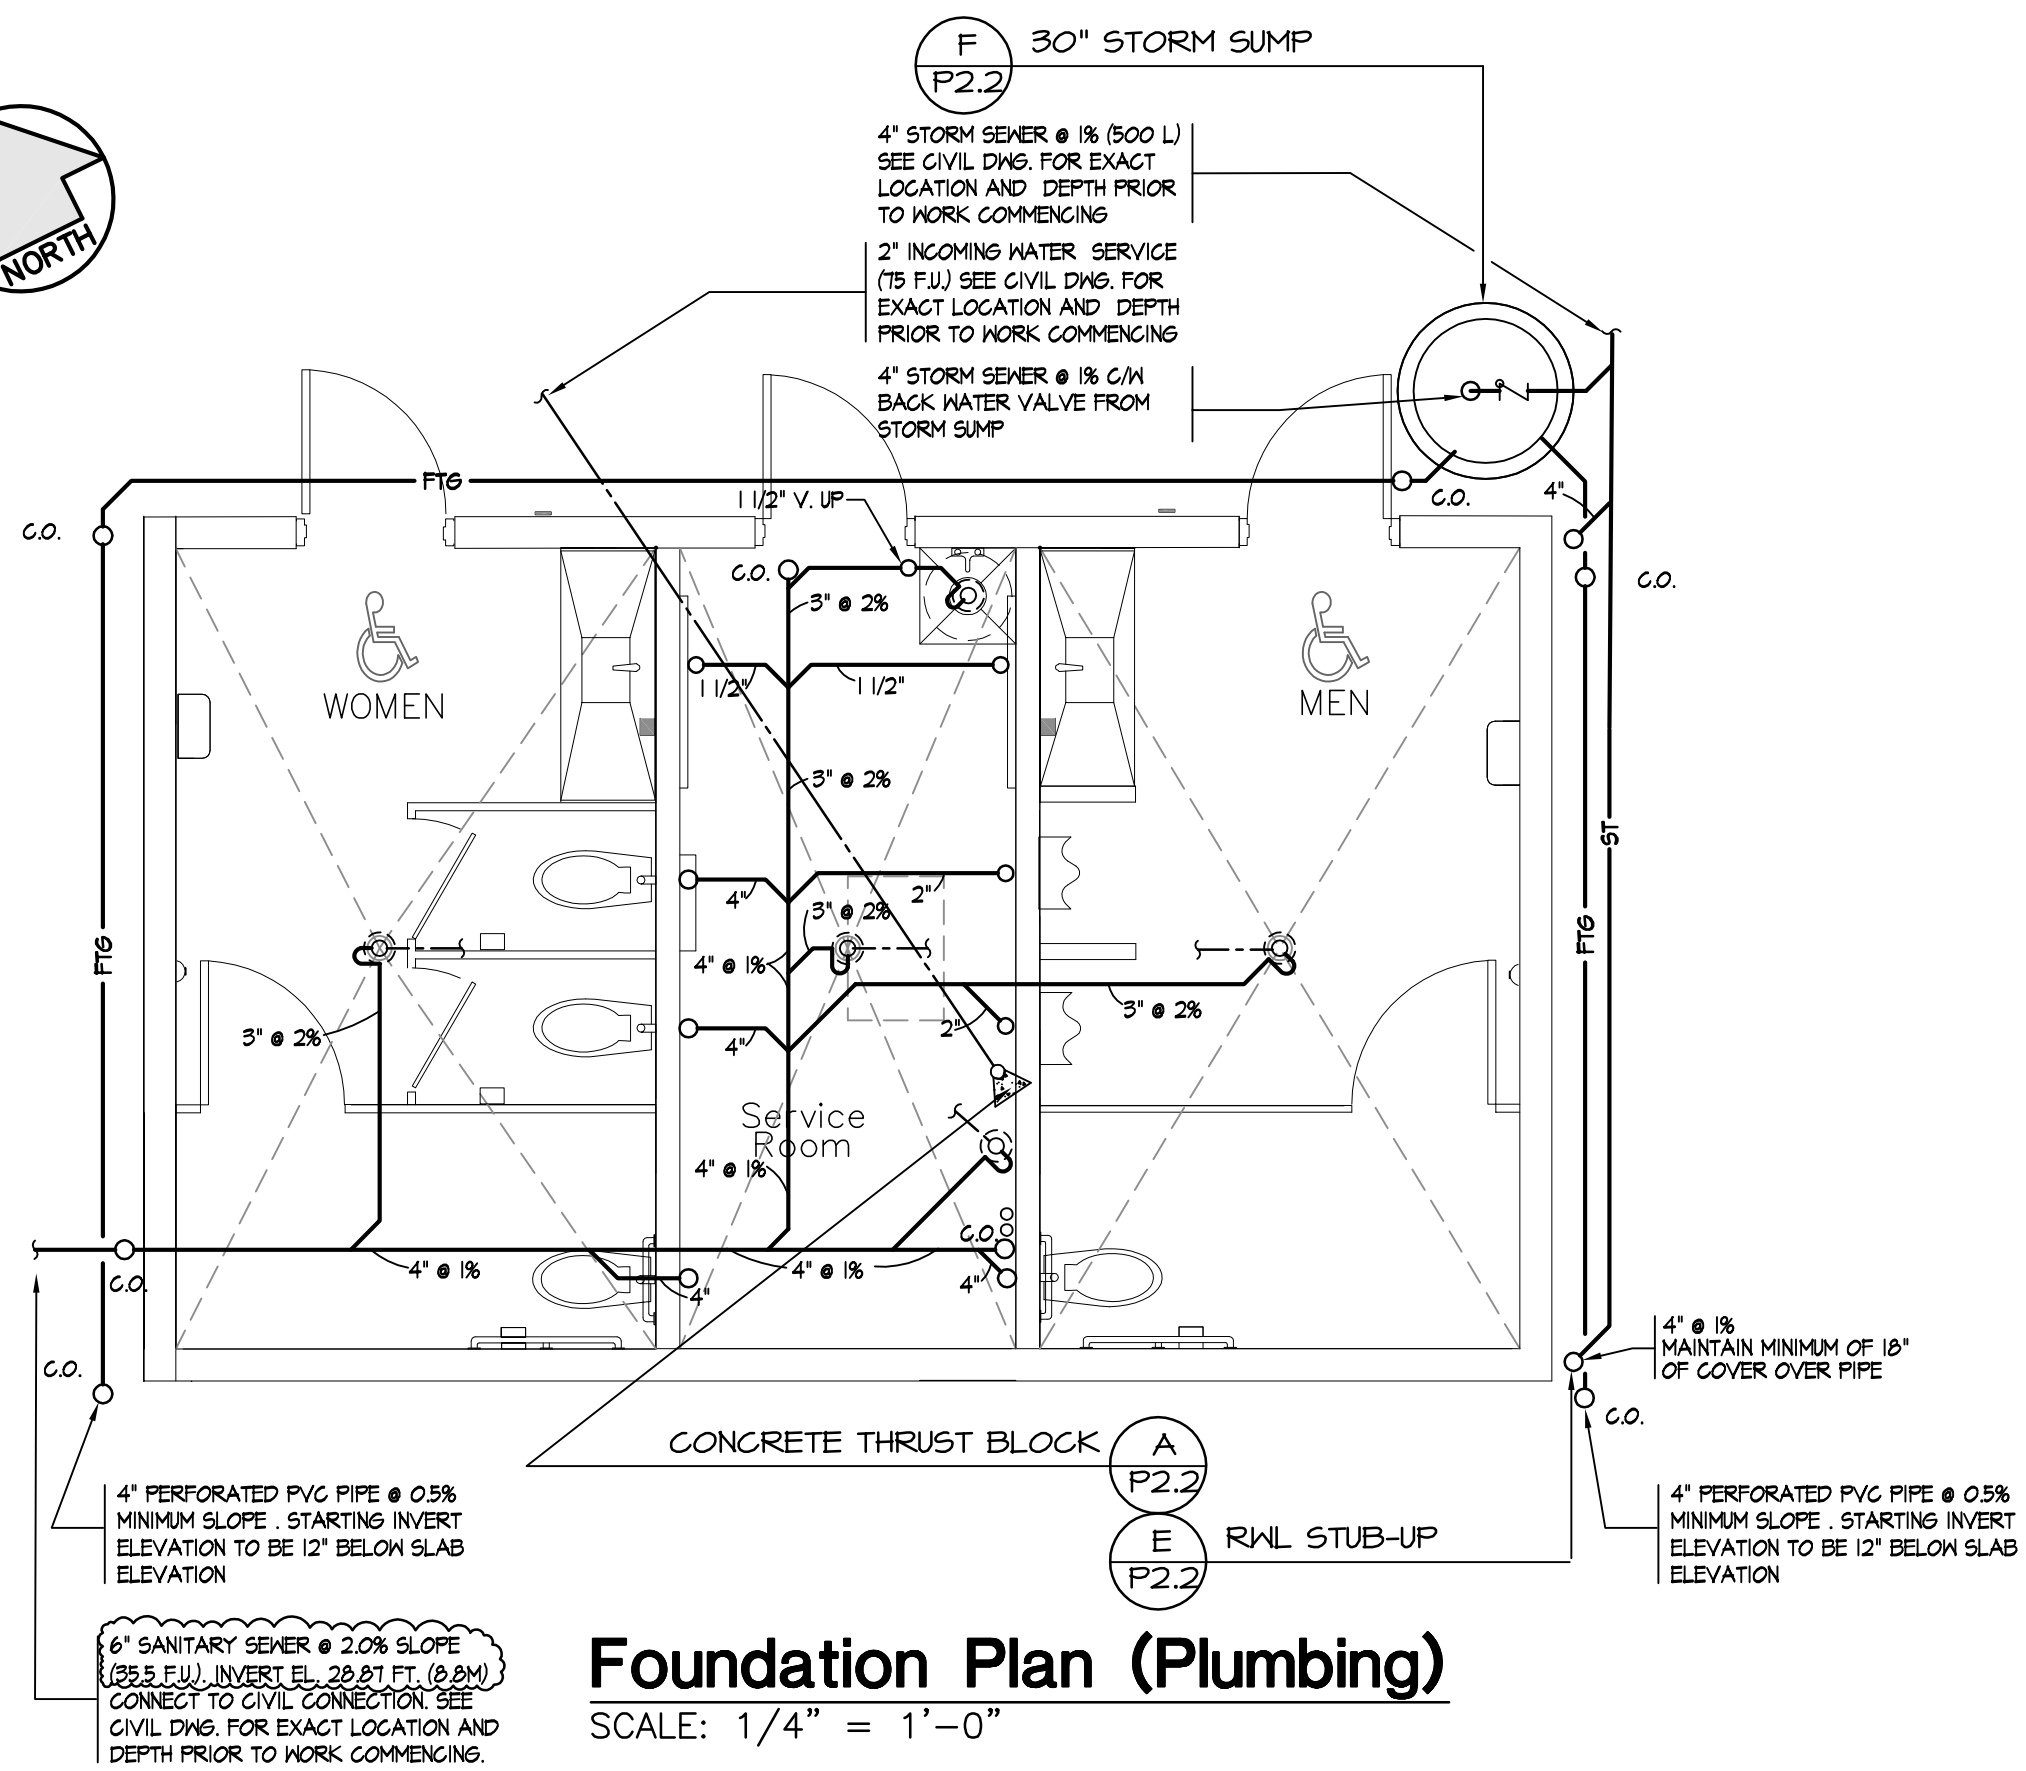

**Floor Plan (Plumbing)**  
 SCALE: 1/4" = 1'-0"


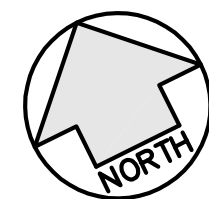


**Foundation Plan (Plumbing)**  
 SCALE: 1/4" = 1'-0"

LEGEND	
	GRILLE REGISTER AND DIFFUSER DESIGNATOR
	EQUIPMENT UNIT TAG
	CEILING DIFFUSER
	CEILING RETURN GRILLE
	EXHAUST AIR UP
	RETURN AIR UP
	SUPPLY AIR UP
	EXHAUST AIR DOWN
	RETURN AIR DOWN
	SUPPLY AIR DOWN
	BALANCING DAMPER
	HORIZONTAL FIRE DAMPER
	BACKDRAFT DAMPER
	ACOUSTICALLY LINED DUCT
	FLEXIBLE DUCT CONNECTOR
	SQUARE ELBOW WITH TURNING VANES
	FLEXIBLE DUCT
	THERMOSTAT
	REMOTE TEMPERATURE SENSOR
	AIR PRESSURE SENSOR
	DOOR GRILLE
	UNDERCUT DOOR
	ACCESS PANEL

**GENERAL NOTES:**

- VISIT THE SITE PRIOR TO TENDERING AND EXAMINE ALL LOCAL AND EXISTING CONDITIONS ON WHICH WORK IS DEPENDENT. NO CONSIDERATION WILL BE GRANTED FOR FAILURE TO VISIT THE SITE OR FOR ANY RESULTING MISUNDERSTANDING OF WORK TO BE DONE.
- DRAWINGS ARE DIAGRAMATIC AND ARE INTENDED TO INDICATE THE SCOPE AND GENERAL ARRANGEMENT OF WORK. DO NOT SCALE THE DRAWINGS. TAKE FIELD MEASUREMENTS WHERE EQUIPMENT AND MATERIAL ARE DEPENDENT UPON BUILDING DIMENSION.
- CONTRACTOR TO MAKE GOOD ANY DAMAGE TO PROPERTIES THAT OCCURS AS A RESULT OF THE WORK BEING DONE IN THIS CONTRACT.
- CONTRACTOR SHALL RETURN REVISED AREA BACK TO ORIGINAL CONDITION AND/OR TO THE DIRECTION AND SATISFACTION OF THE ENGINEER AND THE ARCHITECT, INCLUDING ALL CONCRETE RESURFACING, PAINTING, PATCHING ETC. ALL COSTS TO BE INCLUDED IN BASE TENDER QUOTE.
- LOCATION OF ALL EXISTING EQUIPMENT, DUCTWORK, PIPING, SENSORS, THERMOSTATS, AND OTHER ACCESSORIES AS SHOWN ON THESE DRAWINGS ARE FOR REFERENCE ONLY. THE CONTRACTOR SHALL CONFIRM THE ACTUAL LOCATION ON SITE.
- CONTRACTOR SHALL BALANCE THE EXISTING SUPPLY AIR DIFFUSERS TO THE CFM AS SHOWN ON DRAWING AND AS PER SPECIFICATION.
- ALL CEILING DIFFUSERS BEHIND DRY HALL CEILING SHALL BE COMPLETE WITH OPPOSED BLADE DAMPERS FOR BALANCING.
- NOTIFY ENGINEER IMMEDIATELY FOR INSTRUCTION IF ASBESTOS MATERIAL ARE ENCOUNTERED IN EXISTING STRUCTURE UPON WHICH WORK IS BEING DONE.
- PROVIDE SEPARATED COST FOR SUPPLY & INSTALLATION OF FIRE DAMPERS.

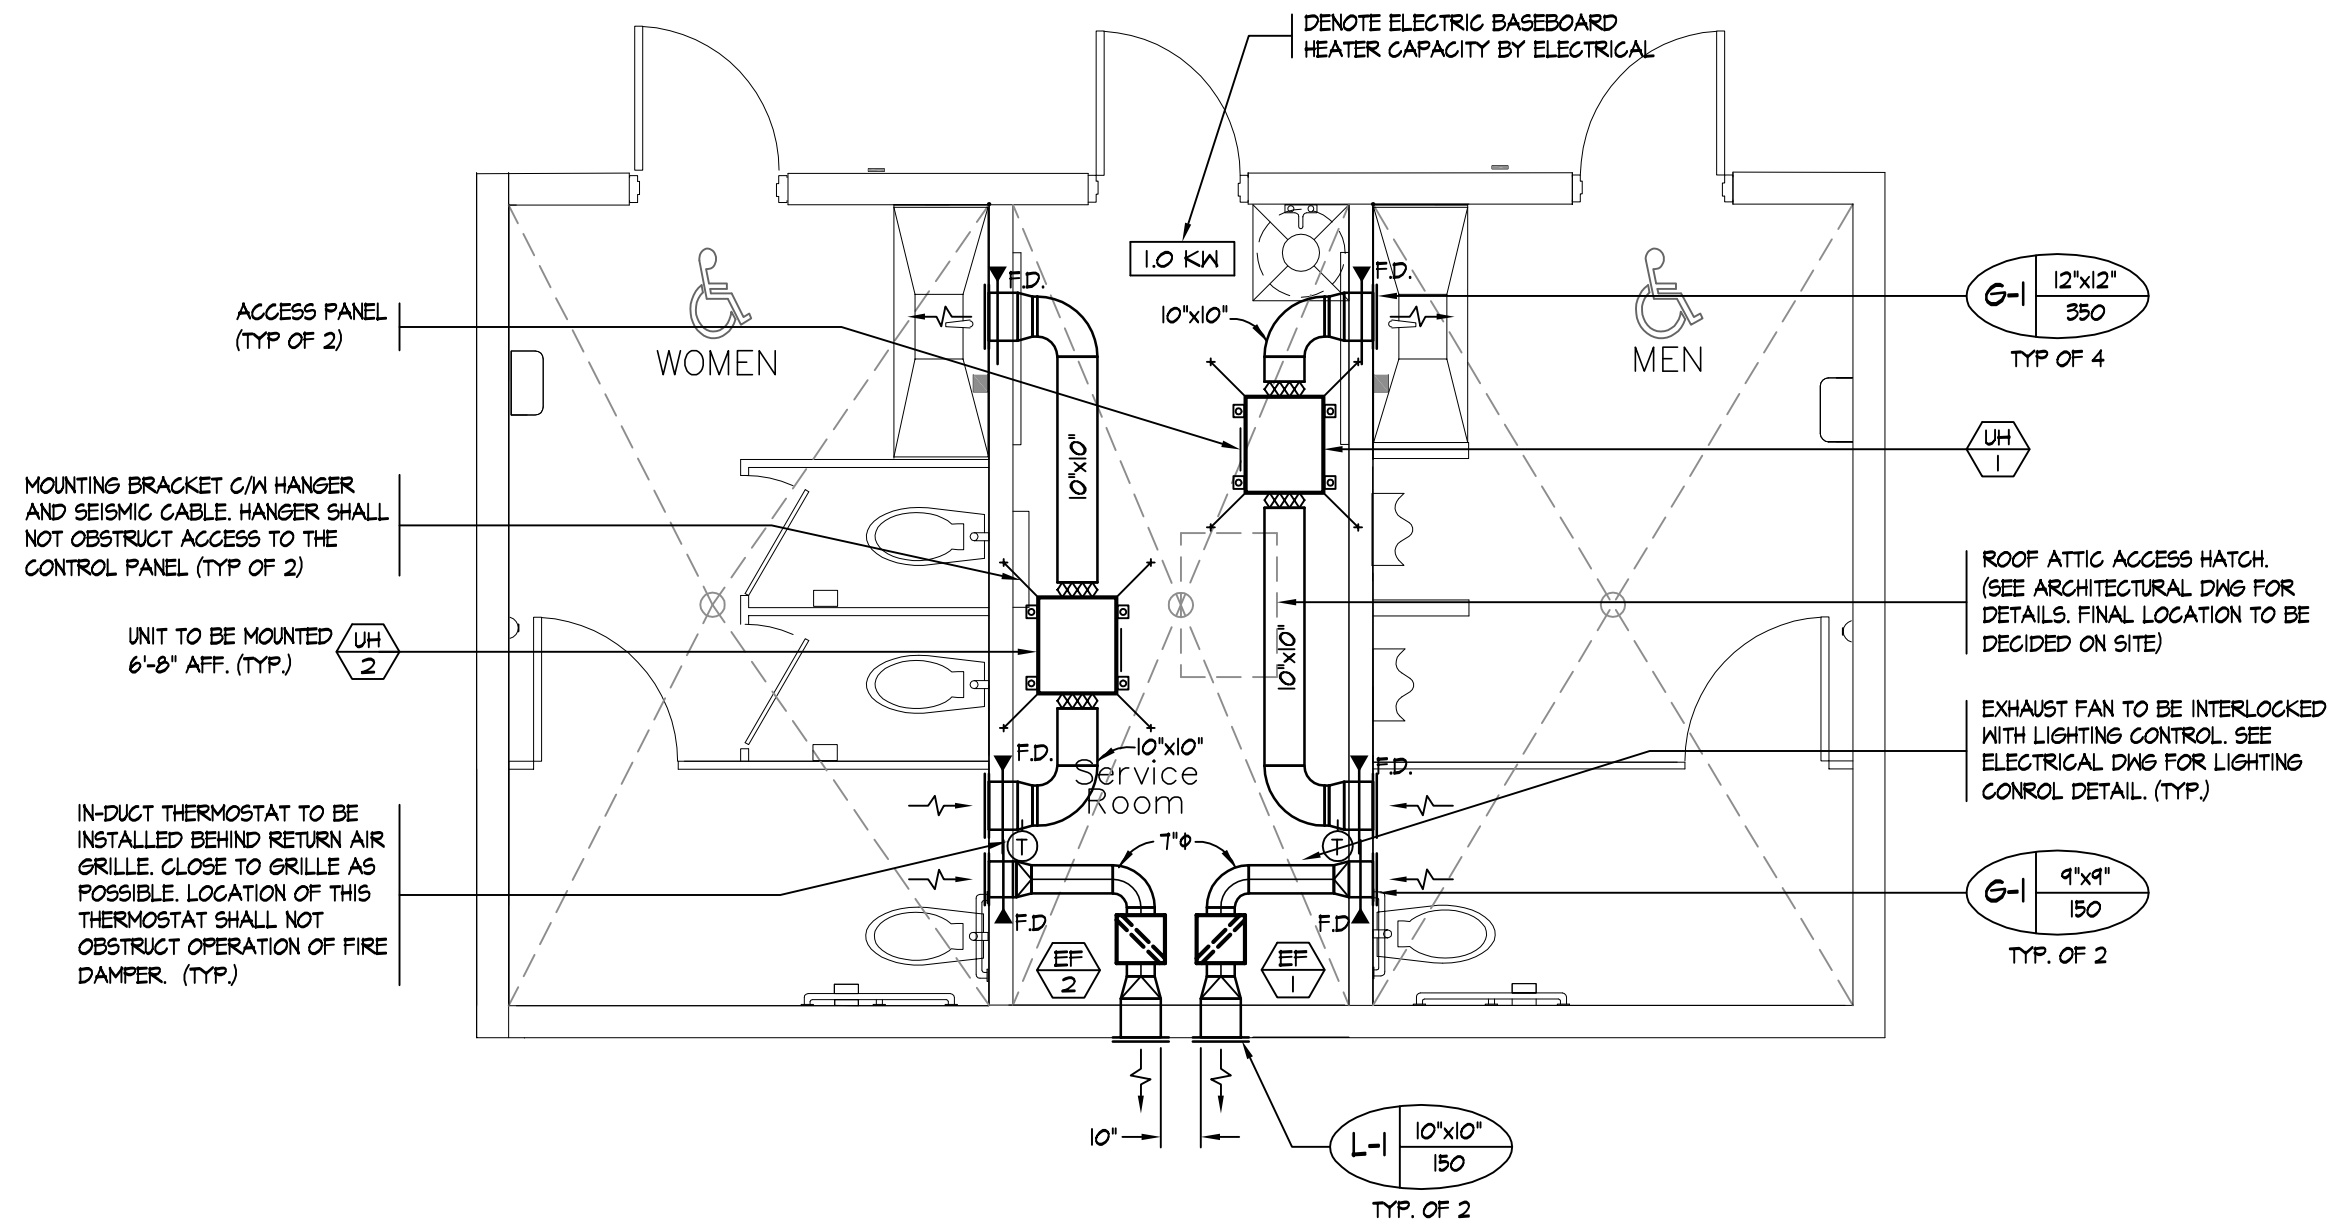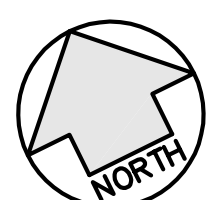

**Floor Plan (HVAC)**  
 SCALE: 1/4" = 1'-0"

**General Notes**

No.	Revision/Issue	Date
08	Re-Issued for Building Permit Deletion of Drinking Fountain	12/08/30
07	Re-Issued for Building Permit Add Water Hammer Arresters	12/07/17
06	Re-Issued for Building Permit	12/07/03
05	Issued for Tender	12/06/28
04	Issued for Review	12/06/22
03	Issued for Building Permit	12/04/10
02	Re-Issued for Review	12/03/26
01	Issued for Review	12/03/07
No.	Revision/Issue	Date

**Mechanical Name and Address**

**DEC**  
 engineering sustainability  
 DEC ENGINEERING  
 308-713 COLUMBIA STREET,  
 NEW WESTMINSTER, B.C. CANADA V3M 1B2  
 TEL: 604-525-3341  
 ENGINEERING@SUSTAINABILITY.COM

**Architect Name and Address**

Forum Projects Ltd.  
 Box 32120  
 Walnut Grove P.O.  
 Langley B.C. V1M-3S7  
 604-888-6672(o)  
 604-888-7857(f)

**Sheet Name and Discipline**

**FLOOR PLAN  
 -PLUMBING & HVAC**

**Project Name and Address**

**Mackin Park  
 Washroom Building  
 Coquitlam B.C.**

Project D12-006

Date 2012-02-17

Scale AS NOTED

Sheet

**P1.1**

PLUMBING SPECIFICATIONS:

1. GENERAL CONDITIONS
  - 1.1 The general conditions for the project shall apply to this sub-trade.
  - 1.2 Contractors shall familiarize themselves with site conditions prior to submitting bids. Claims for extras due to site conditions will not be accepted.
  - 1.3 At start of construction, verify the layout of facilities. Inform the Engineer of any conflicts between the design and the existing conditions prior to starting installation. Be responsible for any corrective action required due to failure to report the conflicts in a timely manner.
  - 1.4 Provide functioning systems that are complete in every detail and installed in accordance with good practice.
2. SERVICE CONNECTIONS
  - 2.1 The locations and sizes of buried services as shown on the drawings are based on the available information. No guaranty is provided by the engineer as to the accuracy of this information and the contractor must verify such accuracy prior to commencing work.
  - 2.2 If there are existing service connections, excavate and confirm the location and invert elevation of existing storm and sanitary connections at property line prior to work commencing.
  - 2.3 If the connections are found to be unsuitable (insufficient size or unacceptable invert) plumbing contractor shall inform the engineer. Be responsible for any corrective action required due to failure to verify or report the unsuitability in a timely manner.
3. SCOPE OF WORK:
  - 3.1 Install a complete sanitary drainage system complete from all plumbing fixtures and floor drains to the existing sanitary drain and vent as indicated on the plumbing drawings.
  - 3.2 Install a complete domestic water distribution system including hot, hot cold water lines as indicated on the plumbing drawings.
4. CODES AND PERMITS:
  - 4.1 Comply with all applicable codes, obtain all necessary approvals and pay for all necessary permits prior to commencement of work.
  - 4.2 Plumbing and drainage systems to be installed as per approved drawings and in accordance with the B.C. Plumbing Code, B.C. Building Code (latest editions and amendments) and local authority's requirements.
  - 4.3 All materials and equipment shall have prior approval for the application by the authorities having jurisdiction, e.g. Canadian Standards Association (C.S.A.)
5. TESTING:
  - 5.1 Drainage piping: test under 3.0m (10 feet) standing head.
  - 5.2 Water piping: pressure test at 200 psi with pressure held steady for 2 hours, with no significant pressure drop. Alternate tests as called for by plumbing inspector.
6. INSPECTIONS AND APPROVALS:
  - 6.1 All work and materials will be subject to inspection from time to time by the engineer and the authority having jurisdiction. Inform the engineer 48 hours in advance of any tests or covering burying or concealment of services to allow for inspection. Do not cover, bury or conceal services without the engineer's approval.
  - 6.2 Do not change any material, equipment or construction method from what is shown on the drawings and specification without the approval of the engineer. Any changes made without the engineer's authorisation may result in the work not being accepted and/or delay in issuance of the final letter of assurance.
  - 6.3 The documents indicate the minimum standards to be applied to the work. Any approval of, or agreement to, a lower standard, by any person or authority will not necessarily be approved by the engineer and may result in the work not being accepted and/or delay in issuance of the final letter of assurance.
7. SUBMITTALS:
  - 7.1 Prior to commencement of work, submit at least 6 copies of complete shop drawings (spec book) on all specified or approved equal materials to be used. Allow 5 working days for DEC Design to review.
  - 7.2 The contractor shall be responsible for delays caused by any required resubmission of shop drawings.
  - 7.3 The engineer's review is for general compliance with the intent of the contract documents and will not relieve the contractor from responsibility for correctness of performance, function, details and dimensions.
  - 7.4 Where alternate equipment has been submitted the contractor bears responsibility for any redesign and construction required to accommodate the equipment.
8. MAINTENANCE MANUALS:
  - 8.1 At completion of construction, submit to engineer 3 sets of maintenance information covering the operation and maintenance of plumbing systems. Incorporate with the HVAC maintenance information in a suitable 3 ring binder.
  - 8.2 Manuals shall include: copies of all permits, test reports, final inspection certificates and approvals; copies of all shop drawings; operating instructions for all equipment; maintenance schedules for all equipment; copies of all warranties; names and addresses of contractors and suppliers.
9. AS BUILT DRAWINGS:
  - 9.1 Obtain from the engineer extra sets of drawings on which to mark, as the work progresses, any changes and deviations in runs of piping, risers or equipment locations from that shown. These drawings shall be kept on site and available for review at all times.
  - 9.2 When the installation is complete, submit the complete marked-up as-builts to DEC Design Mechanical Consultants Ltd. Drawings shall be clean and legible with an acceptable standard of drafting and each sheet shall bear the contractors name and be identified as as-built. Provide a letter certifying that these drawings accurately reflect the building as-built.
10. GUARANTIES:
  - 10.1 Provide a written guaranty of all material, workmanship and system performance for a period of(1) year after final acceptance. And replace forthwith any defective work during this period.
  - 10.2 Such guaranty shall not override any specific guaranties provided or requested of longer duration.
11. CO-OPERATION WITH OTHER TRADES:
  - 11.1 Give full co-operation to other sub-trades and furnish any information necessary to permit the work of all subtrades to be installed satisfactorily and with the least possible interference or delay.
  - 11.2 Install all equipment, piping and ductwork to obtain ceiling heights specified or shown on the architectural drawings. In case of conflict, notify the engineer before fabricating and installing any item referred to above. Carry out any required adjustment

12. PIPING MATERIALS
  - 12.1 The following piping material shall be used unless otherwise specified on the drawings or approved by the engineer.
 

SERVICE	MATERIAL
Sanitary drainage above slab on grade	Cast iron with mechanical joints, CSA-B70
Sanitary drainage below slab on grade and to property line	ABS DWV grade or PVC DWV schedule 40, CSA-B181.1 and B181.2
Domestic hot and cold water branch lines up to 2" in size inside building	iPEX Aquarise CPVC pipe and fittings to CSA B137.6
Domestic cold water service line 2" in size outside & under building	Polyethylene pipe and fittings to Series 160 CSA B137.1

 Note: Connection between PE pipe and Aquarise CPVC shall be with approved fittings.
13. INSTALLATION
  - 13.1 Provide chrome plated escutcheon plates wherever plumbing lines penetrate a finished wall. Holes larger than the escutcheon shall be patched with the finish material.
  - 13.2 Provide shut off valves and accessories in accessible locations to each appliance, piece of equipment, fixture group or fixture. Provide valves in accordance with codes and where shown on the drawings.
  - 13.3 Identify each piping system with stick on decals to indicate service and direction of flow.
  - 13.4 Do not run water pipes in outside walls without protection from freezing to the engineer's approval.
  - 13.5 Co-ordinate with general contractor locations and sizes of required plumbing chases and any additional bracing between studs for wall hung fixtures.
  - 13.6 Co-ordinate with general contractor any required cutting of structure to facilitate passage of pipes.
14. CLEANOUTS:
  - 14.1 Cleanouts shall be installed on all interior sanitary drainage piping in accordance with local plumbing codes.
  - 14.2 Cleanouts shall be full size for pipes of 4" diameter and less, and 4" size for all larger pipes.
  - 14.3 Cleanouts in sidewalks, concrete or paved areas for outside drainage piping and footing drains to be extended to surface in Cast Iron Pipe with pipe anchored in 12" x 12" x 6" collar of concrete.
  - 14.4 Where cleanouts must be installed in finished floors use appropriate cleanout covers.
15. ACCESS DOORS/PANELS:
  - 15.1 Provide access to all concealed mechanical equipment for operation, maintenance, calibration and adjustment, including: valves, solenoid valves, mixing valves, unions, and cleanouts.
  - 15.2 Access doors/panels for cleanouts shall be 8" x 8" (200 x 200 mm) minimum. All other access doors/panels shall be a minimum of 12" x 12" (300 x 300 mm). Where full body or head and shoulders access is required, doors/panels shall be 24" x 24" (610 x 610 mm).
  - 15.3 Access doors/panels to have primer finish except for ceramic tiled areas where access door shall be stainless steel. Access doors shall have lock and key.
  - 15.4 Access doors/panels required in fire partitions and similar fire rated structures shall be U.L.C. Approved fire doors/panels, suitable for the structure in which they are to be located. Access doors/panels shall be as manufactured by Acudor or approved equal.
16. FIRE STOP:
  - 16.1 Material penetrations through the structure (mechanical room walls) shall be sized to allow 12mm (1/2") clearance between the pipe and the structure.
  - 16.2 Pipes passing through fire rated ceilings shall have the 12mm (1/2") space between the pipe and the structure caulked with UL approved high temperature insulation cement to avoid to avoid sound, smoke and dust transmission.
  - 16.3 All redundant unused holes are to be firestopped.
  - 16.4 Provide 1 hour F rated fire stop assemblies through rated walls and ceiling. This work shall be undertaken by qualified trades people only.
17. INSULATION:
  - 17.1 All insulation work shall be in strict accordance with B.C.I.C.A. standards and the 2006 b.c. building code and be carried out by an experienced firm with an established reputation in this field, and to the satisfaction of the architect/engineer.
  - 17.2 All hot water domestic water piping to be insulated with 1" fibreglass insulation with vapour barrier. All cold water domestic water piping to be with 1/2" fibreglass insulation with vapour barrier. Seal all joints.
  - 17.3 Insulation to be as manufactured by manson insulation or knauf industries. one piece moulded insulation with self sealing adhesive. all fittings to be complete with one piece pre moulded high impact pvc fitting covers.
18. DISINFECTION & FLUSHING:
  - 18.1 At the end of the rough-in stage of the project, flush all domestic water piping within the building and disinfect in accordance with AWWA C651 and be carried out by an experienced firm with an established reputation in this field, and to the satisfaction of the architect/engineer.
  - 18.2 Retain 25mg/L of chlorine solution in pipe for a period of 24 hours. Pay for and submit results to independent labatory and have test results forwarded to architect/engineer for review.
  - 18.3 After chlorination test are approved, flush chlorinated water from system, until concentration in remaining water is less than 0.3 mg/L chlorine residual.

19. PLUMBING FIXTURES:
    - 19.1 SUPPLY AND INSTALL THE FOLLOWING FIXTURES IN LOCATIONS INDICATED ON THE DRAWINGS, COMPLETE WITH SUPPLIES, HANGERS, AND ALL ACCESSORIES REQUIRED FOR A COMPLETE INSTALLATION. TOGGLE BOLTS, EXPANSION ANCHORS, OR SIMILAR FASTENERS SHALL BE USED FOR SECURING FIXTURES TO CONCRETE AND CONCRETE BLOCK WALLS. IN FRAME WALLS, INSTALL 50X150MM (2"X6") BRACING BETWEEN STUDS TO ACT AS SUPPORT FOR WALL HUNG FIXTURES. EACH FIXTURE SHALL BE INSTALLED COMPLETE WITH CHROME PLATED ANGLE STOPS, FLEXIBLE SUPPLIES AND ESCUTCHEONS. PIPING, ACCESSORIES ARE TO BE CONCEALED IN STAINLESS STEEL ACCESS PANELS WHEREVER POSSIBLE TO REDUCE THE CHANCE OF VANDALISM.
- ALL FIXTURE COLOUR TO BE WHITE.

- L-1 LAVATORY- BARRIER FREE- (LAVATORY IS CUSTOM UNIT, SEE ARCHITECT DRAWING FOR DESIGN & SPECIFICATION)
 

SEE ARCHITECTURAL DRAWING FOR CUSTOM LAVATORY SPECIFICATION.  
TOTO MODEL TEL5G510#CP AUTOMATIC INFRARED SENSOR ACTIVATED FAUCET WITH TH559EDV908 1.0 GPM LAMINAR FLOW NOZZLE AND TN71V1005 4" CC COVER PLATE. ANTI-SCALD, THERMAL MIXING CHAMBER, AUTOMATIC SENSOR ADJUSTMENT ON INSTALLATION. MAXIMUM DISCHARGE 0.17 GALLONS PER 10 SECOND CYCLE. THERMOSTATIC MIXING VALVE, CONTROLLER AND ELECTRONIC CONTROLS ARE MOUNTED IN MECHANICAL ROOM BEHIND LAVATORY. MAXIMUM TEMPERATURE IS 104 DEGREES FAHRENHEIT. PROVIDE TECK 337260 C.P. CAST BRASS LAVATORY WASTE AND 337311 P-TRAP. TECK 4772312 SUPPLIES AND STOPS. P-TRAP TO BE LOCATED IN MECHANICAL ROOM BEHIND LAVATORY.
- WC-1 WATER CLOSET - CONCEALED FLUSH VALVE - BARRIER FREE
 

ACORN MODEL 2100-W-1-ULF-FVBO-CN-HS-OFWC ADJUST MOUNTING HEIGHT TO CBC 2006 REQUIREMENTS FOR BARRIER FREE DESIGN USING UNISTRUTS AND RODS AND BOLTS, STAINLESS STEEL ELONGATED BLOWOUT JET TYPE BOWL, LOW CONSUMPTION 6 LPF (1.6 GPF), 1-1/2" BACK SPUD WITH PUNCH OUT FOR SEAT, BOLT CAPS, FOR USE WITH CONCEALED FLUSH VALVE.

CENTOCO MODEL AM500STSCC TOILET SEAT, ELONGATED HEAVY DUTY ANTI-MICROBIAL SOLID PLASTIC OPEN FRONT LESS COVER, WITH REINFORCED STAINLESS STEEL CHECK HINGE, POSTS, WASHERS AND NUTS.

TOTO MODEL TET3GN31#SS AUTOMATIC INFRARED SENSOR ACTIVATED, CONCEALED FLUSH VALVE UNIT, 1.6 LPF, HEAVY DUTY 4"x4" COVER PLATE WITH STAINLESS STEEL SATIN FINISH AND VANDAL RESISTANT MOUNTING SCREWS. PISTON VALVE WITH SS SELF-CLEANING SCREEN AND SELF CLEANING SOLENOID. AUTOMATIC FLUSH EVERY 24 HOURS IF NOT USED. ELECTRICAL SENSOR SEPARATED FROM VALVE AND SEALED IN WATERPROOF COMPARTMENT. MANUAL OVERRIDE BUTTON INCORPORATED.
- WC-2 WATER CLOSET - CONCEALED FLUSH VALVE - REGULAR
 

ACORN MODEL 2100-W-1-ULF-FVBO-CN-HS-OFWC ADJUST MOUNTING HEIGHT TO MANUFACTURE'S RECOMMENDATIONS USING UNISTRUTS AND RODS AND BOLTS, STAINLESS STEEL ELONGATED BLOWOUT JET TYPE BOWL, LOW CONSUMPTION 6 LPF (1.6 GPF), 1-1/2" BACK SPUD WITH PUNCH OUT FOR SEAT, BOLT CAPS, FOR USE WITH CONCEALED FLUSH VALVE.

CENTOCO MODEL AM500STSCC TOILET SEAT, ELONGATED HEAVY DUTY ANTI-MICROBIAL SOLID PLASTIC OPEN FRONT LESS COVER, WITH REINFORCED STAINLESS STEEL CHECK HINGE, POSTS, WASHERS AND NUTS.

TOTO MODEL TET3GN31#SS AUTOMATIC INFRARED SENSOR ACTIVATED, CONCEALED FLUSH VALVE UNIT, 1.6 LPF, HEAVY DUTY 4"x4" COVER PLATE WITH STAINLESS STEEL SATIN FINISH AND VANDAL RESISTANT MOUNTING SCREWS. PISTON VALVE WITH SS SELF-CLEANING SCREEN AND SELF CLEANING SOLENOID. AUTOMATIC FLUSH EVERY 24 HOURS IF NOT USED. ELECTRICAL SENSOR SEPARATED FROM VALVE AND SEALED IN WATERPROOF COMPARTMENT. MANUAL OVERRIDE BUTTON INCORPORATED.
- U-1 URINAL - CONCEALED FLUSH VALVE- BARRIER FREE
 

KINDRED MODEL CPMX538 URINAL, WALL HUNG FOR CONCEALED FLUSH VALVE, 18 GAUGE T304 STAINLESS STEEL COMPLETE WITH WASTE FITTING, FLEXIBLE HOSE, FLOW REGULATOR, DOWELS, BACK PLATE, URINAL ADAPTER, FLOWMETER ADAPTER, COUPLINGS AND STAINLESS STEEL SCREWS. 0.5 GPF. PROVIDE P-TRAP. MOUNTING HEIGHT TO CBC 2006 REQUIREMENTS FOR BARRIER FREE DESIGN.

TOTO MODEL TEU3LN11#SS AUTOMATIC INFRARED SENSOR ACTIVATED CONCEALED FLUSH VALVE UNIT, 0.5 GPF, HEAVY DUTY 4"x4" COVER PLATE WITH STAINLESS STEEL SATIN FINISH AND VANDAL RESISTANT MOUNTING SCREWS. PISTON VALVE WITH SS SELF-CLEANING SCREEN AND SELF CLEANING SOLENOID. AUTOMATIC FLUSH EVERY 24 HOURS IF NOT USED. ELECTRICAL SENSOR SEPARATED FROM VALVE AND SEALED IN WATERPROOF COMPARTMENT. MANUAL OVERRIDE BUTTON INCORPORATED.
- JS-1 MOP SINK
 

FIAT MODEL MSB 2424 (24X24") MOLDED STONE SERVICE SINK 10" DEEP, COMPLETE WITH STRAINER, 3" CAST IRON P-TRAP  
TECK NO. 2872313 WALL MOUNTED FAUCET COMPLETE WITH TOP BRACE, DOUBLE CHECK VACUUM BREAKER, INTEGRAL STOPS, HOSE FITTING AND 36" LENGTH OF RUBBER HOSE.
- FD-1 AREA FLOOR DRAIN -
 

WATTS FD-200-E-1 EPOXY COATED CAST IRON DRAIN BODY WITH 6" NICKEL BRONZE STRAINER WITH TRAP SEAL PRIMER
- HB-1 WALL HYDRANT -
 

ZURN Z-1300 NON-FREEZE ENCASED ECOCLOTOL ANTI-SIPHON AUTOMATIC DRAINING WALL HYDRANT FOR FLUSH INSTALLATION, INTEGRAL BACKFLOW PREVENTER, BRONZE CASING, ALL BRONZE INTERIOR PARTS, NICKEL BRONZE BOX AND HINGED COVER WITH OPERATING KEY LOCK.
- HB-2 HOSE BIBB -
 

NIBCO 763-CL-LS-VB 3/4" THREAD SILL COCK WITH LOCK SHIELD AND C750 VACUUM BREAKER
- TSP TRAP SEAL PRIMER -
 

PPP MODEL P1-500 PRIME VALVE WITH INTEGRAL VACUUM BREAKER AND DU-4 DISTRIBUTION UNIT AND ISOLATION VALVE. MOUNT 12" MINIMUM ABOVE FLOOR
- HWT ELECTRIC HOT WATER - SUSPENDED
 

WATER HEATER TO BE RHEEN MODEL REG ELECTRIC  
HOT WATER TANK FOR EACH UNIT, 6 USGAL CAPACITY, 1.5 KW, 120/1/60. TANK SHALL BE C/W TEMPERATURE AND PRESSURE RELIEF VALVE, VACUUM RELIEF VALVE AND THERMOMETER. TANK SHALL BE CSA APPROVED AND HAVE A MINIMUM 1-YEAR WARRANTY. INSTALLATION SHALL BE IN ACCORDANCE WITH BC BUILDING CODE 2006.
- WHA WATER HAMMER ARRESTOR -
 

ZURN Z-1700 SERIES BELLOW TYPR TO SUITE SERVICE  
INSTALL ONE AT EACH CONNECTION TO FLUSH VALVE UNITS

General Notes

No.	Revision/Issue	Date
08	Re-Issued for Building Permit Deletion of Drinking Fountain	12/08/30
07	Re-Issued for Building Permit Add Water Hammer Arresters	12/07/17
06	Re-Issued for Building Permit	12/07/03
05	Issued for Tender	12/06/28
04	Issued for Review	12/06/22
03	Issued for Building Permit	12/04/10
02	Re-Issued for Review	12/03/26
01	Issued for Review	12/03/07

Mechanical Name and Address

**DEC**  
engineering sustainability

DEC ENGINEERING  
309-713 COLUMBIA STREET,  
NEW WESTMINSTER, B.C. CANADA V3M 1B2  
TEL: 604 525-3341  
ENGINEERING@SUSTAINABILITY.COM

Architect Name and Address

Forum Projects Ltd.  
Box 32120  
Walnut Grove P.O.  
Langley B.C. V1M-3S7  
604-888-6672(o)  
604-888-7857(f)


Sheet Name and Discipline

**SPECIFICATION**  
**-PLUMBING**

Project Name and Address

**Mackin Park**  
**Washroom Building**  
**Coquitlam B.C.**

Project	D12-006	Sheet	<b>P2.1</b>
Date	2012-02-17		
Scale	AS NOTED		

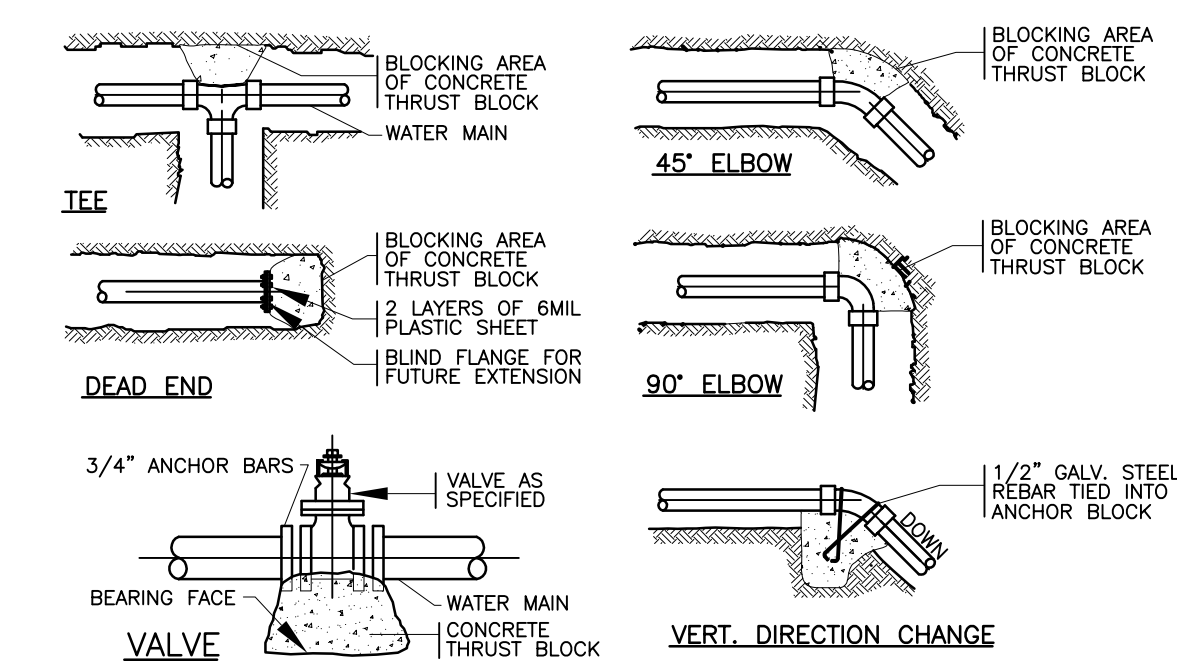


BLOCKING AREA REQUIRED (ft<sup>2</sup>) FOR A SOIL OF 1000 lbs/ft<sup>3</sup> (SAND) OF ALLOWABLE BEARING PRESSURE

SIZE OF PIPE	TEES			BENDS		
	90°	45°	22 1/2°	90°	45°	22 1/2°
4"	2.6	3.6	2.2	2.2	1.5	1.5
6"	5.8	8	4.6	4.6	3	3
8"	10.2	14.4	8.2	8.2	4.5	4.5
10"	15.8	22.4	12.6	12.6	6	6
12"	22.6	32	18.2	18.2	9	9


MAXIMUM WATER PRESSURE: 200 PSI

NOTES:  
 - PLACE CONCRETE AGAINST UNDISTURBED GROUND. KEEP CONCRETE CLEAR OF FITTINGS AND JOINTS.  
 - PROTECT PIPES AND FITTINGS FROM DIRECT CONTACT WITH CONCRETE.  
 - NUTS, BOLTS AND TIE RODS SHALL BE ANTI CORROSIVE MATERIAL.


**A** P.I.I. **THRUST BLOCK DETAIL** N.T.S.

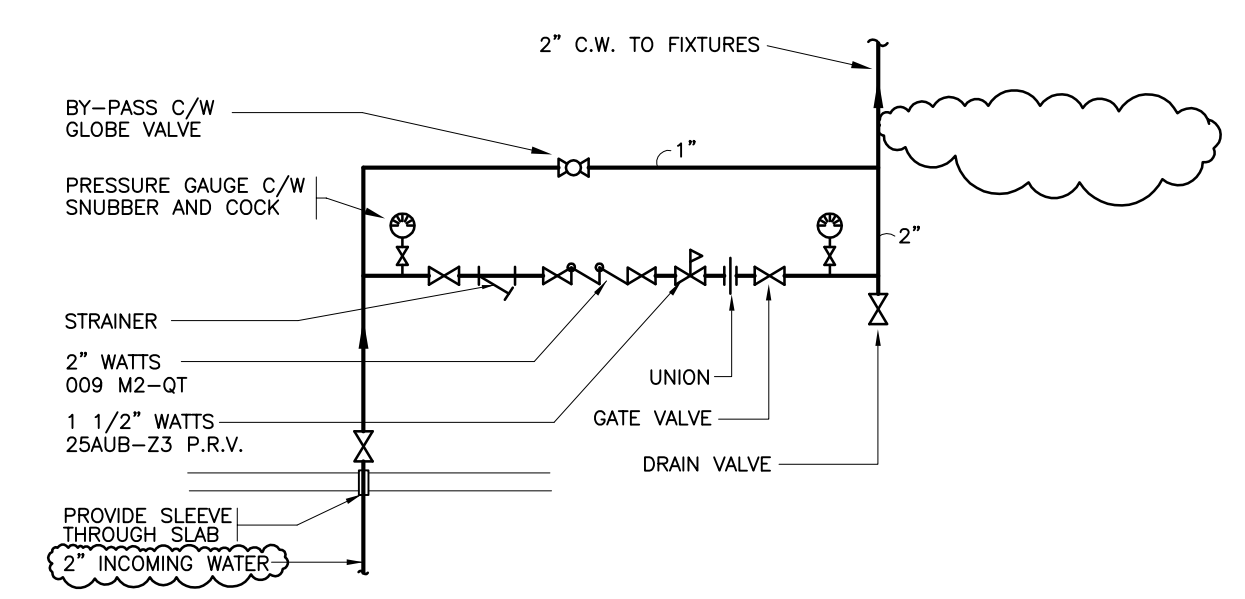

**B** P.I.I. **P.R.V. STATION DETAIL** N.T.S.

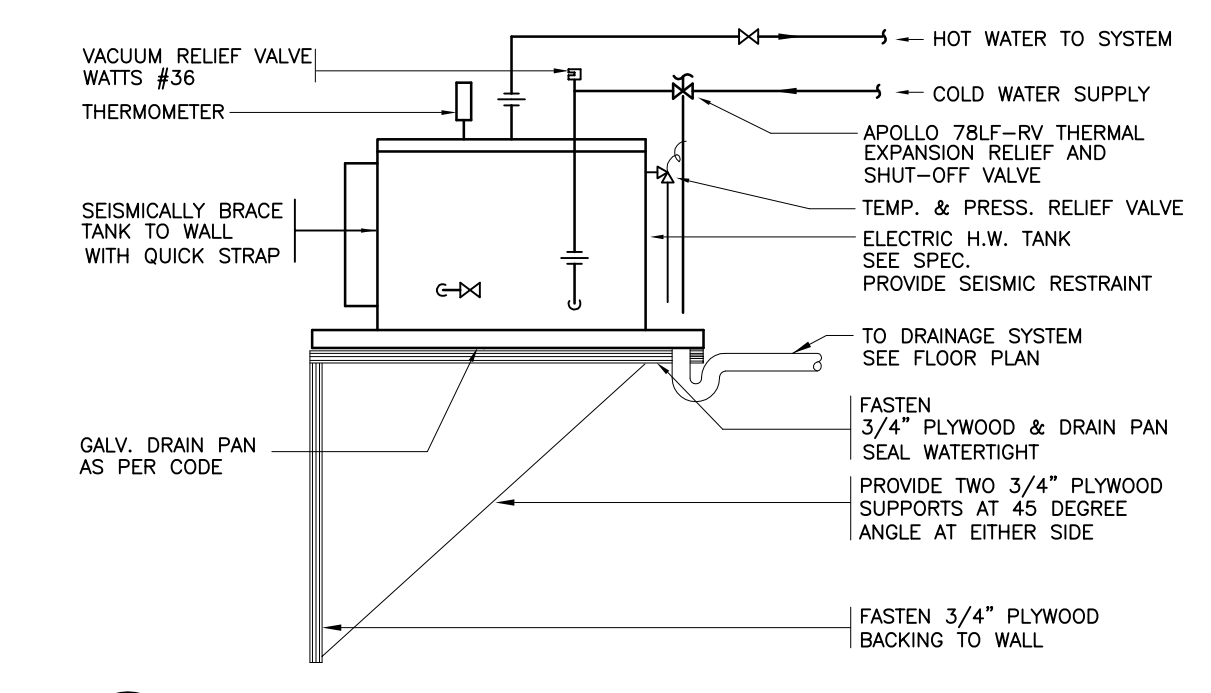


**C** P.I.I. **HOT WATER TANK DETAIL** N.T.S.

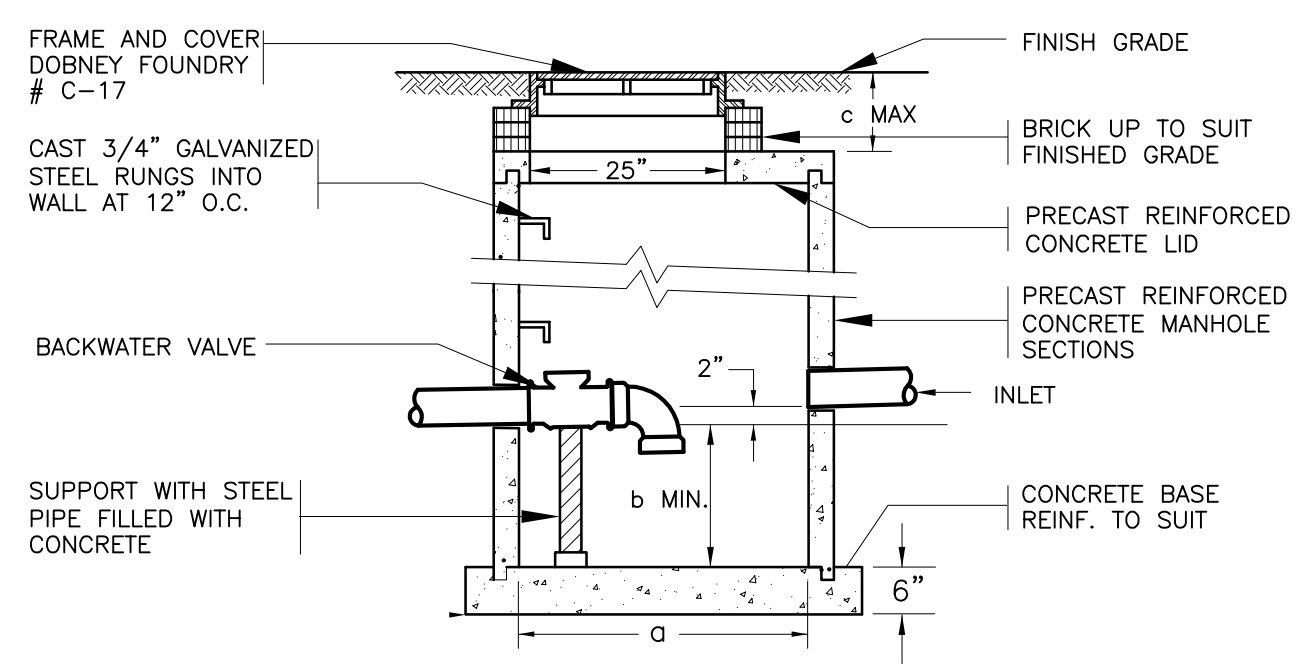


BWV SIZE	a	b	c	BWV SIZE	a	b	c
4"	30"	17"	12"	10"	48"	30"	18"
6"	36"	18"	12"	12"	54"	30"	18"
8"	42"	24"	12"	15"	72"	36"	18"

**F** P.I.I. **STORM SUMP DETAIL** N.T.S.

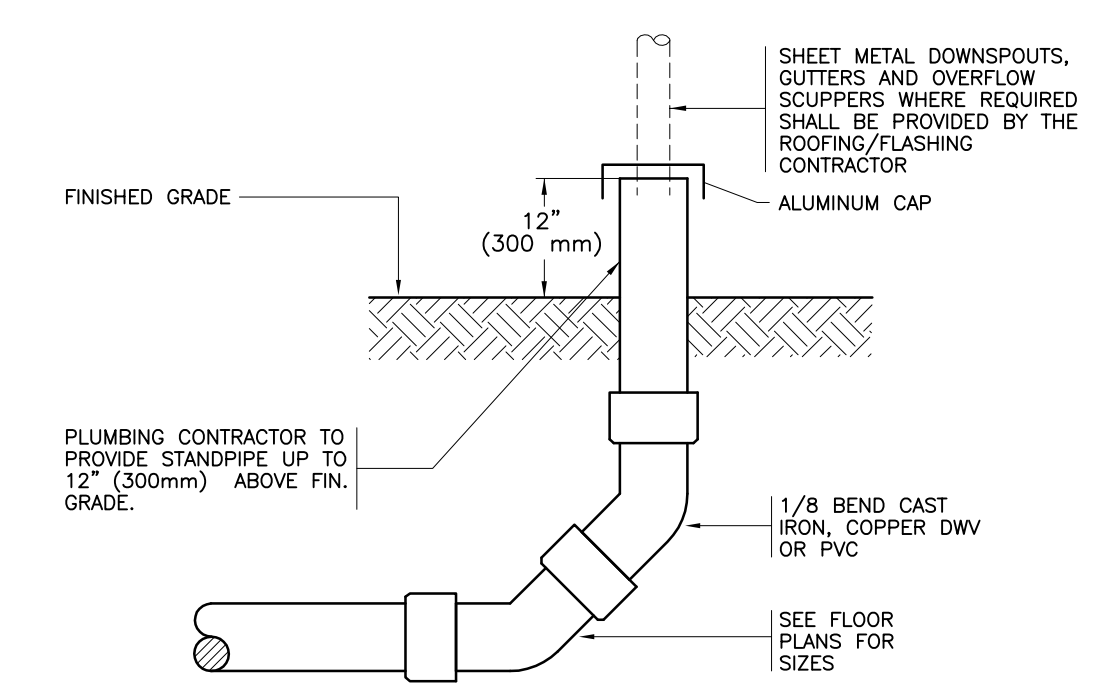

**E** P.I.I. **R.W.L. STUB-UP DETAIL** N.T.S.

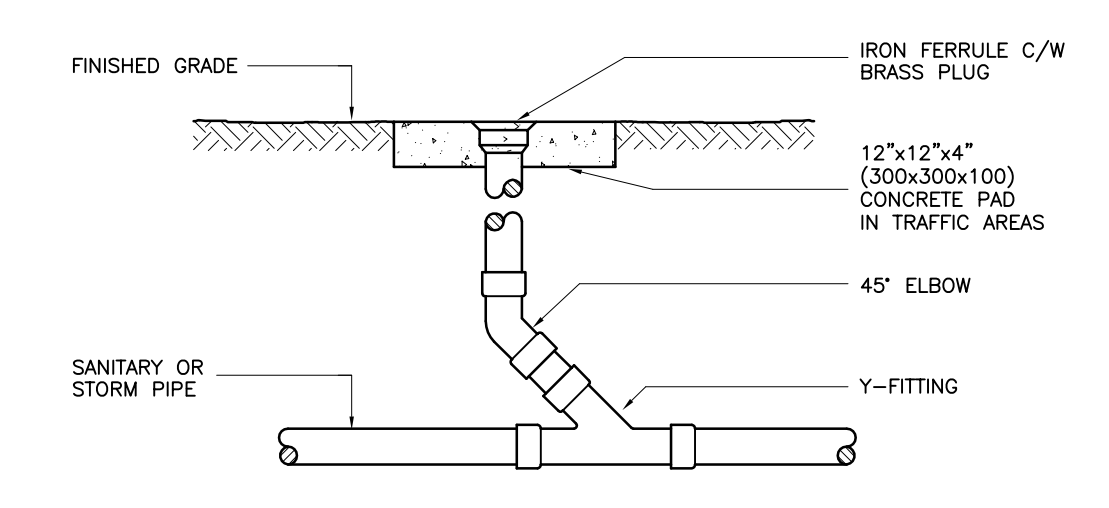

**D** P.I.I. **CLEANOUT DETAIL** N.T.S.

General Notes

No.	Revision/Issue	Date
08	Re-Issued for Building Permit Deletion of Drinking Fountain	12/08/30
07	Re-Issued for Building Permit Add Water Hammer Arresters	12/07/17
06	Re-Issued for Building Permit	12/07/03
05	Issued for Tender	12/06/28
04	Issued for Review	12/06/22
03	Issued for Building Permit	12/04/10
02	Re-Issued for Review	12/03/26
01	Issued for Review	12/03/07
No.	Revision/Issue	Date

Mechanical Name and Address

**DEC**  
 engineering sustainability

DEC ENGINEERING  
 309-713 COLUMBIA STREET,  
 NEW WESTMINSTER, B.C. CANADA V3M 1B2  
 TEL 604 525-3341  
 ENGINEERING@SUSTAINABILITY.COM

Architect Name and Address

Forum Projects Ltd.  
 Box 32120  
 Walnut Grove P.O.  
 Langley B.C. V1M-3S7  
 604-888-6672(o)  
 604-888-7857(f)

Sheet Name and Discipline

**DETAILS**  
**-PLUMBING**

Project Name and Address

**Mackin Park**  
**Washroom Building**  
**Coquitlam B.C.**

Project	D12-006	Sheet	
Date	2012-02-17	<b>P2.2</b>	
Scale	AS NOTED		

