



LEGEND	
	2-TUBE LIGHT FIXTURE (FAIL SAFE MODEL No. SCT-232...XXX)
	2-TUBE LIGHT FIXTURE (PHILLIPS DAY-BRITE MODEL No. SLCW-232-120)
	ELECTRIC BASEBOARD HEATER WATTAGE AS NOTED
	COMMERCIAL GRADE SWITCH C/W CAST BOX STAINLESS STEEL COVER PLATE
	MOTION SENSOR (LEVITON No. OSC05-MOW/GSP POWER PACK)
	ELECTROMECHANICAL TIME CLOCK WITH ASTRONOMIC FEATURE
	AUTOMATIC DOOR OPENER
	DUPLEX RECEPTACLE (5-15R UNLESS OTHERWISE NOTED)
	SOFFIT MOUNTED LIGHT FIXTURE (PHILLIPS DAY-BRITE CAPRI SERIES MODEL No. CM8/F226/32/420/185C /BH5)
	UNIT HEATER
	EXHAUST FAN
	MAGNETIC DOOR LOCK MODEL No. RU 831028

LIGHT LEVELS
20 fc PER ROOM

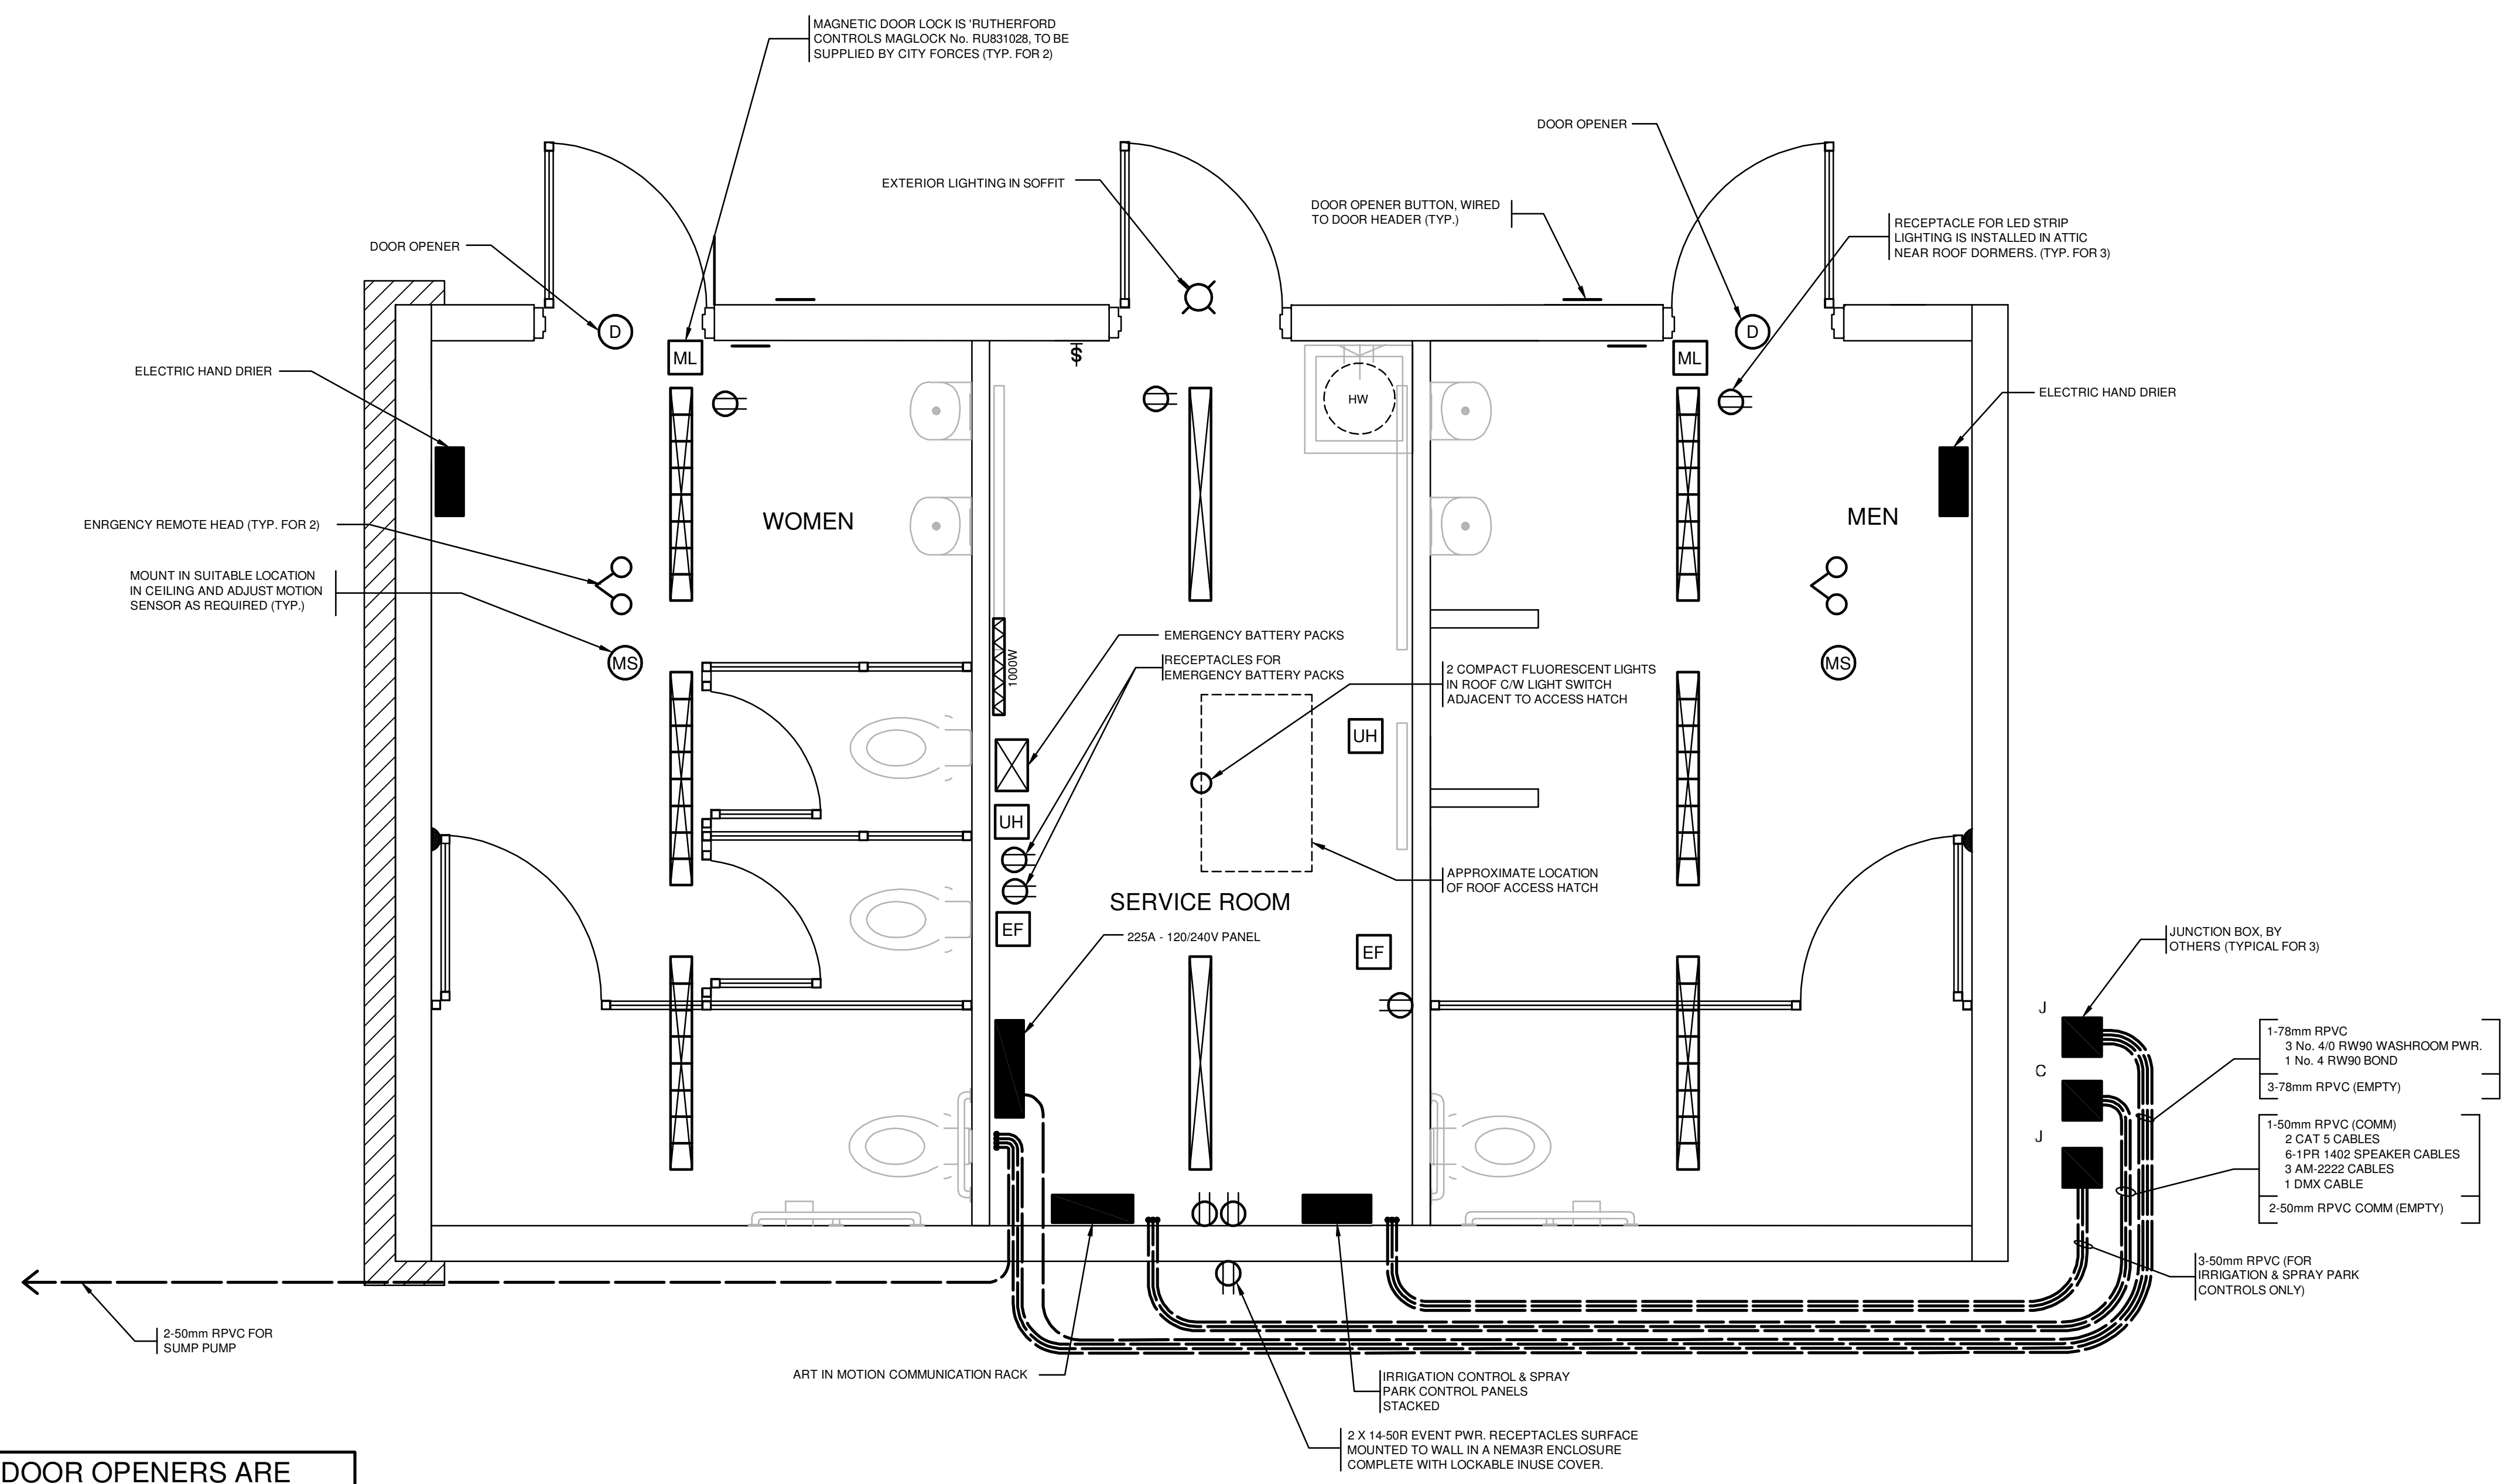

AUTOMATIC DOOR OPENERS ARE HUNTER AUTOMATICS 'HA-8' LOW ENERGY DOOR OPENER UNIT

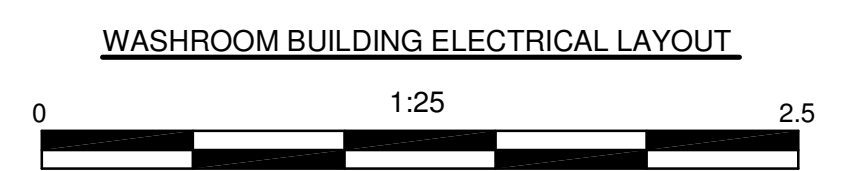

SEE SHEET 3 FOR NOTES AND SPECIFICATIONS



DMD & Associates Ltd.
#12-17358 104A Avenue
Surrey, BC, Canada V4N 5M3
www.dmdeng.com 604/589-9010
office@dmdeng.com Fax 604/589-9012


DESIGNED	DONATO SPEIDEL
DRAWN	BOB KELLIE
CHECKED	DANIEL J. WONG
DATE	2012-02-01
SCALE:	AS SHOWN

No.	DATE	BY	CHK'D	REVISION
1	2012-04-11	DMS	DJW	ISSUED FOR BUILDING PERMIT
2	2012-06-22	DMS	DJW	ISSUED FOR TENDER
3	2012-07-05	DMS	DJW	ISSUED FOR CONSTRUCTION
4	2013-05-28	SH	DJW	RECORD DRAWING

van der Zalm + associates inc.
Suite 1 - 8938 192 Street, Surrey, BC V4N 3W8

WASHROOM BUILDING ELECTRICAL
MACKIN PARK
BRUNETTE AVENUE
COQUITLAM, B.C.

PROJECT No.	3687a-12-01 of 03	SHEET No.	1 of 3	REVISION	4
-------------	-------------------	-----------	--------	----------	---

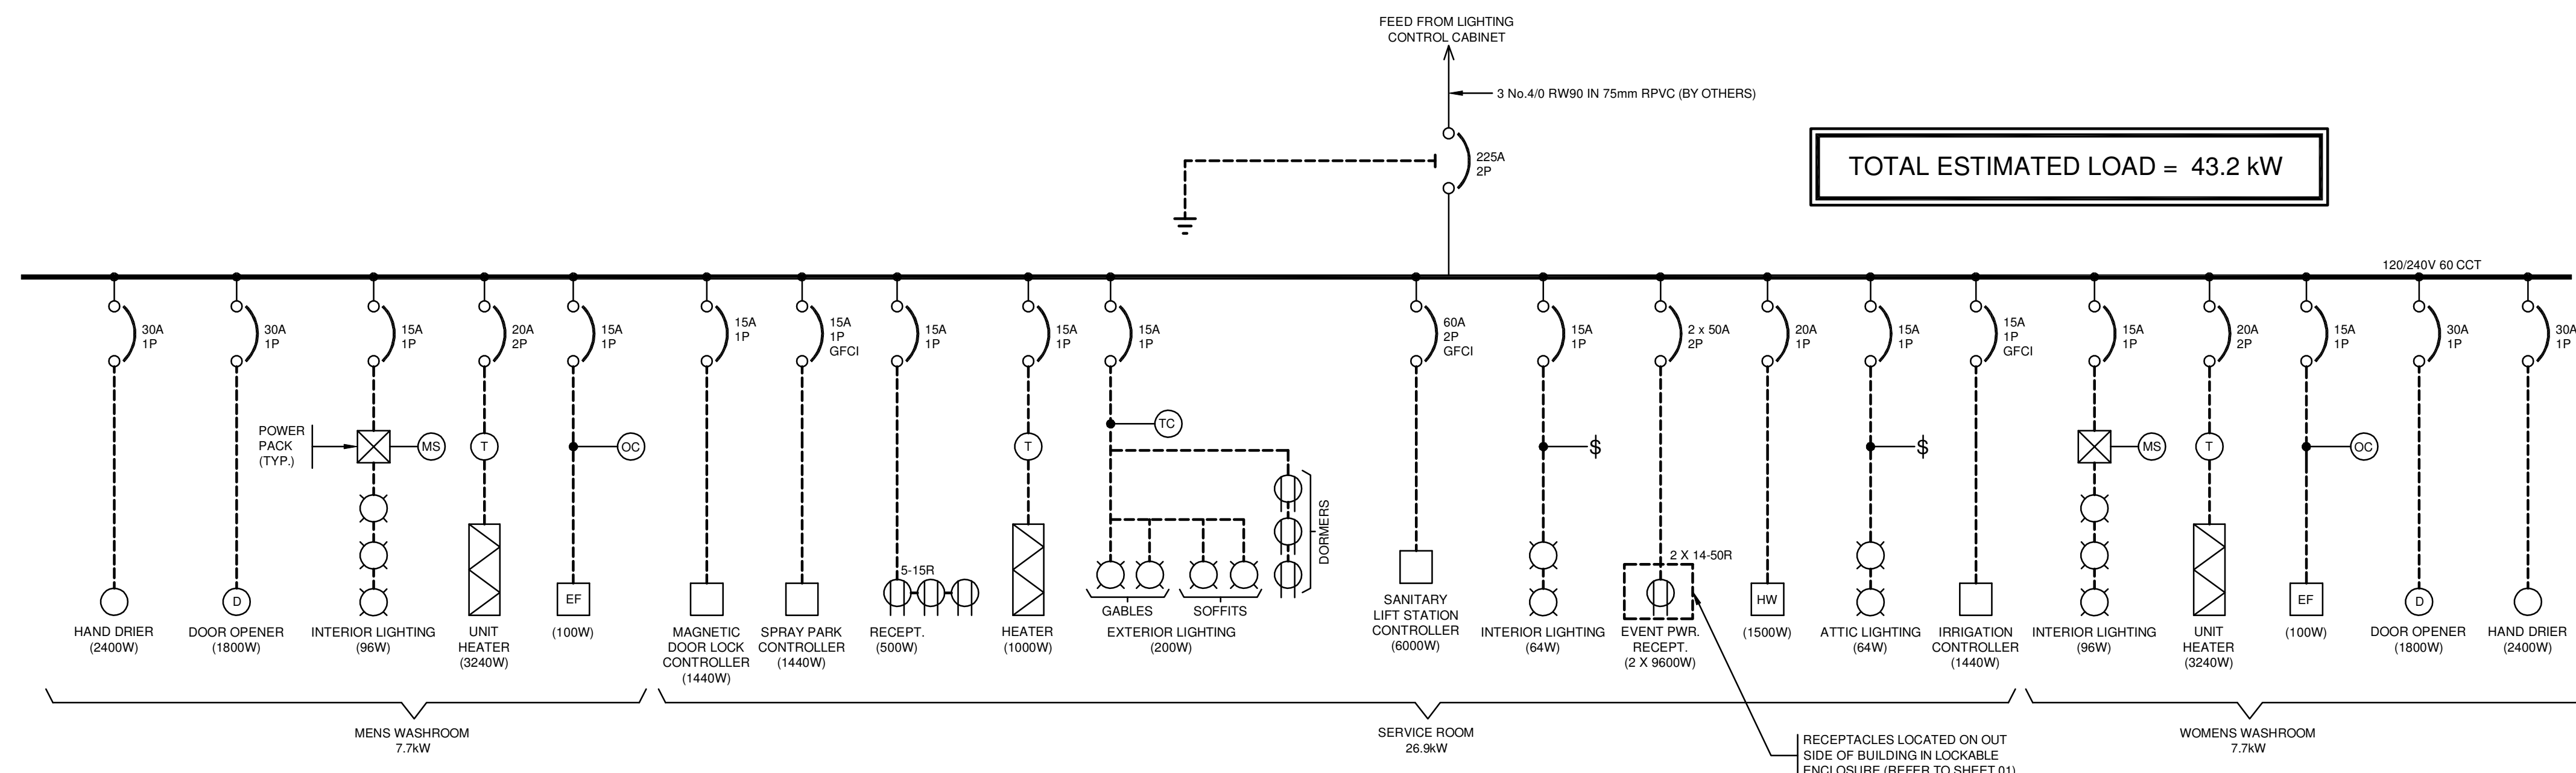

SINGLE LINE DIAGRAM
N.T.S.

TOTAL ESTIMATED LOAD = 43.2 kW

SEE SHEET 3 FOR NOTES AND SPECIFICATIONS

DMD
DMD & Associates Ltd.
 #12-17358 104A Avenue
 Surrey, BC, Canada V4N 5M3
 www.dmdeng.com 604/589-9010
 office@dmdeng.com Fax 604/589-9012

DESIGNED	DONATO SPEIDEL
DRAWN	BOB KELLIE
CHECKED	DANIEL J. WONG
DATE	2012-02-01
SCALE:	AS SHOWN
SEAL	

No.	DATE	BY	CHK'D	REVISION
1	2012-04-11	DMS	DJW	ISSUED FOR BUILDING PERMIT
2	2012-06-22	DMS	DJW	ISSUED FOR TENDER
3	2012-07-05	DMS	DJW	ISSUED FOR CONSTRUCTION
4	2013-05-28	SH	DJW	RECORD DRAWING

van der Zalm + associates inc.
 Suite 1 - 8938 192 Street, Surrey, BC V4N 3W8

WASHROOM BUILDING ELECTRICAL
MACKIN PARK
BRUNETTE AVENUE
COQUITLAM, B.C.

PROJECT No.	SHEET No.	REVISION
3687a-12-02 of 03	2 of 3	4

