

# CITY OF COQUITLAM - DOGWOOD PAVILION - DUST EXTRACTION REPLACEMENT

1655 WINSLOW AVENUE, COQUITLAM, BC





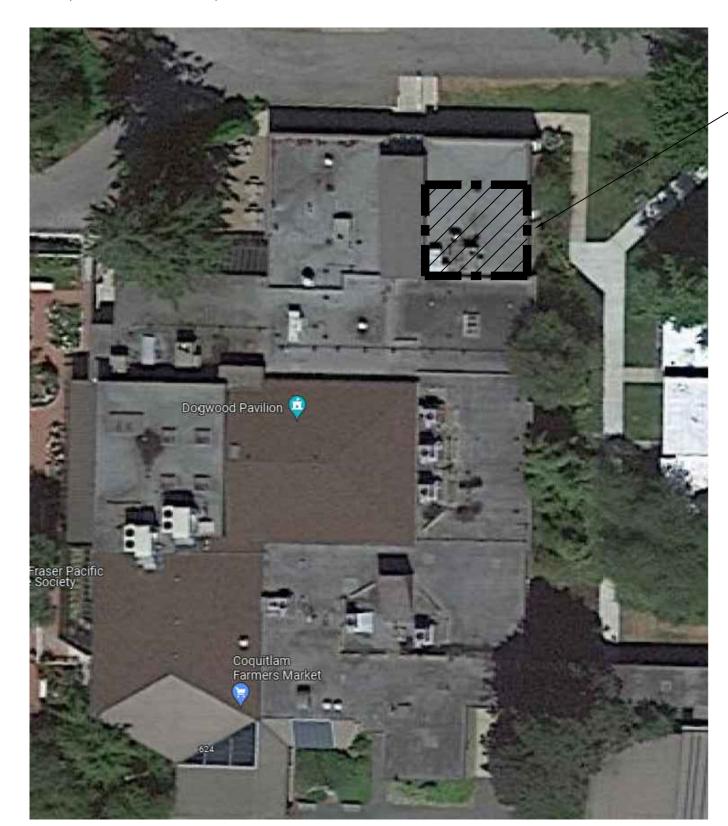

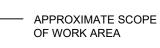

DRAIN PAN BELOW THE COMPRESSOR IS TO BE PROVIDED

AIR RECE	IVER TANK				
EQUIPMENT	MANUFACTURER	MODEL	TANK SIZE	DIMENSIONS	NOTES
TAG			(GALLONS)	(DIAxL) (IN)	
AT-1	INGERSOLL RAND	38020012	30	16x38	ALL
NOTES:					
1	VERTICAL TANK				
2	STEEL TANK				
3	COMPLETED WITH DRAIN P	AN BELOW			

DUST CO	LLECTOR						
EQUIPMENT	LOCATION	MANUFACTURER	MODEL	AIRFLOW	E.S.P.	POWER	NOTES
TAG				(CFM)	(IN. WG)	(HP)	
DC-1	STORAGE	DONALDSON TORIT	UMA 250	2500	9	10	ALL
NOTES:							
1	FILTER, STARTER, CATRI	DGE, AND BARRELS PACKAGE	TO BE PROVID	ER BY SUPPLIER			

EQUIPMENT	MANUFACTURER	MODEL	SIZE	OVERALL DIMENSIONS	VOLT/PH./Hz	NOTES
TAG				(IN)		
ABG-1	NORDFAB	NFES 3245	3	16x6.38x5.50	120/1/60	ALL
ABG-2	NORDFAB	NFES 3245	4	16x6.30x5.50	120/1/60	ALL
ABG-3	NORDFAB	NFES 3245	5	17.5x7.50x5.25	120/1/60	ALL
ABG-4	NORDFAB	NFES 3245	6	20.5x8.66x5.25	120/2/60	ALL

AIR COMP	RESSOR								
EQUIPMENT	MANUFACTURER	MODEL	MAX. PRESS.	TANK CAPACITY	POWER	VOLT/PH./Hz	DIMENSIONS	WEIGHT	NOTES
TAG			(PSI)	(GALLONS)	(HP)		(LxWxH) (IN)	(LBS)	
AC-1	SWAN	DA-103	115	10	3.0	120/1/60	28x16x27	99	ALL
NOTES:									

COMPLETED PACKAGE CONTROL PROVIDED BY SUPPLIER.

NEOPRENE GASKET BELOW UNIT IS TO BE INSTALLED

MECHANICAL DRAWING LIST				
DRAWINGS NO.	DESCRIPTION	SCALE		
M0.00	COVER PAGE	N.T.S.		
M1.00	DEMOLITION PLAN	AS NOTED		
M1.01	RENOVATION PLAN	AS NOTED		
M2.00	MECHANICAL SPECIFICATIONS	N.T.S.		

### MECHANICAL GENERAL NOTES

- THE MECHANICAL SYSTEM SHALL CONSIST OF ALL WORK SHOWN ON THE DRAWINGS, DIAGRAMS, SCHEMATICS AND AS DESCRIBED IN THE SPECIFICATIONS.
- THE MECHANICAL PLANS ARE DIAGRAMMATIC IN NATURE AND DO NOT ATTEMPT TO SHOW ALL REQUIRED OFFSETS. REFER TO ARCHITECTURAL AND STRUCTURAL DRAWINGS FOR
- COORDINATE THE DRAWINGS WITH THE SPECIFICATIONS AND IN CASES WHERE CONFLICTS OCCUR THE MOST STRINGENT REQUIREMENT SHALL APPLY.
- CONTRACTOR TO COORDINATE ALL MECHANICAL WORK WITH THAT OF OTHER TRADES TO ENSURE PROPER AND ADEQUATE INTERFACE WITH THE WORK OUTLINED FOR THIS
- CONTRACTOR TO PROVIDE HORIZONTAL AND VERTICAL CLEARANCE REQUIREMENTS AS PER CEC (CANADIAN ELECTRICAL CODE) FOR ALL INSTALLED EQUIPMENT. OFFSET MECHANICAL WORK AS REQUIRED TO MEET THIS REQUIREMENT.
- MECHANICAL EQUIPMENT SHALL NOT BE USED FOR TEMPORARY HEATING DURING THE CONSTRUCTION PROCESS. A WRITTEN LETTER FROM THE OWNER IS REQUIRED TO DO SO.
- ALL DUCTWORK SIZES ARE SHOWN AS INSIDE CLEAR. ADD APPROPRIATE DIMENSION FOR INSULATION OR DUCT LINER TO OBTAIN "TOTAL DUCT SIZE".
- CONTRACTOR TO ALLOW AND PROVIDE FOR METAL DUCTWORK TRANSITIONS BETWEEN ALL EQUIPMENT AND DUCT CONNECTIONS.
- COORDINATE EXACT LOCATIONS OF ALL ROOM THERMOSTATS AND/OR ROOM TEMPERATURE SENSORS WITH THE DESIGN ARCHITECT BEFORE FINAL INSTALLATION.

### MECHANICAL RENOVATION NOTES

- THE CONTRACTOR SHALL BE REQUIRED TO ATTEND A PRE-INVESTIGATION WALK THROUGH TO ENSURE A PROPER UNDERSTANDING OF THE MECHANICAL SCOPE OF
- CONTRACTOR IS RESPONSIBLE FOR REVIEWING AND VERIFYING ACTUAL ON-SITE CONDITIONS AND EQUIPMENT LOCATIONS PRIOR TO ANY AND ALL DEMOLITION WORK AND/OR EQUIPMENT REMOVAL.
- CONTRACTOR TO INCLUDE AS A PART OF THE PROPOSAL ALL COSTS ASSOCIATED WITH CUTTING AND PATCHING THAT IS REQUIRED TO INSTALL ALL NEW MECHANICAL SYSTEMS AS REQUIRED TO MEET THE SITE CONDITIONS AS SHOWN ON THE DRAWINGS. PATCHING SHALL MEET THE AESTHETIC CONDITIONS WHICH WAS THE CONDITION PRIOR TO ANY CUTTING BEING PREFORMED.
- CONTRACTOR TO PROPERLY SEAL AND REPAIR ANY AND ALL DAMAGE THAT IS A RESULT OF REMOVAL OR DEMOLITION OF MECHANICAL EQUIPMENT. THIS INCLUDES BUT IS NOT LIMITED TO WALL, DOOR, CEILINGS, ETC.
- THE EXISTING FACILITIES MECHANICAL SYSTEMS SHALL REMAIN OPERATIONAL DURING THE CONSTRUCTION AND RENOVATION PERIOD. CONTRACTOR TO COORDINATE CONSTRUCTION ACTIVITIES AND PHASING WITH OWNER TO MINIMIZE DISRUPTIONS TO OWNERS OPERATIONS AND ACCESS, AND TO ENSURE SAFETY OF THE USERS. PROVIDE ALL MEASURES REQUIRED TO PREVENT HAZARDS TO PEOPLE AND DAMAGE TO ITEMS REMAINING INCLUDING BUT NOT LIMITED TO DAMAGE FROM DUST AND HEAT.
- THE EXISTING DRAWINGS HAVE BEEN PREPARED, IN PART, ON THE BASIS OF INFORMATION COMPILED AND FURNISHED BY OTHERS. AS A RESULT, THE ENGINEER WILL NOT BE RESPONSIBLE FOR ANY ERRORS OR OMISSIONS WHICH HAVE BEEN INCORPORATED INTO THIS DOCUMENT.
- DURING REMOVAL OF ITEMS SO INDICATED, CAUTION SHOULD BE USED TO PREVENT DAMAGE TO ANY EQUIPMENT HAVING SALVAGE VALUE. ALL REUSABLE SALVAGED MATERIAL SHALL REMAIN THE PROPERTY OF THE OWNER AND BE RETAINED FOR THEIR INSPECTION. ONLY ITEMS AGREED BY THE OWNER SHALL BE DISPOSED OF BY THE
- CONTRACTOR SHALL COORDINATE AND SCHEDULE WORK WITH FACILITY TO LIMIT INTERFERENCE WITH OPERATIONS.

TAG	RTU-1
LOCATION	ROOF
SERVICE	WOODWORKING
MANUFACTURER	ENGINEERED AIR
MODEL	DJE20/O/R
VOLT (V/PH/CYC)	208/3/60
MCA	8.1
SUPPLY FAN	
NORMAL VOLUME (CFM)	2,000
EXTERNAL STATIC (INCH)	1.30
FAN TYPE	BELT DRIVE
FAN SPEED (RPM)	1,934
MOTOR (HP)	0.78
HEATING SECTION	
INPUT CAPACITY (MBH)	200
OUTPUT CAPACITY (MBH)	160
TURNDOWN RATIO	15:1
TEMPERATURE RISE (DEG. F)	74
FILTERS	
MAIN FILTER	MERV 8
DIMENSIONS	
L x W x H (IN)	82 x 67 x 33
WEIGHT (LBS)	1,200
NOTES	

2. BOTTOM SUPPLY AND BOTTOM RETURN

3. NEW UNIT TO SIT ON EXISTING ROOF CURB

MECHA	ANICAL ABBREVIATIONS
AD	AREA DRAIN
AFF	ABOVE FINISHED FLOOR
	AIR HANDLING UNIT ARCHITECTURAL
BB	BASEBOARD HEATER
BDD	BACKDRAFT DAMPER
BF	BOTTLE FILLER
BFP BHP	BACKFLOW PREVENTER BREAK HORSEPOWER
BMS	BUILDING MANAGEMENT SYSTEM
ВТ	BATH TUB
CB	CATCH BASIN
CFM CLG	CUBIC FEET PER MINUTE CEILING
0_0	CLEANOUT
CONN	CONNECTION
C/W	COMPLETE WITH
	CONTINUATION
CTE DB	CONNECT TO EXISTING DRY BULB
DCVA	DOUBLE CHECK VALVE ASSEMBLY
DDC	DIRECT DIGITAL CONTROL
DEG	DEGREE
DF	DRINKING FOUNTAIN
DIA DN	DOWN DIAMETER
DUC	DUAL CHECK VALVE
DW	DISH WASHER
DWG	DRAWING
	EXHAUST AIR
	ENTERING AIR TEMPERATURE EXHAUST FAN
	EFFICIENCY
ELEC	ELECTRICAL
	ENTERING
	EXTERNAL STATIC PRESSURE ENTERING WATER TEMPERATURE
EXH	EXHAUST
FA	FROM ABOVE
	FROM BELOW
	FLOOR DRAIN FIRE EXTINGUISHER
	FUNNEL FLOOR DRAIN
FLA	FULL LOAD AMPS
	FLOOR
	FEET PER MINUTE
	GALLONS PER MINUTE GYPSUM WALL BOARD
	HUB DRAIN
НВ	HOSE BIBB
	HORSEPOWER
ID INV	INSIDE DIAMETER INVERT
JS	JANITOR SINK
KW	KILOWATT
KS	KITCHEN SINK
LV LAT	LAVATORY LEAVING AIR TEMPERATURE
LWT	LEAVING WATER TEMPERATURE
MAU	MAKE-UP AIR UNIT
MAX	MAXIMUM
MH	MANHOLE
MBH MD	1000 BRITISH THERMAL UNITS/HOUR MOTORIZED DAMPER
MECH	MECHANICAL MECHANICAL
MIN	MINIMUM
NFHB	NON FREEZE HOSE BIB
NIC NC	NOT IN CONTRACT

NO NORMALLY OPEN NTS NOT TO SCALE

OD OUTSIDE DIAMETER POC POINT OF CONNECTION

OBD OPPOSED BLADE DAMPER OED OPEN ENDED DUCT

PRV PRESSURE REDUCING VALVE

PSI POUNDS PER SQUARE INCH

RPM REVOLUTIONS PER MINUTE

RWL RAIN WATER LEADER

O/A OUTDOOR AIR

R/A RETURN AIR

RF RETURN FAN

S/A SUPPLY AIR SF SUPPLY FAN

SH SHOWER

SS STAINLESS STEEL SP STATIC PRESSURE

SPEC SPECIFICATION

T/A TRANSFER AIR TA TO ABOVE

TBC TO BE CONFIRMED

TBD TO BE DETERMINED

TD TRENCH DRAIN

TS TAMPER SWITCH

TSP TOTAL STATIC PRESSURE

VTR VENT THROUGH ROOF

VFD VARIABLE FREQUENCY DRIVE

SK SINK

ST STORM

TB TO BELOW

THRU THROUGH

TYP TYPICAL

UR URINAL


W WATER MAIN

WC WATER CLOSET WG WATER GAUGE

WB WET BULB

RM ROOM

NC NOISE CRITERIA/NORMALLY CLOSED

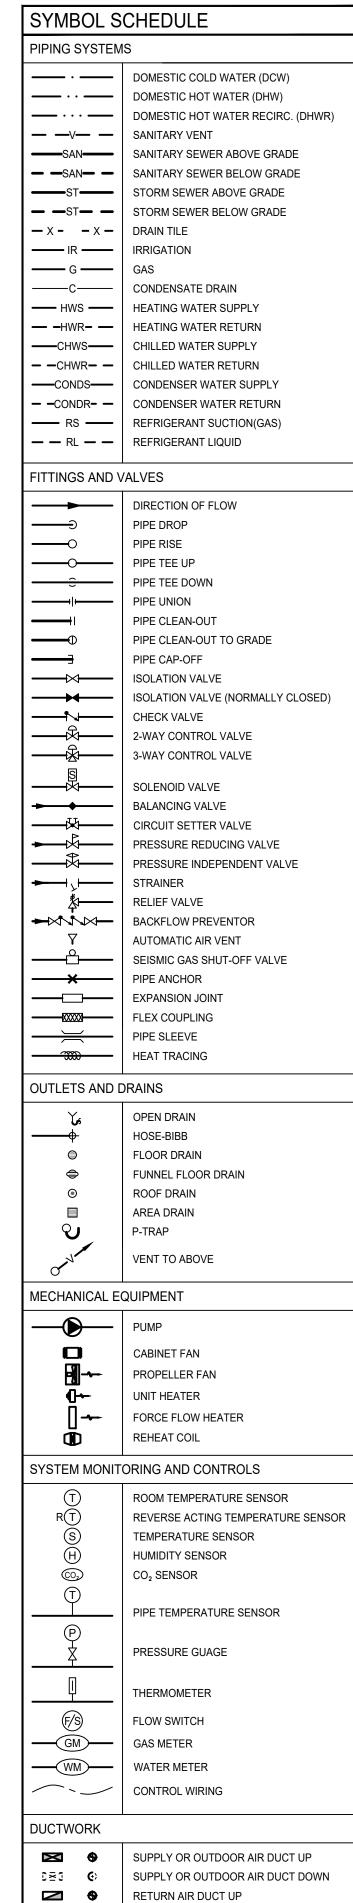

[≥3 **€**) RETURN AIR DUCT DOWN

[2] **(**)

EXHAUST AIR DUCT UP

ACOUSTIC INSULATION BALANCING DAMPER

BACKDRAFT DAMPER

MOTORIZED DAMPER

FIRE DAMPER - VERTICAL FIRE DAMPER - HORIZONTAL


FIRE/SMOKE DAMPER DUCT CAP-OFF

UNDER-CUT DOOR

RETURN OR EXHAUST AIR GRILLE

TURNING VANES

EXHAUST AIR DUCT DOWN

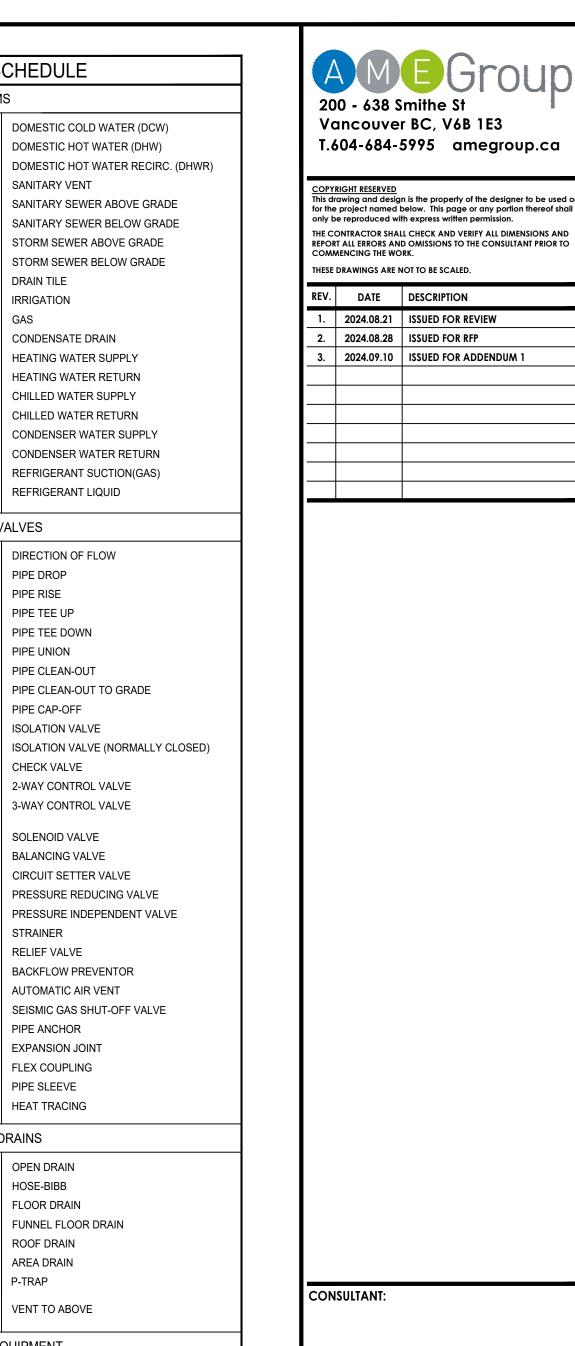

PROJECT TITLE: DOGWOOD PAVILION - DUST EXTRACTION **REPLACEMENT** 

PROJECT ADDRESS: 1655 WINSLOW AVE COQUITLAM, BC V3J 6B1

DRAWN BY JH CHECKED BY SEPTEMBER 10, 2024

DRAWING TITLE: COVER PAGE

DRAWING NO. 025b-009-24 **M0.00** 



 DEMOLISH EXISTING
 DUST COLLECTION
 EQUIPMENT AND ALL ASSOCIATED COMPONENTS. EXISTING OUTDOOR LOUVER IS TO REMAIN FOR REUSE.












— DEMOLISH EXISTING RTU

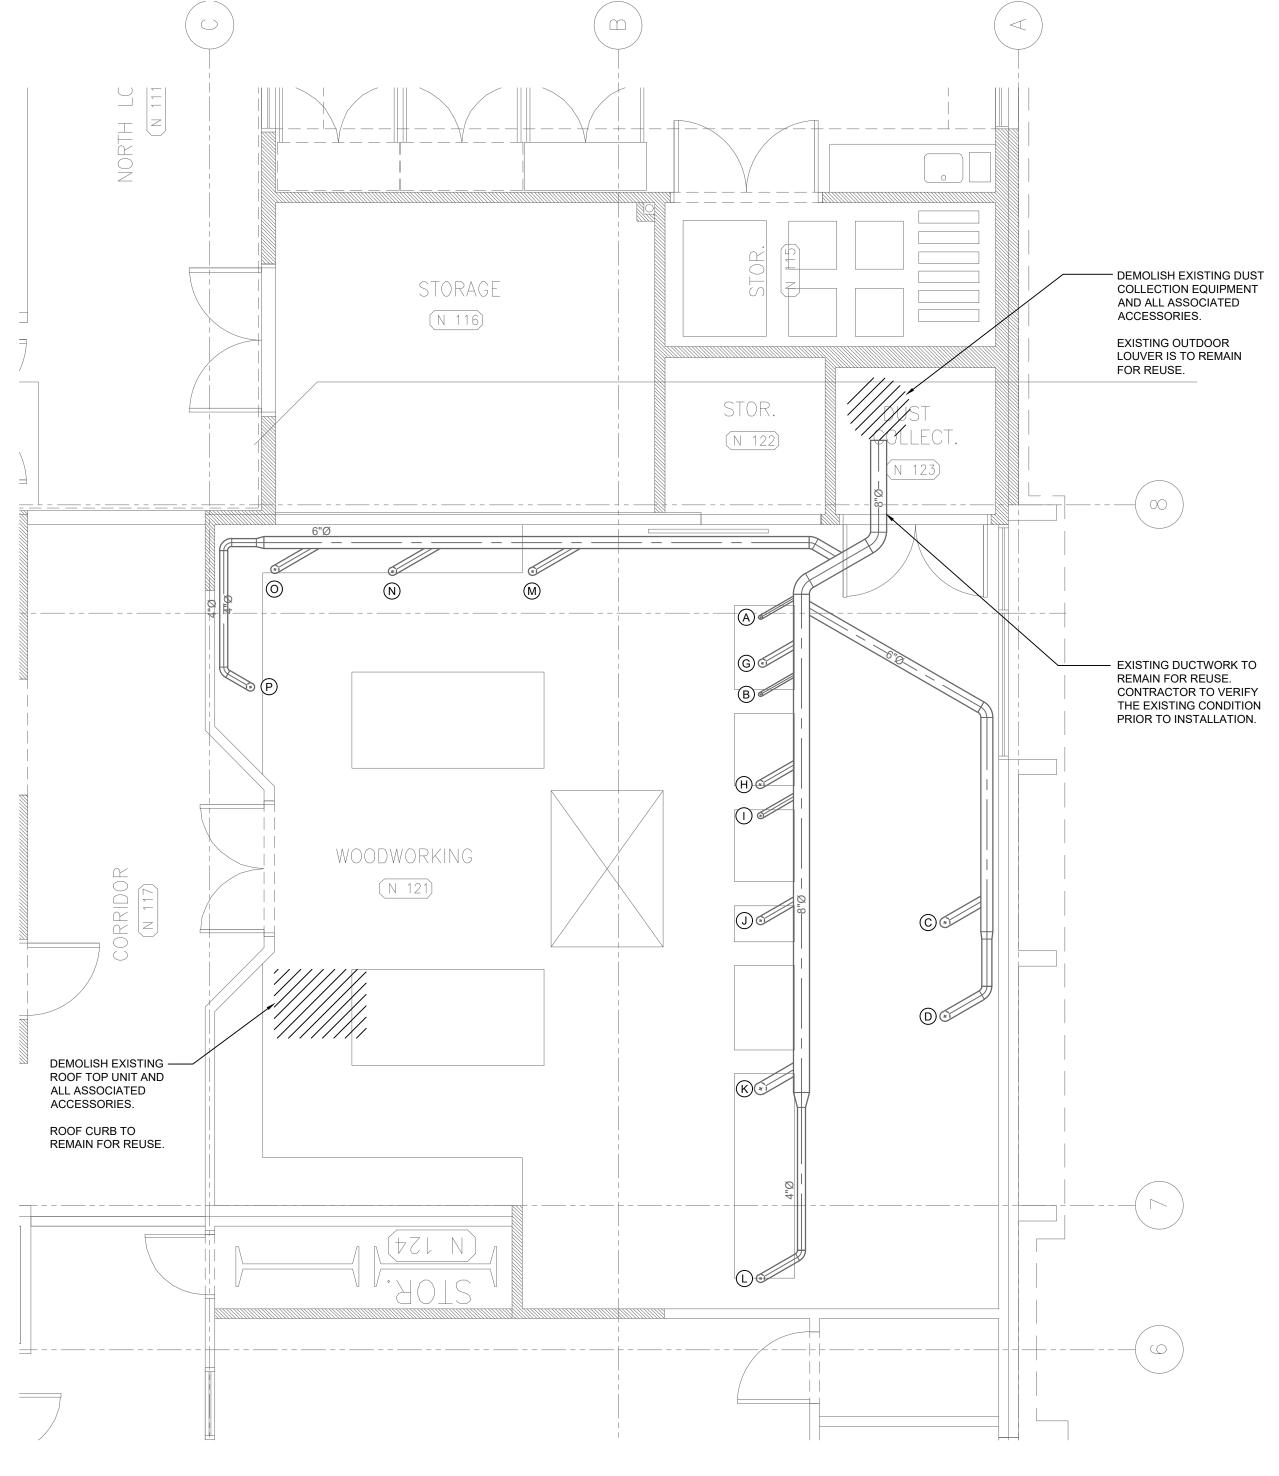

DEMOLITION PLAN

SCALE: 1/4" = 1'-0"

200 - 638 Smithe St Vancouver BC, V6B 1E3 T.604-684-5995 amegroup.ca

COPYRIGHT RESERVED
This drawing and design is the property of the designer to be used onl for the project named below. This page or any portion thereof shall only be reproduced with express written permission. THE CONTRACTOR SHALL CHECK AND VERIFY ALL DIMENSIONS AND REPORT ALL ERRORS AND OMISSIONS TO THE CONSULTANT PRIOR TO COMMENCING THE WORK. THESE DRAWINGS ARE NOT TO BE SCALED.

REV.	DATE	DESCRIPTION
1.	2024.08.21	ISSUED FOR REVIEW
2.	2024.08.28	ISSUED FOR RFP
3.	2024.09.10	ISSUED FOR ADDENDUM 1

CONSULTANT:

PROJECT TITLE:


DOGWOOD PAVILION - DUST EXTRACTION REPLACEMENT

PROJECT ADDRESS: 1655 WINSLOW AVE COQUITLAM, BC V3J 6B1

DRAWN BY	JH
CHECKED BY	MC
SCALE	AS NOTED
DATE	SEPTEMBER 10, 2024

DEMOLITION PLAN

DRAWING NO. 025b-009-24 M1.00

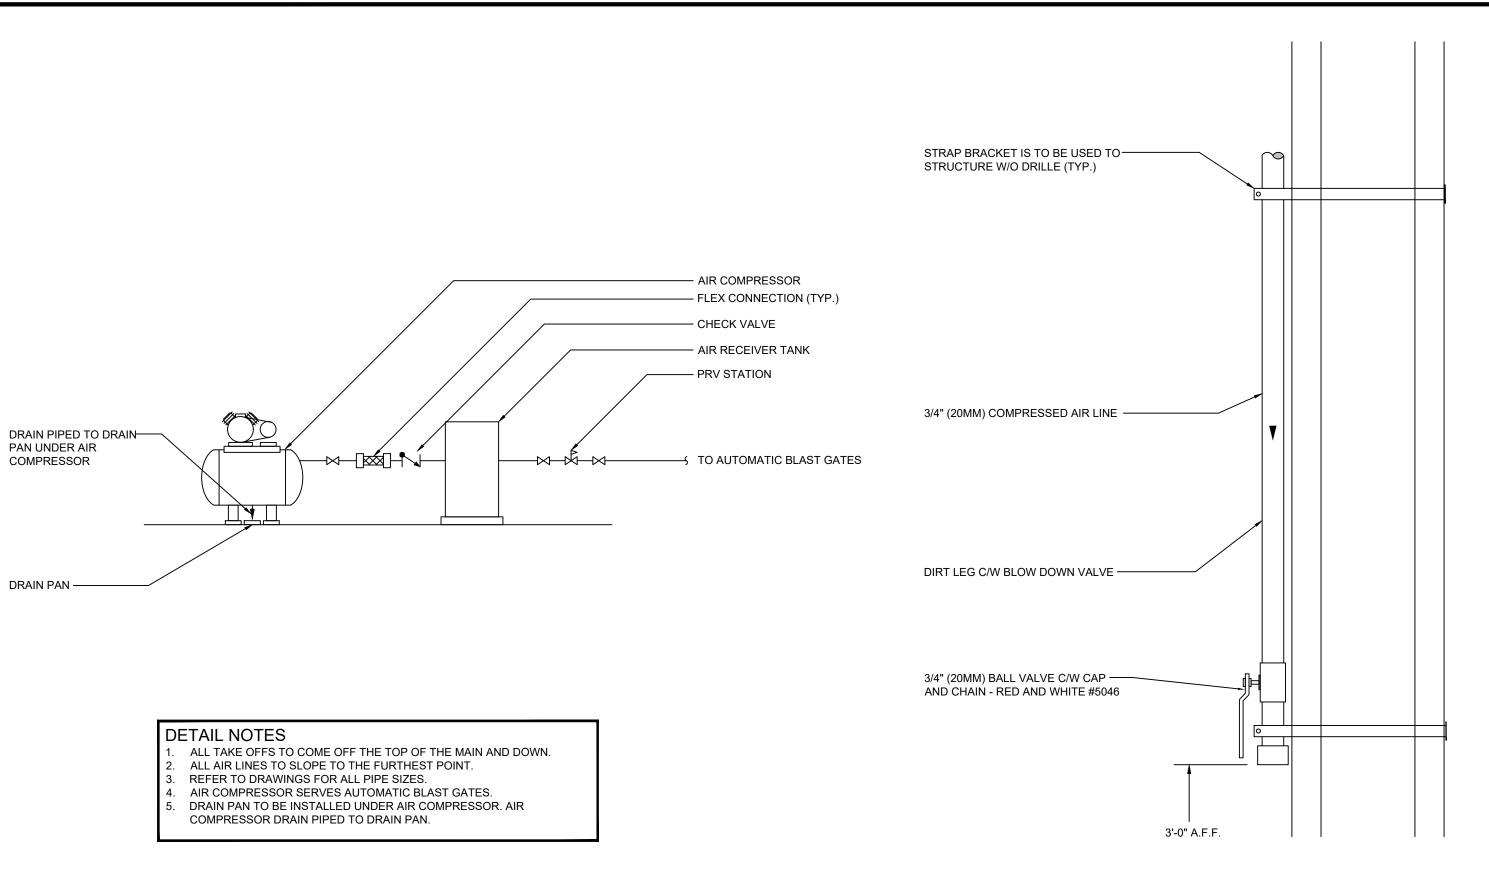

# COMPRESSED AIR SYSTEM SCHEMATIC - HORIZONTAL SCALE: NTS

BALANCING DAMPER

RIGID DUCTWORK

BLAST GATE
(WHERE APPLICABLE)

FLEXIBLE DUCTWORK

(3'-0")

FINAL CONNECTION
BY MECHANICAL


EQUIPMENT


FINAL CONNECTION
BY MECHANICAL

DETAIL NOTES

1. FLEXIBLE DUCT TO BE FLEXHAUST FLEX-TUBE EF, FLEXMASTER TRIPLE LOCK, OR APPROVED ALTERNATE.

4 EXHAUST TAKE OFF DETAIL
M1.01 SCALE: NTS

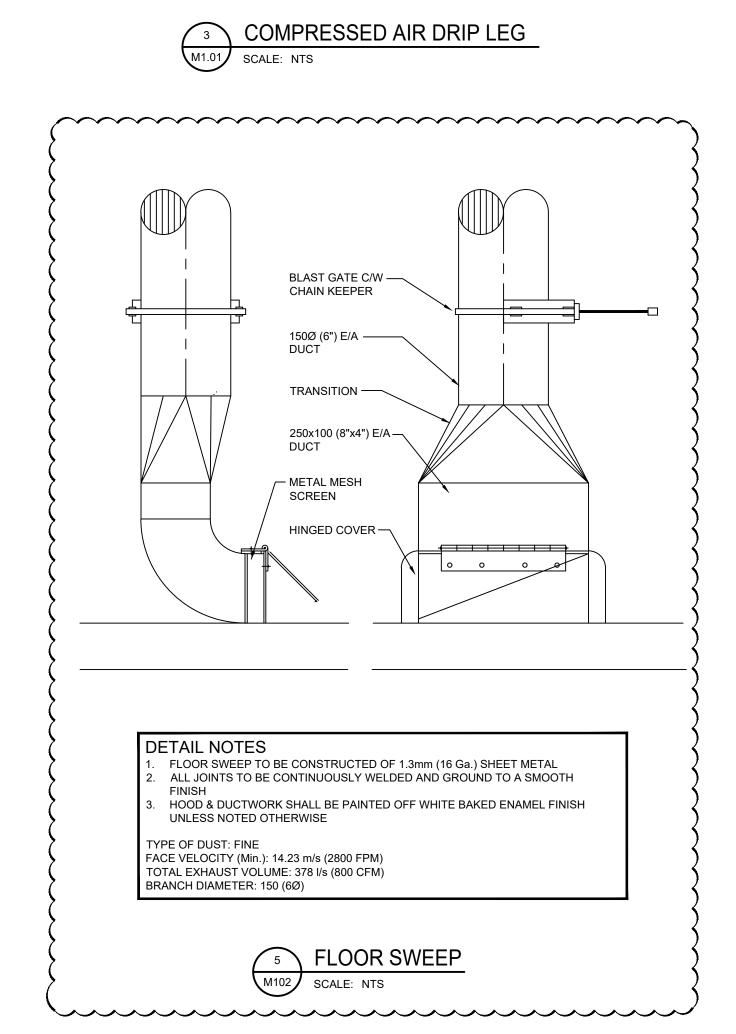

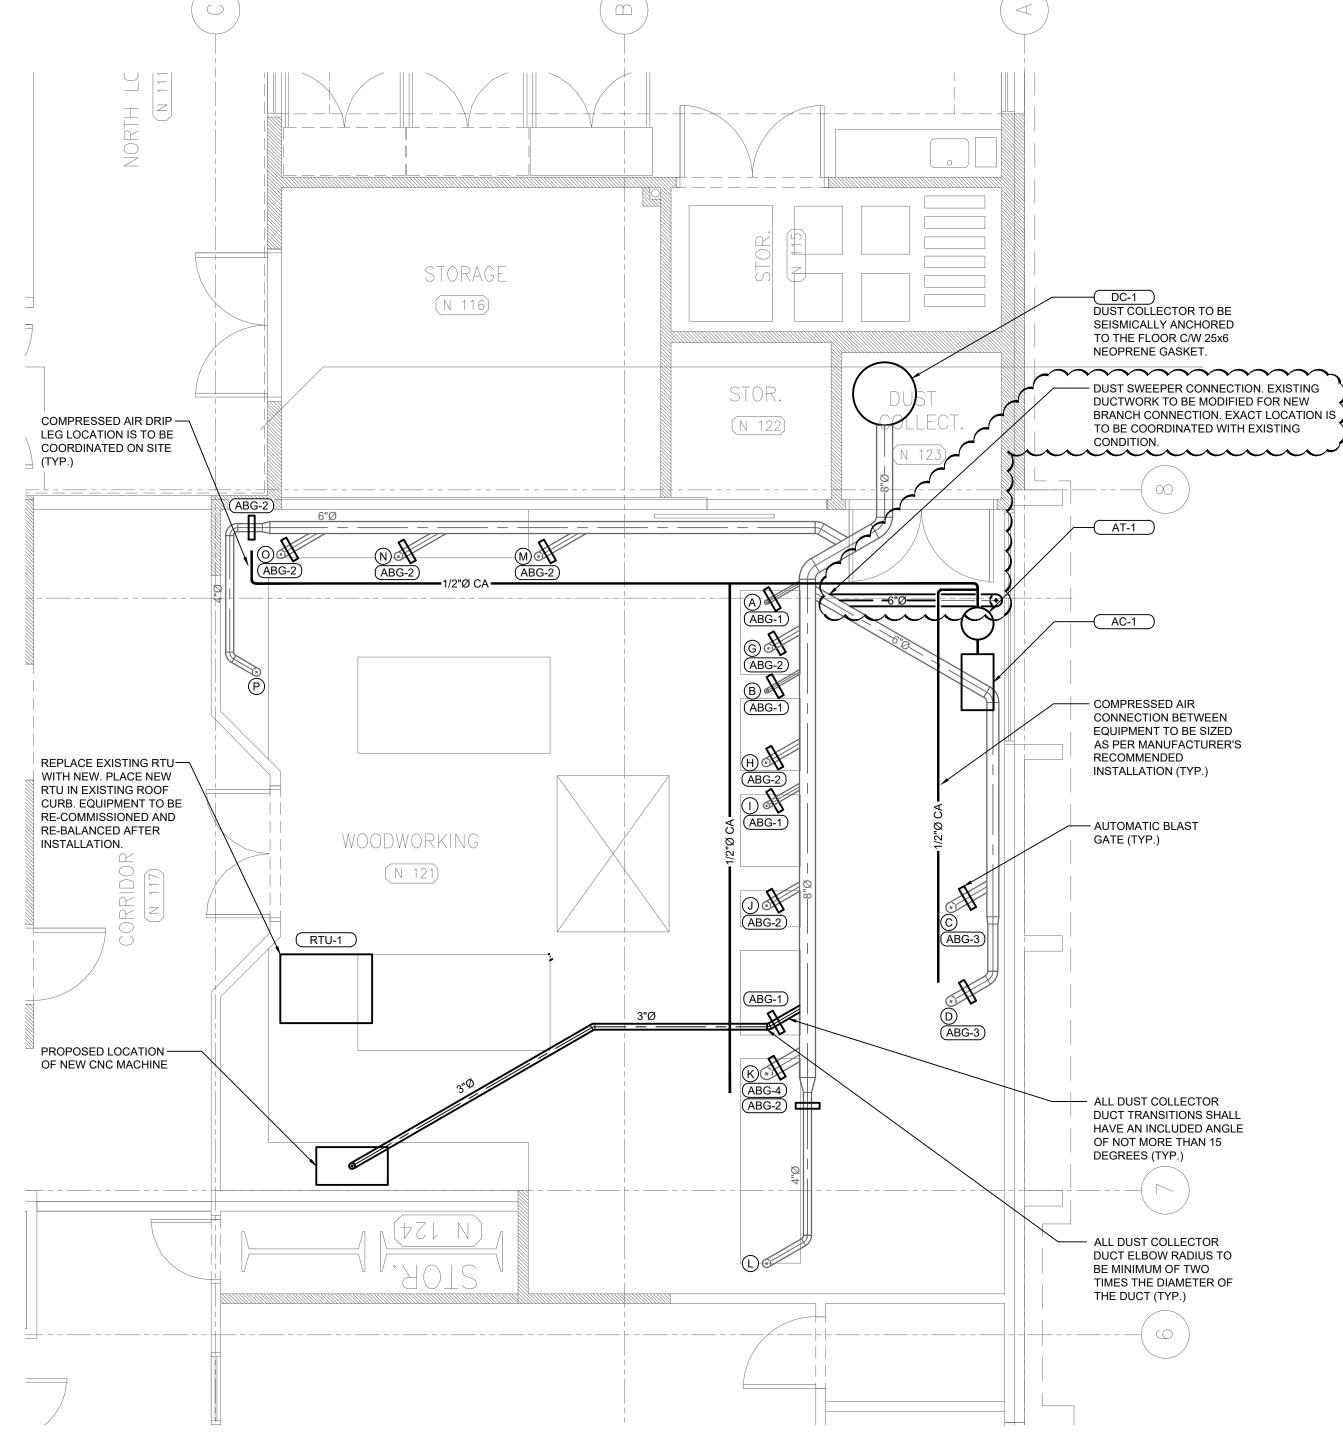

RENOVATION PLAN

M1.01 SCALE: 1/4" = 1'-0"

TOOL	DESCRIPTION	DUCT SIZE	FLOW (CFM)
A	SMALL COMBINATION SANDER	2"	100
В	SPINDLE SANDER	2"	100
С	CHOP SAW	5"	550
D	RADIAL ARM SAW	5"	550
Е	DRILL PRESS	N/A	0
F	LARGE COMBINATION SANDER	4" + 3"	550
G	JOINTER	4"	350
Н	LARGE BANDSAW	4"	350
ı	SMALL BANDSAW	3"	200
J	TABLE SAW	4"	350
K	PLANER	6"	800
L	ROUTER TABLE	4"	350
М	LATHE	4"	350
N	LATHE	4"	350
0	LATHE	4"	350
Р	LATHE	4"	350
		TOTAL	5650

AMEGROUP 200 - 638 Smithe St Vancouver BC, V6B 1E3 T.604-684-5995 amegroup.ca

COPYRIGHT RESERVED

This drawing and design is the property of the designer to be used onl for the project named below. This page or any portion thereof shall only be reproduced with express written permission.

THE CONTRACTOR SHALL CHECK AND VERIFY ALL DIMENSIONS AND REPORT ALL ERRORS AND OMISSIONS TO THE CONSULTANT PRIOR TO COMMENCING THE WORK.

THESE DRAWINGS ARE NOT TO BE SCALED.

REV.	DATE	DESCRIPTION
1.	2024.08.21	ISSUED FOR REVIEW
2.	2024.08.28	ISSUED FOR RFP
3.	2024.09.10	ISSUED FOR ADDENDUM 1

CONSULTANT:

ıL:

PROJECT TITLE:

DOGWOOD

PAVILION - DUST

EXTRACTION

REPLACEMENT

PROJECT ADDRESS: 1655 WINSLOW AVE COQUITLAM, BC V3J 6B1

DRAWN BY	JH
CHECKED BY	MC
SCALE	AS NOTED
DATE	SEPTEMBER 10, 2024

DRAWING TITLE:

RENOVATION PLAN

PROJECT NO. DRAWING NO. 025b-009-24 M1.01

### . GENERAL

### 1.1 GENERAL SCOPE

'PROVIDE' SHALL MEAN SUPPLY AND INSTALL. 'CONSULTANT' SHALL MEAN AME GROUP CONSULTING PROFESSIONAL ENGINEERS

PROVIDE COMPLETE, FULLY TESTED AND OPERATIONAL SYSTEMS TO MEET THE REQUIREMENTS DESCRIBED HEREIN AND IN COMPLETE ACCORD WITH APPLICABLE CODES AND ORDINANCES.

CONTRACT DOCUMENTS AND DRAWINGS ARE DIAGRAMMATIC. THEY ESTABLISH SCOPE, MATERIAL AND INSTALLATION QUALITY BUT ARE NOT DETAILED INSTALLATION INSTRUCTIONS.

FOLLOW MANUFACTURERS' RECOMMENDED INSTALLATION INSTRUCTIONS, DETAILS AND PROCEDURES FOR EQUIPMENT. SUPPLEMENTED BY REQUIREMENTS OF THE CONTRACT DOCUMENTS.

BEFORE SUBMITTING PROPOSAL, VISIT AND EXAMINE THE SITE AND NOTE ALL CHARACTERISTICS AND FEATURES AFFECTING THE WORK NO ALLOWANCES WILL BE MADE FOR ANY DIFFICULTIES ENCOUNTERED OR ANY EXPENSES INCURRED BECAUSE OF ANY CONDITIONS OF THE SITE OR ITEM EXISTING THEREON. WHICH IS VISIBLE OR KNOWN TO EXIST AT THE TIME OF PROPOSAL SUBMISSION.

CLARIFICATIONS OR REQUESTS FOR ALTERNATE MATERIALS OR EQUIPMENT MUST BE SUBMITTED IN WRITING TO THE CONSULTANT NO LATER THAN SEVEN (7) WORKING DAYS PRIOR TO THE MECHANICAL TRADES' PROPOSAL CLOSING DATE. APPROVAL OF REQUESTS SHALL ONLY BE GIVEN BY ADDENDUM.

CONSULT WITH RESPECTIVE DIVISIONS IN SETTING OUT LOCATIONS FOR DUCTWORK, EQUIPMENT, AND PIPING, SO THAT CONFLICTS ARE AVOIDED AND SYMMETRICAL EVEN SPACING IS MAINTAINED. JOINTLY WORK OUT ALL CONFLICTS ON SITE BEFORE FABRICATING OR INSTALLING ANY MATERIALS OR EQUIPMENT.

### 1.2 CODE COMPLIANCE, PERMITS AND FEES

ALL WORK SHALL COMPLY WITH CURRENT EDITIONS OF THE NATIONAL. PROVINCIAL AND MUNICIPAL CODES. STANDARDS, ACTS AND BYLAWS AND WILL MEET THE REQUIREMENTS OF THE AUTHORITY HAVING JURISDICTION.

OBTAIN ALL PERMITS AND PAY ALL FEES APPLICABLE TO THE SCOPE OF WORK, CONTRACTOR SHALL ARRANGE FOR INSPECTIONS OF THE WORK BY THE AUTHORITIES HAVING JURISDICTION AND SHALL PROVIDE CERTIFICATES INDICATING FINAL APPROVAL

### 1.3 QUOTATION PRICE BREAKDOWN

SUBMIT A PROPOSAL QUOTATION PRICE BREAKDOWN WITHIN THIRTY (30) DAYS OF PROPOSAL CLOSING AND BEFORE FIRST PROGRESS CLAIM, IN A FORMAT AGREED TO WITH THE CONSULTANT. AS A MINIMUM INCLUDE EQUIPMENT, MATERIALS AND LABOUR FOR MECHANICAL PLUMBING, SHEET METAL, FIRE PROTECTION AND CONTROLS.

### 1.4 SUBMITTALS

PROCEDURES AND IN ADDITION THE FOLLOWING: CONTRACTOR SHALL PROVIDE AND SUBMIT TO THE CONSULTANT ASSURANCE OF PROFESSIONAL DESIGN AND COMMITMENT FOR FIELD REVIEW SCHEDULE B AND ASSURANCE OF PROFESSIONAL FIELD REVIEW AND COMPLIANCE SCHEDULE S-B FOR SEISMIC ENGINEERING. SHOP DRAWINGS: PROVIDE SHOP DRAWINGS FOR ALI

COMPLY WITH DIVISION 1 - SUBMISSION AND CLOSEOUT

EQUIPMENT AS ELECTRONIC FILES (FILE FORMAT: .DWG .DXF, PDF, OR COMPARABLE). WHEN MANUFACTURER'S CUT SHEETS APPLY TO A PRODUCT SERIES RATHER THAN A SPECIFIC PRODUCT, THE DATA SPECIFICALLY APPLICABLE TO THE PROJECT SHALL BE HIGHLIGHTED OR CLEARLY INDICATED BY OTHER MEANS. EACH SUBMITTED PIECE OF LITERATURE AND DRAWINGS SHALL CLEARLY REFERENCE THE SPECIFICATION AND/OR DRAWING THAT THE SUBMITTAL IS TO COVER. GENERAL CATALOGS SHALL NOT BE ACCEPTED AS CUT SHEETS TO FULFILL SUBMITTAL REQUIREMENTS.

OPERATION AND MAINTENANCE MANUAL APPROVED BY, AND FINAL COPICLOSEOUT SUBMITTALS: PROVIDE A MINIMUM OF TWO (2) MECHANICAL OPERATION AND MAINTENANCE MANUALS AND ONE DIGITAL COPY. PREPARED BY THE TAB CONTRACTOR.

#### ES DEPOSITED WITH THE CONSULTANT A MINIMUM OF 7-DAYS BEFORE FINAL INSPECTION.

OPERATION AND MAINTENANCE MANUAL TO INCLUDE BUT NOT LIMITED TO: LAYMAN'S DESCRIPTION OF THE SYSTEMS AND ASSOCIATED CONTROLS; OPERATIONA INSTRUCTIONS, SERVICING, MAINTENANCE, OPERATION AND TROUBLE-SHOOTING INSTRUCTIONS FOR EACH ITEM OF EQUIPMENT: WARRANTIES: EQUIPMENT MANUFACTURER'S PERFORMANCE DATASHEETS INDICATING POINT OF OPERATION AS LEFT AFTER COMMISSIONING IS COMPLETE; TESTING, ADJUSTING AND BALANCING REPORTS.

RECORD DRAWINGS: CONSULTANT WILL PROVIDE 1 SET OF WHITE PRINTS AT CONTRACTORS COST TO MARK CHANGES AS WORK PROGRESSES AND AS CHANGES OCCUR. USE DIFFERENT COLOUR WATERPROOF INK FOR EACH SERVICE. DO NOT USE PENCIL OR BLACK INK. TRANSFER INFORMATION WEEKLY TO SHOW WORK AS ACTUALLY INSTALLED, DRAWINGS SHALL BE AVAILABLE ON A WEEKLY BASIS FOR REVIEW BY THE CONSULTANT

IDENTIFY EACH DRAWING IN LOWER RIGHT HAND CORNER IN LETTERS AT LEAST 12 MM HIGH AS FOLLOWS: - "AS BUILT DRAWINGS: THIS DRAWING HAS BEEN REVISED TO SHOW MECHANICAL SYSTEMS AS INSTALLED" (SIGNATURE OF CONTRACTOR) (DATE).

SUBMIT TO CONSULTANT FOR APPROVAL AND MAKE CORRECTIONS AS DIRECTED.

SUBMIT COMPLETED CAD RECORD DRAWINGS WITH FINAL OPERATING AND MAINTENANCE MANUALS WITHIN TWO (2) WEEKS OF SUBSTANTIAL COMPLETION. FAILURE TO SUBMIT DRAWINGS WILL RESULT IN THE WORK BEING UNDERTAKEN BY THE OWNER AND DEDUCTED FROM THE CONTRACTOR'S HOLD BACK AMOUNT. COST TO TRANSFER RECORD INFORMATION ONTO REPRODUCIBLE MEDIA & AUTO-CAD DISKS ARE THIS CONTRACTOR'S RESPONSIBILITY. CONSULTANT WILL RELEASE DRAWINGS TO CONTRACTOR AFTER SIGNING A COPYRIGHT FORM. SHOULD THE CONTRACTOR CHOOSE TO UTILISE THIS CONSULTANT FOR TRANSFERRING AS BUILT INFORMATION, ALLOW \$400 / SHEET FOR ALL DRAWINGS IN THE CONSTRUCTION SET. THIS WILL COVER COSTS FOR

### 1.5 QUALITY OF WORK

DRAFTING TIME & PRINTING COSTS.

ALL WORK SHALL BE BY QUALIFIED TRADESMEN WITH VALID PROVINCIAL TRADE QUALIFICATION CERTIFICATES. SPOT CHECKS WILL BE MADE BY THE CONSULTANT. WORK WHICH DOES NOT CONFORM TO STANDARDS MAY BE REJECTED BY THE CONSULTANT. THE CONTRACTOR SHALL REDO REJECTED WORK TO THE ACCEPTED STANDARD AT NO COST TO THE OWNER.

# 1.6 DRAWINGS AND SPECIFICATIONS

SHOULD ANY DISCREPANCY APPEAR BETWEEN DRAWINGS AND SPECIFICATIONS OBTAIN WRITTEN CLARIFICATION FROM THE CONSULTANT DURING THE PROPOSAL PERIOD WITHOUT A WRITTEN CLARIFICATION THE BETTER QUALITY AND/OR GREATER QUANTITY OF WORK OR MATERIALS SHALL BE ESTIMATED, PERFORMED AND FURNISHED WITHIN THE PROPOSED PRICE.

### 1.7 CUTTING, PATCHING AND CORING

PROVIDE HOLES AND SLEEVES, CUTTING AND FITTING REQUIRED FOR MECHANICAL WORK, RELOCATE IMPROPERLY LOCATED HOLES AND SLEEVES. ALL WORK SHALL BE COORDINATED WITH OTHER TRADES. OBTAIN WRITTEN APPROVAL FROM THE STRUCTURAL

CONSULTANT BEFORE CUTTING OR BURNING STRUCTURAL MEMBERS

PROVIDE X-RAY OF ALL REQUIRED PENETRATIONS OF THE FLOOR X-RAY USE FOR LOCATING IN FLOOR REBAR AND CONDUIT TO BE DONE AFTER NORMAL WORKING HOURS TAKE NECESSARY PRECAUTIONS TO PROTECT COMPUTER EQUIPMENT WHEN X-RAYING FLOORS. COORDINATE WITH

### 1.8 INSTALLATION OF EQUIPMENT

PIPE ALL EQUIPMENT DRAINS TO BUILDING DRAINS OR SPECIFIED DRAIN METHOD EXCEPT SYSTEMS CONTAINING UNIONS AND FLANGES SHALL BE PROVIDED IN PIPING OR

#### MAINTENANCE. 1.9 CONNECTIONS TO EXISTING SERVICES

MAINTAIN LIAISON WITH THE OWNER AND PROVIDE A MUTUALLY ACCEPTABLE SCHEDULE TO INTERRUPT REROUTE, OR CONNECT TO EXISTING BUILDING SERVICES WITH THE MINIMUM OF INTERRUPTION OF THOSE SERVICES.

DUCTWORK TO PERMIT EASY REMOVAL OF EQUIPMENT.

MAINTAIN PERMANENT ACCESS TO EQUIPMENT FOR

### 1.10 SELECTIVE DEMOLITION

REMOVE FROM SITE ALL EQUIPMENT, DUCTING OR PIPING WHICH IS NO LONGER REQUIRED BECAUSE OF WORK UNDER THIS CONTRACT. EXCEPT AS OTHERWISE STATED, SALVAGEABLE MATERIALS FROM AREA OF DEMOLITION SHALL BECOME THE PROPERTY OF THE OWNER AT HIS DISCRETION.

THE INTENT IS FOR A HAZ-MAT CONTRACTOR TO REMOVE ALL ASBESTOS CONTAINING MATERIAL PRIOR TO THE PROPOSED PROJECT WORK TAKING PLACE NOTIFY THE CONSULTANT IF ASBESTOS CONTAINING MATERIAL IS SUSPECTED TO REMAIN ON SITE.

### 1.11 EQUIPMENT AND MATERIALS

WHERE TWO OR MORE PRODUCTS OF THE SAME TYPE ARE REQUIRED, PRODUCTS SHALL BE OF THE SAME MANUFACTURER.

NOTIFY THE CONSULTANT IN WRITING TEN (10) DAYS PRIOR TO THE PROPOSAL SUBMISSION, ANY MATERIALS OR EQUIPMENT SPECIFIED WHICH IS NOT CURRENTLY AVAILABLE OR WILL NOT BE AVAILABLE FOR USE AS CALLED FOR HEREIN. FAILING THIS, THE CONTRACT WILL ASSUME THAT THE MOST EXPENSIVE ALTERNATE HAS BEEN INCLUDED IN THE PROPOSED PRICE. APPROVED EQUIVALENTS AND/OR ALTERNATIVES TO SPECIFIED PRODUCTS SHALL BE EQUAL TO THE SPECIFIED PRODUCT IN EVERY RESPECT, OPERATE AS INTENDED, AND MEET THE SPACE, CAPACITY, AND NOISE

REQUIREMENTS OUTLINED. THE CONTRACTOR SHALL BE FULLY RESPONSIBLE FOR ANY ADDITIONAL LABOUR AND MATERIALS REQUIRED BY ANY TRADES OR OTHER CONTRACTORS TO ACCOMMODATE THE USE OF OTHER THAN SPECIFIED MATERIALS OR EQUIPMENT. THE CONTRACTOR SHALL BEAR ANY AND ALL COSTS FOR DESIGN/SYSTEM MODIFICATIONS TO ACCOMMODATE THE "ALTERNATE" EQUIPMENT. EXTRAS WILL NOT BE APPROVED TO COVER SUCH WORK.

#### 1.12 DELIVERY, STORAGE AND HANDLING STORE MATERIALS AND FOUIPMENT IN ACCORDANCE

WITH THE MANUFACTURER'S RECOMMENDATIONS IN A CLEAN, DRY, WELL-VENTILATED AREA. REPLACE DEFECTIVE OR DAMAGED MATERIALS WITH NEW.

1.13 FIRESTOPPING AND SMOKE SEALS

PROVIDE FIRESTOPPING SYSTEM(S) TO PROVIDE AND MAINTAIN A FIRE RESISTANCE RATING, AS INDICATED ON DRAWINGS AND IN ACCORDANCE WITH UL, WH, ULC, CUL OR FM DESIGN DETAILS FOR ALL MECHANICAL WORK IN DIVISIONS 21, 22, 23 AND 25

FOR RENOVATION PROJECTS, IN ADDITION TO THE NECESSARY NEW PENETRATIONS, PROVIDE THE FIRESTOPPING FOR ALL EXISTING MECHANICAL ASSEMBLIES WHERE FIRESTOPPING IS DAMAGED DISCONTINUED OR ABSENT WITHIN THE CONSTRUCTION

ALL FIRESTOP SYSTEM INSTALLATIONS MUST MEET THE REQUIREMENTS OF CAN4-S115-M OR ULC S-115-M TESTED ASSEMBLIES THAT PROVIDE A FIRE RATING

A MANUFACTURER'S DIRECT REPRESENTATIVE (NOT DISTRIBUTOR OR AGENT) SHALL BE ON-SITE DURING THE INITIAL INSTALLATION OF FIRESTOP SYSTEMS TO TRAIN APPROPRIATE CONTRACTOR PERSONNEL IN CORRECT SELECTION AND INSTALLATION PROCEDURES. THIS WILL BE DONE PER MANUFACTURER'S WRITTEN RECOMMENDATIONS PUBLISHED IN THEIR LITERATURE AND DRAWING DETAILS.

### 1.14 ACCESS DOORS

PROVIDE ACCESS DOORS FOR MAINTENANCE OR ADJUSTMENT OF ALL PARTS OF THE MECHANICAL SYSTEM.

PROVIDE 300 MM X 300 MM MINIMUM SIZE FOR INSPECTION AND HAND ACCESS.

600 MM X 600 MM MINIMUM SIZE, LARGER IF INDICATED ON DRAWINGS, WHERE ENTRY IS REQUIRED AND ACCESS IS DIFFICULT.

### 1.15 ESCUTCHEONS AND PLATES

PROVIDE ESCUTCHEONS AND PLATES ON ALL PIPING AND DUCTWORK PASSING THROUGH FINISHED WALLS, FLOORS, AND CEILINGS.

1.16 GUARANTEE / WARRANTY FURNISH A WRITTEN GUARANTEE STATING THAT ALL WORK EXECUTED IN THIS CONTRACT WILL BE FREE FROM DEFECTIVE WORKMANSHIP AND MATERIALS FOR A PERIOD OF ONE (1) YEAR FROM THE DATE OF SUBSTANTIAL

## PERFORMANCE.

1.17 BALANCING THE APPROVED BALANCING AGENCIES ARE: WESTERN MECHANICAL; K.D. ENGINEERING, FLOTECH MECHANICAL

BLUE COLLAR GROUP. BALANCE EQUIPMENT AND AIR OUTLETS TO AIR QUANTITIES INDICATED ON THE DRAWINGS AND IN THIS SPECIFICATION. WHERE OUTLET QUANTITIES ARE NOT INDICATED, DIVIDE CAPACITY EQUALLY AMONG ALL

SUBMIT A PDF COPY OF THE REPORT TO THE CONSULTANT WITHIN TWO (2) WEEKS AFTER SUBSTANTIAL COMPLETION FAILURE TO SUBMIT THE REPORT WITHIN THE SPECIFIED TIME WILL RESULT IN THE WORK BEING DONE BY THE OWNER AND THE COSTS DEDUCTED FROM FINAL PAYMENT.

BALANCING SHALL BE PERFORMED TO THE FOLLOWING: AIR-TERMINAL OUTLETS AIR-CENTRAL EQUIPMENT ±5%

PROVIDE A DROP TEST OF ALL FIRE DAMPERS AND A LETTER/CERTIFICATE CONFIRMING THIS WORK.

COOPERATE WITH THE BALANCING AGENCY AND MAKE ANY CORRECTIONS AS REQUIRED BY BALANCING AGENCY. PROVIDE BALANCING VALVES AND DAMPERS. PULLEYS. SHEAVES ETC. AS REQUESTED BY THE BALANCING AGENCY AND/OR NECESSARY TO PROPERLY ADJUST OR CORRECT THE SYSTEMS TO DESIGN FLOWS, WITHOUT ADDITIONAL COST TO OWNER.

### BE RESPONSIBLE FOR THE PERFORMANCE AND COMMISSIONING OF ALL EQUIPMENT SUPPLIED AND

RE-USED UNDER DIVISIONS 22 AND 23. CONFIRM OPERATION AND REVIEW CONDITION OF ALL EXISTING EQUIPMENT AND ASSOCIATED CONTROL

1.18 COMMISSIONING AND DEMONSTRATION

DEVICES IN THE RENOVATED AREA. SUBMIT REPORT NOTING ANY REMEDIAL WORK REQUIRED. AT THE CONCLUSION OF COMMISSIONING, DEMONSTRATE THE OPERATION OF THE SYSTEMS TO THE CONSULTANT AND THEN TO THE OWNER'S OPERATING STAFF.

AT THE COMPLETION OF THE COMMISSIONING, TESTING, BALANCING AND DEMONSTRATION SUBMIT TO THE CONSULTANT A LETTER CERTIFYING THAT ALL WORK SPECIFIED LINDER THIS CONTRACT IS COMPLETE, CLEAN AND OPERATIONAL IN ACCORDANCE WITH THE SPECIFICATION AND DRAWINGS.

2.2 FIRESTOPPING AND SMOKE SEALS

COMPONENTS SPECIFIED BY THE FIRESTOPPING

ACCEPTABLE MANUFACTURERS: 3M, HILTI, AD

PROVIDE HANGERS AND SUPPORTS TO SECURE

EQUIPMENT IN PLACE, PREVENT VIBRATION, PROTECT

PROVIDE FOR EXPANSION AND CONTRACTION, AND

PIPING EXCEPT HANGERS AND SUPPORTS SHALL BE

AGAINST DAMAGE FROM EARTHQUAKE, MAINTAIN GRADE,

PROVIDE GALVANIZED HANGERS AND SUPPORTS FOR ALL

COPPER PLATED OR EPOXY COATED FOR COPPER PIPING.

TOGGLE HANGERS AND/OR STRAP HANGERS SHALL NOT

POWER ACTUATED FASTENERS AND "DROP-IN" ANCHORS

PROVIDE RING TYPE HANGERS FOR PIPING UP TO NPS 11/2

AND CLEVIS TYPE HANGERS FOR PIPING OVER NPS 11/2.

DRYWALL SURFACE: EXTRUDED ALUMINUM FRAME WITH

GYPSUM BOARD INLAY AND STRUCTURAL CORNER

ELEMENTS. HINGE TO BE CONCEALED 2-POINT HINGE.

NON-CORRODING WITH SCREWDRIVER OPERATED CAM

TILE SURFACE: UNIVERSAL DESIGN, STAINLESS STEEL

FLUSH TO FRAME, ROUNDED SAFETY CORNERS,

CONTINUOUS CONCEALED HINGE. SCREWDRIVER

OPERATED CAM LATCH, #4 SATIN STAINLESS STEEL

DOOR (16GA) AND STAINLESS STEEL FRAME (18GA), DOOR

PLASTER WALLS AND CEILING: STEEL DOOR (14GA) AND

EXPANSION CASING BEAD AND 75 MM WIDE GALVANIZED

FIRE RATED WALLS NON-COMBUSTIBLE CONSTRUCTION:

(16GA), DOOR FLUSH TO FRAME EDGE, 25MM MOUNTING

FRAME WITH MASONRY ANCHOR STRAPS, CONCEALED

INSULATED STEEL DOOR (20GA) FOR MAXIMUM 250°C RISE

SELE-CLOSING HINGE, FLUSH KEY LATCH, PRIME COAT

GREY PAINTED FINISH, ULC RATED 2 HOUR 'B' LABEL.

FIRE RATED WALLS COMBUSTIBLE CONSTRUCTION:

AFTER 30 MINUTES AND STEEL FRAME (16GA), DOOR

FLUSH TO FRAME EDGE, 25MM MOUNTING FRAME WITH

HINGE, FLUSH KEY LATCH, PRIME COAT GREY PAINTED

FIRE RATED CEILINGS: 50MM INSULATED STEEL DOOR

(16GA) AND STEEL FRAME (16GA), DOOR FLUSH TO FRAME

HANDLE LATCH, WHITE BAKED ENAMEL FINISH, SIZE 600MM

DESIGN, GALVANIZED STEEL FRAME (22GA), DOUBLE SKIN

FULLY ENCLOSED IN PANEL BUILB TYPE SEAL INTEGRALLY

GALVANIZED STEEL DOOR (22 GA) WITH 25MM INSULATION

FDGE, 25MM MOUNTING FRAME WITH MASONRY ANCHOR

STRAPS, CONCEALED UPSWING SELF-CLOSING HINGE, L

X 600MM (24" X 24") ULC RATED 2 HOUR 'B' LABEL.

DUCTWORK: ULTRA LOW LEAKAGE TYPE, FLAT OVAL

FASTENED TO DOOR. LEVER CAM LOCKS. PROVIDE

STAINLESS STEEL IN LIEU OF GALVANIZED STEEL IN

ACCEPTABLE MANUFACTURERS: MAXAM, ACUDOR,

DENTIFY PIPING WITH LABELS AND FLOW ARROW

PROVIDE IDENTIFICATION AT 15M (50FT) MAXIMUM

INSULATED PIPES AND B-350 FOR INSULATED PIPES.

VALVE STEMS WITH KEY CHAIN. PROVIDE A VALVE

ANY ASSOCIATED CONTROLS NOMENCLATURE.

PLATES HAVING 6MM (1/4") MINIMUM LETTER SIZE.

NEOPRENE WASHER/BUSHING: A ONE PIECE MOI DED

BRIDGE BEARING NEOPRENE WASHER/BUSHING. THE

A FLAT WASHER FACE TO AVOID METAL TO METAL

ACCEPTABLE MANUFACTURER: MASON HG HEMI

DEFLECTION 2.5 MM (0.1") OR GREATER.

BUSHING SHALL SURROUND THE ANCHOR BOLT AND HAVE

CONTACT. USE WASHER/BUSHING ONLY ON LIGHT-WEIGHT

NEOPRENE PAD ISOLATORS: NEOPRENE OR NEOPRENE /

ACCEPTABLE MANUFACTURER: MASON WMSW OR EQUAL

RUBBER FLOOR MOUNTS: BRIDGE BEARING NEOPRENE

MOUNTINGS. MINIMUM STATIC DEFLECTION OF 5MM (0.2")

OR GREATER AND ALL DIRECTIONAL SEISMIC CAPABILITY.

SPRING FLOOR MOUNTS: SPRING ISOLATORS BUILT INTO A

ACCEPTABLE MANUFACTURER: MASON RAA OR ND OR

DUCTILE IRON OR STEEL HOUSING TO PROVIDE ALL

6MM (1/4") TRAVEL IN ALL DIRECTIONS BEFORE

CONTACTING THE RESILIENT SNUBBING COLLARS

MOLDED NEOPRENE CUP OR 1/4" (6MM) NEOPRENE

SPRING AT RATED LOAD. SPRINGS SHALL HAVE A

THE RATED DEFLECTION.

3. EXECUTION

DIRECTIONAL SEISMIC SNUBBING. THE SNUBBER SHALL

ACOUSTICAL FRICTION PAD BETWEEN THE BASEPLATE

AND THE SUPPORT. SPRING DIAMETERS SHALL BE NO

LESS THAN 0.8 OF THE COMPRESSED HEIGHT OF THE

MINIMUM ADDITIONAL TRAVEL TO SOLID EQUAL TO 50% OF

ACCEPTABLE MANUFACTURER: MASON SSLFH OR EQUAL

STEEL FRAMES CONTAINING MINIMUM 32MM (1 1/4") THICK

NEOPRENE ELEMENTS AT THE TOP AND A STEEL SPRING

CUP ON THE BOTTOM. PROVIDE A COMBINATION RUBBER

AND STEEL REBOUND WASHER AS THE SEISMIC UPSTOP

RUBBER THICKNESS SHALL BE A MINIMUM OF 6MM (1/4")

BOX TYPE HANGERS. TO MAINTAIN STABILITY THE BOXES

SHALL NOT BE ARTICULATED AS CLEVIS HANGERS NOR

ACCEPTABLE MANUFACTURER: MASON HD, HS OR EQUAL

FOR SUSPENDED PIPING, DUCTWORK AND EQUIPMENT

COLOUR CODED SPRINGS, RUST RESISTANT, PAINTED

THE NEOPRENE ELEMENT STACKED ON TOP OF THE

ALTERNATE VIBRATION ISOLATION ACCEPTABLE

MANUFACTURERS, KORFUND, VIBRO-ACOUSTICS

DO PAINTING IN ACCORDANCE WITH DIVISION 09

3.1 PAINTING REPAIRS AND RESTORATION

SEATED IN A STEEL WASHER REINFORCED NEOPRENE

SPRING HANGERS: HANGERS SHALL CONSIST OF RIGID

BE ADJUSTABLE VERTICALLY AND ALLOW A MAXIMUM OF

STEEL / NEOPRENE PAD ISOLATORS. MINIMUM STATIC

ACCEPTABLE MANUFACTURERS: BRADY

2.6 VIBRATION ISOLATION

EQUIPMENT.

**GROMMET OR EQUAL** 

DIRECTORY AT ALL MECHANICAL ROOMS, IN THE O&M

THROUGH WALLS, AT ALL SIDES OF TEES, BEHIND ACCESS

DOORS. USE BRADY B-500 VINYL CLOTH LABELS FOR NON

PROVIDE 20MM (3/4") DIAMETER BRASS TAGS, SECURE TO

MANUALS AND A DIGITAL COPY CROSS REFERENCED WITH

EACH PIECE OF EQUIPMENT SHALL BE IDENTIFIED WITH

ITS EQUIPMENT SCHEDULE IDENTIFICATION, E.G. SUPPLY

FAN SF-1, COOLING COIL CC-1, PUMP P-1 WITH LAMACOID

INTERVALS, BEFORE AND AFTER PIPES PASSING.

MILCOR, CAN.AQUA, MIFAB, BILCO, BAUCOPLUS

STAINLESS STEEL DUCTWORK.

2.5 IDENTIFICATION

FINISH, ULC RATED 1-1/2 HOUR 'B' LABEL

MASONRY ANCHOR STRAPS, CONCEALED SELF-CLOSING

UNINSULATED STEEL DOOR (16GA) AND STEEL FRAME

LATH SURROUND RECESSED 18 MM TO RECEIVE PLASTER,

STEEL FRAME (14GA), DOOR FLUSH TO FRAME EDGE,

CONTINUOUS CONCEALED HINGE. SCREWDRIVER

OPERATED CAM LATCH, PRIME COAT GREY PAINTED

MANUFACTURER FOR THE DESIGNATED

FIRE-RESISTANCE-RATED SYSTEMS.

2.3 PIPE HANGERS AND SUPPORTS

ACCOMMODATE INSULATION.

BE USED FOR PIPE HANGERS.

2.4 ACCESS DOORS

RESTORATION WORK

FIREBARRIER, TREMCO

### 1.19 FLASHING AND ROOF CURBS

1.20 SEISMIC CONTROL

PROVIDE CURBS, FLASH AND COUNTER FLASH AS REQUIRED WHERE MECHANICAL EQUIPMENT PASSES THROUGH WEATHER OR WATERPROOFED WALLS, FLOORS

PROVIDE FACTORY ROOF CURBS FOR ALL ROOF MOUNTED EQUIPMENT UNLESS NOTED OTHERWISE.

PROVIDE SEISMIC RESTRAINTS FOR ALL REQUIRED EQUIPMENT, PIPING, AND DUCTWORK IN ACCORDANCE WITH THE LATEST EDITION OF THE SEISMIC RESTRAINTS MANUAL FOR MECHANICAL SYSTEMS PRODUCED BY SMACNA, AND THE LATEST EDITION OF THE ASHRAE APPLICATION HANDBOOK CHAPTER 49, SEISMIC RESTRAINTS.

THE CONTRACTOR SHALL RETAIN THE SERVICES OF A QUALIFIED PROFESSIONAL SEISMIC ENGINEER (SEISMIC ENGINEER) REGISTERED IN THE PROVINCE OF BRITISH COLUMBIA. THE SEISMIC ENGINEER SHALL DESIGN AND REVIEW THE INSTALLATION OF ALL SEISMIC RESTRAINTS AS WELL AS MECHANICAL EQUIPMENT AND MECHANICAL SYSTEM SUPPORTS THE RESTRAINTS AND SUPPORTS SHALL BE SPECIFICALLY DESIGNED TO FASTEN TO THE STRUCTURE INDICATED IN THE CONTRACT DOCUMENTS AND INSTALLED IN THE FIELD. THE COMPLETE DESIGN FOR THESE SYSTEMS SHALL COMPLY WITH ALL APPLICABLE BUILDING CODE REQUIREMENTS.

SEISMIC ENGINEER SHALL PROVIDE AND SUBMIT TO THE OWNER'S CONSULTANT ASSURANCE OF PROFESSIONAL DESIGN AND COMMITMENT FOR FIELD REVIEW SCHEDULE B AND ASSURANCE OF PROFESSIONAL FIELD REVIEW AND COMPLIANCE SCHEDULE S-B FOR SEISMIC ENGINEERING SUBMIT SHOP DRAWINGS OF ALL SEISMIC RESTRAINT

DETAILS PREPARED AND SEALED BY THE SEISMIC ENGINEER. PRIOR TO SUBSTANTIAL COMPLETION, THE SEISMIC ENGINEER SHALL VISIT THE SITE AND VERIFY THE SEISMIC RESTRAINT INSTALLATION AS REQUIRED TO SATISFY THE ASSURANCE OF PROFESSIONAL FIELD REVIEW AND COMPLIANCE SCHEDULE S-B OF THE BUILDING CODE

THE CONTRACTOR SHALL OBTAIN APPROVAL FOR THE LOCATION OF ALL RESTRAINT FIXING POINTS FROM THE STRUCTURAL ENGINEER, ON SITE, PRIOR TO

WHERE EQUIPMENT IS MOUNTED ON SPRING OR RESILIENT MOUNTS FOR VIBRATION ISOLATION IT SHALL BE THE RESPONSIBILITY OF THE MANUFACTURER OF THE MOUNT TO INCORPORATE SEISMIC RESTRAINT. PROVIDE STEEL FRAME BASES WHERE NECESSARY TO ACHIEVE THIS AND ALSO AVOID OVERTURNING. THE MANUFACTURER SHALL SUPPLY CERTIFICATES, SIGNED BY A PROFESSIONAL ENGINEER REGISTERED WITHIN THE JURISDICTION, VERIFYING THE DESIGN OF THE SEISMIC RESTRAINTS IS IN ACCORDANCE WITH THIS SECTION.

1.21 VIBRATION ISOLATION PROVIDE NEOPRENE ISOLATORS FOR DEFLECTIONS 6MM (1/4") AND UNDER.

PROVIDE EITHER NEOPRENE OR STEEL SPRING ISOLATORS FOR DEFLECTIONS BETWEEN 6MM AND 12MM PROVIDE STEEL SPRING ISOLATORS FOR DEFLECTIONS OF

12MM (1/2") AND OVER. PROVIDE ADJUSTABLE LIMIT STOPS FOR SPRING ISOLATION MOUNTS ON EQUIPMENT WITH OPERATING WEIGHTS SUBSTANTIALLY DIFFERENT FROM THE INSTALLED WEIGHTS

ALL SPRING ISOLATORS SHALL BE "OPEN SPRING" UNLESS OTHERWISE STATED. SEISMICALLY RATED HOUSED SPRING ISOLATORS MAY BE USED IN LIEU PROVIDED THAT THEY MEET THIS PROJECT'S REQUIREMENTS FOR SEISMIC RESTRAINT

SELECT ISOLATORS IN ACCORDANCE WITH EQUIPMENT WEIGHT DISTRIBUTION TO ALLOW FOR AN AVERAGE DEFLECTION MEETING OR EXCEEDING THE SPECIFIED DEFLECTION REQUIREMENTS AND SO THAT NO ISOLATOR HAS A DEFLECTION LESS THAN 80% OF THE STATIC DEFLECTION SPECIFIED. A MINIMUM OF 4 ISOLATORS ARE REQUIRED FOR EACH PIECE OF EQUIPMENT. UNLESS

### SPECIFIED OTHERWISE.

1.22 SUBSTANTIAL AND TOTAL PERFORMANCE PRIOR TO REQUESTING AN INSPECTION FOR SUBSTANTIAL PERFORMANCE, PROVIDE A COMPLETE LIST OF ITEMS, WHICH ARE DEFICIENT.

A CERTIFICATE OF SUBSTANTIAL PERFORMANCE WILL NOT BE GRANTED UNLESS THE FOLLOWING ITEMS ARE COMPLETED AND AVAILABLE TO THE OWNER'S CONSULTANT:

FINAL PLUMBING INSPECTION CERTIFICATE FROM THE AUTHORITY HAVING JURISDICTION.

SCHEDULE S-B FOR SEISMIC ENGINEERING. FINAL BACKFLOW PREVENTION TEST REPORTS FOR ALL BACKFLOW DEVICES.

FIRE STOPPING AND FIRE DAMPER TEST LETTER DRAFT OPERATING/MAINTENANCE MANUALS HAVE BEEN SUBMITTED FOR REVIEW. ALL MECHANICAL SYSTEMS HAVE BEEN COMMISSIONED

AND ARE CAPABLE OF OPERATION WITH ALARM CONTROLS FUNCTIONAL AND AUTOMATIC CONTROLS IN OPERATION.

AIR AND WATER SYSTEMS HAVE BEEN BALANCED WITH DRAFT REPORT SUBMITTED TO THE CONSULTANT. OPERATING AND MAINTENANCE DEMONSTRATIONS HAVE BEEN PROVIDED TO THE OWNER.

RECORD DRAWINGS HAVE BEEN SUBMITTED. ALL PREVIOUSLY IDENTIFIED DEFICIENCIES HAVE BEEN CORRECTED AND ACCEPTED PRIOR TO A TOTAL PERFORMANCE INSPECTION PROVIDE DECLARATION IN WRITING THAT SUBSTANTIAL

PERFORMANCE DEFICIENCIES HAVE BEEN CORRECTED AND FINAL TAB REPORTS AND O&M MANUALS HAVE BEEN SUBMITTED. THE CONSULTANT SHALL PROVIDE ONE (1) VISITATION FOR THE PURPOSE OF TOTAL PERFORMANCE INSPECTION. SUBSEQUENT VISITATIONS IF REQUIRED SHALL BE AT THE

### 2. PRODUCTS

EXPENSE OF THE CONTRACTOR

### 2.1 ACCEPTABLE MANUFACTURERS

LISTED MANUFACTURERS ARE ACCEPTABLE FOR THEIR ABILITY TO MEET THE GENERAL DESIGN INTENT, QUALITY AND PERFORMANCE CHARACTERISTICS OF THE SPECIFIED PRODUCT. THE LIST DOES NOT ENDORSE THE ACCEPTABILITY OF ALL PRODUCTS AVAILABLE FROM THE LISTED MANUFACTURERS/SUPPLIERS.

IT REMAINS THE RESPONSIBILITY OF THE CONTRACTOR TO ENSURE THE PRODUCTS SUPPLIED ARE EQUAL TO THE SPECIFIED PRODUCTS IN EVERY RESPECT. OPERATE AS INTENDED, AND MEET THE PERFORMANCE SPECIFICATIONS AND PHYSICAL DIMENSIONS OF THE SPECIFIED PRODUCT.

THE CONTRACTOR SHALL BE FULLY RESPONSIBLE FOR ANY ADDITIONAL WORK OR MATERIALS, TO ACCOMMODATE THE USE OF EQUIPMENT FROM THE

ACCEPTABLE MANUFACTURERS AND SUPPLIERS LISTED. INTERIOR PAINTING PRIME AND TOUCH UP MARRED FINISHED PAINTWORK TO MATCH ORIGINAL. RESTORE TO NEW CONDITION, FINISHES WHICH HAVE BEEN DAMAGED. USE THE SAME MANUFACTURER THROUGHOUT THE CLEAN EXPOSED BARE METAL SURFACES SUPPLIED PROJECT AND COMPATIBLE MATERIALS FOR UNDER DIVISIONS 21, 22, 23 AND 25, APPLY AT LEAST ONE COAT OF CORROSION RESISTANT PRIMER PAINT TO ALL SUPPORTS AND EQUIPMENT FABRICATED FROM FERROUS PROVIDE FILL MATERIAL COMPONENTS FOR EACH FIRESTOPPING SYSTEM AS NEEDED. USE ONLY

### 3.2 DEMONSTRATION

SUPPLY TOOLS, EQUIPMENT, PERSONNEL TO DEMONSTRATE AND INSTRUCT THE OPERATING. AND MAINTENANCE PERSONNEL IN OPERATING, CONTROLLING ADJUSTING TROUBLE-SHOOTING AND SERVICING OF ALL SYSTEMS AND EQUIPMENT DURING REGULAR WORK HOURS, PRIOR TO ACCEPTANCE.

3.3 FIRESTOPPING AND SMOKE SEALS THE OWNER'S CONSULTANT SHALL CONDUCT MANDATORY DESTRUCTIVE REVIEWS FOR EACH TYPE OF INSTALLATION. DESTRUCTIVE TESTING SHALL BE AT THE DISCRETION OF THE OWNER'S CONSULTANT AND AUTHORITY HAVING JURISDICTION

ALLOW FOR DESTRUCTIVE TESTING OF 5% OF FIRE STOPPING APPLICATIONS, SHOULD INSTALLATIONS NOT CONFORM TO MANUFACTURER'S LISTED ASSEMBLY. AN ADDITIONAL 25% OF INSTALLATIONS MAY BE DESTRUCTIVELY TESTED AND SHOULD THERE BE MORE FAILURES, THE CONTRACTOR WILL BE RESPONSIBLE TO REMOVE ALL FIRE STOPPING PRODUCTS AND REINSTALL PRODUCTS CORRECTLY, AT NO ADDITIONAL COST TO THE TAG ALL PENETRATIONS AND EVERY 3 METERS OF JOINT

PRODUCT, SYSTEM #, DATE INSTALLED, INSTALLED BY: (NAME AND PHONE NUMBER OF SUBCONTRACTOR) AND RE-PENETRATED BY & DATE. TAGS SHALL STATE: CAUTION! FIRESTOP - DO NOT REMOVE, PUNCTURE OR DISCONTINUE UNLESS PREPARED TO RE-SEAL IMMEDIATELY WITH SPECIFIED

SFAL WITH PRINTED TAGS. TAGS SHALL INDICATE

COMPLY WITH MANUFACTURER'S INSTRUCTIONS FOR INSTALLATION OF THROUGH-PENETRATION JOINT MATERIALS. WHERE POSSIBLE, USE METAL SLEEVES FOR FLOOR PENETRATIONS TO PREVENT/MITIGATE THE CONSEQUENCES OF LEAKAGE OR FLOODING. PERFORM UNDER THIS SECTION PATCHING AND REPAIRING OF FIRESTOP CAUSED BY CUTTING OR

PENETRATING OF EXISTING FIRESTOP SYSTEMS ALREADY

### INSTALLED BY OTHER TRADES. 3.4 PIPE HANGERS AND SUPPORTS

PRODUCT

PIPE SUPPORT SPACING AND HANGER ROD DIAMETER SHALL BE: PIPE SIZE: NPS 1/2 ROD DIAMETER 9MM (3/8"), SPACING 1.8M (6') PIPE SIZE: NPS 3/4 TO 11/2 ROD DIAMETER 9MM (3/8"), SPACING 2.4M (8') PIPE SIZE: NPS 2 TO 21/2 ROD DIAMETER 9MM (3/8"), SPACING 3M (10')

PIPE SIZE: NPS 3 TO 4 ROD DIAMETER 16MM (5/8"), SPACING 3.6M (12') PIPE SIZE: NPS 6 TO 12 ROD DIAMETER 22MM (7/8"), SPACING 4.3M (14')

3.5 PIPE PRESSURE TESTING ADVISE CONSULTANT OR PROJECT MANAGER 48 HOURS MINIMUM PRIOR TO PERFORMANCE OF PRESSURE TESTS. HYDROSTATIC TEST: 150% OF WORKING PRESSURE, BUT NOT LESS THAN 860 KPA (125 PSIG). MAINTAIN TEST PRESSURE WITHOUT LOSS FOR 4 HOURS MINIMUM UNLESS SPECIFIED FOR LONGER PERIOD OF TIME IN RELEVANT MECHANICAL SECTIONS. FOR PP-R PIPING. DO NOT EXCEED 1034 KPA (150 PSI). FOR PEX PIPING, DO NOT EXCEED 690 KPA (100 PSI).

PRIOR TO TESTS, ISOLATE EQUIPMENT AND OTHER PARTS WHICH ARE NOT DESIGNED TO WITHSTAND TEST PRESSURE OR MEDIA.

CONDUCT TESTS IN PRESENCE OF CONSTRUCTION MANAGER OR PROJECT MANAGER. EXAMINE ALL JOINTS FOR LEAKS AND REMAKE ALL LEAKING JOINTS WITH NEW MATERIALS. PAY COSTS FOR REPAIRS OR REPLACEMENT, RETESTING, AND MAKING GOOD. CONSULTANT TO DETERMINE WHETHER REPAIR OR REPLACEMENT IS APPROPRIATE

INSULATE OR CONCEAL WORK ONLY AFTER APPROVAL AND CERTIFICATION OF TESTS BY AUTHORITIES. SUBMIT COPIES OF PRESSURE TEST REPORTS FOR ALL

#### SECTIONS OF PIPING. 3.6 ACCESS DOORS

PROVIDE ALL ACCESS DOORS REQUIRED TO ACCESS WORK INSTALLED BY DIVISIONS 21, 22, 23 AND 25. BE RESPONSIBLE FOR COORDINATING LOCATIONS, CUTTING OPENING AND INSTALLING PANELS. ANY SECONDARY SUPPORTS, BLOCKING FTC, WILL BE BY THE CEILING OR WALL CONTRACTOR. ENSURE THAT EQUIPMENT IS WITHIN VIEW AND ACCESSIBLE FOR OPERATING, INSPECTING,

### ADJUSTING, SERVICING WITHOUT USING SPECIAL TOOLS

3.7 VIBRATION ISOLATION NEOPRENE WASHER/BUSHING: ISOLATE VARIABLE FREQUENCY DRIVE CONTROLLER USING NEOPRENE WASHER/BUSHING ISOLATORS OR SOFT GROMMETS SUCH THAT STRUCTURE BORNE NOISE TRANSMISSION TO OCCUPIED SPACE IS LESS THAN AIRBORNE NOISE TRANSMISSION.

RUBBER FLOOR MOUNTS: MOUNT IN-LINE PUMPS ON TWO (2) RUBBER FLOOR MOUNT ISOLATORS UNDER EACH SUPPORT FOOT. FOR EQUIPMENT MOUNTED ON A SLAB ON GRADE MOUNT ON RUBBER FLOOR MOUNT ISOLATORS UNLESS OTHERWISE SPECIFIED. PROVIDE PROTECTION OF THE RUBBER ELEMENT FROM CONTACT WITH OIL IN THE MECHANICAL ROOM.

SPRING FLOOR MOUNTS: ISOLATE ALL FLOOR OR PIER MOUNTED EQUIPMENT ON SPRING FLOOR MOUNT ISOLATORS, UNLESS OTHERWISE SPECIFIED.

SPRING HANGERS: LOCATE ISOLATION HANGERS AS NEAR TO THE OVERHEAD SUPPORT STRUCTURE AS POSSIBLE. INSTALLATION SHALL PERMIT HANGER BOX OR ROD TO MOVE THROUGH A 30 DEGREES ARC WITHOUT METAL TO METAL CONTACT, ALL DISCHARGE DUCTWORK RUNS FOR A DISTANCE OF 15M (50') FROM THE CONNECTED EQUIPMENT SHALL BE ISOLATED FROM THE BUILDING STRUCTURE BY MEANS OF SPRING HANGERS. SPRING DEFLECTION SHALL BE A MINIMUM OF 19MM (0.75").

### **DIVISION 23 HVAC**

**TREATMENT** 

EMPLOY SERVICES OF THE EXISTING BUILDING'S WATER TREATMENT FIRM OR IF THERE IS NOT ONE, A FIRM SPECIALIZING IN HYDRONIC SYSTEM CHEMICAL TREATMENT. THIS FIRM SHALL SUBMIT A SCHEDULE OF WORK TO BE PERFORMED, CHEMICAL TYPES AND QUANTITY TO BE USED. AT THE COMPLETION OF THE CHEMICAL TREATMENT A REPORT SHALL BE SUBMITTED TO OUTLINE THE WORK PERFORMED AND DETAILS OF PROCEDURES TO BE USED BY THE BUILDING OPERATOR

1.1 SYSTEM CLEANING AND CHEMICAL TREATMENT

PROVIDE TEST KITS AS REQUIRED ALONG WITH ADEQUATE CHEMICALS AND REAGENTS FOR ONE YEAR OF TESTING. APPROPRIATE TEST KITS WILL BE PROVIDED TO PROPERLY TEST EACH SYSTEM INSTALLED UNDER THIS CONTRACT.

FOR CONTINUED WATER QUALITY TESTING AND CHEMICAL

CLEAN AND FLUSH ALL NEW HOT AND COLD CLOSED LOOP WATER SYSTEM PIPING. PROVIDE A CERTIFICATE FOR

### 1.2 GRILLES, LOUVERS AND DIFFUSERS

AIRFLOW TESTS AND SOUND LEVEL MEASUREMENT SHALL BE MADE IN ACCORDANCE WITH APPLICABLE ADC EQUIPMENT TEST CODES, ASHRAE STANDARDS AND AMCA

MANUFACTURER SHALL CERTIFY CATALOGUED PERFORMANCE AND ENSURE CORRECT APPLICATION OF AIR OUTLET TYPES.

OUTSIDE LOUVERS SHALL BEAR AMCA SEAL FOR FREE AREA AND WATER PENETRATION

PROJECT CONDITIONS: REVIEW REQUIREMENTS OF OUTLETS AS TO SIZE, FINISH AND TYPE OF MOUNTING PRIOR TO SUBMITTING SHOP DRAWINGS AND SCHEDULES OF OUTLETS. POSITIONS INDICATED ARE APPROXIMATE ONLY. CHECK LOCATIONS OF OUTLETS AND MAKE NECESSARY ADJUSTMENTS IN POSITION TO CONFORM WITH ARCHITECTURAL FEATURES, SYMMETRY, AND LIGHTING ARRANGEMENT.

### 2. PRODUCTS

2.1 DUCTWORK AND ACCESSORIES

PROVIDE DUCTWORK CONSTRUCTED, REINFORCED, SEALED, AND INSTALLED TO WITHSTAND 1-1/2 TIMES THE WORKING STATIC PRESSURE.

PROVIDE LOW PRESSURE DUCTWORK 500 PA (2" W.G.) FOR SUPPLY DUCTWORK AND PLENUMS ON SYSTEMS WITHOUT TERMINAL MIXING BOXES OR AIR VALVES, SUPPLY DUCTWORK DOWNSTREAM FROM TERMINAL MIXING BOXES OR AIR VALVES, OUTDOOR AIR DUCTWORK AND PLENUMS, RETURN AIR DUCTWORK AND PLENUMS, EXHAUST AND RELIEF AIR DUCTWORK AND PLENUMS, UNLESS NOTED OTHERWISE.

LOW PRESSURE INSULATED FLEXIBLE DUCTWORK SHALL BE EQUAL TO THERMAFLEX TYPE M-KC.

PROVIDE MEDIUM PRESSURE DUCTWORK TO 1000 PA (4"W.G.) FOR SUPPLY AIR DUCTWORK DOWNSTREAM FROM SUPPLY AIR HANDLING UNITS DISCHARGE, TO TERMINAL MIXING BOXES OR AIR VALVES, EXHAUST AND RETURN AIR DUCTWORK DOWNSTREAM OF RETURN/EXHAUST AIR VALVES TO THE RETURN/EXHAUST FANS AND DISCHARGE DUCTWORK FROM THE RETURN/EXHAUST FANS TO THE AIR HANDLING UNITS AND/OR RELIEF OPENING.

WHERE FLEXIBLE AIR DUCTS ARE USED TO CONNECT TERMINAL MIXING BOXES OR AIR VALVES TO METAL DUCTS, THE FLEXIBLE AIR DUCTS SHALL BE RATED FOR 30.5 M/S (6000 FPM) VELOCITY AND 2500 PA (10" W.G.). MAXIMUM STRETCHED LENGTH OF FLEXIBLE AIR DUCT SHALL BE 300 MM (12"). DO NOT USE FLEXIBLE DUCT TO CHANGE DIRECTION. WHERE FLEXIBLE AIR DUCTS ARE ATTACHED TO METAL INSULATED DUCT, FURNISH FLEXIBLE AIR DUCTS WITH FIBERGLASS WOOL INSULATION AND METALIZED JACKET. THERMAFLEX M-KC OR EQUAL.

### 2.2 DUCT SEALING

DUCT SEALING LOW PRESSURE DUCTWORK 500 PA (2" W.G.) AND UNDER SHALL BE SMACNA SEAL CLASS A. SEAL ALL SUPPLY, RETURN AND EXHAUST DUCT JOINTS, LONGITUDINAL AS WELL AS TRANSVERSE JOINTS AS FOLLOWS:

SLIP JOINTS: APPLY HEAVY BRUSH-ON HIGH PRESSURE DUCT SEALANT. APPLY SECOND APPLICATION AFTER THE FIRST APPLICATION HAS COMPLETELY DRIED OUT. WHERE METAL CLEARANCE EXCEEDS 1.5 MM (1/16") USE HEAVY MASTIC TYPE SEALANT.

FLANGED JOINTS: SOFT ELASTOMER BUTYL OR EXTRUDED FORM OF SEALANT BETWEEN FLANGES FOLLOWED BY AN APPLICATION OF HEAVY BRUSH-ON HIGH PRESSURE DUCT SEALANT.

OTHER JOINTS: HEAVY MASTIC TYPE SEALANT. DUCT SEALING MEDIUM PRESSURE DUCTWORK TO 1000 PA (4"W.G.) SHALL BE THE SAME AS 500 PA DUCTWORK EXCEPT PROVIDE A COMBINATION OF WOVEN FABRICS AND SEALING COMPOUND FOLLOWED BY AN APPLICATION OF HIGH PRESSURE DUCT SEALANT.

DUCT TAPES AS A SEALING METHOD ARE NOT PERMITTED, EXCEPT ON RESIDENTIAL DUCTWORK - MINIMUM 2 WRAPS OF 2" WIDE (50MM) FOIL DUCT TAPE IS ACCEPTABLE. DO NOT INSULATE ANY SECTION OF THE DUCTWORK UNTIL IT HAS BEEN INSPECTED AND APPROVED OF DUCT

### SEALANT APPLICATION, BY THE CONSULTANT. 2.3 DUCT HANGERS AND SUPPORTS

HANGERS AND SUPPORTS TO SMACNA STANDARDS STRAP HANGERS: OF SAME MATERIAL AS DUCT BUT NEXT SHEET METAL THICKNESS HEAVIER THAN DUCT. MAXIMUM SIZE DUCT SUPPORTED BY STRAP HANGER: 500

HANGERS: GALVANIZED STEEL ANGLE WITH GALVANIZED STEEL RODS TO SMACNA. TOGGLE HANGERS AND/OR STRAP HANGERS SHALL NOT

BE USED. POWER ACTUATED FASTENERS AND "DROP-IN" ANCHORS SHALL NOT BE USED.

### 2.4 DUCT AND BREECHING INSULATION

EXPOSED RECTANGULAR DUCTS: EXTERNAL RIGID INSULATION, SERVICE TEMPERATURE 5°C TO 232°C (41°F TO 450°F), MINERAL FIBER BOARD FOR LOW AND MEDIUM TEMPERATURE APPLICATIONS, ALL SERVICE ALUMINUM FOIL-SCRIM KRAFT (FSK) VAPOUR BARRIER JACKET WITH GLASS FIBRE REINFORCEMENT. FACTORY APPLIED. DENSITY 36KG/M3 (2.25 PCF), MINIMUM RSI 0.76/25MM (R

ROUND DUCTS AND CONCEALED RECTANGULAR DUCTS: EXTERNAL FLEXIBLE INSULATION, SERVICE TEMPERATURE 5°C TO 232°C (41°F TO 450°F), GLASS FIBER OR MINERAL FIBER FLEXIBLE BLANKET FOR LOW AND MEDIUM TEMPERATURE APPLICATIONS, ALL SERVICE ALUMINUM FOIL-SCRIM KRAFT (FSK) VAPOUR BARRIER JACKET WITH GLASS FIBRE REINFORCEMENT, FACTORY APPLIED. DENSITY 12KG/M3 (0.75PCF), MINIMUM RSI 0.49/25MM (R 2.8/IN) (INSTALLED)

ACOUSTIC LINING DUCTS: INTERNAL FLEXIBLE DUCT LINER, FLEXIBLE MINERAL FIBER BLANKET, FOR LOW AND MEDIUM TEMPERATURE ACOUSTICAL APPLICATIONS, AIRSTREAM SURFACE FACED WITH A BLACK MAT BONDED TO THE FIBREGLASS SUBSTRATE, AIR VELOCITY RATING 25.4 M/S (5,000 FT/MIN). DENSITY 24KG/M3 (1.5 PCF), MINIMUM RSI 0.74/25MM (R 4.2/IN) ACOUSTIC LINING PLENUMS: INTERNAL RIGID DUCT LINER,

TEMPERATURE ACOUSTICAL APPLICATIONS. AIRSTREAM SURFACE FACED WITH A BLACK MAT BONDED TO THE FIBREGLASS SUBSTRATE, AIR VELOCITY RATING 25.4 M/S (5,000 FT/MIN). DENSITY 48KG/M3 (3 PCF), MINIMUM RSI 0.76/25MM (R 4.3/IN) BREECHING INSULATION: EXTERNAL SEMI-RIGID

INSULATION, SERVICE TEMPERATURE UP TO 538°C

RIGID MINERAL FIBER BOARD, FOR LOW AND MEDIUM

(1000°F), GLASS FIBER OR MINERAL FIBER FLEXIBLE BLANKET FOR HIGH TEMPERATURE APPLICATIONS. DENSITY 25KG/M3 (1.6PCF), MINIMUM RSI 0.25/25MM (R

### 2.5 DUCTWORK FINISH JACKETS

THERMOCANVAS JACKET: FIRE RATED, 170G (6 OZ) FIRE RETARDANT CANVAS JACKET FOR COVERING MECHANICAL INSULATION INDOORS, 25/50 FIRE CLASS. PLAIN WAVE COTTON, NO DYES. UTILITY FINISH: OVER RIGID INSULATION FOR

RECTANGULAR DUCTWORK AND FLEXIBLE INSULATION FOR ROUND DUCTWORK. APPLY CONTINUOUS METAL CORNER BEAD TO ALL CORNERS. ADHERE VAPOR RETARDER TAPE OVER ALL JOINTS AND BREAKS IN VAPOR RETARDER, AND AT ALL CORNERS.

ALUMINUM JACKET: 51 MIL (22 GA.) THICK STUCCO OR SMOOTH ALUMINUM JACKETING WITH LONGITUDINAL SLIP JOINTS AND 50MM (2") END LAPS WITH FACTORY APPLIED PROTECTIVE LINER ON INTERIOR SURFACE.

### 2.6 GRILLES, LOUVERS AND DIFFUSERS ACCEPTABLE MANUFACTURES FOR AIR TERMINALS: E.H. PRICE, TITUS, ANEMOSTAT, NAILOR.

ACCEPTABLE MANUFACTURERS FOR LOUVERS: AIROLITE, PENN, AIRSTREAM, WEST VENT, NAILOR, RUSKIN. PROVIDE BAFFLES TO DIRECT AIR AWAY FROM WALLS, COLUMNS OR OTHER OBSTRUCTIONS WITHIN THE RADIUS OF DIFFUSER OPERATION.

PROVIDE PLASTER FRAME FOR DIFFUSERS LOCATED IN PLASTER SURFACES AND ANTI-SMUDGE FRAMES OR PLAQUES ON DIFFUSERS LOCATED IN ROUGH TEXTURED SURFACES SUCH AS ACOUSTICAL PLASTER. PROVIDE 30 MM MARGIN FRAME ON GRILLES WITH [COUNTERSUNK SCREW HOLES] [CONCEALED FASTENING]. PROVIDE OPPOSED BLADE BALANCE DAMPER,

ACCESSIBLE FROM GRILLE FACE ON ALL GRILLES

LOCATED IN DRYWALL CEILINGS OR BULKHEADS.

ALL GRILLES AND DAMPERS SHALL BE ALUMINUM IN WET AREAS (I.E. SHOWERS, AQUATIC AREAS, DISHWASHING IN GYMNASIUM, AQUATIC CENTRES, FRONT BLADES SHALL

BE FRONT PIVOTED, WELDED IN PLACE OR SECURELY

FASTENED TO BE IMMOBILE. FABRICATE GOOSENECKS OF MINIMUM 1.3 MM (18 GA.) GALVANIZED STEEL. MOUNT ON MINIMUM 300 MM (12 IN.) HIGH CURB BASE WHERE SIZE EXCEEDS 225 MM X 225 MM (9 IN. X 9 IN).

REFER TO GRILLES AND DIFFUSER SCHEDULE FOR TYPES

### 2.7 EQUIPMENT

3.1 DUCTWORK AND ACCESSORIES

AND CAPACITIES.

INTENDED USE. 3. EXECUTION

FABRICATE DUCTWORK IN ACCORDANCE WITH SMACNA

DUCT CONSTRUCTION STANDARDS - METAL AND FLEXIBLE,

ALL EQUIPMENT SHALL BE CSA APPROVED FOR ITS

NFPA 90A STANDARD FOR THE INSTALLATION OF AIR-CONDITIONING AND VENTILATING SYSTEMS, AND NFPA 90B STANDARD FOR THE INSTALLATION OF WARM AIR HEATING AND AIR-CONDITIONING SYSTEMS PRIOR TO FABRICATION OF DUCTWORK, CHECK ALL

CEILING SPACES AND HEIGHTS AND CONFLICTS WITH

OTHER TRADES. DUCT SIZES INDICATED ARE INSIDE CLEAR DIMENSIONS FOR ACOUSTICALLY LINED OR INTERNALLY INSULATED DUCTS ALLOW FOR INSULATION THICKNESS AND MAINTAIN

INTERIOR CLEAR DIMENSIONS INDICATED. CONNECT OUTLET TERMINALS TO LOW PRESSURE DUCTS WITH 900MM (36") MAXIMUM LENGTH OF STRETCHED FLEXIBLE DUCT. HOLD IN PLACE WITH STRAP OR CLAMP. CAULK SEALED. DO NOT USE FLEXIBLE DUCT TO CHANGE DIRECTIONS.

PRESSURE DUCTS ARE CONNECTED TO FAN EQUIPMENT, TERMINAL BOXES OR ANY OTHER APPARATUS. JOINT SHALL BE SCREWED OR BOLTED FLEXIBLE GASKETED JOINT, MINIMUM 50MM (2") WIDE. PROVIDE FIRE DAMPERS WHERE DUCTS CROSS FIRE

SEPARATIONS. FIRE DAMPERS SHALL BE ULC LISTED AND

"DYNAMIC"; RATED TO CLOSE UNDER AIRFLOW. REFER TO

PROVIDE A FLEXIBLE CONNECTION WHERE LOW

ARCHITECTURAL DRAWINGS FOR FIRE SEPARATION RATINGS AND LOCATIONS. PROVIDE BALANCING DAMPERS WHERE INDICATED ON DRAWINGS AND AT POINTS ON LOW PRESSURE SUPPLY, RETURN AND EXHAUST DUCTS WHERE BRANCHES ARE

TAKEN FROM LARGER DUCTS. MODIFY CEILING SYSTEM WHERE REQUIRED TO

ACCOMMODATE GRILLES AND DIFFUSERS. SIZE ROUND DUCTS, INSTALLED IN PLACE OF RECTANGULAR DUCTS, FROM ASHRAE TABLE OF EQUIVALENT RECTANGULAR AND ROUND DUCTS. NO VARIATION OF DUCT CONFIGURATION OR SIZES PERMITTED EXCEPT BY PERMISSION FROM THE

CONSULTANT. EXPOSED ROUND DUCTWORK TO BE SPIRAL LOCK SEAM TYPE ONLY.

PROVIDE DUCT HANGERS AND SUPPORTS IN

OTHERWISE.

6MM ROD SIZE

10MM ROD SIZE

10MM ROD SIZE

ACCORDANCE WITH SMACNA MANUALS. CONFIRM THE EXISTING BASE BUILDING STANDARDS PRIOR TO SUBMITTING PROPOSAL. DUCTWORK SHALL BE GALVANIZED STEEL UNLESS NOTED

3.2 DUCT HANGERS AND SUPPORTS DUCT SUPPORT SHALL BE: UP TO 750MM DUCT SIZE: ANGLE SIZE 25X25X3 MM WITH 6MM ROD SIZE

751 TO 1050MM DUCT SIZE: ANGLE SIZE 40X40X3 MM WITH

1051 TO 1500MM DUCT SIZE: ANGLE SIZE 40X40X3 MM WITH 10MM ROD SIZE 1501 TO 2100MM DUCT SIZE: ANGLE SIZE 50X50X3 MM WITH

2101 TO 2400MM DUCT SIZE: ANGLE SIZE 50X50X5 MM WITH 10MM ROD SIZE 2401 AND OVER DUCT SIZE: ANGLE SIZE 50X50X6 MM WITH

UPPER HANGER ATTACHMENTS SHALL BE: FOR CONCRETE: MANUFACTURED CONCRETE INSERTS. FOR STEEL JOIST: MANUFACTURED JOIST CLAMP.

FOR STEEL BEAMS: MANUFACTURED BEAM CLAMPS.

3.3 DUCT AND PLENUM INSULATION INSTALL ALL DUCTWORK INSULATION TO THE THERMAL INSULATION ASSOCIATION OF CANADA BEST PRACTICES GUIDE.

BLACK.

3.4 GRILLES, LOUVERS AND DIFFUSERS PAINT DUCTWORK VISIBLE BEHIND AIR OUTLETS MATTE

ALL AIR OUTLETS MOUNTED IN A T-BAR CEILING SHALL BE SEISMICALLY RESTRAINED BY EITHER SECURE ATTACHMENT TO SOLID DUCTWORK, WHICH IS BRACED AT THE OUTLET OR WIRE HANGERS ATTACHED TO STRUCTURE. WIRE HANGERS SHALL BE A MINIMUM OF TWO (2) PER OUTLET AND ONE PER 1200 MM LENGTH. AIR OUTLETS OTHER THAN T-BAR MOUNTING MUST BE SECURELY ATTACHED TO THE BUILDING ELEMENTS.

**DIVISION 25 INTEGRATED AUTOMATION** 

#### GENERAL 1.1 SECTION SCOPE

PROVIDE A COMPLETE SYSTEM OF AUTOMATIC CONTROLS TO MATCH THE BASE BUILDING STANDARD WITH REGARD TO CONTROL DEVICES, COMPONENTS, WIRING AND MATERIALS. ALL CONTROL WORK ASSOCIATED WITH THE WORK OF DIVISIONS 22 AND 23.

THIS SECTION OF THE SPECIFICATION FORMS PART OF

### 1.2 RELATED REQUIREMENTS

INTERPRETED AND COORDINATED WITH ALL OTHER PARTS. FOR GENERAL CONDITIONS REFER TO HEATING, VENTILATION AND AIR CONDITIONING (HVAC) SECTION. 1.3 CODE COMPLIANCE ALL WORK SHALL COMPLY WITH CURRENT EDITIONS OF THE NATIONAL, PROVINCIAL AND MUNICIPAL CODES,

STANDARDS, ACTS AND BYLAWS AND WILL MEET THE

THE CONTRACT DOCUMENTS AND IS TO BE READ,

JURISDICTION. 1.4 ACCEPTABLE CONTRACTORS ALL CONTROLS WORK IS TO BE DONE BY THE BASE BUILDING CONTRACTOR(FILL IN NAME).

REQUIREMENTS OF THE AUTHORITY HAVING

1.5 EXAMINATION OF EXISTING SYSTEM THIS PROJECT INVOLVES RENOVATION TO AN EXISTING CONTROL SYSTEM. THE CONTRACTOR SHALL INSPECT

INCLUDE IN HIS PROPOSAL ALL CONTROL COMPONENTS REQUIRED TO PROVIDE A FULLY OPERATIONAL SYSTEM INCLUDING REPLACEMENT OF EXISTING DEFECTIVE COMPONENTS WHERE NOTED IN THE PROJECT DOCUMENTS.

ENERGY MONITORING AND CONTROL SYSTEM EMCS.

SUPPLY SUFFICIENT PROGRAMMABLE CONTROLLERS OF

TYPES TO MEET PROJECT REQUIREMENTS. QUANTITY AND

THE SYSTEM PRIOR TO PROPOSAL SUBMISSION AND

#### 1.6 DESIGN REQUIREMENTS DESIGN AND PROVIDE CONDUIT AND WIRING LINKING ELEMENTS OF SYSTEM TO THE EXISTING BUILDING

POINTS CONTENTS AS REVIEWED BY CONSULTANT PRIOR TO INSTALLATION. PROVIDE UTILITY POWER TO EMCS AS INDICATED. RETAIN THE SERVICES OF A QUALIFIED ELECTRICIAN TO PROVIDE POWER AND DATA CABLING TO EACH BUILDING AUTOMATION SYSTEM (BMS) CONTROL PANEL. POWER WIRING AND CONDUIT AS WELL AS DATA CABLING AND

CONDUIT SHALL COMPLY WITH THE ELECTRICAL

SPECIFICATIONS FOR THIS PROJECT, REFER TO

ELECTRICAL DRAWINGS FOR ELECTRICAL PANELBOARD

#### AND COMMUNICATION ROOM LOCATIONS. MAKE ALL NECESSARY ALLOWANCES FOR BRANCH BREAKERS REQUIRED TO BMS PANELS.

2. PRODUCTS 2.1 THERMOSTATS RELOCATE AND RECONNECT EXISTING THERMOSTATS AS

SHOWN ON THE DRAWINGS. PROVIDE NEW THERMOSTATS WHERE INDICATED OF BUILDING STANDARD TYPE. ENSURE OPERATING CHARACTERISTICS ARE COMPATIBLE WITH CONTROL COMPONENTS (I.E. DIRECT/REVERSE ACTING). ALL THERMOSTATS TO BE WALL OR COLUMN MOUNTED [TO MATCH EXISTING BASE BUILDING MOUNTING HEIGHT] [AT 1200MM ABOVE FINISHED FLOOR] UNLESS SPECIFICALLY NOTED OTHERWISE

ALL THERMOSTATS, EXISTING AND NEW, ARE TO BE

CALIBRATED PRIOR TO AIR BALANCING. CONTACT

#### BUILDING OWNER IF AN EXISTING THERMOSTAT NEEDS REPLACING.

NOTED OTHERWISE.

2.2 CONTROL COMPONENTS PROVIDE CONTROL VALVES AND DAMPER ACTUATORS AS REQUIRED TO MEET THE SEQUENCE OF OPERATION AND MEET THE DESIGN INTENT. VALVES AND ACTUATORS SHALL MATCH THE BASE BUILDING STANDARD UNLESS

CONTROL VALVES FOR NEW MECHANICAL EQUIPMENT SHALL BE PROVIDED BY CONTROLS CONTRACTOR FOR INSTALLATION BY THE MECHANICAL CONTRACTOR. WHERE EXISTING DEVICES ARE RE-USED, VERIFY OPERATION AND RE-CALIBRATE AS REQUIRED. VERIFY CORRECT OPERATION OF CONTROLLED DEVICES INCLUDING EXISTING [AIR VALVE ACTUATORS], CONTROL VALVES, ETC. WITHIN THE AREA OF RENOVATION. CONTROL VALVES AND ACTUATORS TO BE COMPATIBLE WITH BASE BUILDING STANDARD UNLESS NOTED OTHERWISE. NEW CONTROL VALVE OPERATION TO BE COMPATIBLE WITH EXISTING.

REPORT ANY EXISTING CONTROL DEVICE WHICH NEED REPLACEMENT. REPLACEMENT WILL BE BY BUILDING MANAGEMENT OR VIA CHANGE ORDER, AT THE DISCRETION OF THE OWNER.

#### 3. EXECUTION 3.1 GENERAL

IN GENERAL ALL CONTROLS PROVIDED SHALL BE STAND

ALONE CONTROLS. CONTRACTOR TO PROVIDE ALL REQUIRED CONTROL DEVICES, THERMOSTATS, WIRING, AND CONTROLLERS TO MEET DESIGN INTENT.

200 - 638 Smithe St Vancouver BC, V6B 1E3 T.604-684-5995 amegroup.ca

drawing and design is the property of the designer to be used o for the project named below. This page or any portion thereof sha nly be reproduced with express written permission

THE CONTRACTOR SHALL CHECK AND VERIFY ALL DIMENSIONS AND REPORT ALL ERRORS AND OMISSIONS TO THE CONSULTANT PRIOR TO COMMENCING THE WORK. THESE DRAWINGS ARE NOT TO BE SCALED. EV. DATE DESCRIPTION 2024.08.21 ISSUED FOR REVIEW 2024.08.28 | ISSUED FOR RFP 2024.09.10 ISSUED FOR ADDENDUM 1

**CONSULTANT:** 

PROJECT TITLE: DOGWOOD

**REPLACEMENT** 

EXTRACTION

025b-009-24 **M2.00** 

JH

**DRAWING TITLE: MECHANICAL SPECIFICATIONS** 

PAVILION - DUST

PROJECT ADDRESS: **1655 WINSLOW AVE** COQUITLAM, BC V3J 6B1

DRAWN BY CHECKED BY SEPTEMBER 10, 2024