

City of Coquitlam

Contract Documents 78035A

Mariner Overpass Structural Rehab & Intersection Upgrade



Table of Contents

Contract No. 78035A

Mariner Overpass Structural Rehab & Intersection Upgrade Project Construction Documents

Table of Contents

The complete **Project Construction Documents** consist of the following parts:

1.	Standard Documents – supplied	Page
	Table of Contents	TC 1 to TC 2
	Invitation to Tender	IN 1 to IN 3
	Instruction to Tenderers	
	Table of Contents	IT 1
	Instructions to Tenderers	IT 2 to IT 12
	Form of Tender, including	
	Form of Tender Summary	FT 1
	Form of Tender	FT 2 to FT 5
	 Appendix 1 – Schedule of Quantities and Unit Prices 	FT 6
	 Appendix 2 – Preliminary Construction Schedule 	FT 7
	 Appendix 3 – Experience of Superintendent 	FT 8
	 Appendix 4 – Comparable Work Experience 	FT 9
	 Appendix 5 – Subcontractors 	FT 10
	 Appendix 6 – Bid Bond 	FT 11
	 Appendix 7 – Certificate of Compliance for 	
	Contract Insurance	FT 12
	Agreement between Owner and Contractor	AGT 1 to AGT 4
	Schedule 1 – Schedule of Contract Documents	AGT 5
	Schedule 2 – List of Drawings	AGT 6
	Supplementary General Conditions – Table of Contents	SGC 1 to SGC 2
	 Supplementary General Conditions, including Appendices: 	
	Appendix I Performance Bond	SGC 19 to SGC 20
	Appendix II labour and Material Payment Bond	
	Appendix III Certificate of Insurance	
	Appendix IV Prime Contractor Designation	

Table of Contents

Supplementary Contract Specifications	SS 1 to SS 68
Appendix A – Traffic Management Detail Specifications	TMP 1 to TMP 9
Appendix B – As-builts	ASB 1 to ASB 49
Appendix C – Archaeological Chance Find Procedures	ACF 1 to ACF 19
Contract Drawings	Under Separate Cover

2. **Standard Documents - not supplied**

- i) (available in the "MMCD General Conditions, Specifications and Standard Detail Drawings")
 - Instructions to Tenderers
 - **General Conditions**

Schedule 17.5.3 – Letter Agreement with Referee Flow Chart – Changes and Extra Work

Flow Chart - Dispute Resolution

- Specifications
- Standard Detail Drawings
- ii) City of Coquitlam Supplementary Specifications for Contract Documents

Invitation to Tender



INVITATION TO TENDER

DATE OF ISSUE: November 19, 2025

We acknowledge with gratitude and respect that the name Coquitlam was derived from the həńqəmińəm word kwikwəðam (kwee-kwuh-tlum) meaning "Red Fish Up the River". The City is honoured to be located on the kwikwəðam (Kwikwetlem) traditional and ancestral lands, including those parts that were historically shared with the sqaciyar təməxw (Katzie), and other Coast Salish Peoples.

Tender No. 78035A

Mariner Overpass Structural Rehab & Intersection Upgrade

The City of Coquitlam invites tenders for **Contract 78035A - Mariner Overpass Structural Rehab & Intersection Upgrade**, generally consisting of the following, but not limited to:

- Mariner Overpass Minor Structural Rehabilitation:
 - o Concrete Deck and Cast-In-Place Concrete Spall Repairs,
 - o Drainage Improvements,
 - o Expansion Joint and Asphalt Replacements.
- Transit Ramp Intersection Upgrades:
 - o Traffic Signal Works and structural pole base installation,
 - o Median modifications and MMA Pavement Markings installation.
- Other miscellaneous and incidental works as contained in the Contract Documents.

Tender Documents and Drawings are available for downloading from the City of Coquitlam website: www.coquitlam.ca/BidOpportunities

Printing of Tender documents and drawings is the sole responsibility of the Tenderers.

Tenders submitted must be accompanied by a copy of the original specified 10% Bid Bond and will be received:

On or Before 2:00 pm local time December 10, 2025

("Closing Date and Time")

Addenda

Tenderers are required to check the City's website for any updated information, issued before the Closing Date at: www.coquitlam.ca/BidOpportunities. Where in its sole discretion it considers it to be necessary or desirable, the City may issue Addenda to amend any portion of the Contract Documents.

Any changes to the Tender documentation will be issued by means of written Addenda and posted on the City's website and will form part of the Tender. No amendment of any kind to the Tender is effective unless it is posted in a formal written Addendum on the City website. Upon submitting a Tender, Tenderers will be deemed to have received notice of all Addenda that are posted on the City's website and deemed to have considered the information for inclusion in the Tender submitted.

The City does not retain a bidder's list or bidder's registry. Tenderers are encouraged to register as plan takers and may view the Tender Documents and Drawings by contacting the Vancouver Regional Construction Association (VRCA), website: www.my.vrca.ca, ph: 604-294-3766, or email at vrca@vrca.ca, quoting the Coquitlam Tender Reference Number.

Should there be any discrepancy in the documentation provided, the City's original file copy shall prevail.

Tenders shall remain open for acceptance for 60 days following the submission Closing Date.

The City reserves the right to accept or reject any or all Tenders and the lowest or any Tender may not necessarily be accepted. The City also reserves the right to cancel any request for Tender at any time without recourse by the Tenderer.

The City, prior to award of any Tender, may negotiate with the Tenderer presenting the lowest price compliant Tender, for changes in the Work, materials, specifications or conditions without having any duty or obligation to advise any other Tenderers or to allow them to modify their Tenders, and the City will have no liability to any Tenderer as a result of such negotiations or modifications.

The City will not be responsible for any costs incurred by the Tenderer in preparing the Tender.

Procurement of goods and services is conducted in accordance with Chapter 5 of the Canadian Free Trade Agreement (CFTA) and the New West Partnership Trade Agreement (NWPTA).

M. Pain Manager Procurement

Instructions to Tenderers

Tender 78035A

Mariner Overpass Structural Rehab & Intersection Upgrade

INSTRUCTIONS TO TENDERERS

TABL	E OF CONTENTS	Page
1	Introduction	IT 2
2	Tender Documents	IT 2 to 3
3	Submission of Tenders	IT 3 to 4
4	Additional Instructions to Tenderers	IT 4 to 5
5	Tender Requirements	IT 6 to 7
6	Qualifications, Modifications, Alternative Tender	IT 7
7	Approved Equals	IT 7
8	Inspection of the Place of the Work	IT 7 to 8
9	Interpretation of Contract Documents	IT 8
10	Prices	IT 8 to 9
11	Taxes	IT 9
12	Amendment of Tenders	IT 9 to 10
13	Duration of Tenders	IT 10
14	Qualifications of Tenders	IT 10
15	Award	IT 10 to 12
16	Subcontractors	IT 12
17	Optional Work	IT 12

INSTRUCTIONS TO TENDERERS

(FOR USE WHEN UNIT PRICES FORM THE BASIS OF PAYMENT - TO BE USED ONLY WITH THE GENERAL CONDITIONS AND OTHER STANDARD DOCUMENTS OF THE UNIT PRICE MASTER MUNICIPAL CONSTRUCTION DOCUMENTS.)

The City of Coquitlam

Contract: Mariner Overpass Structural Rehab & Intersection Upgrade

Reference No. 78035A

1.0 Introduction

- 1.1 These Instructions apply to and govern the preparation of tenders for this *Contract*. The *Contract* is generally for the following work:
 - Mariner Overpass Minor Structural Rehabilitation:
 - o Concrete Deck and Cast-In-Place Concrete Spall Repairs,
 - o Drainage Improvements,
 - o Expansion Joint and Asphalt Replacements.
 - Transit Ramp Intersection Upgrades:
 - o Traffic Signal Works and structural pole base installation,
 - Median modifications and MMA Pavement Markings installation.
 - Other miscellaneous and incidental works as contained in the Contract Documents.
- 1.2 All inquiries regarding this Tender are to be submitted in writing referencing the **Tender Name and Number** sent to:

E-mail <u>bid@coquitlam.ca</u>

The deadline for inquiries is **2:00 PM** local time, **Friday**, **December 5**, **2025**.

INQUIRIES RECEIVED AFTER THIS DATE AND TIME MAY NOT RECEIVE A RESPONSE.

2.0 Tender Documents

2.1

- The Tender Documents which a Tenderer should review to prepare a Tender consist of all of the *Contract Documents* listed in Schedule 1 entitled "Schedule of Contract Documents". Schedule 1 is attached to the Agreement which is included as part of the Tender Package. The *Contract Documents* include the drawings listed in Schedule 2 to the Agreement, entitled "List of *Contract Drawings*".
- 2.2 A portion of the Contract Documents are included by reference.

 Copies of these documents have not been included with the tender package. These documents are the General Conditions,

 Specifications and Standard Detail Drawings. They are those contained in the publication entitled "Master Municipal Construction Documents General Conditions, Specifications and Standard Detail Drawings". Refer to Schedule 1 to the Agreement or, if not specified in Schedule 1, then the applicable edition shall

be the most recent edition as of the date of the *Tender Closing Date*. All sections of this publication are by reference included in the *Contract Documents*.

2.3 Any additional information made available to Tenderers prior to the Tender Closing Time by the Owner or representative of the Owner, such as geotechnical reports or as-built plans, which is not expressly included in Schedule 1 or Schedule 2 to the Agreement, is not included in the Contract Documents. Such additional information is made available only for the assistance of Tenderers who must make their own judgments about its reliability, accuracy, completeness and relevance to the *Contract*, and neither the Owner nor any representative of the Owner gives any guarantee or representation that the additional information is reliable, accurate, complete or relevant.

3.0 Submission of Tenders

3.1

3.2

Tenders must be submitted on the Tender Form provided, accompanied by a copy of the original 10% Bid Bond quoting the Tender Name and Number, and be uploaded to the City's file transfer website.

Tenders must be received on or before:

Tender Closing Time: 2:00 p.m. local time
Tender Closing Date: December 10, 2025

For the purpose of the Tender submission, digital copies of original documents and signatures sent electronically are accepted.

Original documents are required upon request by the City.

Instructions for Tender Submission

Tender submissions are to be consolidated into one (1) PDF file and uploaded electronically through QFile, the City's file transfer service accessed at website:

http://gfile.coguitlam.ca/bid

- 1. In the "Subject Field" enter: Tender Number and Name
- 2. Add consolidated Tender file in PDF format and Appendix 1 in XLS format, and Send (ensure your web browser remains open until you receive 2 emails from Qfile to confirm upload is complete and was sent to email: bid@coquitlam.ca)

Tenderers are responsible to allow for ample time to complete the submission process. For assistance, phone 604-927-3037.

3.3 Tenders submitted shall be deemed to be received when displayed as a new email in the in-box of the above email address. The City will not be responsible for any delay or for any Tenders not received for any reason, including technological delays or issues by either party's network or email program, and the City will not be liable for any damages associated with Tenders not received.

3.4 The City reserves the right to accept late Tenders to allow for technological delays. The City also reserves the right to accept Tenders by email: bid@coquitlam.ca.

BIDS RECEIVED IN-PERSON, BY COURIER, OR BY FAX WILL NOT BE ACCEPTED.

- 3.5 Tenders will not be opened in public. The unevaluated results will be forwarded to participants by email.
- 3.6 Tender submissions are subject to the Freedom of Information and Protection of Privacy Act and contents may be disclosed if required to do so, pursuant to the Act.

4.0 Additional Instructions to Tenderers

4.1 <u>Additional Instructions to Tenderers</u>

The Hours of Work for this Contract is restricted to night time work. The Tenderer is required to review "Appendix A – Traffic Management Detail Specifications" for details related to this restriction.

Obtaining Documents

- 4.2 The following documents which are referred to and form part of the Contract Document package may be obtained as follows:
 - Copies of the Master Municipal Construction Documents Volume II (2009), General Conditions, Specifications and Standard Detail Drawings are available separately from:

Support Services Unlimited Suite 102 211 Columbia Street Vancouver, B.C. V6A 2R5

Tel: 604-681-0295 Fax: 604-305-0424

 Copies of the City of Coquitlam Supplementary Specifications and Detailed Drawings to the MMCD 2009 Edition are available for viewing and downloading off the City of Coquitlam website: Supplementary Specifications and Detailed Drawings to MMCD

Test Excavations

4.3

4.4

Prior to the excavation of test holes on road allowances or privately owned property the Tenderer shall obtain permission from the Municipality or Owner of the property and comply with their requirements for restoration of disturbed surfaces and utilities. Failure to comply with Municipal by-laws restricting this practice may result in prosecution of the offending party.

Business License

The successful Tenderer shall provide evidence of a City of Coquitlam Business License or Tri-Cities Inter-Municipal Business License prior to commencement of work or supply of materials. For

		more information, contact Business License Division Ph: 604-927-3085 or apply online at website: <u>City of Coquitlam Business License</u>
No Claim	4.5	Except as expressly and specifically permitted in these Instructions to Tenderers, no Tenderer shall have any claim for any compensation of any kind whatsoever, as a result of participating in this Tender, including accepting a non-compliant bid and by submitting a Tender, each Tenderer shall be deemed to have agreed that it has no claim.
No Cost	4.6	The City will not under any circumstances be responsible for any costs incurred by the Tenderer in preparing the Tender.
Right to Accept or Reject any Tender	4.7	The City reserves the right to accept or reject any or all Tenders and the lowest or any Tender may not necessarily be accepted. In its sole discretion, the City may reject or retain for its consideration, tenders which are nonconforming because they do not contain the content or form required by the instructions to tenderers or for failure to comply with the process for submission set out in these instructions to tenderers.
		The City specifically reserves the right to reject all Tenders if none is considered to be satisfactory and, in that event, at its option, to call for additional Tenders.
Negotiation	4.8	The City, prior to award of any Tender, may negotiate with the Tenderer presenting the lowest price compliant Tender, for changes in the Work, materials, specifications or conditions without having any duty or obligation to advise any other Tenderers or to allow them to modify their Tenders, and the City will have no liability to any Tenderer as a result of such negotiations or modifications.
Cancellation of Tender	4.9	The City reserves the right to cancel any request for Tender at any time without recourse by the Tenderer. The City has the right to not award this work for any reason including choosing to complete the work with the City's own forces.
Conflict of Interest	4.10	Tenderers shall disclose any actual or potential conflicts of interest and existing business relationships it may have with the City, their elected or appointed officials or employees.
Collusion	4.11	Tenderers will not discuss or communicate with one another in regards to the preparation of their Tenders. Each Tenderer will ensure that its participation in the Tender process and that of its team members is conducted without collusion or fraud. Failure to comply with this requirement may lead to disqualification without further notice or warning.
Instruction to Tenderers – Part II	4.12	Delete Instructions to Tenderers – Part II Contained in the Edition of the Publication "Master Municipal Construction Documents 2009" and replace with the following:

5.0 Tender Requirements

- 5.1 A tender should be on the Form of Tender as provided and be signed by the authorized signatory(s) as follows:
 - 5.1.1 if the tenderer is a partnership or joint venture then the name of the partnership or joint venturer should be included, and each partner or joint venturer should sign personally; if a partner of joint venture is a corporation then such corporation should sign as indicated in paragraph 5.1.3 below; and
 - 5.1.2 if the tenderer is a corporation then the full name of the corporation should be included, together with the names and signatures of authorized signatories.
 - 5.1.3 For the purpose of the Tender submission, digital copies of original documents and electronic signatures are accepted. Original documents are required upon request by the City.
- 5.2 A tender must be accompanied by tender security ("Bid Security") in the form of:
 - 5.2.1 a copy (digital or Electronic copy is acceptable) of the original bid bond in an amount equal to 10% of the Tender Price, issued by a surety licensed to carry on the business of suretyship in British Columbia in a form reasonably satisfactory to the *Owner*;
- 5.3 Tenderer should be competent and capable of performing the various items of work. Tenderer shall complete the following statement sheets appended to the Form of Tender:
 - 5.3.1 Appendix 1 the Schedule of Quantities and Prices;
 - 5.3.2 Appendix 2 a "Preliminary Construction Schedule", generally in the form attached as Appendix 2 to the Form of Tender, and showing Substantial Performance by the date or within the duration, shown in paragraph 2.2 of the Form of Tender.
 - 5.3.3 Appendix 3 name and brief description of the previous experience of the *Superintendent* the tenderer will use for the *Work*;
 - 5.3.4 Appendix 4 a list of previous comparable work, including a brief description of that work, approximate contract value, and references (with phone numbers);
 - 5.3.5 Appendix 5 a complete list of all subcontractors, if any, that the tenderer will use for the *Work* including full names.; and

Appendix 7 – is provided for information only, to indicate the Contract Insurance is to be submitted by the successful Tenderer upon Notice of Award.

- 5.4 The successful tenderer will, within 15 *Days* of receipt of the written *Notice of Award*, be required to deliver to the *Owner* the items listed in FT 5.1.1, including a Performance Bond and a Labour and Material Payment Bond as described in FT 5.1.1(a), failing which the provisions of FT 6.1 will apply.
- 6.0 Qualifications, Modifications, Alternative Tenders
- 6.1 Tenders which contain qualifications, or omissions, so as to make comparison which other tenders difficult, may be rejected by the *Owner*.
- 6.2 A tenderer may, at the tenderer's election, submit an alternative tender ("Alternative Tender") which varies the materials, products, designs or equipment by the Owner as Approved Equals as the case may be, but an Alternative Tender must be in addition to, and not in substitution for a tender which conforms to the requirements of the Contract Documents.
- 6.3 The only *Alternative Tender* that the *Owner* may accept is an *Alternative Tender* submitted by that tenderer whose conforming tender, submitted as required by paragraph 6.2 of these Instructions to Tenderers, would have been accepted by the *Owners* in the preference to other conforming tenders, if no *Alternative Tenders* had been invited.
- 7.0 Approved Equals
- 7.1 Prior to the *Tender Closing Time and Date,* a tenderer may request the *Owner* to approve materials, products, or equipment ("Approved Equal") to be included in a tender in substitution for items indicated in the Contract Documents.
- 7.2 Applications for an *Approved Equal* must be in writing, and supported by appropriate supporting information, data, specifications, and documentation.
- 7.3 If the *Owner* decides in its discretion to accept an *Approved Equal*, then the *Owner* will issue an addendum to all tenderers.
- 7.4 The *Owner* is not obligated to review or accept an application for an *Approved Equal*.
- 8.0 Inspection of the *Place of the Work*

8.1

All tenderers, either personally or through a representative, are responsible to examine the *Place of the Work* before submitting a tender. A tenderer has full responsibility to be familiar with and make allowance in the tender for all conditions at the *Place of the Work* that might affect the tender, including any information regarding subsurface soil conditions made available by the *Owner*, the location of the *Work*, local conditions, topographical soil conditions, weather and access. Unless otherwise specified in the *Contract Documents*, a tenderer is not required to do subsurface

investigations. By submitting a tender, a tenderer represents that the tenderer has examined the *Place of the Work*, or specifically elected not to. No additional payments or time extensions shall be claimable or due because of difficulties relating to conditions at the *Place of the Work* which were reasonably foreseeable by a contractor qualified to undertake the *Work*.

8.2 Tenderers are referred to GC 11.2.1 regarding **Concealed or Unknown Conditions.**

9.0 Interpretation of Contract Documents

- 9.1 If a tenderer is in doubt as to the correct meaning of any provision of the *Contract Documents*, the tenderer may request clarification as instructed in paragraph 1.2 of the Instructions to Tenderers.
- 9.2 If a tenderer discovers any contradictions or inconsistencies in the *Contract Documents* or its provisions, or any discrepancies between a provision of the *Contract Documents* and conditions at the *Place of* the Work as observed in an examination under paragraph 8 of the person named in paragraph 1.2 of the Instructions to Tenderers.
- 9.3 If the *Owner* considers it necessary, the *Owner* may issue written addenda to provide clarification (s) of the *Contract Documents*.
- 9.4 <u>No oral interpretation or representations from the *Owner* or any representative of the *Owner* will affect, alter, or amend any provision of the *Contract Documents*.</u>

10.0 Prices

- 10.1 The Tendered Price will represent the entire cost excluding *GST* to the *Owner* of the complete *Work* based on the estimated quantities in the *Schedule of Quantities and Prices* of the Form of Tender. Notwithstanding the generalities of the above, tenderers shall include in the tendered prices (including unit prices, lump sum prices, or other forms of pricing) sufficient amounts to cover:
 - 10.1.1 the costs of all labour, equipment and material included in or required for the *Work*, including all items which, whole not specifically listed in the *Schedule of Quantities and Prices*, are included in the *Work* specifically or by necessary inference from the *Contract Documents*;
 - 10.1.2 all assessments payable with respect to labour as required by any statutory scheme such as unemployment insurance, holiday pay, insurance, CPP and all employee benefits and the Workers Compensation Act;
 - 10.1.3 all overhead costs, including head office and on-site overhead costs, and all amounts for the *Contractor's* profit.
- 10.2 The tendered prices and all subcontracts must allow for compliance with all applicable laws regarding trade or other qualifications of

				ning the <i>Work</i> , and payment of appropriate ncluded in or required for the <i>Work</i> .
11.0	Taxes	11.1	kind payable with	es shall cover all taxes and assessments of any respect to the <i>Work</i> , but shall not include <i>GST</i> . as a separate line item as required by GC 19.3.
12.0	Amendment of Tenders	12.1	delivered by Email Instructions to Ter <i>Date and Time</i> . An	nend or revoke a tender by giving written notice, to the office referred to in paragraph 3.4 of the oderers at any time up until the <i>Tender Closing</i> amendment or revocation that is received after <i>Date and Time</i> shall not be considered and shall ras submitted.
		12.2	signatory of the te	revocation must be signed by an authorized nderer in the same manner as provided by hese Instructions to Tenderers.
		12.3	tenderer's <i>Tender I</i> that, in the opinion	hat expressly or by inference discloses the Price or other material element of the tender such n of the <i>Owner</i> , the confidentiality of the tender is lilidate the entire tender.
		12.4	•	n of a tender amendment which tenderers may, ed to, use is as follows:
			"Contract:	(TITLE OF CONTRACT)
			Reference No.	(OWNER'S CONTRACT REFERENCE NO.)
			TO:	(NAME OF OWNER)
				ed wish to amend our tender which we submitted ract by deleting the following tendered prices or nder:
			(TEDNERED PRICES AND/OR T	TENDER ITEMS IN THE TENDER THAT ARE TO BE AMENDED)
			and substituting th	ne following revised tendered prices or items:
			(REVISED TENDERED PRICES O	OR TENDER ITEMS)
			our Tender Price a	our tender should be adjusted accordingly, and s set out in Appendix 1 of our submitted Form of e Schedule of Quantities and Prices , increased /
				, excluding GST. We have not included

			our revised Tender Price in order to preserve the confidentiality of our tender.
			Signed and delivered the day of, 20"
13.0	Duration of Tenders	13.1	After the <i>Tender Closing Time</i> , a tender shall remain valid and irrevocable as set out in paragraph 5.1 of the Form of Tender.
14.0	Qualifications of Tenderers	14.1	By submitting a tender, a tenderer is representing that it has the competence, qualifications and relevant experience required to do the <i>Work</i> .
15.0	Award	15.1	In exercising its discretion, the <i>Owner</i> will have regard to the information provided in the Appendices to the Form of Tender as described under IT 5.3 including the proven experience of the tenderer, and any listed subcontractors, to do the <i>Work</i> .

Tenders received will be evaluated to provide the City with greatest value based on quality, service, price and experience. Evaluation Criteria will include but is not limited to:

- Ability to meet specifications and required completion date
- 2. Contractor's past experience, references, reputation and compliance to specifications
- 3. Demonstrated successful experience on similar projects and specific equipment installation
- 4. Price: purchase price, maintenance costs, availability of parts and service, warranty and compatibility with existing equipment and/or conditions
- 5. Any other criteria, the City deems, at its sole discretion, necessary to evaluate Tenders;
- 6. Lowest price will not necessarily be accepted.

The City may, in its absolute discretion, not award to a Tenderer if the Tenderer, or any officer or director of a corporate Tenderer, is or has been engaged, either directly or indirectly through another corporation or legal entity, in a legal action against the City and its elected and appointed officers and employees or any of them in relation to:

- a) any other contract or services; or
- b) any matter arising from the City's exercise of its powers, duties or functions under the *Local Government Act*, the *Community Charter* or any other enactments; within five years of this Tender Offer.

For purposes of this section, the words "legal action" includes, without limitation, mediation, arbitration, hearing before an administrative tribunal or lawsuit filed in any court.

Without limiting the City's sole discretion, in determining whether or not to award to a Tenderer pursuant to this clause, the City will consider such factors as whether the legal action is likely to affect the Tenderer's ability to work with the City and its employees, agents, consultants and representatives or any of them and whether the City's past experience with the Tenderer in the matter that resulted in the legal action indicates that the City is likely to incur increased staff and legal costs or either of them in the administration of this contract if it is awarded to the Tenderer.

In the event that the lowest total Tender Price by two or more Tenderers is the same amount, the City will select a Tenderer with an overall satisfactory performance record in having completed work on previous relevant projects that are provided as references, and on City projects. Information obtained from references will not be disclosed or discussed with any Tenderer. If all references are equal, selection will be determined by a coin toss in a manner to be directed by the City.

Where only one Tender is received the City may reject such and retender on a selected basis.

- 15.2 The *Owner* will notify the successful tenderer in writing.
- 15.3 If there are any discrepancies in the *Schedule of Quantities and Prices* between the unit prices and the extended totals then the unit prices shall be deemed correct, and corresponding corrections shall be made to the extended totals. If a unit price or extended total has been omitted, the following shall apply:
 - a) If a unit price is given but the corresponding extended total has been omitted, then the extended total shall be calculated from unit price and the estimated quantity, and inserted as the extended total;
 - b) If an extended total is given but the corresponding unit price has been omitted, then the unit price shall be calculated from the extended total and estimated quantity, and inserted as the unit price;
 - c) If both the unit price and the corresponding extended total for a tender item have been omitted, then the following test shall be applied to determine whether the tender shall be rejected as incomplete:
 - the highest of the unit prices tendered by other tenderers for that tender item shall be used as the test unit price, and the corresponding test extended total shall be calculated from the test unit price and the estimated quantity;
 - (ii) if the test extended total for the tender item exceeds 1% of the revised total *Tender Price*,

- including the test extended total, or if the revised total *Tender Price*, including the test extended total, alters the ranking of the tenderers according to the lowest *Tender Price*, then the omitted unit price for that tender item is deemed to materially affect the *Tender Price* relative to other tenders and the tender shall be rejected;
- (iii) if the tender is not rejected under subparagraph (ii) of this IT 15.3 (c), then the unit price and the extended total for that tender item shall both be deemed to be, and the costs for that tender item shall be zero deemed to be included in other tender items prices;
- d) In no event shall page totals in the *Schedule of Quantities* and *Prices* or the total *Tender Price* be used to calculate missing extended totals or unit prices.

16.0 Subcontractors

16.1 The *Owner* reserves the right to object to any of the subcontractors listed in a tender. If the *Owner* objects to any of the subcontractor(s) then the *Owner* will permit a tenderer to, within 5 days, propose a substitute subcontractor(s) acceptable to the *Owner* provided that there is not resulting adjustment in the *Tender Price* or the completion date set out in paragraph 2.2 of the Form of Tender. A tenderer will not be required to make such substitution and, if the *Owner* objects to a listed *Subcontractor(s)*, the tenderer may, rather than propose a substitute subcontractor(s), consider its tender rejected by the *Owner* and by written notice withdraw it tender. The *Owner* shall, in the event, return the tenderer's bid security

17.0 Optional Work

- 17.1 If the *Schedule of Quantities and Prices* includes any tender prices for *Optional or Provisional Work*, as defined in GC 7.4.1, the tenderers must complete all the unit prices for such *Optional or Provisional Work*. Such tender prices shall not include any general overhead costs, or other costs, or profit, not directly related to the *Optional or Provisional Work*.
- 17.2 Notwithstanding that the *Owner* may elect not to proceed with the *Optional or Provisional Work*, the tender prices for any *Optional or Provisional Work*, including the extended totals for *Optional or Provisional Work* unit prices, shall be included in the *Tender Price* for the purpose of any price comparisons between tenders.

Form of Tender



Form of Tender

Tender No. 78035A

Mariner Overpass Structural Rehab & Intersection Upgrade

Summary

Name of <i>Contractor</i> :	
Tender Price (exclude GST):	
	(FROM APPENDIX 1 OF FORM OF TENDER)

Tender submitted must be accompanied by a copy of the original 10% Bid Bond and will be received

On or before 2:00 pm (local time) Wednesday, December 10, 2025

Instructions for Tender Submission

Tender submissions are to be consolidated into one (1) .pdf file and uploaded electronically through QFile, the City's file transfer service accessed at website: gfile.coguitlam.ca/bid

- 1. In the "Subject Field" enter: Tender Number and Name
- 2. Add consolidated Tender file in PDF format, and Appendix 1 in XLS format, and Send (ensure your web browser remains open until you receive 2 emails from Qfile to confirm upload is complete and was sent to the correct email address: bid@coquitlam.ca)

Tenderers are responsible to allow ample time to complete the Tender submission process. If assistance is required, phone 604-927-3037.

THE CITY OF COQUITLAM 3000 Guildford Way Coquitlam, B.C. V3B 7N2

December 2025

(FOR USE WHEN UNIT PRICES FORM THE BASIS OF PAYMENT - TO BE USED ONLY WITH THE GENERAL CONDITIONS AND OTHER STANDARD DOCUMENTS OF THE UNIT PRICE MASTER MUNICIPAL CONSTRUCTION DOCUMENTS.)

Contract Name: Mariner Overpass Structural Rehab & Intersection Upgrade

Reference No.: 78035A

TO OWNER:

1 WE, THE UNDERSIGNED:

1.1 have received and carefully reviewed all of the Contract Documents, including the Instructions to Tenderers, the City of Coquitlam Supplementary General Conditions, the City of Coquitlam Supplementary Contract Specifications, the specified edition of the "Master Municipal Construction Documents – General Conditions, Specifications and Standard Detail Drawings" and the following Addenda:

(ADDENDA, IF ANY)	

1.2 shall fully disclose any actual or potential conflicts of interest and existing business relationships we may have with the City, their elected or appointed officials or employees:

- 1.3 have full knowledge of the *Place of the Work*, and the *Work* required; and
- 1.4 have complied with the Instructions to Tenderers; and

2 ACCORDINGLY WE HEREBY OFFER:

- 2.1 to perform and complete all of the *Work* and to provide all the labour, equipment and material all as set out in the *Contract Documents*, in strict compliance with the *Contract Documents*; and
- 2.2 to achieve Substantial Performance of the Work on or before July 17, 2026; and
- to do the *Work* for the price, which is the sum of the products of the actual quantities incorporated into the *Work* and the appropriate unit prices set out in Appendix 1, the "*Schedule of Quantities and Prices*", plus any lump sums or specific prices and adjustment amounts as provided by the *Contract Documents*. For the purposes of tender comparison, our offer is to complete the *Work* for the "*Tender Price*" as set out on Appendix 1 of this Form of Tender. Our *Tender Price* is based on the estimated quantities listed in the *Schedule of Quantities and Prices*, and excludes *GST*.

3 WE CONFIRM:

- 3.1 that we understand and agree that the quantities as listed in the *Schedule of Quantities and Prices* are estimated, and that the actual quantities will vary.
- 3.2 that we understand and agree that the owner is in no way obliged to accept this Tender.

4 WE CONFIRM:

- 4.1 that the following Appendices are attached to and form a part of this tender:
 - 4.1.1 the Appendices as required by paragraph 5.3 of the Instructions to Tenderers Part II; and
 - 4.1.2 the *Bid Security* as required by paragraph 5.2 of the Instructions to Tenderers Part II.
 - 4.1.3 the Certificate of Compliance on the form provided in Appendix 7 of this Form of Tender.

5 WE AGREE:

- 5.1 that this tender will be irrevocable and open for acceptance by the *Owner* for a period of <u>60</u> calendar days from the day following the *Tender Closing Date and Time*, even if the tender of another Tenderer is accepted by the *Owner*. If within this period the *Owner* delivers a written notice ("*Notice of Award*") by which the *Owner* accepts our tender we will:
 - 5.1.1 within **15** *Days* of receipt of the written *Notice of Award* deliver to the *Owner*:
 - a) a Performance Bond and a Labour and Material Payment Bond, each in the amount of 50% of the *Contract Price*, issued by a surety licensed to carry on the business of suretyship in the province of British Columbia, and in a form acceptable to the *Owner*;
 - b) a "clearance letter" indicating that the Tenderer is in WCB compliance; and
 - c) a copy of the insurance policies as specified in SGC Section 24 indicating that all such insurance coverage is in place and;
 - d) a letter confirming the *Contractor* as "Prime Contractor" for the Contract as specified in SGC Section 21.2.1.
 - 5.1.2 within **2** *Days* of receipt of written "*Notice to Proceed*", or such longer time as may be otherwise specified in the *Notice to Proceed*, commence the *Work*; and
 - 5.1.3 sign the Contract Documents as required by GC 2.1.

6 WE AGREE:

- 6.1 that, if we receive written *Notice of Award* of this *Contract* and, contrary to paragraph 5 of this Form of Tender, we:
 - 6.1.1 fail or refuse to deliver the documents as specified by paragraph 5.1.1 of this Form of Tender; or
 - 6.1.2 fail or refuse to commence the Work as required by the Notice to Proceed,

then such failure or refusal will be deemed to be a refusal by us to enter into the <u>Contract</u> and the <u>Owner</u> may, on written notice to us, award the <u>Contract</u> to another party. We further agree that, as full compensation on account of damages suffered by the <u>Owner</u> because of such failure or refusal, the <u>Bid Security</u> shall be forfeited to the <u>Owner</u>, in an amount equal to the lesser of:

- 6.1.3 the face value of the Bid Security; and
- 6.1.4 the amount by which our *Tender Price* is less than the amount for which the *Owner* contracts with another party to perform the *Work*.

Phono:	
Phone: Email:	
Attention:	
This Tender is executed thi	sday of, 20
Contractor:	
(FULL LEGAL NAME OF CO	RPORATION, PARTNERSHIP OR INDIVIDUAL)
(AUTHORIZED SIGNATOR)	Δ


(GST F	REGISTRATION NUMBER)
or;	
8.1.2	by signature hereunder, we certify we are not required to provide registration number:

(AUTHORIZED SIGNATORY)

APPENDIX 1 FORM OF TENDER

Contract 78035A

Mariner Overpass Structural Rehab & Intersection Upgrade

SCHEDULE OF QUANTITIES AND PRICES
(see paragraph 5.3.1 of the Instruction to Tenderers)
(All Tender and Contract Prices shall NOT include GST. GST will apply upon payment)
(Should there be any discrepancy in the information provided, the City's original file copy shall prevail)

		(Snould there be any discrepancy in the information provided, the City's original fi	1 1		, 	I	
ITEM NO.	MMCD Ref. / (Supplementary Contract Specifications)	DESCRIPTION	UNIT	QTY	UNIT PRICE	EXTENDED AMOUNT	
1.00	01 55 005	TRAFFIC CONTROL, VEHICLE ACCESS AND PARKING					
1.01	(1.5.1)	Traffic Control and Management		In	cidental to Conti	ract	
2.00	01 57 015	ENVIRONMENTAL PROTECTION					
2.01	(1.6.1)	ESC supply & installation, maintenance and removal Incidental to Contract					
3.00	01 58 015	PROJECT IDENTIFICATION				ı	
3.01	(1.3.1)	Construction Zone Information Signs	ea.	3			
3.02	(1.3.2)	Changeable Message Signs (CMS) (x4 Signs)	month	5			
	BR	230 MARINER WAY OVERPASS STRUCTURAL REHABILITATION (refer to Contract Dra	wings b	y Associa	ated Engineer	ing)	
4.00	03 30 535	CAST-IN-PLACE CONCRETE					
4.01	(1.5.6)	Repair Concrete Spalling in Median (Provisional)	sq. m	1			
4.02	(1.5.7)	Barrier Demolition and Reinstatement	each	6			
4.03	(1.5.8)	Repair of Concrete Deck Along Longitudinal Hinge (Pier Y)	m	21			
5.00	03 40 01	PRECAST CONCRETE BARRIERS					
5.01	1.4.4	Supply and Install Concrete Roadside Barriers With Drainage Slot (MOTT Standard CRB-E type)	each	9			
5.02	1.4.5	Remove/Reinstate Concrete Roadside Barriers	each	20			
5.03	1.4.5	Disposal of Concrete Roadside Barriers	each	9			
6.00	05 53 005	METAL FABRICATIONS					
6.01	(1.5.2)	Replace Bearing Keeper Plates (North Abutment)	each	5			
7.00	07 91 005	JOINTS					
7.01	(1.4.1)	North Abutment Expansion Joint Replacement	L.S.	1			
7.02	(1.4.1)	South Abutment Expansion Joint Replacement	L.S.	1			
7.03	(1.4.1)	East Abutment Expansion Joint Replacement	L.S.	1			
7.04	(1.4.3)	Replace Joint Sealants in Sidewalk and Parapet	L.S.	1			
8.00	31 24 135	ROADWAY EXCAVATION, EMBANKMENT AND COMPACTION			•		
8.01	(1.8.5)	Removal and Offsite Disposal of Existing Asphalt Sidewalk and Road to Complete Sidewalk Regrading and East Approach Crack Repair (as per Associated Engineering Civil Grading Plan; Contract Drawings Sheet 2 and 3) (Provisional)	cu. m	25			
9.00	32 11 235	GRANULAR BASE					
9.01	(1.4.1)	Granular Base - 25mm Minus (Sidewalk Regrading and East Approach Crack Repair) (Provisional)	tonne	40			
10.00	32 12 165	HOT-MIX ASPHALT CONCRETE PAVING					
10.01	(1.5.1)	Machine Laid Hot Mix Asphalt - 50mm Thick (MMCD Upper Course #1) c/w Tack Coat - East Approach Crack Repair & CB Lead and Manhole Installation (Provisional)	tonne	9			
10.02	(1.5.1)	Machine Laid Hot Mix Asphalt - 75mm Thick (MMCD Lower Course #1) - East Approach Crack Repair & CB Lead and Manhole Installation (Provisional)	tonne	13			
10.03	(1.5.3)	Machine Laid Hot Mix Asphalt - 50mm Thick (MMCD Upper Course #2) - Sidewalk Regrading (Provisional)	tonne	22			
11.00	33 40 015	STORM SEWERS					
11.01	(1.6.5)	Supply and Install 150mm PVC DR28 Catch Basin Lead	m	8			
12.00	33 44 015	MANHOLES AND CATCHBASINS					
12.01	(1.5.1.1)	Supply and Install 1050mm Diameter Storm Manhole as per MMCD DWG S1	each	1			





Total Tendered Price (exclude GST):

(Transfer the amount to Form of Tender Summary Page 1)

Name of Contractor:

FORM OF TENDER

Contract 78035A Mariner Overpass Structural Rehab & Intersection Upgrade

PRELIMINARY CONSTRUCTION SCHEDULE

(See paragraph 5.3.2 of the Instructions to Tenderers)

INDICATE SCHEDULE WITH BAR CHART WITH CONSTRUCTION DURATIONS

CONSTRUCTION ACTIVITY		M	IARC	:H			AP	RIL			M	AY			J	IUNI	E		JU	LY
	1	2	3	4	5	1	2	3	4	1	2	3	4	1	2	3	4	5	1	2

Substantial Completion Date: July 17, 2026	
D 10: 16"	
Proposed Disposal Site:	

FORM OF TENDER

Contract 78035A Mariner Overpass Structural Rehab & Intersection Upgrade

EXPERIENCE OF SUPERINTENDENT

(See paragraph 5.3.3 of the Instructions to Tenderers)

roposed Project Super	intendent	
ist of Project Experie	<u>ence</u>	
PROJECT:	Dates:	
Work Description:		
Responsibility:		
Owner/Reference:	Phone No.:	
PROJECT:	Dates:	
Work Description:		
Responsibility:		
Owner/Reference:	Phone No.:	
PROJECT:	Dates:	
Work Description:		
Responsibility:		
Owner/Reference:	Phone No.:	

FORM OF TENDER

Contract 78035A Mariner Overpass Structural Rehab & Intersection Upgrade

CONTRACTOR'S COMPARABLE WORK EXPERIENCE

(See paragraph 5.3.4 of the Instructions to Tenderers)

PROJECT:	VALUE (\$):	
OWNER:	Phone No.:	
Work Description:		
PROJECT:	VALUE (\$):	
OWNER:	Phone No.:	
Work Description:		
PROJECT:	VALUE (\$):	
OWNER:	Phone No.:	
Work Description:		
PROJECT:	VALUE (\$):	
OWNER:	Phone No.:	
Work Description:		

FORM OF TENDER

Contract 78035A Mariner Overpass Structural Rehab & Intersection Upgrade

SUBCONTRACTORS

(See paragraph 5.3.5 of the Instructions to Tenderers)

Tundo	Tender	
Trade:	Item:	
Work Description:		
Subcontractor:	Phone No.:	
<u> </u>	Tender	
Trade:	Item:	
Work Description:		
Subcontractor:	Phone No.:	
1		
Trade:	Tender	
	Item:	
Work Description:		
Subcontractor:	Phone No.:	
	Tender	
Trade:	Item:	
Work Description:		
	_,	
Subcontractor:	Phone No.:	
	Tender	
Trade:	Item:	
Work Description:		
Subcontractor:	Phone No:	

FORM OF TENDER

Contract 78035A Mariner Overpass Structural Rehab & Intersection Upgrade

		Bid Bond	
NO			\$
	KNOW ALL N	MEN BY THESE PRESENTS THAT	
	As Principal, he	reinafter called the Principal, and	
	As Surety, hereinafter calle	d the Surety, are held and firmly bo	und unto
	As Obligee, hereinaft	ter called the Obligee, in the amoun	t of
) lawful money of
		nd truly to be made, the Principal an ors, successors and assigns, jointly	
	•	n Tender to the Obligee, dated the <u>.</u>	-
Tender accepted time required, er the terms and co and Surety will p Principal and the	within sixty (60) days from the nter into a formal contract and anditions of the Contract, then ay unto the Obligee the differe	BLIGATION is such that if the aforest e Closing Date of Tender and the sa d give good and sufficient bonds to s this obligation shall be null and voicence in money between the amount e legally contracts with another part	id Principal will, within the secure the performance of d; otherwise the Principal tof the bid of the said
The Surety shall	not be liable for a greater sum	than the specified penalty of this B	ond.
Any suit under th	nis Bond must be instituted be	fore the expiration of six (6) months	s from the date of this Bond.
these presents to		reto set its hand and affixed its seal, seal duly attested by the signature o	
SIGNED, SEALED In the presence o			
•)))	PRINCIPAL	

SURETY

FORM OF TENDER

Contract 78035A Mariner Overpass Structural Rehab & Intersection Upgrade

CERTIFICATE OF COMPLIANCE for CONTRACT INSURANCE

This is provided for information to certify that the Tenderer does hereby undertake and agree to supply to the City of Coquitlam, upon award, contract insurance listed below for the project requirements indicated:

Contract Number: 78035A

Contract Name: Mariner Overpass Structural Rehab & Intersection Upgrade

Description of Work:

- Mariner Overpass Minor Structural Rehabilitation:
 - o Concrete Deck and Cast-In-Place Concrete Spall Repairs,
 - o Drainage Improvements,
 - o Expansion Joint and Asphalt Replacements.
- Transit Ramp Intersection Upgrades:
 - o Traffic Signal Works and structural pole base installation,
 - o Median modifications and MMA Pavement Markings installation.
- Other miscellaneous and incidental works as contained in the Contract Documents.

Other miscellaneous and incidental work as contained in the Contract Documents Commercial General Liability: \$5,000,000 limit Special Coverage Required: YES NO Special Coverage Description () (X) Shoring and Underpinning Hazard () (X) Pile Driving and Vibrations () (X)Excavation Hazard) (X) Demolition) (X) Blasting We also certify that the insurance coverage will meet the requirements of the Supplementary General Conditions Section 24 – Insurance, included as part of the Contract Documents, and that the proof of insurance will be provided on the City of Coquitlam Certificate of Insurance form, without amendments, except for the exclusions noted above. Name of Tenderer (printed) **Authorized Signature**

Date

Agreement

AGREEMENT

Between Owner and Contractor

(FOR USE WHEN UNIT PRICES FORM THE BASIS OF PAYMENT - TO BE USED ONLY WITH THE GENERAL CONDITIONS AND OTHER STANDARD DOCUMENTS OF THE UNIT PRICE MASTER MUNICIPAL CONSTRUCTION DOCUMENTS.)

THIS AGREEMENT made in duplicate this day of 202					
Contract:	Mariner Overpass Structural Rehab & Intersection Upgrade				
Reference	No. 78035A				
BETWEEN:					
300	e City of Coquitlam 00 Guildford Way quitlam, B.C. V3B 7N2				
(th	e "Owner")				
AND:					

The *Owner* and the *Contractor* agree as follows:

(the "Contractor")

1 THE WORK - START/COMPLETION DATES

- 1.1 The *Contractor* will perform all *Work* and provide all labour, equipment and material and do all things strictly as required by the *Contract Documents*.
- 1.2 The Contractor will commence the Work in accordance with the Notice to Proceed. The Contractor will proceed with the Work diligently, will perform the Work generally in accordance with the construction schedules as required by the Contract Documents and will achieve Substantial Performance of the Work on or before July 17, 2026 subject to the provisions of the Contract Documents for adjustments to the Contract Time.
- 1.3 Time shall be the essence of the Contract.

2 CONTRACT DOCUMENTS

- 2.1 The "Contract Documents" consist of the documents listed or referred to in Schedule 1, entitled "Schedule of Contract Documents", which is attached and forms a part of this Agreement, and includes any and all additional and amending documents issued in accordance with the provisions of the Contract Documents. All of the Contract Documents shall constitute the entire Contract between the Owner and the Contractor.
- 2.2 The *Contract* supersedes all prior negotiations, representations or agreements, whether written or oral, and the *Contract* may be amended only in strict accordance with the provisions of the *Contract Documents*.

3 CONTRACT PRICE

- 3.1 The price for the Work ("Contract Price") shall be the sum in Canadian dollars of the following:
 - a) the product of the actual quantities of the items of *Work* listed in the *Schedule of Quantities* and *Prices* which are incorporated into or made necessary by the *Work* and the unit prices listed in the *Schedule of Quantities and Prices*; plus
 - b) all lump sums, if any, as listed in the *Schedule of Quantities and Prices*, for items relating to or incorporated into the *Work*; plus
 - c) any adjustments, including any payments owing on account of *Changes* and agreed to *Extra Work*, approved in accordance with the provisions of the *Contract Documents*.
- 3.2 The *Contract Price* shall be the entire compensation owing to the *Contractor* for the *Work* and this compensation shall cover and include all profit and all costs of supervision, labour, material, equipment, overhead, financing, and all other costs and expenses whatsoever incurred in performing the *Work*.

4 PAYMENT

- 4.1 Subject to applicable legislation and the provisions of the *Contract Documents*, the *Owner* shall make payments to the *Contractor*.
- 4.2 If the *Owner* fails to make payments to the *Contractor* as they become due in accordance with the terms of the *Contract Documents* then interest calculated at 2% per annum over the prime commercial lending rate of the Royal Bank of Canada on such unpaid amounts shall also become due and payable until payment. Such interest shall be calculated and added to any unpaid amounts monthly.

5 RIGHTS AND REMEDIES

5.1 The duties and obligations imposed by the *Contract Documents* and the rights and remedies available hereunder shall be in addition to and not a limitation of any duties, obligations, rights and remedies otherwise imposed or available by law.

5.2 Except as specifically set out in the *Contract Documents*, no action or failure to act by the *Owner*, *Contract Administrator* or *Contractor* shall constitute a waiver of any of the parties' rights or duties afforded under the *Contract*, nor shall any such action or failure to act constitute an approval of or acquiescence in any breach under the *Contract*.

6 NOTICES

6.1 Communications among the *Owner*, the *Contract Administrator* and the *Contractor*, including all written notices required by the *Contract Documents*, may be delivered by email, or by hand, or by pre-paid registered mail to the addresses as set out below:

The *Owner:* The *Contractor:*

The City of Coquitlam 3000 Guildford Way Coquitlam, B.C. V3B 7N2

Tel: 604-927-3500 Tel:

Email: Attention:

The *Contract Administrator*:

The City of Coquitlam 3000 Guildford Way Coquitlam, B.C. V3B 7N2

Tel:

Email:

Attention:

- 6.2 A communication or notice that is addressed as above shall be considered to have been received:
 - a) immediately upon delivery, if delivered by hand; or
 - b) immediately upon transmission if sent or received by email; or
 - c) after 5 days from date of posting if sent by registered mail.
- 6.3 The *Owner* or the *Contractor* may, at any time, change its address for notice by giving written notice to the other at the address then applicable. Similarly if the *Contract Administrator* changes its address for notice then the *Owner* will give or cause to be given written notice to the *Contractor*.

7 GENERAL

7.1 This *Contract* shall be construed according to the laws of British Columbia.

Contractor:

- 7.2 The *Contractor* shall not, without the express written consent of the *Owner*, assign this *Contract*, or any portion of this *Contract*.
- 7.3 The headings included in the *Contract Documents* are for convenience only and do not form part of this *Contract* and will not be used to interpret, define or limit the scope or intent of this *Contract* or any of the provisions of the *Contract Documents*.
- 7.4 A word in the *Contract Documents* in the singular includes the plural and, in each case, vice versa.
- 7.5 This agreement shall enure to the benefit of and be binding upon the parties and their successors, executors, administrators and assigns

IN WITNESS WHEREOF the parties hereto have executed this Agreement the day and year first written above.

(FULL LEGAL NA	ME OF CORPORA	TION, PARTNEI	RSHIP OR INDIVIDUAL)
(AUTHORIZED SI	GNATORY)		_
(AUTHORIZED SI	GNATORY AND P	OSITION - PRII	NT)
Owner:			
The City of Co	<u>quitlam</u>		
(MANAGER, CAP Representative as	ITAL PROJECTS A s Per G.C. 17	ND INSPECTIO	NS)

(SENIOR MANAGER, DESIGN AND CONSTRUCTION)

Mariner Overpass Structural Rehab & Intersection Upgrade

Reference No: 78035A

Schedule 1

Schedule of Contract Documents

(INCLUDE IN LIST <u>ALL</u> DOCUMENTS INCLUDING, IF ANY, SUPPLEMENTARY GENERAL CONDITIONS, SUPPLEMENTARY SPECIFICATIONS, SUPPLEMENTARY STANDARD DETAIL DRAWINGS)

The following is an exact and complete list of the *Contract Documents*, as referred to in Article 2.1 of the Agreement.

<u>NOTE</u>: The documents noted with "*" are contained in the "Master Municipal Construction Documents – General Conditions, Specifications and Standard Detail Drawings", edition dated 2009. All sections of this publication are included in the *Contract Documents*.

- 1. Agreement, including all Schedules;
- 2. The following Addenda:
 - As issued
- 3. Supplementary General Conditions, if any;
- 4. General Conditions*;
- 5. Supplementary Specifications, if any;
- 6. Detail Specifications, if any;
- 7. Specifications*;
- 8. Supplementary Detail Drawings, if any;
- 9. Standard Detail Drawings*;
- 10. Executed Form of Tender, including all Appendices;
- 11. Drawings listed in Schedule 2 to the Agreement -"List of Drawings", if any;
- 12. Instructions to Tenderers;
- 13. COQUITLAM "Supplementary Specifications Master Municipal Construction Documents" March 2022

Mariner Overpass Structural Rehab & Intersection Upgrade

Reference No: 78035A

Schedule 2

LIST OF DRAWINGS

(Complete Listing of All Drawings, Plans and Sketches That Are Part of the Contract Documents)

Bound in this Document:

Appendix A: Traffic Management Detail Specifications

Appendix B: As-Builts

Appendix C: Archaeological Chance Find Procedures

Bound Separately: Contract Drawings

TITLE	SHEET NO.	REVISION NO.	DATE
BR230 MARINER WAY OVERPASS STRUCTURAL REHABILITATION	V (Asso	iated Eng	ineering)
COVER	1	-	-
CIVIL - GRADING PLAN	2	0	2025-05-28
CIVIL – CIVIL DETAILS	3	0	2025-05-28
STRUCTURAL – GENERAL NOTES	4	0	2025-05-28
STRUCTURAL – GENERAL ARRANGEMENT	5	0	2025-05-28
STRUCTURAL – SOUTH ABUTMENT – REPAIR DETAILS	6	0	2025-05-28
STRUCTURAL – NORTH ABUTMENT – REPAIR DETAILS	7	0	2025-05-28
STRUCTURAL – EAST ABUTMENT – REPAIR DETAILS	8	0	2025-05-28
STRUCTURAL – EXPANSION JOINT DETAILS	9	0	2025-05-28
STRUCTURAL – PARAPET AND NOISE BARRIER DETAILS	10	0	2025-05-28
STRUCTURAL – MISCELLANEOUS REPAIR DETAILS	11	0	2025-05-28
MARINER TRANSIT RAMP IMPROVEMENTS (Binnie, Ent	tuitive,	and DMD)	
COVER (BINNIE)	-	-	-
MARINER WAY TRANSIT RAMP – PAVEMENT MARKINGS AND SIGNS	1	4	2025-09-16
COVER (ENTUITIVE)	S000	0	10-01-2025
GENERAL NOTES	S100	0	10-01-2025
WORKING DRAWINGS	S101	0	10-01-2025
CONCRETE MEDIAN DETAILS	S102	0	10-01-2025
MARINER WAY OFF RAMP AT SKYTRAIN DRIVEWAY – TRAFFIC SIGNAL	1	3	2025-03-05
MARINER WAY OFF RAMP AT SKYTRAIN DRIVEWAY – TRAFFIC SIGNAL	2	3	2025-03-05

Supplementary General Conditions

SUPPLEMENTARY GENERAL CONDITIONS

TABLE OF CONTENTS

		Page
Supplementa	ry General Conditions to MMCD Volume II, 2009 Issue	SGC 1 to SGC 17
Section 1: DE	FINITIONS	SGC 3
1.1	Abnormal Weather	SGC 3
Section 2: D	OCUMENTS	SGC 3
2.2	Interpretation	SGC 3
Section 4: Co	ONTRACTOR	SGC 3 to 7
4.1	Control of Work	SGC 3
4.2	Safety	SGC 4
4.3	Protection of Work, Property and the Public	
4.6	Construction Schedule	SGC 5
4.7	Superintendent	SGC 5
4.8	Workers	SGC 5
4.9	Materials	SGC 5
4.11	Subcontractors	SGC 6
4.12	Tests and Inspections	SGC 6
4.14	Final Clean-up	SGC 7
4.16	Notice of Disruption	SGC 7
Section 7: CI	HANGES	SGC 7
7.1	Changes	SGC 7
7.4	Optional Work	SGC 7
Section 9: V	ALUATION OF CHANGES AND EXTRA WORK	SGC 8
9.2	Valuation Method	SGC 8
9.4	Quantity Variations	SGC 8
Section 10: F	FORCE ACCOUNTS	SGC 8
10.1	Force Account Costs	SGC 8
Section 12: H	HAZARDOUS MATERIALS	SGC 8 to 9
12.2	Discovery of Hazardous Materials	SGC 9
Section 13: [DELAYS	SGC 9 to 10
13.1	Delay by Owner or Contract Administrator	SGC 9
13.3	Unavoidable Delay	SGC 9
13.8	Direction to Stop or Delay	SGC 9
13.9	Liquidated Damages for Late Completion	
Section 18: F	PAYMENT	SGC 10 to 11
18.1	Preparation of Payment Certificate	SGC 10

18.4	Holdbacks	SGC 10
18.6	Substantial Performance	SGC 10
Section 19: T	AXES, DUTIES AND GST	SGC 11 to 12
19.4	Tariffs or Duties	SGC 11
Section 21: W	ORKERS COMPENSATION REGULATIONS	SGC 12
21.2	Contractor is "Prime Contractor"	SGC 12
Section 24: If	NSURANCE	SGC 12 to 17
24.1	General	SGC 12
24.2	Required Insurance	SGC 13
24.3	Physical Loss or Damage with Respect to New Buildings under	
	Construction and/or Major Additions to Existing Structures	SGC 14
24.4	Additional Insured	SGC 17
Section 25: N	AINTENANCE PERIOD	SGC 17
25.1	Correction of Defects	SGC 17
Section 27: C	ONTRACTOR PERFORMANCE EVALUATION	SGC 18
APPENDICES		SGC 19 to SGC 25
Apper	dix I Performance Bond	SGC 19 to 20
Apper	dix II Labour and Material Payment Bond	SGC 21 to 23
Apper	dix III Certificate of Insurance	SGC 24
Apper	dix IV Prime Contractor Designation Letter	SGC 25

CITY OF COC	UITLAM
Contract No.	78035A

SGC-3

1.0 **DEFINITIONS**

1.1 Abnormal Weather 1.1.1 **(Replace clause 1.1.1 as follows):**

Abnormal Weather" means temperature, precipitation, wind or other weather conditions in which the monthly average, differs from the statistical average for that condition in that period by more than one standard deviation, calculated based on data available from Environment Canada. Coquitlam's Burke Mountain Rain Gauge will be used to compare the rainfall summary versus the available data from Environment Canada.

City of Coquitlam Rainfall

2.0 DOCUMENTS

2.2 Interpretation 2.2.4 (1) **(Replace clause 2.2.4 (1) as follows):**

The Contract Documents shall govern and take precedence in the following order as listed in Schedule 1 of the Agreement, taking precedence over all Contract Documents.

4.0 CONTRACTOR

4.1 Control of the Work

4.1.1 *(Add to clause 4.1.1 as follows):*

The *Contractor* is responsible for all survey layout for the construction of the Work to the design specifications and/or elevations as shown on the contract drawings or as amended on site by the Contract Administrator, unless otherwise described in the Contract Document.

4.1.2 *(Add to clause 4.1.2 as follows):*

The Contractor shall not deposit any material upon any street, sidewalk, boulevard or other property, without the Contract Administrator's or the Owner's permission, nor shall they allow the same to remain longer than necessary. All surplus spoil and rubbish and other waste material shall be removed from the site so that the area of work is cleaned up and restored to as clean a condition as it was before the Contract started, within four days of the Contract Administrator's written request to do so, failing which the Owner may carry out the work or have the work carried out by others and recover the costs from the Contractor or may deduct the cost from any monies due or that may become due to the Contractor.

4.1.3 *(Add new clause 4.1.3 as follows):*

Work can be performed during the normal weekday working hours of 0700h to 1900h, unless specified otherwise in Supplementary Specifications - Appendix A:

Traffic Management Detail Specifications. Written permission from the Contract Administrator will be required for any works to be performed outside of the normal working days of Monday to Friday.

No Sunday work will be permitted, except in case of emergency and then only with the written permission of the Contract Administrator and to such extent as he deems necessary.

In case the Contractor decides to work on a day which is a Statutory Holiday, they shall provide the Contract Administrator in writing at least (4) days in advance of such holiday, stating those places where said work is to be conducted. In case the Contractor fails to give such notice in advance of any Statutory Holiday, no work within the terms of the contract shall be done on such holiday.

The cost of inspections on a Sunday or on a Statutory Holiday by City staff/s will be at Contractor's expense.

4.2 Safety 4.2.2

(Add new clause 4.2.2 as follows):

In an emergency, gas pipeline rupture or leak, Contact
FortisBC's 24 Hour Emergency Line (1-800-663-9911) and

FortisBC's 24 Hour Emergency Line (1-800-663-9911) and Coquitlam Fire (911) immediately and then City of Coquitlam's Utility Control Centre (604-927-6287).

4.3 Protection of Work, Property and the Public

4.3.1 (Replace clause 4.3.1 as follows):

In performing the Work, the Contractor shall protect the Work and the Owner's property and other person's property from damage. The Contractor shall at the Contractor's own expense make good any such damage which arises as the result of the Contractor's operations. If the Contractor causes damage to private property, the Contactor must obtain a written release from the owner of the damaged property.

4.3.5.1 (Add clause 4.3.5.1 as follows):

The Contractor shall notify the Contract Administrator immediately if damage occurs to any City or third party utility or structure.

4.3.7 (Add new clause 4.3.7 as follows):

Any lands other than those upon which the work is to be performed, which may be required for temporary facilities, storage purposes or access to the work site, other than those provided by the *Owner*, shall be provided by the *Contractor* at their own cost, with no liability to the *Owner*.

CITY OF COQUITLAM Contract No. 78035A		Supplementary General Conditions SGC-5		SGC-5
4.6	Construction Schedule	4.6.1	(Replace clause 4.6.1 as follows): The Contractor shall within the time set out in the Tender prepare and submit to the Contract Ad for their approval a construction schedule (the Construction Schedule) indicating the planned completion dates of major activities of the Nasseline Construction Schedule shall be in more the Preliminary Construction Schedule and should complete the Work in compliance with an Milestone Dates, including Substantial Performance	Iministrator ne Baseline d start and Work. The detail than nall indicate ny specified
		4.6.6	(Replace clause 4.6.6 as follows): The time for the performance of the Work shall on the date specified in the Notice to Proceed, specified, on the date the Notice to Proceed is i Notice to Proceed will not be issued documentation required under paragraph 5.1.1 of Tender has been submitted and the coschedule has been approved.	or if not so ssued. The until the of the Form
		4.6.8	(Add new clause 4.6.8 as follows): Any requests to lengthen the work schedule shain writing by the Contractor within five worki knowledge of the reason for the extension. The Administrator will adjust the schedule at their upon receipt of a written request.	ing days of he Contract
4.7	Superintendent	4.7.4	(Add new clause 4.7.4 as follows): The key personnel named in the Contractor response, shall remain in these key positions the project. In the event that key personne Contractor's firm, or for any unknown reason ar continue fulfilling their role, the Contractor mus suitable replacement, and obtain written conse Owner. Acceptance of the proposed replacement sole discretion of the Contract Administrate Owner.	throughout el leave the e unable to et propose a nt from the ent is at the
4.8	Workers	4.8.2	(Add new clause 4.8.2 as follows): The Contractor shall, upon the request of the Administrator, remove any person employed by the purposes of the Contract who, in the opin Contract Administrator, is incompetent or has themselves improperly, and the Contractor shall a person who has been removed to return to the Work.	by them for nion of the conducted I not permit
4.9	Materials	4.9.3	(Add new clause 4.9.3 as follows): The Contractor shall, at their cost,	

- a) Be responsible for storing all of the materials supplied for the Work either by themselves or the Owner, until it has been incorporated into the completed Work;
- Store all materials in a manner which will prevent damage from the weather, dirt, foreign matter, vandalism and theft;
- c) Arrange for and/or verify the time of delivery of all materials to be supplied by themselves or the Owner to ensure that delivery will coincide with their work schedules.
- d) Examine with the Contract Administrator the quantities and details of all materials supplied by the Owner at the time and place of delivery or those materials already at the Place of Work, and prepare and sign a Statement of Materials Acceptance, specifically noting and rejecting any defective material;
- Replace all materials supplied by themselves or the Owner which are found to be stolen, missing or damaged while under their care;
- f) Replace all materials found to be defective in manufacture which have been supplied by themselves.

4.11 Subcontractors 4.11.3 (*Replace clause 4.11.3 as follows*):

The Contractor shall, upon notice of the Contract Administrator, remove any Subcontractor employed by them for the purposes of the Contract who, in the opinion of the Contract Administrator, is incompetent or has conducted themselves improperly, and the Contractor shall not permit the Subcontractor who has been removed to return to the Place of Work. The removal of a Subcontractor under this clause shall not be considered a Change and the Contract Price and the Contract Time shall not be adjusted.

4.12 Test and Inspections

4.12.1 *(Replace clause 4.12.1 as follows):*

The Contractor shall perform or cause to be performed all tests, inspections and approvals of the Work as described in the Contract Documents or a required by the Contract Administrator as part of Quality Control. The Contractor shall complete all the necessary testing at the frequencies described in the Contract Document unless otherwise approved by the Contract Administrator.

Acceptable test and inspection results will not relieve the Contractor of its obligations under the Contract to correct defects or deficiencies in the Work.

4.12.11 *(Add clause 4.12.11 as follows):*

Failure to follow DFO/FLNRO BMPs and the approved permit for Instream Works or as instructed by Contract Administrator will result in shut-down of the work. The

	COQUITLAM t No. 78035A	Supplem	entary General Conditions SGC-7
			Contractor must take all steps to mitigate impacts to aquatic resources, environment and habitats before work can re-start on site. No claim will be accepted by the Owner for costs associated with this work shut-down.
4.14	Final Clean-up	4.14.1	(Replace clause 4.14.1 as follows): Prior to applying for Substantial Performance, the Contractor shall remove all surplus products, tools, construction machinery and equipment relating to the Work that is not required for the performance of the remaining Work. The Contractor shall also remove waste, debris and waste products other than caused by the Owner or Other Contractors, and leave the Place of Work clean and suitable for occupancy by the Owner unless otherwise specified in the Contract Documents or directed by the Contract Administrator.
4.16	Notice of Disruption	4.16.2	(Add new clause 4.16.2 as follows): Written notice must be provided to all properties which may be physically affected by the construction not less than one week and not more than two weeks prior to construction. Notify occupants directly affected by the work 48 hours in advance of commencement of construction. Cost of notifying area occupants of ensuing construction and delivery of the notices is incidental to the Contract.
7.0	CHANGES		
7.1	Changes	7.1.3	(Replace clause 7.1.3 as follows): Additional work that the Owner may wished performed that does not satisfy the requirements of subparagraphs (a) and (b) of GC 7.1.1 is extra work (Extra Work) and is not a Change. Pursuant to GC 8, Extra Work may be declined by the Contractor or may, upon agreement between the parties, be undertaken as Extra Work.
7.4	Optional Work	7.4.2	(Add new clause 7.4.2 as follows): If there are Optional items or Provisional items included in the Schedule of Quantities and Prices, those items shall be used only as directed and at the sole discretion of the Contract Administrator through the issue of a Change

the Schedule of Quantities and Prices, those items shall be used only as directed and at the sole discretion of the Contract Administrator through the issue of a Change Order. These items will be paid at the contract unit price as part of regular progress payments. Only quantities used will be eligible for payment. No claim will be accepted for unused Optional or Provisional quantities. Clause 9.4 Quantity Variations will not be applicable for these items.

	COQUITLAM t No. 78035A	Suppleme	ntary General Conditions	SGC-8
9.0	VALUATION OF CHANGES AND EXTRA WORK			
9.2	Valuation Method	9.2.4	(Replace clause 9.2.4 as follows): Once a quotation is accepted by the Contract or other agreement reached between Administrator and the Contractor regarding the Contract Price or Contract Time on according to 
9.4	Quantity Variations	9.4.1	(Replace clause 9.4.1 as follows): If for any reason, including an addition or de 7.1.1(1) or 7.1.1(2) respectively, the actual of price item varies by more than plus or min Threshold Percentage from the estimated of unit price item listed in the Schedule of Prices (the "Tender Quantity") or as other pursuant to these Contract Documents, Owner or the Contractor may by written no other party to agree to a revised unit price, change in quantities. A party shall make revised unit price as soon as reasonably perparty concerned becomes aware of the quantity.	uantity of a unit nus the Variance quantity for that Quantities and rwise agreed to then either the otice request the considering the a request for a possible after the
		9.4.2	(Delete clause 9.4.2 (2)	
10.0	FORCE ACCOUNTS			
10.1	Force Account Costs	10.1.1(1)	(Add to clause 10.1.1(1) as follows): Costs for the Contractor's Superinte Managers, Health and Safety Pe Office/Administration Staff are not eligible as those costs are considered incidental owing for overhead and labour.	ersonnel, and for labour costs
		10.1.1(4)	(Replace clause 10.1.1(4) as follows): Force Account Work performed by a subcorpaid for in the lesser of: (i) the amou subparagraphs (1), (2) and (3) of this GC, pl 5%, or (ii) the actual amount the Contraubcontractor including a mark-up of 10% costs to cover all overhead and profit.	nt provided by us a mark-up of ractor pays the

These Supplementary General Conditions must be read in conjunction with the General Conditions contained in the Master Municipal Construction Documents, Volume II, Printed 2009

HAZARDOUS MATERIALS

12.0

	COQUITLAM t No. 78035A	Suppleme	entary General Conditions SGC-9
12.2	Discovery of Hazardous Materials	12.2.2	(Replace clause 12.2.2 as follows): If the Contract Administrator observes any materials at the Place of Work that the Contract Administrator knows or suspects may be Hazardous Materials, then the Contract Administrator shall immediately give written notice to the Contractor and the Contractor shall immediately stop the Work or portion of the Work as required by GC 12.2.1(1).
13.0	DELAYS		
13.1	Delay by Owner or Contract Administrator	13.1.2	(Add new clause 13.1.2 as follows): The Owner may at any time suspend the work or any portion thereof provided they give the Contractor five (5) days' written notice of delay. The Contractor shall resume work upon written notice from the Owner. The Contractor shall be entitled to:
			 a) An extension of the Contract time equivalent to the length of suspension of work. b) Reimbursement by the Owner for directly related out-of-pocket additional costs, reasonably and necessarily incurred by the Contractor as a result of such suspension. No additional payment will be made to the Contractor for any loss of profits or overhead.
13.3	Unavoidable Delay	13.3.1	(Add to clause 13.3.1 as follows): Beyond the reasonable control of the Contractor also includes pandemic or community outbreak
13.8	Direction to Stop or Delay	13.8.3	(Add new clause 13.8.3 as follows): The Contract Administrator may order the Contractor to stop work if at any time the Contract Administrator is of the opinion that there exists a danger to life or property.
13.9	Liquidated Damages for Late Completion	13.9.1	(Replace clause 13.9.1 as follows): If the Contractor fails to meet the Milestone Date for Substantial Performance as set out in the Form of Tender, paragraph 2.2 as may be adjusted pursuant to the provisions of the Contract Documents, then the Owner may deduct from any monies owing to the Contractor for the Work: (1) An amount of \$1,000.00 for each calendar day the actual Substantial Performance is achieved after the Substantial Performance Milestone Date; plus (2) All direct out of pocket costs, such as costs for safety, security or equipment rental, reasonably incurred by the Owner as a direct result of such delay.

These Supplementary General Conditions must be read in conjunction with the General Conditions contained in the Master Municipal Construction Documents, Volume II, Printed 2009

delay.

CITY OF COQUITLAM
Contract No. 78035A

SGC-10

If the monies owing to the Contractor are less than the total amount owing by the Contractor to the Owner under (1) and (2) then any shortfall shall immediately, upon written notice from the Owner, and upon Substantial Performance, be due and owing by the Contractor to the Owner.

18.0 PAYMENT

18.1 Preparation of Payment Certificate

18.1.1 *(Replace clause 18.1.1 as follows):*

The Contract Administrator shall prepare and issue a certificate for the period ending the last calendar day of the month.

18.4 Holdbacks

18.4.2 *(Add to clause 18.4.2 as follows):*

At the sole discretion of the Contract Administrator, an amount equivalent to 10% of the contract award value or 200% of a reasonable estimate, whichever is higher, may be held without interest until all deficiencies have been remedied and accepted by the Contract Administrator.

18.6 Substantial Performance

18.6.5 *(Replace clause 18.6.5 as follows):*

The Owner may release any builders lien holdback on the <u>56th day</u> following the date of Substantial Performance, or other date as required by law, but the Owner may hold back the amounts for any deficiencies or filed builders liens as provided in GC 18.4.2, 18.4.3 and 18.4.4.

18.6.6 *(Replace clause 18.6.6 as follows):*

The Contract Administrator, as defined herein, shall be the Payment Certifier responsible under Section 7 of the Builders Lien Act for certifying Substantial Performance of the Work of the Contractor, but not the Work of Subcontractors. The Contractor shall cooperate with and assist the Contract Administrator by providing information and assistance in a timely manner as the Contract Administrator considers necessary to carry out the duties of the Payment Certifier for the Contract.

The Contractor shall be the Payment Certifier responsible under Section 7 of the Builders Lien Act for certifying Substantial Performance of the Work of each Subcontractor. Prior to certifying completion for a Subcontractor, the Contractor shall consult the Contract Administrator and obtain the Contract Administrator's comments on the status of completion by the Subcontractor, including any deficiencies or defects in the Subcontractor's Work noted by the Contract Administrator. The Contractor will indemnify and save the Owner harmless from any and all liability the Owner may have to anyone arising out of the certification by

the *Contractor* of *Substantial Performance* for that *Subcontractor*.

Notwithstanding any other provision of the *Contract*, no payments will be due or owing to the *Contractor* so long as a Lien filed by anyone claiming under or through the *Contractor* remains registered against the Project of any lands, or interest therein, on which *Work* for the project was performed. Failure of the *Contractor* to remove all Liens promptly will entitle the *Owner* to damages.

19.0 TAXES, DUTIES AND GST

19.4 Tariffs or Duties

19.4.1

Tariffs or Duties refer to taxes, levies, or charges imposed by any level of government (including foreign governments) on imported or domestic goods, materials, or equipment used in the performance of the Work. The Contract Price is based on the tariffs and duties in effect as of the date of the Tender Closing. If, after the Tender Closing Date, any new Tariffs or Duties are imposed, or existing rates are materially increased, and such changes directly and demonstrably affect the cost of materials or equipment required for the performance of the Work, the Contractor shall notify the Contract Administrator in writing within ten (10) Working Days of becoming aware of such change, providing supporting documentation, including but not limited to:

- (1) Affected materials
- (2) Quantity and cost impact
- (3) Evidence of original and new tariff rates
- (4) Reasonable efforts made to mitigate the cost impact (e.g., sourcing alternatives)
- 19.4.2 If the Contract Administrator is satisfied that the Contractor has incurred additional direct costs solely due to the change in Tariffs or Duties, the Owner will issue a Change Order to adjust the Contract Price accordingly. No adjustment shall be made for Tariffs or Duties that were publicly announced or reasonably foreseeable before the Tender Closing Date.
- 19.4.3 This clause does not apply to costs incurred due to delays caused by the Contractor's procurement or supply chain management. It also does not apply if the Contractor fails to take reasonable steps to mitigate the impact of the change.

	COQUITLAM t No. 78035A	Supplem	entary General Conditions SGC-12
		19.4.4	If the imposition of new Tariffs or Duties causes unavoidable delays in material delivery, the Contractor may request an extension of the Contract Time under GC 13.3, subject to approval by the Contract Administrator.
21.0	WORKERS COMPENSATION REGULATIONS		
21.2	Contractor is "Prime Contractor"	21.2.1	(Add to clause 21.2.1 as follows): Prior to the issuance of the "Notice to Proceed" the Contractor must provide a signed "Prime Contractor Designation" form as provided in Appendix IV of these Supplementary General Conditions.
24.0	INSURANCE		(Replace section 24.0 as follows):
24.1	General	24.1.1	Importance of Prompt Attention to Insurance Requirements: The Contractor shall provide the Owner with satisfactory evidence that the insurance required to be provided under this GC is in full force and effect.
		24.1.2	Acceptable Insurance Carriers: The insurer issuing any policy, or other document which is evidence of insurance to the Contractor, shall be an insurer licensed by the Superintendent of Insurance in the Province of British Columbia and registered with the Department of Insurance for Canada in Ottawa, except the Insurance Corporation of British Columbia, which is not subject to this condition.
		24.1.3	Owner's Right to Change Terms: Notwithstanding anything contained in the Contract Documents, the Owner will have the right to request a change to the specified terms and conditions respecting insurance at the sole option of the Owner. The Contractor will be notified in writing of any changes required by the Owner and will provide a quotation for such work.

24.1.4 **Delivery of Insurance Documents:**

All insurance policies or other acceptable specified documents shall be delivered to, and accepted by, the Owner before the Contract Documents are signed. No work shall be commenced by the Contractor or by anyone acting on the instructions of the Contractor, until the required Insurance Documents have been accepted by the Owner

and the Contract Documents have been duly signed by the Owner and the Contractor.

24.1.5 **Owner's Right to Insure:**

Should the Contractor for any reason not comply with the specified requirements with respect to the insurance, the Owner will, at the Owner's option, have the right to purchase all or any part of such insurance which, in the opinion of the Owner, may be required to provide the specified insurance, and, in the event of so doing, the Owner will have the right to pay the premiums for such insurance and to withhold the amount of premiums so paid from any amount due and payable to the Contractor under the Contract.

24.2 Required Insurance

24.2.1 General

Damage to work (excluding Building Contracts where Section 24.3, Paragraph 24.3.1, Further Responsibilities of Contractor, applies).

The Contractor shall be responsible for any and all loss, or damage, whatsoever which may occur on or to the works, completed or otherwise, until such time as the entire works have been completed and the Notice of Acceptance has been issued by the Owner, except that loss or damage caused solely by an act of the Owner. In the event of any loss or damage occurring, the Contractor shall, on notice from the Contract Administrator, immediately put the works into the condition it was immediately prior to such loss or damage, all at the

Contractor's expense, except where such loss or damage was caused solely by an act of the Owner.

The Contractor shall be responsible for any and all loss or damage whatsoever which may occur on or to the works, completed or otherwise, arising out of the negligence of the Contractor, any subcontractors, and the employees or agents of any of them.

24.2.2 **Public Liability Insurance:**

(Other than Automobile Third Party Liability Insurance): **Evidence of Insurance:**

The Contractor shall deposit with the Owner, before the work commences, a Certificate of Insurance, signed by an authorized representative of the insurer, such certificate to be as shown in Appendix III.

Effective Dates and Terms:

The effective date of the Certificate of Insurance shall be the date of the execution of the Contract Agreement and the term of this policy shall be from such effective date until a date not less than twelve (12) months after the date of Substantial Performance completion of all work under the Contract.

Limits of Liability:

For bodily injury and for property damage shall be inclusive limits not less than \$5,000,000.

24.2.3 **Public Liability Insurance (Automobile):**

The Contractor shall deposit with the Owner before the work commences a Certificate of Insurance with respect to owned automobiles on ICBC Form No. APV 47 entitled "Confirmation of Insurance Coverage" and with respect to Non-Owned Automobiles including hired automobiles and Contractual Liability on ICBC non-owned automobile policy Form APV 29 (if non-owned automobile coverage is not included under the comprehensive general liability coverage) each signed by an authorized representative of the Insurance Corporation of British Columbia.

24.3 Physical Loss or Damage With Respect to New Buildings under Construction and/or Major Additions to Existing Structures

24.3.1 **Responsibility for Placing Insurance:**

The types of insurance required under this section will be provided and maintained at the expense of the City of Coquitlam during the term of the Contract and will be as follows unless otherwise changed by specific endorsement to these Insurance Specifications.

24.3.2 **Insurance Coverage Required:**

Builders Risk Completed Value "All Risks" Course of Construction Insurance. This policy will be written in the names of the City of Coquitlam and the Contractor with loss payable as their respective interests may appear.

24.3.3 Responsibility of Contractor – Limitations of cover and deductibles:

The insurance provided by the City of Coquitlam as described herein will not provide the Contractor with full protection against any and all kinds of loss or damage which may arise out of the Contract. It is, therefore, the responsibility of the Contractor to fully understand the scope of the cover provided with particular attention to the exclusions, limitations of cover and deductible provisions

contained in the Insuring Agreements of the policies and it is further the responsibility of the Contractor to take out at the Contractor's expense, whatever other additional insurance the Contractor may consider necessary or desirable for his protection subject as hereinafter provided. The Contractor shall act in the same manner on insurance made available through the City of Coquitlam as he would if he had arranged such insurance himself.

24.3.4 Responsibility of Contractor – Direct Damage Insurance:

If the Contractor fails to do all or anything that is required of them concerning insurance, the City of Coquitlam may do what is required and any monies expended by the City of Coquitlam for that purpose shall be repayable and recoverable from the Contractor. Should any action, failure or negligence of the Contractor result in higher insurance costs being incurred by the City of Coquitlam, such additional costs shall be payable or recoverable from the Contractor.

24.3.5 Responsibility of Contractor – Machinery and Equipment Belonging to Others:

Unless otherwise directed by the City of Coquitlam in writing, the Contractor shall carry insurance covering loss or damage to construction machinery, tools and equipment owned by and/or on bare rental from a third party or parties and used by the Contractor in performing the work, which insurance shall be in a form satisfactory to the City of Coquitlam and having coverage in accordance with the actual cash value of such construction machinery, tools and equipment. Such policies shall also provide for subrogation to be waived against the City of Coquitlam. A certified copy of the policy shall be delivered to the City of Coquitlam not later than thirty days after the commencement of work under the Contract.

24.3.6 **Contractor's Waiver of Liability to Coquitlam:**

The Contractor hereby releases the City of Coquitlam from any and all liability for damages to the extent that such damages are covered by the course of construction insurance referred to in Section 24.3 of these specifications.

24.3.7 **Liability of Contractor:**

Neither the providing of insurance by the Contractor or the City of Coquitlam in accordance with the requirements hereof, nor the insolvency, bankruptcy, nor failure of any insurance company to pay any claim accruing shall be held to waive any of the provisions of this Contract with respect to the liability of the Contractor or otherwise.

24.3.8 Responsibility of Contractor for protection of work, persons and property:

The Contractor and all persons employed by the Contractor or under their control, and all employees and subcontractors, shall use due care that no person or property is injured, and that no rights are infringed in the prosecution of the work. Contractors shall take particular care to protect the work against loss or damage caused by riot, vandalism or malicious mischief and shall be at the expense of the Contractor provide all necessary safeguards in the form of watchmen and/or watch dog protection to prevent loss or damage of this type. The payment of deductibles is the responsibility of the Contractor and if not paid by the Contractor such amounts shall be deducted by the City of Coquitlam from payment due to the Contractor. These deductibles will normally be \$250.00 each claim.

24.3.9 Action to be taken in the event of loss or damage to the work covered by the Contract:

When any loss or damage occurs to the work or to any materials and supplies on the site of the work, the Contractor shall remove any and all damaged or destroyed property and shall rebuild or replace the damaged or destroyed work, materials, or supplies and complete the work to the satisfaction of the Owner. For such removal, rebuilding, or replacing, the Contractor shall be entitled to receive from the Owner the amount of insurance monies received by the Owner pursuant to the said adjustment which amount shall be paid to the Contractor as the work of rebuilding or replacing proceeds, and in accordance with the Agreement. Damage or destruction of the whole or any part of the work shall not affect the rights and obligations of either party under the Agreement, except that in such event the Contractor shall be entitled to such reasonable extension of time to complete the work as the Architect and/or Contract Administrator may decide.

24.3.10 Further responsibility of Contractor:

Other than with respect to loss or damage arising out of insured risks and herein before specified, the Contractor shall be responsible for all loss or damage whatsoever which may occur on or to the works completed or otherwise, until such time as the entire works have been completed and the Notice of Acceptance has been issued by the Owner, except that loss or damage caused solely by an act of the Owner.

In the event of any loss or damage occurring, the Contractor shall on notice from the Owner immediately put the works into the condition it was immediately prior to such loss or damage, all at the Contractor's expense except as previously stated.

24.3.11 Owner Not Responsible for Loss or Damage or Loss of Use of Property of Contractors and their Employees:

The Owner will not be responsible for securing or paying for insurance of any kind other than as specified in Section 24.3 of these specifications nor will the Owner have any responsibility whatsoever for loss or damage from whatever cause occurring to property owned, leased, or otherwise in the possession of the Contractor, subcontractors or their employees including, without restricting the generality of the foregoing, machinery, equipment, tools, supplies, and clothing at the construction site or elsewhere including loss of use of same.

24.4 Additional Insured 24.4.1

The Contractor shall ensure the following are named as "additional insured" on the liability policy for this contract:

The City of Coquitlam

The City may identify private properties that are directly affected by construction. If so, the Contractor shall include the legal owners of these properties named as "additional insured" on the liability policy for this contract.

25.0 MAINTENANCE PERIOD

25.1 Correction of Defects

25.1.4 (Add new clause 25.1.4 as follows):

The Owner is authorized to make repairs to defects or deficiencies if, ten days after giving written notice, the Contractor has failed to make or undertake with due diligence the required repairs. However, in the case of emergency where, in the opinion of the Owner, delay is not reasonable, repairs may be made without notice being sent to the Contractor. All expenses incurred by the Owner in connection with repairs made pursuant to GC 25 shall be paid by the Contractor or may be deducted from the Maintenance Security, or other holdbacks. The Contractor shall promptly pay any shortfall.

CITY OF COQUITLAM	Supplementary General Conditions	SGC-18
Contract No. 78035A		

27.0 CONTRACTOR PERFORMANCE EVALUATION

27.1 (Add new clause 27.1 as follows):

After the completion of the Contract, the Contractor will be evaluated on their performance of the Work. The evaluation will provide percentage scores on the following categories:

- 1. Contract Administration
- 2. Construction Management
- 3. Schedule Management
- 4. Communications
- 5. Resource Management and Contractor Performance
- 6. Quality Management

An evaluation summary report may be issued to the Contractor with scores for each of these categories. Upon request, the Contractor may attend a meeting with the City to discuss the evaluation.

This internal evaluation may be reviewed for reference on subsequent tenders with the City. Evaluation scores can form part of the tender analysis and influence contract award decisions.

Evaluation Scores in categories that are below 50% may result in a suspension of tendering privileges with the City.

APPENDIX I

PERFORMANCE BOND

	NO	_	\$		
	KNOW	ALL MEN BY TH	ESE PRESENTS TH	AT	
	As Princip	oal, hereinafter o	called the Principa	l, and	
	As Surety, hereinafte	r called the Sure	ety, are held and f	irmly bound unto	
	As Obligee, her	einafter called t	he Obligee, in the	amount of	
		(\$)	Dollars	
the Surety bir			•	to be made, the Principal acessors and assigns, jointly	
WHEREAS, the	e Principal has entered	into a written co	ontract with the O	bligee, dated the	
day of	20	, for			

in accordance with the drawings and specifications submitted, therefore, which contract, drawings and specifications and addenda thereto, to the extent provided for, are by reference made part hereof and are hereinafter referred to as the Contract.

NOW THEREFORE, THE CONDITION OF THIS OBLIGATION is such that, if the Principal shall promptly and faithfully perform said Contract (including any addenda thereto, provided such addenda do not collectively increase the amount to be paid to the Principal by more than twenty per cent (20%) of the amount of the Contract except with the written consent of the Surety) then this obligation shall be null and void; otherwise, it shall remain in full force and effect.

CITY OF COQUITLAM	Supplementary General Conditions	SGC-20
Contract No. 78035A		

Whenever the Principal shall be, and declared by Obligee to be, in default under the Contract, the Obligee having performed Obligee's obligations thereunder, the Surety may promptly remedy the default, or shall promptly:

- 1. Complete the Contract in accordance with its terms and conditions, or
- 2. Obtain a bid or bids for submission to Obligee for completing the Contract in accordance with its terms and conditions, and upon determination by Obligee and Surety of the lowest responsible bidder, arrange for a contract between such bidder and Obligee and make available as work progresses (even though there should be a default or a succession of defaults under the contract or contracts of completion arranged under this paragraph) sufficient funds to pay the cost of completion less the balance of the contract price; but not exceeding, including other costs and damages for which the Surety may be liable hereunder, the amount set forth in the first paragraph hereof. The term 'balance of the contract price', as used in this paragraph, shall mean the total amount payable by Obligee to Principal under the Contract less the amount properly paid by Obligee to Principal.

Any suit under this Bond must be instituted before the expiration of two (2) years from date on which the Notice of Acceptance under the Contract is issued.

The Surety shall not be liable for a greater sum than the specified penalty of this Bond.

No right of action shall accrue on this Bond to or for the use of any person or corporation other than the Obligee named herein or the heirs, executors, administrators, or successors of Obligee.

	·	set its hand and affixed its seal, and the Surety has ate seal duly attested by the signature of its
Attorney-in-fact, this	·	20
•		
CICNED CEALED and D	AELTVEDED	
SIGNED, SEALED and D	PELIVERED	
In the presence of	1	DDINCIDAL
)	PRINCIPAL
)	
)	
)	SURETY
)	
	,	

APPENDIX II

LABOUR AND MATERIAL PAYMENT BOND

(Private Contracts – Trustee Form)

NO	_	\$	
Note: This Bond is issued simultane for the full an	-	er Bond in favour on the contr	_
KNOW A	LL MEN BY THESI	E PRESENTS THAT	
As Principal	, hereinafter call	ed the Principal, ar	 nd
As Surety, hereinafter called the Sur	etv. are. subject	to the conditions h	 nereinafter contained, held
To sure egy, the contacted cancal time sur	and firmly bour		ieremanter esmantea, meta
As Trustee, hereinafter called the Ob of their heirs, executors, adr			
			Dollars
\$) lawful money of Can the Principal and the Surety bind ther assigns jointly and severally, firmly by	nselves, their hei	nent of which sum	well and truly to be made,
SIGNED AND SEALED this	_day of	, 20	
WHEREAS, the Principal has entered in day of		tract with the Obli	gee dated the
which contract is by reference made a	a part hereof, and	d is hereinafter ref	erred to as the Contract.
NOW, THEREFORE, THE CONDITION Coayment to all Claimants for all labou performance of the Contract, then thi full force and effect, subject, however	r and material us is obligation shal	sed or reasonably I be null and void;	required for use in the

- 1. A Claimant for the purpose of this Bond, is defined as one having a direct contract with the Principal for labour, material, or both, used or reasonably required for use in the performance of the Contract, labour and material being construed to include the part of water, gas, power, light, heat, oil, gasoline, telephone service or rental equipment directly applicable to the Contract provided that a person, firm or corporation who rents equipment to the Principal to be used in the performance of the Contract under a contract which provides that all or any part of the rent is to be applied towards the purchase price thereof shall only be a Claimant to the extent of the prevailing industrial rental value of such equipment for the period during which the equipment was used in the performance of the Contract. The prevailing industrial rental value of equipment shall be determined, insofar as it is practical to do so, in accordance with and in the manner provided for in the latest revised edition of the publication of the Canadian Construction Association entitled "Rental Rates on Contractors' Equipment" published prior to the period during which the equipment was used in the performance of the Contract.
- 2. The Principal and the Surety hereby jointly and severally agree with the Obligee as Trustee that every Claimant who has not been paid as provided for under the terms of his contract with the Principal before the expiration of a period of ninety (90) days after the date on which the last of such Claimant's work or labour was done or performed or materials were furnished by such Claimant, may as a beneficiary of the trust herein provided for, sue on this Bond, prosecute the suite to final judgment for such sum or sums as may be justly due to such Claimant under the terms of his said contract with the Principal and have execution thereon. Provided that the Obligee is not obliged to do or take any act, action or proceeding against the Surety on behalf of the Claimants or any of them to enforce the provisions of this Bond. If any act, action or proceeding is taken either in the name of the Obligee or by joining the Obligee as a party to such proceedings then such act, action or proceeding shall be taken on the understanding and basis that the Claimants or any of them who take such act, action or proceeding shall indemnify and save harmless the Obligee against all costs, charges and expense or liabilities incurred thereon and any loss or damage resulting to the Obligee by reasons thereof. Provided still further that subject to the foregoing terms and conditions, the Claimants or any of them may use the name of the Obligee to sue on and enforce the provisions of this Bond.
- 3. No suit or action shall be commenced hereunder by any Claimant:
 - a) unless such Claimant shall have given written notice within the time limits hereinafter set forth to each of the Principal, Surety and Obligee, stating with substantial accuracy the amount claimed. Such notice shall be served by mailing the same by registered mail to the Principal, Surety and Obligee at any place where an office is regularly maintained for the transaction of business by such persons or served in any manner in which legal process may be served in the Province or other part of Canada in which the subject matter of the contract is located. Such notice shall be given (i) in respect of any claim for the amount or any portion thereof required to be held back from the Claimant by the Principal under either the terms of the Claimant's contract with the Principal or under the Mechanic's Liens Legislation applicable to the Claimant's contract with the Principal whichever is the greater within one hundred and twenty (120) days after such Claimant should have been paid in full under the Claimant's contract with the Principal; (ii) in respect of any claim other than for the holdback or portion thereof referred to above within one hundred and twenty (120) days after the date upon which such claimant did

- or performed the last of the work or labour or furnished the last of the materials for which such claim is made under the Claimant's contract with the Principal.
- b) after the expiration of one (1) year following the date on which Principal ceased work on the Contract including work performed under guarantees provided in the Contract.
- c) Other than in a court of competent jurisdiction in the Province or District of Canada in which the subject matter of the Contract or any part thereof is situated and none elsewhere, and the parties hereto agree to submit to the jurisdiction of such court.
- 4. The amount of this Bond shall be reduced by and to the extent of any payments made in good further and in accordance with the provisions which may be filed of record against the subject matter of the Contract, whether or not claim for the amount of such lien be presented under and against this Bond.
- 5. The Surety shall not be liable for a greater sum than the specified penalty of this Bond.

IN TESTIMONY WHEREOF, the Principal has hereto set its hand and affixed its seal, and the Surety has caused these presents to be sealed with its corporate seal duly attested by the signature of its Attorney-in-fact the day and year first above written.

SIGNED, SEALED and	DELIVERED		
In the presence of			
)	PRINCIPAL	
)		
)		
)	SURETY	
)		

APPENDIX III

CERTIFICATE OF INSURANCE

This Certificate issued to the City of Coquitlam is to certify that policies of insurance, as described below, have been issued to the Insured named below and are in force at this time. It is understood and agreed that thirty (30) days' prior written notice by registered mail of any material alterations, transfer, assignment or cancellation of any of the policies listed below, either in part or in whole, will be given to the holder of this Certificate.

A.	This Certificat	e is issued to:	Named Insured and Mailing Address:		
	300	r of Coquitlam 0 Guildford Way _J uitlam, BC V3B 7N2			
В.	CONTRACT N	JMBER AND/OR NAME	Description of the Work:		
C.	INSURANCE P	<u>OLICY</u>			
	Name of Insure				
	Policy Number	:	Liability Limit:		
	Effective Date:		Expiry Date:		
D.		GENERAL LIABILITY coverage is a	required to insure against liability from the activities arising out of operations or work in luding liability arising out of the use of City property.		
D.1			isive per occurrence against bodily injury, personal injury and property damage.		
D.2			s, agents and volunteers are added as Additional Insureds, but only with respect to		
	operations con	ducted by or on behalf of the Na	amed Insured in connection with the above-described project, operations or work.		
D.3	This insurance	shall be primary as regards the	City of Coquitlam, its employees, officers, agents and volunteers as Additional Insureds.		
D.4	•	e or reimbursement clause con of the Named Insured.	tained in the policy shall not apply to the City of Coquitlam and shall be the sole		
D.5		shall include the following cover	ranes:		
2.5	D.5.1 Cross Liability Clause				
	D.5.2 Non-Owned Automobile Liability				
		censed Automobile Liability			
	D.5.4 Blanket Contractual Liability				
		ad Form Property Damage Liabil	lity		
		ner's & Contractor's Protective Li			
		ducts & Completed Operations L	· ·		
D.6		ion of special coverage for this p	· · · · · · · · · · · · · · · · · · ·		
2,0	•	O Special Coverage Des			
	() ()	() Charing and Undernie	oning Hazard		
	() ()		•		
	() ()	•	tions		
	() ()	•			
	() ()	•			
	() ()	() Blasting			
			Authorized Signature and Stamp		
Date			Name and Title		
City' br	oker to return to	City Representative	Department		



APPENDIX IV

Owner		CITY OF COQUITLAM
Contractor:		700254
	ct / Permit #: : / Workplace:	78035A Mariner Overpass Structural Rehab & Intersection Upgrade (the "Project")
rroject	7 Workplace.	warmer overpass structural Kerias & Intersection opgrade (the Troject)
By sign	ing this Prime (Contractor Designation form, the Contractor hereby:
1.	Compensation	and accepts designation as, the "prime contractor" for the purposes of the Worken Act, R.S.B.C. 2019, c. 1 (the "Act") and the Occupational Health and Safety C. Reg. 223/2022 (the "Regulation") in respect of the Project and Workplace noted
2.	prime contrac	d warrants that the Contractor is qualified and capable to perform the duties of tor and that the undersigned signatory has the authority to accept designation as tor and to bind the Contractor;
3.	persons at the to do everythi	uty and responsibility for ensuring the activities of employers, workers and other workplace relating to occupational health and safety are coordinated and agreeing that is reasonably practicable to establish and maintain a system or process compliance with the Act and the Regulation in respect of the Workplace;
4.		d agrees to comply with the occupational health and safety provisions of the Act, n, any other applicable regulations under the Act, and any applicable orders;
5.	the Owner tha	and agrees that the Owner has provided the Contractor the information known at is necessary to identify and eliminate or control hazards to the health or safety workplace; and
6.	-	e designation as prime contractor hereunder may not be assigned or revoked rior written consent of the Owner.
e Contra	nctor Name:	
e Contra ess:	ector	

Print Name

Prime Contractor Signature

Please return a signed copy of this designation to the City of Coquitlam, 3000 Guildford Way, Coquitlam, BC, V3B 7N2. If you have any questions, please contact the City of Coquitlam Health & Safety Manager at 604-927-3070.

These Supplementary General Conditions must be read in conjunction with the General Conditions contained in the Master Municipal Construction Documents, Volume II, Printed 2009

Date

Supplementary Contract Specifications

SUPPLEMENTARY
CONTRACT INDEX
SPECIFICATIONS
SECTION INDEX
SS 1
SPECIFICATIONS
SECTION INDEX
SECTION INDEX

Supplementary Contract Specifications

to the

MASTER MUNICIPAL SPECIFICATIONS Volume II – Platinum Book

MARINER OVERPASS STRUCTURAL REHAB & INTERSECTION UPGRADE

CONTRACT 78035A

TABLE OF CONTENTS

The following Supplementary Specifications are to be considered part of the Specifications. These Supplementary Specifications take precedence over the Master Municipal Specifications.

SUPPLEMENTARY CONTRACT

SPECIFICATIONS	S INDEX	SS 1
00 72 43S	Contract Specific Notations	SS 2 to SS 5
01 33 01S	Project Record Documents	SS 6
01 42 00S	Reference Specifications	SS 7
01 45 00S	Quality Control	
01 55 00S	Traffic Control, Vehicle Access and Parking	SS 10 to SS 11
01 57 01S	Environmental Protection	
01 58 01S	Project Identification	SS 15
03 10 00S	Concrete Forming and Accessories	SS 16 to SS 17
03 20 01S	Concrete Reinforcement	SS 18 to SS 20
03 30 53S	Cast-in-Place Concrete	SS 21 to SS 31
05 53 00S	Metal Fabrications	
07 91 00S	Joints	SS 38 to SS 41
31 05 17S	Aggregates and Granular Materials	SS 42
31 11 01S	Clearing and Grubbing	SS 43
31 23 01S	Excavating, Trenching and Backfilling	SS 44
31 24 13S	Roadway Excavation, Embankment and Compaction	SS 45 to SS 46
32 11 23S	Granular Base	SS 47
32 12 13.15	Asphalt Tack Coat	SS 48
32 12 16S	Hot-Mix Asphalt Concrete Paving	SS 49 to SS 51
32 17 23S	Painted Pavement Markings	SS 52 to SS 54
33 40 01S	Storm Sewers	
33 44 01S	Manholes and Catchbasins	SS 57 to SS 58
34 41 135	Traffic Signals	SS 59 to SS 68

1.0 GENERAL

1.1 Coordination of Work Add 1.1.1

The Contractor shall be responsible to consult with all affected businesses, residents and transportation companies regarding delays, detours, and any other works affecting any transit service in the area, and will be responsible to coordinate the works with City crews and other contractors working in the area. If working area is to become a multiple-employer workplace as defined by WorkSafe BC, the Contractor shall remain the Prime Contractor.

1.2 Outside Agency Approval Add 1.2.1

In accordance with the Contract Documents, the Contractor is responsible to consult with and obtain any approval required to meet and comply with all the conditions required from outside agency such as, but not limited to, BC One Call, Metro Vancouver, BC Hydro, TELUS, Kinder Morgan, Coast Mountain Bus Company, and Fortis BC, in the area of the place of Work.

1.3 Waste Collection Add 1.3.1 Coordination

- Contractor is responsible to accommodate all waste collection vehicles and cart pick up schedules throughout construction.
 Collection schedule can be found in https://www.coquitlam.ca/157/Collection-Calendar-Guidelines.
- 2. If waste collection will be impacted the Contractor is responsible to:
 - a. Provide advanced notification to:
 - The City's Solid Waste staff at 604-927-3500 or wastereduction@coquitlam.ca; and
 - ii. The City's Contract Administrator.
 - Provide access for collection trucks to closed streets due to road work; or
 - c. Move waste carts for collection. The Contractor is required to ensure each cart is labelled with the property address and returned to the correct address after collection (each cart has its own individual cart identification code and is specifically assigned to each property). Contractors will be responsible for the costs to replace missing carts.
- 3. Contractor's Request for Change in Collection Time (e.g. PM to AM):
 - a. The Contractor must provide residents with as much notice as possible – minimum 5 working days.
 - b. The contractor must follow all conditions of Clause 1.04 and is responsible to deal with any missed collections. For example, taking garbage to the United Boulevard Recycling and Waste Centre or covering the cost associated for any missed collection to be rescheduled.

Questions: wastereduction@coquitlam.ca

1.4 Cooperation with Add 1.4.1 Emergency and Maintenance Activities

The Contractor will be responsible to cooperate with regular maintenance or emergency vehicles and staff for access to the site when required including:

- Fire, Police, and Ambulance
- Collection (garbage/recycling pick-up)
- City Utilities Maintenance (or representatives)
- Other Contractors

1.5 Site Safety Add 1.5.1

The Contractor is responsible to ensure the construction site is safe at all times for workers, pedestrians, and vehicle traffic. During non-working hours, the Contractor must ensure that the site has all potentially hazardous areas appropriately identified and protected, and also must provide appropriate signage, lighting, and markings for the direction of

and use of this equipment is considered incidental to the contract.

Manhole lids, valve boxes and other appurtenances within the roadway that may present a traffic hazard during construction must be clearly marked for traffic.

Manhole lids left raised in preparation for paving must have a rubberized protector ring painted with bright colour for traffic safety. Supply and use of this equipment is considered incidental to the contract.

1.6 Lane Closure Restrictions Add 1.6.1

The Contractor shall refer to Contract Supplementary Specifications Section 01 55 00S and to Appendix A: Traffic Management Detail Specifications.

The Contractor must take the above information into account in the preparation and submission of the Tender.

1.7 Location of Existing Add 1.7.1 Utilities

The Contractor is responsible to verify the depth and location of all utilities (watermains, storm mains, sanitary mains etc.), including outside agency utilities (i.e. Fortis BC Gas Mains etc.) and service connections (water, storm and sanitary services at the mains, and property lines) by hand digging or by Hydro-Vac in the presence of the Site Inspector.

Pre-locates must be completed as soon as possible after award of the Contract so changes can be completed by the Engineer prior to site construction. Contact Metro Vancouver for location of their utilities and BC One for location of other outside agency utilities. The Contractor will not receive any compensation or allowance for delays if work is halted due to utility and service connections not located prior to commencing construction.

City of Coquitlam does not guarantee water, storm or sanitary services connections are perpendicular to the mains or property lines, the Contractor will not receive any compensation for the time to locate these connections or for exposing hidden services at the property lines.

Payment for this work will be treated as incidental to payment for work described in other Sections.

1.8 Manholes and Valves Add 1.8.1

Access to manholes and valves must be maintained at all times for City utilities crews and external utility companies. In case of an emergency the cost for exposing any buried manhole or valve covers during construction will be paid by the Contractor.

1.9 Verification of Dimensions Add 1.9.1 and Quantities

Before proceeding with work, the Contractor shall visit the site and check and verify dimensions and quantities. Report variations between Contract Drawings and site conditions to the Contract Administrator before proceeding with work. Payment for this work will be treated as incidental to payment for work described in other Sections.

1.10 Precautions Add 1.10.1

Protect areas under construction from damage caused by excessive erosion, flooding, heavy rains, etc. Repair or replace unprotected damaged areas as directed by the Contract Administrator at no cost to the Owner.

1.11 FORTIS BC Emergency Add 1.11.1 Protocol

In an emergency, gas pipeline rupture or leak, Contact Fortis BC 24 Hour Emergency Line (1-800-663-9911) & Fire Department (911) immediately and then City of Coquitlam's Utility Control Centre (604-927-6287)

3.1 Pre-Construction Meeting Add 3.1.1 Requirements

After the Award of the Contract, the Contractor (Project Manager and Superintendent) will be required to attend a Pre-Construction Meeting with the Contract Administrator and provide all necessary information required by the Contract Administrator prior to provision of a Notice to Proceed. Items required to be provided at the meeting include:

- A Detailed Construction Schedule showing the start date, completion date, and durations of major work components showing how all work will be completed within the Contract Duration.
- 2. Proof of Insurance
- 3. Performance Bond and Labour and Materials Payment Bond
- 4. WCB Clearance Letter and Copy of Notice of Project
- 5. City of Coquitlam Business License

These Supplementary Contract Specifications must be read in conjunction with the Specifications contained in the Master Municipal Construction Documents, Volume II, Printed 2009 and the City of Coquitlam Supplementary Specifications and Detailed Drawings

Charges

to be presented at the pre-construction meeting. The schedule must show major components and durations.

All work under this project is to be completed within the designated Contract Duration as contained in the signed Contract Agreement, or as formally amended.

3.3 **Contract Superintendent** and Subcontractors

Add 3.3.1

In compliance with the MMCD General Conditions, Section 4.7, Superintendent, the Contractor shall have a competent senior representative, (the "Superintendent") in FULL TIME attendance at the Place of Work while work is being performed for the duration of the contract.

This FULL-TIME attendance is also required when work is being performed by Subcontractors.

Work done by Subcontractors is to be directed by the Superintendent and monitored on site ensuring conformance to the Contract Documents and other particular direction to the Superintendent by the Contract Administrator.

The Owner and Contract Administrator are not responsible for the direction of Subcontractors.

3.4 **Changes of Contractor** Representatives & **Subcontractors**

Add 3.4.1

The Superintendent and Subcontractors indicated in the Form of Tender shall not be changed unless:

- The Owner requests a replacement.
- The Contractor submits an application for a change, in writing, to the Contract Administrator with the change being approved in writing.

Mobilization and 3.5 Demobilization

Payment for Mobilization and Demobilization shall be incidental. Payment shall be considered full compensation for all activities, resources, and incidental costs associated with mobilizing to, maintaining, and demobilizing from the site. This includes, but is not limited to:

- · Provision of all labour, materials, equipment, and supervision required for mobilization and demobilization, including those of subcontractors.
- Establishment of temporary site facilities, including site offices, storage areas, workshops, and sanitary facilities.
- Provision, maintenance and removal of safe and secure access to and within the site, including haul roads and pedestrian routes.
- · Provision, maintenance, and eventual removal of site security, including lighting, surveillance, and personnel.
- Maintenance and clean-up of laydown area.

SUPPLEMENTARY
CONTRACT
SPECIFICATIONS
PROJECT RECORD DOCUMENTS
SECTION 01 33 01S
SS 6
SPECIFICATIONS
PROJECT RECORD DOCUMENTS
2025

1.0 GENERAL

1.3 Submission Delete 1. and repla

Delete 1.3.2 and replace with the following Submit one copy of accurate project record documents in final form prior to applying for Substantial Performance including material testing reports. Record documents to include changes in the Issued for Construction Drawings, new elevation, location of all walkways, sidewalks, and all utilities affected by the Work.

Substantial Performance and release of Holdbacks will not be issued until record documents have been submitted and accepted by the Contract Administrator and the City.

SUPPLEMENTARY CONTRACT SPECIFICATIONS		PE	SECTION 01 42 00S SS 7 FERENCE SPECIFICATIONS 2025
3F LCII	ICATIONS	· · · · · · · · · · · · · · · · · · ·	TERENCE SPECIFICATIONS 2023
1.0	GENERAL	Add 1.0.6	The Supplementary Specifications contained herein must be read in conjunction with the Master Municipal Specifications contained in the Master Municipal Construction Documents, Volume II (Platinum Edition 2009) as identified in the Instructions to Tender.
		Add 1.0.7	The Supplementary Contract Specifications follow the same format and numbering system as the Master Municipal Specifications, but is differentiated from it by having the letter "S" placed after the section number.
2.0	REFERENCED SPECIFICATIONS		
2.13	всмотт	Add 2.13.5	The Provincial Ministry of Transportation and Infrastructure has produced a 2025 Standard Specifications for Highway Construction (Volume 1 & 2), which applies to heavy civil materials and bridge construction and will be referenced in this document as BC MoTT Standard Specifications Section Number. Description of the supply, shipping, installation and payment of the structural materials are described in this publication. This contract will refer to this provincial document as a reference and will be binding. To view

<u>Standard Specifications for Highway Construction - Province of British Columbia (gov.bc.ca)</u>

or to obtain a digital copy of these specifications go to:

SUPPL CONTF	EMENTARY RACT		SECTION 01 45 00S SS 8
SPECIF	ICATIONS		QUALITY CONTROL 2025
1.0	QUALITY	Add 1.0.1	The Contractor shall provide a final product conforming to the Contract Documents and the intent of the work. The work is to be accurate to the dimensional and tolerance requirements of the contract. Payment will be subject to adjustments based on quality assurance tests performed by the Contract Administrator.
1.1	Quality Control (QC) by Contractor	Add 1.1.1	The MMCD (2009) definition of "Quality Control" is the process by which the <i>Contractor</i> checks specific materials, products, and workmanship to ensure strict conformance with the Contract Documents.
			The Contractor is fully responsible for quality control of the materials, production, and construction processes.
			Quality control tests shall be performed by the Contractor, at their own expense, to ensure that products meet the contract specifications. Failure by the Contractor to conduct adequate quality control testing during production and construction will negate the Contractor's ability to appeal the quality assurance tests used for acceptance/rejection of the work.
			Under no circumstances will QC test results produced after completion of the Quality Assurance (QA) results be considered for appeal purposes.
			Any changes in the Work with respect to the location, grade, or line shall be approved in advance by the Contract Administrator. Failure to notify the Contract Administrator of changes in writing may result in rejection of Work.
1.2	Inspection of Work, Quality Assurance, and Material Testing, by the Owner	Add 1.2.1	The MMCD (2009) definition of "Quality Assurance" means the process by which the <i>Owner</i> evaluates if the work is being constructed in accordance with the Contract Documents. This definition will be used for this contract.
			The Contract Administrator will provide construction review through spot inspections and spot materials testing for Quality Assurance.
			Any materials testing results indicating a non-conformance to the Contract Documents will require construction corrective action by the Contractor.
			All subsequent testing to corrective action to verify conformance to the Contract Documents will be the full responsibility of the Contractor.
			Inspection review by the Owner will not relieve the Contractor from providing a product that meets or exceeds the requirements of the Contract Documents.
1.3	Inspection		Materials testing shall be as described in MMCD General Conditions, Section 4.12 with the following change:
			Delete Section 4.12.2(a) and insert the following:
			Where the MMCD specification clauses for Inspection and Testing indicate the Contract Administrator will arrange for all testing for work described in this section will be amended to read The Contractor will arrange for and pay for all testing for work described in this section. The testing shall take place at the following prescribed rates and as directed by the Contract Administrator. The Contract Administrator has the authority to call for testing, up to the rates and frequencies specified, at the Contractors cost.

All testing covered under this item shall be performed by a CSA certified laboratory and technicians with copies of all test results to be sent directly

SUPPL	EMENTARY RACT		SECTION 01 45 00S SS 9
SPECIF	ICATIONS		QUALITY CONTROL 2025
			to the Contract Administrator. Re-testing resulting from failed first tests shall be at the Contractor's expense.
1.5	Testing	Add 1.5.1	The Contractor shall carry out inspection and testing (QC) to ensure compliance with Contract Documents. The Contractor shall submit test results within one week of testing to the Contract Administrator and prior to the preparation of the payment certificate where required.
1.6	Contractors Responsibilities	Add 1.6.1	 Furnish labour and facilities to: Provide access to work to be inspected Facilitate inspections and tests Make good work disturbed by inspection and tests
1.7	Access to Work	Add 1.7.1	The Contractor shall allow inspection testing agencies access to Work.
1.8	1.8 Tests A		Test rates and frequencies (excluding failed tests), when not defined in the MMCD or Contract Specifications Sections, shall be at the following frequencies:
			 Trench Backfilling and Compaction: Compaction: 1 test / 25 linear m / 300 mm lift Sieve: 1 test / placed material / 50 m³ Granular Base: Compaction: 1 test / 500 m² / 100mm depth of granular base Sieve: 1 test / placed material / 250 tonnes Granular Subbase: Compaction: 1 test/500 m² / 300mm depth of granular subbase Sieve: 1 test / placed material / 250 tonnes Embankment (Subgrade): Compaction: 1 test/50 m² / 300 mm depth of fill Sieve: 1 test / placed material / 100 tonnes Asphalt: Marshall test: Test per 250 tonnes placed, per specified mix, min. 1 / day ASTM D1559, D3203, C117, C136 Superpave: Test per 250 tonnes placed, per mix specified, min. 1 / day CAI-SP2, ASTM D3203, C117, C136 Cores: 1 per 500 m²/lift Continuous asphalt density testing during paving. Subgrade Preparation: Compaction & Moisture: 1 test / 500 m² Concrete Tests: Air, Slump & 1 Set Cylinders: 1 test / truck, min. 1 set / day Cementitious Grout Tests: CSA A23.2-09
1.9	Measurement and Payment	Add 1.9.1	Payment for all work performed under this section will be considered incidental to payment for work described in other Sections.

1.0 GENERAL

Add 1.0.6

The Contractor is responsible for all temporary traffic control on the streets required for completion of the work. The Contractor will be responsible to provide a Traffic Management Plan (TMP) for approval ten (10) working days prior to any lane closures taking place. TMP is to be prepared by a professional certified by the American Traffic Safety Services Association.

The TMP shall outline the approach to traffic management, show recognition and minimization of risks indicates signing locations, identify Traffic Control Persons (TCP) stations, show lane shifting and proposed closures.

The Contractor shall ensure safe passage of vehicles, cyclists and pedestrian through the work zone.

Add 1.0.7

A Road and Sidewalk Closure Permit is required from Coquitlam for all work affecting pedestrian and traffic flow related to construction. A permit is required for each specific construction interference with pedestrian and traffic flow. The road and sidewalk closure permit form can be obtained for use from the City's website at http://www.coquitlam.ca. The Contractor must follow the approved TMP. Any changes to this TMP must be submitted to City's Traffic Operations for approval.

Add 1.0.8

Refer to Appendix A – Traffic Management Detail Specifications

1.4 Traffic Control

Delete 1.4.1 and replace with the following The Contractor shall conduct their operations so as to cause the minimum obstruction and inconvenience to traffic and to places of business and residences adjacent to the Place of Work. No greater quantity of work shall be undertaken at any one time than can be properly conducted with due regard to the rights and interests of the public as may be determined by the Contract Administrator.

The Contractor is to provide at all times safe and convenient means of approach and entrance to adjoining lanes, driveways, buildings and property both for vehicles and pedestrians to the satisfaction of the Contract Administrator. For this purpose, they shall construct and maintain suitable and safe platforms, approaches, structures, bridges, diversions or other works.

Where traffic must cross open trenches, the Contractor shall provide suitable bridges. Where trenches have been backfilled or where road improvements are incomplete the Contractor shall take any steps necessary to prevent potholes or other traffic hazards. Where the Contract Administrator so instructs or where Contract Specifications so require, the Contractor shall provide temporary asphalt patching of such hazards.

Add 1.4.9.3.1

The Contractor, as required by the Contract Administrator and the City, is to supply Construction Zone information signs (stationary), refer to MMCD 01 58 01 for the required identification signage.

The Contractor is responsible for the removal of the signs at the completion of the work.

Delete 1.4.10.1.3 and replace with the following When workmen or equipment are employed over travelled way over brow of hills, around sharp curves or at other locations where oncoming traffic would not otherwise have adequate warning.

SUPPLEMENTARY		SECTION 01 55 00S
CONTRACT		SS 11
SPECIFICATIONS	TRAFFIC CONTROL, VEHICLE ACCESS AND PARKING	2025

1.5 Measurement and Payment

Delete 1.5.1 and replace with the following Payment for all work performed under this section including submission of Traffic Management Plan (TMP), Traffic Control Persons (TCP), and all temporary traffic signs, devices as required for traffic and pedestrian safety; and all other items described in the Traffic Regulation Section, and all labor, material, equipment, and work described under *Appendix A: Traffic Management Detail Specifications* shall be treated as incidental to payment for work described in other Sections unless shown otherwise in the Schedule of Quantities and Prices.

1.0 **GENERAL** 1.2 **Temporary Erosion and** Delete 1.2.1.1 Properly drain all portions of the site. Protect the site and the **Sediment Controls** and replace watercourses to which it drains, directly or indirectly, against erosion and with the siltation in accordance with the City of Coquitlam Stream and Drainage following System Protection Bylaw No. 4403, 2013 during construction and until the Place of Work has been restored to the satisfaction of the Contract Administrator. Ensure no silt, gravel, debris or other deleterious substance resulting from construction activity discharges into existing drainage systems or watercourses or onto highways or adjacent property. The Contractor is responsible for all damage that may be caused by water backing up or flowing over, through, from or along any part of the work or otherwise resulting from his operations. Keep existing culverts, drains, ditches and watercourses affected by the work clear of excavated material at all times. When it is necessary to remove or alter any existing drainage structure, provide suitable alternative measures for handling the drainage. Adequately support culverts and drainpipes across trenches to prevent displacement and interference with the proper flow of water due to trench settlement. Sweep streets, and clean catch basins, manhole sumps, detention tanks, and maintain siltation controls as often as the Contract Administrator and the City deems necessary. Delete 1.2.2.2 Do not operate construction equipment in watercourses. and replace with the following Add 1.2.2.9 All work must be carried out during favourable and low water conditions. Add 1.2.2.10 Any fill used on this project shall be certified inert and from a source which is confirmed to be free of contaminants. Add 1.2.2.11 All work within a watercourse must be undertaken and completed in isolation of all flowing water to maintain downstream water quality and unrestricted flows. Add 1.2.6 Complete construction in a manner that will prevent the release of sediment or sediment laden waters to the watercourses, ditches, and swales draining to fish habitat. 1.4 **Environmental Protection** Add 1.4.3.5 Immediately contain and clean up any leaks and spills of prohibited materials at the Place of Work. Add 1.4.3.6 Ensure that a well-stocked spill kit is on-site at all times and that the Contractor's employees are familiar with appropriate spill response techniques. Any spill of reportable quantities must be immediately reported to the Provincial Emergency Program's 24-hour phone line at 1-800-663-3456. Add 1.4.3.7 Immediately notify the Contract Administrator and the City of any leaks or spills of prohibited materials that occur at the Place of Work. Add 1.4.3.8 Ensure that any fuel stored on-site is located at least 15 metres from the nearest stream, and is placed within a bermed off and lined area, in order to prevent leaks or spills into the environment.

All equipment and machinery must be in good working condition (power washed), free of leaks or excess oil and grease. No equipment refuelling

Add 1.4.3.9

JI LCII I	CATIONS	LIV	ROMMENTAL PROTECTION 2025
			or servicing shall be undertaken within a minimum of 15 metres of any water course or surface water drainage.
		Add 1.4.3.10	During all phases of the operation, take precautions to abate nuisance caused by mud or dust by clean up, sweeping, sprinkling with water or dust control, or other means as necessary to accomplish results satisfactory to the Contract Administrator.
1.6	Measurement and Payment	Delete 1.6.1 and replace with the	Payment for all work, unless included in the Schedule of Quantities and Prices, performed under this section will be incidental to payment for work described in other Sections.
		following	All works for Erosion and Sediment Control (ESC) shall include silt fencing, interceptor channel/swale/ditch construction, interceptor drainpipe, check dams, catch basin, socks, and all materials to complete the work as shown on the Contract Drawings or as directed by the Contract Administrator
		Add 1.6.2	Payment for this item as directed by the Contractor Administrator includes supply, placement, maintenance, materials, removal and incidentals required for environmental protection.
		Add 1.6.3	Payment for the poly cover or temporary tarps over stockpile materials or exposed road subgrades shall be treated as incidental work.
1.9	Archaeological / Historical Resources	Add 1.9	Immediately cease work and inform the Contract Administrator and the City, if any archaeological or historical resources are encountered during construction. Leave these resources in place and do not disturb them in any way.
			The Contractor must allow the Archaeological and Historical Resources group to perform duties around the site during construction. The Contract Administrator shall coordinate all other work being performed at the site with the Contractor
1.10	Contractor's Hydrocarbon Wastes and Fuel Spill Mitigation Measures	Add 1.10	The Contractor will prepare a Spill Response Plan prior to Construction. Costs of the preparation of the spill response plan are incidental to the Contract.
			The Contractor will develop and identify waste receptacles for the safe disposal of hydrocarbons and lubricant fouled waste material, and use those receptacles.
			There will be no machine refuelling within 30 m of a watercourse

There will be no machine refuelling within 30 m of a watercourse.

The Contractor must keep emergency spill kit at each bridge repair site. The Environmental Monitor will inspect and confirm that a spill kit is on site prior to commencement of bridge repair work. Each spill kit will at a minimum have the following:

- 2 5 m long absorbent spill booms
- 50 16" x 20" Sorbent Pads (Oil, Gas & Diesel)
- 6 48" x 3" Sorbent Socks (Oil, Gas & Diesel)
- 4 -120" x 3" Sorbent Socks (Oil, Gas & Diesel)
- 4 8" x 18"Sorbent Pillows (Oil, Gas & Diesel)
- Nitrile Gloves
- Hand Wipes
- 2 Disposable Respirators N958 HD
- Hazmat Disposal Bags

Spills of any substance toxic to aquatic life of reportable quantities will be immediately reported to the Provincial Emergency Program 24-hour phone line at 1-800-663-3456.

Contractor shall immediately notify the Contract Administrator of any leaks or spills of prohibited materials that occur on the job site.

The Contractor is wholly responsible for costs associated with clean-up of spills originating from their equipment or work practices.

1.11 Non-Hazardous Waste Handling Requirements

Add 1.11

There will be no disposal of solid wastes into sumps, ditches, streams, culverts, road edges or private property.

The Contractor's will supply trash cans for the disposal of crew generated wastes.

Littering is prohibited and monitoring for this activity will be ongoing throughout the project.

1.12 Control of Cement and Cement Grouts

Add 1.12

The Contractor shall undertake all concrete/grouting work with caution and comply with, at a minimum, the following procedures:

- The Work shall be isolated from watercourses through the use of berms, pits or tarpaulins.
- There shall be no direct contact between work activity and any watercourse through spillage, hosing off surfaces, rain or cleaning of tools.
- Complete isolation of all grouting from any watercourse for a minimum of 72 hours.
- 4. Exposed concrete will be covered if there are forecast rains.
- 5. No wash water shall be allowed to discharge to any watercourse.
- The Contractor must follow BC Environmental Management Act –
 Spill reporting regulation procedures relating to emergency
 mitigation and clean up measures for managing the cleanup and
 recovery of concrete materials.
- All wash water from concrete works shall be contained and removed from site.
- 8. If required, concrete wash water may be disposed in a temporary disposal location that has been reviewed and accepted by the Owner. This location may be a rock pit or grassy area, provided the wash water will be contained in an upland location at least 30m away from the high-water mark, and at least 30m away from the top of bank of watercourses and there is landowner approval.
- All accepted temporary disposal area locations must be cleaned up and re-seeded prior to demobilization.
- 10. Concrete dust from saw cutting and drilling shall be prevented from entering any watercourse.

SUPPLEMENTARY		SECTION 01 58 01S
CONTRACT		SS 15
SPECIFICATIONS	PROJECT IDENTIFICATION	2025

1.3 Measurement and Delete 1 Payment and repl

Delete 1.3.1 and replace with the following Payment for the installation of 1.2m x 1.2m static construction Information signs as shown in Appendix A – Traffic Management Detail Specifications includes supply, placement and removal, and will be incidental to payment for work described in other Sections, unless shown otherwise in the Schedule of Quantities and Prices.

Add 1.3.2

Payment for changeable message signs (CMS) including supply, placement, communication management & removal as required for traffic & pedestrian safety and as shown in in Appendix A – Traffic Management Detail Specifications will be incidental to payment for work described in other Sections, unless shown otherwise in the Schedule of Quantities and Prices.

When shown in the Schedule of Quantities and Prices, payment for CMS used for only a fraction of a month will be paid prorated.

1.0 GENERAL

1.1	References	Add 1.1.1	Canadian Standards Associated (CSA)
			 CSA-A23.1/A23.2, Concrete Materials and Methods of Concrete Construction/Methods of Test and Standard Practices for Concrete, 2019 Edition.
			 CSA O86S1, Supplement No. 1 to CAN/CSA-O86-01, Engineering Design in Wood.
			3. CSA O121, Douglas Fir Plywood.
			4. CSA O151, Canadian Softwood Plywood.
			5. CSA O153, Poplar Plywood.
			 CAN/CSA-O325.0, Construction Sheathing. CSA O437 Series, Standards for OSB and Waferboard, CSA S269.1,
			Falsework for Construction Purposes.
			8. CSA S269.1, Falsework and Formwork.
			9. CAN/CSA S269.3, Concrete Formwork, National Standard of Canada.
		Add 1.1.2	Underwriters' Laboratories of Canada (ULC):
			 CAN/ULC-S701, Standard for Thermal Insulation, Polystyrene, Boards and Pipe Covering.
1.2	Delivery, Storage, and Handling	Add 1.2.1	Store and manage hazardous materials in accordance with manufacturer's written instructions and applicable federal and provincial laws, regulations, codes, and guidelines.
			-0 , ,
		Add 1.2.2	Storage and Handling Requirements:
			1. Store materials in accordance with manufacturer's recommendations in clean, dry, well-ventilated area.
			2. Store and protect formwork from damage.
			3. Replace defective or damaged materials with new.
		Add 1.2.3	Waste Management and Disposal:
			1. Separate waste materials for reuse and recycling.
1.3	Measurement and	Add 1.3.1	Payment for all work performed under this Section will be incidental to
	Payment		payment for work described in other Sections unless shown otherwise in
			the Schedule of Quantities and Prices. No separate payment will be made
			for the supply, transport and installation of the formwork required as part of another Item.
			of another item.
2.0	PRODUCTS		
2.1	Materials	Add 2.1.1	Formwork Materials:
			1. For concrete without special architectural features, use wood and
			wood product formwork materials to CAN/CSA O86. 2. For concrete with special architectural features, use formwork
			materials to CSA A23.1/A23.2.
		Add 2.1.2	Form Ties: Removable or snap-off metal ties, fixed or adjustable length,
			free of devices leaving holes minimum 25 mm diameter in concrete surface.
		Add 2.1.3	Form Release Agent: Proprietary, non-volatile material not to stain
		-	concrete or impair subsequent application of finishes or coatings to

formwork may be required or where members may be subjected to additional loads during construction as required. Add 3.2.2 Re use formwork and falsework subject to requirements of CSA

A23.1/A23.2.

Build in anchors, sleeves, and other inserts required to accommodate

Ensure that anchors and inserts will not protrude beyond surfaces designated to receive applied finishes, including painting.

Clean formwork in accordance with CSA A23.1/A23.2, before placing

Provide necessary re-shoring of members where early removal of

concrete.

Work specified in other sections.

Add 3.1.10

Add 3.1.11

Add 3.1.12

Add 3.2.1

END OF SECTION

Removal and Reshoring

3.2

1.0 **GENERAL** 1.1 References Add 1.1.1 American Concrete Institute (ACI): ACI 315R, Manual of Engineering and Placing Drawings for Reinforced Concrete Structure. SP-66, ACI Detailing Manual 2004. Add 1.1.2 American National Standards Institute/American Concrete Institute (ANSI/ACI): 1. ANSI/ACI 315, Details and Detailing of Concrete Reinforcement. Add 1.1.3 American Society for Testing and Materials (ASTM) 1. ASTM A123, Standard Specification for Zinc (Hot-Dip Galvanized) Coatings on Iron and Steel Products 2. ASTM A143/A143M, Standard Practice for Safeguarding Against Embrittlement of Hot-Dip Galvanized Structural Steel Products and Procedure for Detecting Embrittlement. 3. ASTM A276, Standard Specification for Stainless Steel Bars and 4. ASTM A995M, Standard Specification for Castings, Austenitic-Ferritic (Duplex) Stainless Steel, for Pressure-Containing Parts. Add 1.1.4 Canadian Standards Associated (CSA) 1. CAN/CSA A23.1, Concrete Materials and Methods of Concrete Construction, 2019 Edition. 2. CAN3 A23.3, Design of Concrete Structures for Buildings. 3. CSA G30.3, Cold Drawn Steel Wire for Concrete Reinforcement. 4. CAN/CSA G30.18, Billet Steel Bars for Concrete Reinforcement. 5. CAN/CSA G40.21, Structural Quality Steels. Add 1.1.5 Reinforcing Steel Institute of Canada (RSIC): 1. RSIC, Reinforcing Steel Manual of Standard Practice. Add 1.1.6 Where there are differences between the Specifications and Drawings and the codes, standards, or acts, the most stringent shall govern. Delivery and Acceptance Requirements: Deliver materials to site in 1.2 Delivery, Storage, and Add 1.2.1 original factory packaging, labelled with manufacturer's name and Handling address. Add 1.2.2 Storage and Handling Requirements: 1. Store materials in accordance with manufacturer's recommendations in clean, dry, well-ventilated areas. 2. Store reinforcing bars clear of the ground on timber or other suitable protective cribbing spaced to prevent sags in bundles. Stacks of bundles of straight bars shall have adequate blocking to prevent contact between the layers of bundles. 3. Store and handle stainless steel reinforcing bars with non-corrosive materials and keep contaminate free.

Store stainless steel reinforcing bars separate from uncoated bars.

Replace defective or damaged materials with new.

surfaces are not damaged due to straightening from coil.

CONTRACT			SECTION 03 20 01S SS 20	
	ICATIONS	CONCRETE REINFORCEMENT 2025		
		Add 3.1.3	Cold bend reinforcing bars. Do not straighten or re-bend bars.	
3.2	Construction	Add 3.2.1	Welding of reinforcing bars and welded splices is not permitted.	
		Add 3.2.2	Mechanical Coupler Splices:	
			 Mechanical couplers shall be approved by the Contract Administrator. Such couplers shall develop tension or compression, as required, at least 120% of the specific yield strength of the bars, but not less than 110% of the mean yield strength, representative of the bars to be used, in the test of the mechanical connection. Wedge couplers shall not be used in bars greater than 15 mm diameter. When Mechanical couplers are used the Contractor shall ensure that the minimum concrete cover as specified is maintained. 	
		Add 3.2.3	Obtain Contract Administrator's approval for locations of reinforcement splices other than those shown on placing drawings.	
		Add 3.2.4	Ship bundles of bar reinforcement, clearly identified in accordance with bar bending details and lists.	
		Add 3.2.5	Detail reinforcement in accordance with Contract Documents, CSA A23.1, and detailing standards in RSIC Manual of Standard Practice.	
3.3	Field Bending	Add 3.3.1	Do not field bend or field weld reinforcement except when indicated or authorized by Contract Administrator.	
		Add 3.3.2	Only bend stainless steel reinforcement using equipment specifically designed for that purpose.	
		Add 3.3.3	When field bending is authorized, bend without heat, applying a slow and steady pressure.	
		Add 3.3.4	Do not field bend bars partially embedded in concrete except as shown on the Drawings or where authorized by the Contract Administrator.	
		Add 3.3.5	Replace bars which develop cracks or splits.	
3.4	Placing Reinforcement	Add 3.4.1	Place reinforcing steel as indicated on accepted placing drawings and in accordance with CAN/CSA A23.1.	
		Add 3.4.2	Perform fabrication and setting so completed work will be within tolerances set out in CSA A23.1 unless otherwise shown on the Drawings or determined by the Contract Administrator. These tolerances are acceptable with regard to structural requirements. Interfacing tolerances may not be compatible with the above. Review and coordinate interfacing tolerances so various elements come together properly.	
		Add 3.4.3	Do not place concrete prior to having obtained Contract Administrator's review of reinforcing material and placement and having completed any required changes or adjustments.	
		Add 3.4.4	Ensure cover to reinforcement is maintained during concrete pour.	
		Add 3.4.5	Protect stainless bars with covering during transportation and handling.	
		Add 3.4.6	For dowel installation, see requirements in BC MoTT Standard Specification Section 03 30 00 – Structural Cast-in-Place Concrete.	

SECTION 03 20 01S

END OF SECTION

SUPPLEMENTARY

SUPPLEMENTARY CONTRACT SPECIFICATIONS		CAST-IN-P	LACE CONCRETE	SECTION 03 30 53S SS 21 2025
1.0	GENERAL	Add 1.0.4	This section describes requirements for mand placing of cast-in-place concrete.	naterials, proportioning,
1.1	Related Work	Add 1.1.10	Concrete Forming and Accessories	Section 03 10 00S
		Add 1.1.11	Concrete Reinforcement	Section 03 20 01S
1.2	References	Add 1.2.1	Canadian Standards Associated (CSA)	
			 CSA A23.1/CSA A23.2, Concrete Mat Concrete Construction / Test Methor Practices for Concrete, 2019 Edition. CSA S6, Canadian Highway Bridge De CSA A283, Qualification Code for Con Laboratories. CAN/CSA A3000, Cementitious Mate 	ds and Standard esign Code ncrete Testing
		Add 1.2.2	American Society for Testing and Materia	ils (ASTM)
			 ASTM C1017/C1017M, Standard Spe Admixtures for Use in Producing Flow ASTM C C1059/C1059M, Standard Spe Agents for Bonding Fresh To Harden ASTM C260, Standard Specification of Admixtures for Concrete ASTM C309, Specification for Liquid of Compounds for Curing Concrete. ASTM C494, Standard Specification of Admixtures for Concrete. 	wing Concrete. pecification for Latex ed Concrete. for Air-Entraining Membrane Forming
		Add 1.2.3	Where there are differences between the Drawings and the codes, standards, or act shall govern.	
		Add 1.2.4	The 2019 Edition of CSA A23.1/A23.2 shall exceptions will be made.	ll be used. No
1.4.1	Submittals	Add 1.4.1.1	Submit a concrete mix design and mix design and the project acceptance by the Contract Administrator weeks prior to commencement of placing to the materials, admixtures, additives, or components of a mix design constitutes a and requires a separate mix design submit	t for review and r a minimum of two (2) g concrete. Any change r proportions of new type of concrete
		Add 1.4.1.2	Concrete mix design review letters shall divide with all specification requirements for the concrete including an evaluation and sum constituents, material test reports, mix proposed and if applicable, trial batch test results, reconsiderations, and portable batch plant aggregate source, producers' names, grading gravities, compliance with CSA A23.

	CAST-IN-PI	LACE CONCRETE	2025
		Engineer registered with Engineers and Geoscientists of Britis Columbia who has a minimum 5 years' experience in concrete mix design reviews.	
	Add 1.4.1.3	Submit results of testing completed by an independent test agency showing compliance with the concrete mix design requirements specified in Clause 1.3.2.	
	Add 1.4.1.4	When concrete suppliers request confidentiality of mix proportion quantities, the Professional Engineer providing the concrete mix design review letter, subject to a mutually agreeable confidentiality agreement with the concrete supplishall be granted full disclosure of mix proportion quantities are used materials such that a general mix proportioning discussion can be provided in the mix design review letter.	er, nd
	Add 1.4.1.5	An interruption in production of a particular type of concrete shall not constitute the need for additional testing when the Contractor provides aggregate sieve analysis, organic impuriti in sands for concrete, petrographic examination of aggregate and letter of evaluation from the mix design review letter professional indicating that the material initially tested is still representative. Provide additional analyses when requested the Contract Administrator to confirm that the mix constituer continue to meet specification requirements and provide sign off by the Professional Engineer providing the concrete mix design review letter.	ies s, by nts
	Add 1.4.1.6	Where available, submit material safety data sheets (MSDS) for all constituent materials.	or
	Add 1.4.1.7	If the fine aggregate consists of a blend from more than one source, the fine aggregate sieve analysis shall show the gradation of the blended fine aggregates. Similarly in the case blended coarse aggregates, the coarse aggregate sieve analys shall indicate the gradation of the blended coarse aggregates.	sis
	Add 1.4.1.8	Provide other information in accordance with CSA A23.1 if requested by the Contract Administrator.	
	Add 1.4.1.9	Submit temporary works drawings and procedures required to facilitate the concrete works. Temporary works drawings shal prepared and sealed by a Professional Engineer registered wit Engineers and Geoscientists of British Columbia, experienced the design of temporary works of the type required for this project at least two (2) weeks prior to starting construction of the temporary works. Temporary works or structures cannot impact height of travel lanes beneath the overpass.	ll be th in f
Delivery, Storage, and Handling	Add 1.4.2.1	Concrete hauling time: Deliver to site of Work and discharged within ninety (90) minutes maximum after batching.	ł
	Add 1.4.2.2	Modifying maximum time limit without receipt of prior writte agreement from the Contract Administrator and concrete producer as described in CSA A23.1/A23.2. is prohibited.	•n
	Add 1.4.2.3	Submit deviations for review by Contract Administrator.	

Placing concrete during rain or weather events that could

damage concrete is prohibited.

Add 1.4.3.1

Site Conditions

1.4.2

1.4.3

Add 1.4.3.2 Protect newly placed concrete from rain, wind, or weather events in accordance with CSA A23.1/A23.2.

Add 1.4.3.3 Cold weather protection:

- Maintain protection equipment, in readiness, on Site.
- Use such equipment when ambient temperature below +5°C, or when temperature may fall below +5°C before the concrete has finished the curing period in accordance with Clause 3.8.
- Placing concrete upon or against surface at temperature below +5°C is prohibited.
- If the project schedule requires concrete to be placed when the ambient temperature is less than +5°C, submit a written plan detailing protective measures that will be undertaken to protect freshly placed concrete from extreme temperatures. Concrete shall not be placed until the Contract Administrator has reviewed the Contractor's submittal and all of the Contract Administrator's comments have been addressed.

Add 1.4.3.4 Hot weather protection:

- Protect concrete from direct sunlight when ambient temperature above +27°C.
- Prevent formwork from getting too hot before concrete placed. Apply accepted methods of cooling not to Adversely affect concrete.
- If the project schedule requires concrete to be placed when the ambient temperature exceeds +30°C or is expected to exceed +30°C prior to the commencement of curing, submit a written plan detailing protective measures that will be undertaken to protect freshly placed concrete from extreme temperatures. Concrete shall not be placed until the Contract Administrator has reviewed the Contractor's submittal and all of the Contract Administrator's comments have been addressed.
- Add 1.4.3.5 Make note of special curing and protection requirements for concrete placed during periods of extreme temperatures.
- Add 1.4.3.6 Protect from drying during the minimum curing period specified in Clause 3.8.
- **Waste Management and** Add 1.4.4.1 Separate waste materials for reuse and recycling.
 - Add 1. 4.4.2 Use trigger operated spray nozzles for water hoses.
 - Add 1. 4.4.3 Designate a cleaning area for tools to limit water use and run-
 - Ensure emptied containers are sealed and stored safely for Add 1. 4.4.4 disposal away from the public.
 - Add 1. 4.4.5 Prevent plasticizers, water reducing agents, air entraining agents, and any fresh concrete or fresh concrete constituents from entering drinking water supplies or streams. Using appropriate safety precautions, collect liquid or solidify liquid with an inert, non-combustible material and remove for

These Supplementary Contract Specifications must be read in conjunction with the Specifications contained in the Master Municipal Construction Documents, Volume II, Printed 2009 and the City of Coquitlam Supplementary Specifications and Detailed Drawings

Disposal

1.4.4

disposal. Dispose of all waste in accordance with applicable local, provincial, and national regulations

Add 1. 4.4.6

Choose least harmful, appropriate cleaning method which will perform adequately.

1.5 Measurement and Payment

Add 1.5.6

Quantities indicated in the Schedule of Quantities and Prices in square meters shall be rounded to the nearest 0.1 m², and calculated as the product of the lineal length and width of the repair areas. No variations to the unit price per square metre will be authorized regardless of the depth of the work. Payment includes all applicable work described in 1.5.9.

Add 1.5.7

Payment for Barrier Demolition and Reinstatement will be made at the unit price bid as indicated in the Schedule of Quantities and Prices. Payment will include all labour, materials, and equipment required to remove and dispose existing barriers, any required temporary barriers, construct new barriers, reinforcing steel, formwork, surface preparation, concrete, finishing, and curing. Payment includes all applicable work described in 1.5.9.

Add 1.5.8

Payment for Repair of Concrete Deck Along Longitudinal Hinge (Pier Y) will be made at the unit price bid as indicated in the Schedule and Quantities and Prices. Payment will include saw cutting of repair boundaries, removal of unsound concrete within the repair area, surface preparation, supply of sealant, placement, finishing, and curing. Payment will include all equipment, labour, materials, offsite waste disposal, and all tasks to facilitate repairs and access to the locations required to complete the work as shown in the Contract Drawings. Payment includes all applicable work described in 1.5.9.

Add 1.5.9

Payment for concrete will be made in accordance with BC MoTT Standard Specifications Section 211.21.02 at the applicable Unit Price of per cubic metre as listed in the Schedule of Quantities and Prices. No payment will be made under this item for concrete supplied as part of another Item.

All concrete work shall be in accordance with BC MoTT Standard Specifications Sections 211 and 933, unless otherwise specified in these Special Provisions. Payment shall also include quality control, submissions, clearning and grubbing, protection of existing structures that are to remain, protection of roadway underneath, concrete reinforcement, concrete forming and accessories, any falsework and brace for the formwork, rebar, dowels, epoxy, removal of existing concrete median (cut flush with existing deck and sealed with Sikaflex or other Approved Equivalent), all equipment or temporary structures for accessing the side of the overpass, joint preparation, finishes, and all appurtenances as required to complete the work as shown in the Contract Drawings by R.F. Binnie and Entuitive.

2.0 PRODUCTS

2.1 Materials

Delete 2.1 and replace with the following:

Add 2.1.1

Portland cement: To CAN/CSA A3000 and CSA A23.1

Add 2.1.3 Aggregates:

- To CAN/CSA A23.1/2.
- Coarse aggregates to be normal density.
- Add 2.1.4 Air entraining admixture: To ASTM C260.
- Add 2.1.5 Chemical admixtures:
 - 1. To ASTM C494.
 - Accelerating or set retarding admixtures during cold and hot weather placing require acceptance by the Contract Administrator prior to use.

SS 25

2025

- Do not use admixtures containing calcium chloride.
- Add 2.1.6 Supplementary cementing materials: To CAN/CSA A3000.
- Add 2.1.7 Mixing water shall be potable. If non-potable water is to be used for batching, water shall comply with the requirements of ASTM C1602/C1602M. Do not use wash water in concrete.
- Add 2.1.8 Super-plasticizing admixtures: To ASTM C494.
- Add 2.1.9 Concrete retarders:
 - 1. To ASTM C494.
 - Do not allow moisture of any kind to come in contact with the retarder film.

Add 2.1.10 Grouts:

- Epoxy grout shall be Sikadur 31 Hi Mod, unless bedding thickness exceeds 35 mm where Sikadur 42 shall be used with minimum strength of 35 MPa at 28 days.
- Cementitious grout shall be pre-bagged, non-shrink grout with minimum compressive strength of 45 MPa at 28 days.
- Alternative products shall be equivalent and require acceptance by the Contract Administrator
- Add 2.1.11 Test materials originating from outside Canada or the United States of America intended for use in the production of concrete to the required standard by a laboratory in Canada certified to CSA A283. Provide a verification letter by the certified laboratory and shall include references to the appropriate mill test report(s), material specification number(s), testing date(s), and statements indicating compliance of the material to the requirements of the Contract documents. Verification letters shall be signed and sealed by a Professional Engineer registered with the Engineers and Geoscientists of British Columbia, experienced with materials engineering.
- Add 2.1.12 Any cement types, water, aggregates, admixtures, supplementary cementing materials, superplasticizers, additives, and other concrete constituents not explicitly mentioned in this section shall not be used without acceptance by the Contract Administrator and the City Engineer. If the Contractor proposes to use other materials/concrete constituents, it is the onus of the Contractor to demonstrate equivalent or better performance of the material component and the concrete mix proposed. This

may include material documentations, including but not limited to material properties/test results, material data sheets, signed and sealed mix design reviews deemed necessary by the Contract Administrator to carry out the review. No additional payment or delay claim will be entertained for changes to material /concrete constituents.

2.2 Concrete Mixes

Delete 2.2.1 and replace with the following:

Proportion normal density concrete in accordance with CAN/CSA-A23.1, Alternative 1 to give following properties for all concrete:

- 1. Cement Types, except where noted on the drawings:
 - a. Type GU or GUL Portland cement.
 - b. Minimum compressive strength at 28 days: 45 MPa,
 - c. Exposure class C1, except as noted.
 - d. Maximum water cement ratio: 0.38.
- Cement aggregate ratio to be kept as low as possible while remaining consistent with strength and durability requirements.
- Nominal maximum size of coarse aggregate: 14 mm or 20 mm, dependent on depth of component.
- 4. Supplementary cementitious materials:
 - To CSA A3000 for fly ash, slag cement, and silica fume.
 - b. Fly ash: Type F.
 - c. Silica fume: Type SF.
- 5. Limitations on supplementary cementitious materials:
 - a. Fly ash content shall not exceed 15% by mass of total cementing materials content unless accepted by the Contract Administrator. Concretes using Type GUL cement and with a moderate to severe degree of sulphate exposure may require a higher percentage of fly ash, which requires acceptance by the Contract Administrator
 - Slag content shall not exceed 30% by mass of total cementing materials content unless accepted by the Contract Administrator.
 - Silica fume content shall not exceed 11% by mass of total cementing materials content unless accepted by the Contract Administrator.
 - Use of other supplementary cementing materials are subject to acceptance by the Contract Administrator.
- Slump at time and point of discharge (prior to addition of superplasticizer):
 - a. 75 mm ±20 mm.
- 7. Air Content: 5 to 8%.
- 8. Maximum shrinkage at 35 days: 0.07% (700 microstrain)
- Chemical Admixtures: In accordance with ASTM C260 and ASTM C494.
- 10. Do not add calcium chloride or admixtures containing calcium chloride to concrete.
- Do not use accelerating admixtures unless accepted by the Contract Administrator.
- 12. When Type GUL cement is used, the following conditions shall apply:
 - Incorporate appropriate supplementary cementitious materials into mix design to obtain desired performance for specified exposure class.
 - b. Assume low sulphate exposure for site.

- c. Provide sulphate exposure as defined by CSA A23.1 for aggregates, new materials placed, mixing water and any other components that may impact the sulphate exposure where concrete is placed. Propose sulphate exposure class for acceptance by Contract Administrator prior to submitting mix designs.
- d. Include a minimum of 15% Type F fly ash by mass of cementing materials where late exposure (more than 35 days after placement of concrete) of the concrete to chlorides is expected.
- e. Include a minimum of 8% of silica fume and 12%

 Type F fly ash by mass of cementing materials where early exposure (between 14 and 28 days after casting concrete) of the concrete to chlorides is expected.
- 13. Super-plasticizer: may only be added on site.
- 14. Do not change concrete mix designs or mix design requirements beyond CSA A23.1 tolerances without prior acceptance by the Contract Administrator. If an alternate mix design is considered, a new mix design submission in accordance with Clause 1.3 is required. No additional payment or delay claim will be entertained for changes to mix designs and required additional mix design submissions and review process.

2.4 Cast-In-Place Concrete Add 2.4.1 Patch Repairs

Use a proprietary pre-bagged concrete or a concrete supplied by a ready-mix plant, minimum strength 35MPa at 28 days. Regardless of proprietary pre-bagged concrete or supplied ready-mix, concrete shall be in accordance with Clause 2.2, except that the requirements for proprietary pre-bagged concrete shall be modified as noted in this clause.

- Proprietary pre-bagged concrete shall be flowable, shrinkage-compensated, and high-quality concrete with maximum aggregate size of 10 mm applied by pumping or pouring in repair areas provided with formwork with letter box / bird-mouth arrangement or confined formwork for patch repairs to girder side faces and girder soffits.
- Proprietary pre-bagged concrete shall be designed for low early age heat release.
- Mix and place proprietary pre-bagged concrete in accordance with the manufacturer's recommendations and in accordance with these specifications.

2.5 **Concrete Trowel Patch** Add 2.5.1 Use a proprietary cementitious pre-bagged mortar mix, one-Repairs component, shrinkage-compensated mortar applied by trowel for patch repairs. Add 2.5.2 Use SikaTop 123 Plus or Target SC100W, or other equivalent product accepted by the Contract Administrator. Add 2.5.3 Use product in accordance with the manufacturer's recommendations. 3.0 **EXECUTION** 3.1 General Add 3.1.1 Do cast-in-place concrete work in accordance with CSA A23.1.

3.3	Workmanship	Delete 3.3 and replace with the following:	
		Add 3.2.1	Do not place concrete prior to the Contract Administrator's review and prior to having resolved any comments made by the Contract Administrator and having completed required adjustments. Provide a minimum 48 hours notice prior to placing of concrete to allow for inspection of reinforcement and formwork.
		Add 3.2.2	Prior to concrete placement, remove all sawdust chips and other construction debris from the interior of the formwork.
		Add 3.2.3	Clean reinforcement of debris and other deleterious materials by means acceptable to the Contract Administrator prior to placement. Refer to Section 03 20 01S - Concrete Reinforcement.
		Add 3.2.4	Pumping of concrete is permitted only after acceptance of equipment and mix.
		Add 3.2.5	Ensure reinforcement and inserts are not disturbed during concrete placement.
		Add 3.2.6	Prior to placing of concrete, obtain Contract Administrator's acceptance of proposed method for protection of concrete during placing and curing in adverse weather.
		Add 3.2.7	Maintain accurate records of poured concrete items to indicate date, location of pour, quality, air temperature and test samples taken.
		Add 3.2.8	Concrete tolerance shall be in accordance with CSA A23.1 straight edge method.
		Add 3.2.9	Proprietary products shall be Installed in accordance with manufacturer's instructions. Grouts shall not be disturbed until a minimum compressive strength of 25 MPa is reached.
3.5	Installing Dowels	Add 3.5.1	Meet the following requirements for dowel installation personnel:
			1. All personnel installing dowels into existing concrete shall

- All personnel installing dowels into existing concrete shall be trained by the dowel adhesive manufacturer for the installation of dowels in the orientations shown on the Drawings within the past twelve (12) months or be an ACI certified adhesive anchor installer with a valid certificate.
- The installers of dowels in horizontal, upwardly inclined, or overhead orientations shall have been trained specifically to install dowels in these orientations and for use of the required installation accessories by the manufacturer within the past twelve (12) months.
- 3. Provide proof of training of all dowel installers to the Contract Administrator at least seven (7) days prior to starting the installation of dowels. Alternatively, the dowel adhesive manufacturer shall provide training and certify all dowel installers on site at the beginning of the dowel installation for each type of dowel.

CONTRACT		CACTIBLE	SECTION 03 30 535 SS 29
SPECIFICATIONS		CAST-IN-F	PLACE CONCRETE 2025
		Add 3.5.2	Fill all dowelled and abandoned holes with Hilti Hit HY-200 or an equivalent product as accepted by the Contract Administrator.
		Add 3.5.3	Temporarily support overhead or upwardly inclined dowels after bonding, as necessary, to prevent their movement during curing period. The dowels shall remain undisturbed, and no load shall be placed on the dowels until curing is achieved.
3.6	Placing Concrete	Add 3.6.1	Handle and place concrete so as to avoid segregation of materials and the displacement of reinforcement. Deposit concrete as closely as practical to its final position.
		Add 3.6.2	When placing involves dropping concrete more than 1.5 m, deposit concrete through an elephant trunk. Alternate methods require demonstration by the Contractor of equivalent or better performance and require acceptance by the Contract Administrator.
		Add 3.6.3	Consolidate concrete thoroughly and uniformly. Perform the consolidation by mechanical vibration. Vibrators shall be equipped with non-metallic or rubber heads.
		Add 3.6.4	Supply a sufficient number of vibrators to properly consolidate concrete at the rate it is being placed. Have standby vibrators and AC generator available at all times.
		Add 3.6.5	Manipulate vibrators so as to thoroughly work the concrete around the reinforcement and embedded fixtures and into corners and angles of formwork.
		Add 3.6.6	Apply vibration at the point of deposit and in areas of freshly deposited concrete.
		Add 3.6.7	Insert vibrators vertically and withdraw slowly from the concrete. The vibration shall be of a sufficient duration and intensity to thoroughly impact the concrete but shall not be continued as to cause segregation.
		Add 3.6.8	Place concrete in horizontal layers not exceeding 300 mm thickness. Consolidate each layer so as to avoid a construction joint with the layer below.
		Add 3.6.9	Do not use concrete which does not reach its final position within 90 minutes after batching.
3.7	Finishing	Add 3.7.1	Patch and finish formed surfaces to CAN/CSA A23.1 except as noted.
		Add 3.7.2	Finish:
			 Class 2 – Common Finish. Finish all formed concrete exposed to view. Common finish to consist of smooth form finish to CAN/CSA A23.1
		Add 3.7.3	Repair honeycombed and defective concrete with method accepted by Contract Administrator. This may include removal and recasting, if required.
		Add 3.7.4	Rub exposed sharp edges of concrete with carborundum to produce 3 mm radius edges unless otherwise indicated.

SECTION 03 30 53S

SUPPLEMENTARY

SPECIFICATIONS	SS 30 CAST-IN-PLACE CONCRETE 2029				
3.8	Construction Joints and Casting to Existing Concrete	Add 3.8.1	Prepare construction joints and surfaces to existing concrete to CAN/CSA A23.1 and roughen existing surface to a nominal amplitude of 6 mm.		
		Add 3.8.2	Dampen receiving surface and allow to dry to a saturated surface-dry (SSD) condition just prior to concrete application.		
		Add 3.8.3	The location of construction joints not shown on the drawings require approval by the Contract Administrator prior to placing concrete.		
3.9	Curing	Add 3.9.1	Cure concrete to CAN/CSA-A23.1 except where specified otherwise. Do not use curing compounds without approval of the Contract Administrator.		
		Add 3.9.2	For concrete placed when ambient air temperature is below +5°C comply with the cold weather requirements of CAN/CSA-A23.1. Do not place concrete when the ambient temperature exceeds +25°C.		
		Add 3.9.3	Unformed Surfaces:		
			1. Cure with burlap and water for a minimum of seven (7)		
			 days. Carefully place two (2) layers of damp burlap on the surface of the concrete as soon as practicable following placement. Overlap each strip by at least 75 mm and secure against displacement by wind. Maintain burlap in place and keep thoroughly and continuously wet for seven (7) days after day of placing. Provide misting as described in CAN/CSA A23.1 when water evaporation from the concrete surface is predicted to exceed 1.5 kg/m²/hr and according to CAN/CSA A23.1 Appendix D. 		
		Add 3.9.4	Formed Surfaces:		
			 If formwork is left in place for seven (7) days or more, no additional curing will be required. If formwork is removed in less than seven (7) days, cure in manner specified for unformed surfaces for remainder of seven (7) day period. 		
		Add 3.9.5	During curing period uncover only such areas as are immediately needed for finish treatment. Recover and continue curing.		
		Add 3.9.6	Continuously maintain the in-place concrete at a minimum temperature of +10°C for a minimum of 7 consecutive days or for the time necessary to attain 70% of the specified compressive or flexural strength, whichever period is shorter. This may require the erection of hoarding around the placed concrete and the provision of external heat. If required, do not vent heat to the enclosure directly at the in-place concrete.		
3.10	Field Quality Control	Add 3.10.1	Retain certified Independent Testing Laboratory in accordance with CSA A283 to carry out field quality testing.		
		Add 3.10.2	Inspection and testing of concrete and concrete materials shall be carried out in accordance with CAN/CSA A23.1, except as follows:		

SECTION 03 30 53S

SUPPLEMENTARY

A strength test shall consist of 3 standard cylinders, tested at 3, 7 and 28 days.

- Frequency of testing may be increased at Contract Administrator's discretion.
- 2. Contractor shall pay for costs of tests.
- Contract Administrator may take additional test cylinders during cold weather concreting. Cure cylinders on job site under same conditions as concrete which they represent.
- Non-destructive Methods for Testing Concrete shall be in accordance with CAN/CSA A23.2.
- Inspection or testing by Contract Administrator will not augment or replace Contractor quality control nor relieve the Contractor of their contractual responsibility.
- Concrete failing to meet the requirements shall be retested, strengthened, or rejected in accordance with CAN/CSA A23.2. All additional testing, strengthening, and/or replacement shall be at the Contractor's expense, and no delay claims will be entertained.
- In the event that air content is outside the specified tolerance range as determined by testing, the Contract Administrator may accept adjustments to the mix as an alternate to rejection, provided adjustment are made within the maximum time allowed.
- Do not add additional water to adjust slump.

Add 3.10.3 Acceptance Testing for Dowels:

- Carry out all acceptance testing on selected dowels. Testing shall be performed by an independent testing agency acceptable to the Contract Administrator. All required repairs and retesting shall be at the Contractor's expense, and no delay claims will be entertained.
- Carry out testing intermittently as installation proceeds. The Contract Administrator will randomly select up to 10% of the installed dowels or a minimum of three dowels whichever is larger, in each work zone for tensile (pull-out) testing. The Contract Administrator will review the installation and testing program with the Contractor prior to the start of dowel installation.
- Reinstate hooks cut off to facilitate testing using lap splices, couplers, or other means accepted by the Contract Administrator.
- Re-install and retest any dowel that fails the test at no expense to the Contract Administrator.
- Pull-out tests shall conform to ASTM E488 "Test Methods for Strength of Anchors in Concrete and Masonry Elements". Tension dowels to 80% of the specified minimum yield strength of the dowel. Dowel must hold the load for 5 min. without measurable movement of the
- Testing will be increased to up to 10% of all dowels or an additional 3 dowels whichever is larger, following a dowel failure or following the change of any installer contributing to the successful installation of previous dowels.
- If test results indicate that more than 5% of the total dowels fail the tensile test, the Contract Administrator may require the Contractor to carry out tensile testing of all dowels. No additional payment will be made.

1.0 GENERAL

1.1 References 1.1.1 American Society for Testing and Materials (ASTM):

- ASTM A53/A53M, Standard Specification for Pipe, Steel, Black and Hot Dipped, Zinc Coated Welded and Seamless.
- ASTM A123/A123M, Standard Specification for Zinc (Hot-Dip Galvanized) Coatings on Iron and Steel Products
- ASTM A153/A153M, Standard Specification for Zinc Coating (Hot-Dip) on Iron and Steel Hardware
- ASTM A193 / A193M, Standard Specification for Alloy-Steel and Stainless Steel Bolting for High Temperature or High-Pressure Service and other Special Purpose Applications.
- ASTM A269, Standard Specification for Seamless and Welded Austenitic Stainless Steel Tubing for General Service.
- ASTM A307, Standard Specification for Carbon Steel Bolts and Studs, 60,000 PSI Tensile Strength.
- ASTM A385, Standard Practice for Providing High-Quality Zinc Coatings (Hot-Dip)
- ASTM A563/ A563M, Standard Specification for Carbon and Alloy Steel Nuts
- ASTM B695, Standard Specification for Coatings of Zinc Mechanically Deposited on Iron and Steel
- 10. .ASTM F436/F436M, Standard Specification for Hardened Steel Washers Inch and Metric Dimensions
- ASTM F3125/F3125M, Standard Specification for High Strength Structural Bolts, Steel and Alloy Steel, Heat Treated, 830 MPa and 1040 MPa Minimum Tensile Strength, Inch and Metric Dimensions.
- 12. ASTM Practice A 143, Standard Practice for Safeguarding Against Embrittlement of Hot-Dip Galvanized Structural Steel Products and Procedure for Detecting Embrittlement

1.1.2 American Welding Society (AWS):

- AWS A5.4/A5.4M, Specification for Stainless Steel Electrodes for Shielded Metal Arc Welding
- 2. AWS D1.6/D1.6M, Structural Welding Code -Stainless Steel

1.1.3 Canadian Standards Association (CSA):

- CSA G40.20/G40.21, General Requirements for Rolled or Welded Structural Quality Steel/Structural Quality Steel.
- 2. CSA S16, Design of Steel Structures.
- 3. CSA S6, Canadian Highway Bridge Design Code.
- 4. CSA W47.1, Certification of companies for fusion welding of steel
- CSA W48, Filler Metals and Allied Materials for Metal Arc Welding (developed in cooperation with the Canadian Welding Bureau).
- CSA W59, Welded Steel Construction (Metal Arc Welding).
- 7. CSA W178.2, Certification of welding inspectors.
- 8. CSA G279, Steel for Prestressed Concrete Tendons.

1.1.4 Health Canada / Workplace Hazardous Materials Information System (WHMIS):

1. Material Safety Data Sheets (MSDS).

1.2 Submittals 1.2.1 Submit in accordance with the General Conditions and Section 01 33 015 – Project Record Documents.

1.2.2 Product Data:

- Submit manufacturer's instructions, printed product literature and data sheets for sections, plates, couplers, anchors, and joints. Include product characteristics, performance criteria, physical size, finish and limitations.
- Submit load-strain curves certifying physical properties for each mill heat of bar steel and/or wire steel. Physical properties and chemical composition to conform to minimum specification requirements indicated for bar steel and/or wire steel.

1.2.2 Shop Drawings:

- Submit drawings to Contract Administrator for review two weeks prior to fabrication.
- Shop drawings shall be supplied for all steel and joint components including, but not limited to, plates, built up sections and proprietary ioint hardware.
- Indicate on all shop drawings materials, core thicknesses, finishes, connections, joints, method of anchorage, number of anchors, supports, reinforcement, details, adjustable level devices for deck joints and accessories.

1.2.3 Welding procedures:

 Submit welding procedures, including welding procedure datasheets, for each type of weld proposed. The welding procedures shall bear the approval of the CWB and be reviewed and accepted by the Contract Administrator a minimum of one week prior to shop welding and three weeks prior to the commencement of field welding.

1.2.4 Mill Certificate Reports:

- The contractor shall provide certified mill test results for all reinforcing steel and any other structural and miscellaneous steel components required for the construction of the works, specifying the minimum ultimate strength, yield strength, elongation and chemical composition upon delivery to the site.
- Mill test reports that originate from a mill outside Canada, or the United States of America shall be verified and certified by a laboratory in Canada by testing the material to the specified material standards, including boron content.
- The testing laboratory shall be certified to ISO/IEC 17025 by an
 organization accredited by the Standards Council of Canada for the
 tests required. Samples for testing shall be collected by personnel
 employed by the certified laboratory.
- 4. A verification letter shall be provided by the certified laboratory that includes at a minimum, the applicable mill test reports, testing standards, date of verification testing, and declaration of material compliance with Contract requirements. The verification letter shall be signed by an authorized officer of the certified laboratory.

1.3 Quality Control

- 1.3.1 Submit certified test reports showing compliance with specified performance characteristics and physical properties.
- 1.3.2 Submit product certificates signed by manufacturer certifying materials comply with specified performance characteristics and criteria and physical requirements.

SUPPLEMENTARY CONTRACT		SECTION 05 53 00S SS 34		
SPECIFICATIONS		METAL FABRICATIONS 2025		
	1.3.3	Notify and submit a fabrication schedule to the Contract Administrator at least fourteen (14) days before fabrication commences. Allow the Contract Administrator access to all parts of the Work and supply such information and assistance as is required.		
	1.3.4	Provide samples of any materials when requested by the Contract Administrator.		
	1.3.5	Inspection by the Contract Administrator shall not relieve the Contractor from obligation to perform the work in accordance with the Contract.		
	1.3.6	Retain and pay for an independent qualified inspection company to complete in-plant fabrication inspection. The inspection company will:		
		 Verify that the correct materials are incorporated into the structure. Complete all non-destructive weld testing. 		
	1.3.7	Upon completion of the fabrication, the inspection company shall provide a report summarizing the work completed including summaries of all inspection work completed.		
	1.3.8	Welding inspectors shall be qualified by the CWB to the requirements of CSA W178.2. Any welding work found to be unacceptable shall be corrected in accordance with CSA W59, Section 5.10.		
	1.3.9	Perform, as a minimum, the following non-destructive testing of all welds:		
		 Visual inspection of all welds. Magnetic particle inspection of fillet welds, as follows: Submerged-arc welds: 25%. Semi-automatic welds: 50%. Manual welds: 25%. 		
	1.3.10	The Contract Administrator, at their discretion, may complete independent quality assurance inspection(s). Provide suitable access to allow these inspection(s) to be completed including moving and supporting components as required. The Contract Administrator will attempt to schedule non-destructive testing so as not to interfere with the progress of the work. Cost of re-inspection after defects are repaired shall be borne by the Contractor. The Contract Administrator's quality assurance inspection(s) will not absolve the Contractor of its responsibility for the quality control of the Work nor for completing the Work in accordance with the requirements of the Contract.		
	1.3.11	Correct any welding work found to be unacceptable in accordance with CSA W59.		
	1.3.12	In the fabricator's plant, the specification and grade of steel used for main components shall be identified by use of suitable markings or recognized colour coding. Cut pieces that are identified by piece mark and contract number need not continue to carry specification identification markings when it has been established that such pieces conform to the required material specifications.		
1.4 Delivery, Storage, And Handling	1.4.1	Deliver, store and handle materials in accordance with manufacturer's written instructions.		
	1.4.2	Delivery and Acceptance Requirements: Deliver materials to site in original factory packaging, labelled with manufacturer's name and address.		

- Upon request by Contract Administrator, provide tests for embrittlement outlined in ASTM A143.
- 4. Chemical composition of steel being galvanized shall be as follows:
 - Carbon less than 0.25%
 - Phosphorus less than 0.04%
 - Manganese less than 1.3%
 - Silicon less than 0.04% or between 0.15% and 0.22%
- 5. For steel not meeting these chemical composition requirements, develop special galvanizing techniques to ensure that the specified coating thickness and adherence is achieved. A detailed description of the special techniques shall be submitted to the Contract Administrator for review 2 weeks prior to galvanizing.
- 2.2.2 Zinc Rich Primer Coating:
 - Zinc rich primer shall be in accordance with CAN/CGSB 1.181 or MPI EXT 5.2C.
 - 2. Application rate of zinc rich primer shall be heavy.
 - Use primer unadulterated, as prepared by the manufacturer. Paint on dry surfaces, free from rust, scale, and grease. Paint when temperature is minimum 7°C.

	MENTARY ACT		SECTION 05 53 00S SS 36
CONTRACT SPECIFICATIONS		METAL FABRICATIONS 2	
		2.2.3	Isolate aluminum from the following components, by means of bituminous paint:
			 Dissimilar metals. Concrete, mortar, and masonry
3.0	EXECUTION		
3.1	Erection	3.1.1	Erect metalwork and temporary supports square, plumb, straight, and true, accurately fitted, with tight joints and intersections.
		3.1.2	Provide suitable means of anchorage acceptable to Contract Administrator such as dowels, anchor clips, bar anchors, expansion bolts and shields, and toggles.
		3.1.3	Exposed fastening devices to match finish and be compatible with material through which they pass.
		3.1.4	Supply components for work by other trades in accordance with shop drawings and schedule.
		3.1.5	Make field connections as shown on shop drawings.
		3.1.6	Deliver items over for casting into concrete together with setting templates to appropriate location and construction personnel.
		3.1.7	All field welds and other damage in galvanized coatings shall be thoroughly cleaned and painted with two coats of organic and zinc-rich paint.
		3.1.8	Couplers and anchorages shall not be welded.
		3.1.9	Couplers shall be manufactured by the coupler manufacturer and shall be capable of developing full tensile strength of the reinforcement. Couplers shall be stop-put and furnished with counter nuts, unless otherwise acceptable to the Contract Administrator.
3.2 Fa	Fabrication	3.2.1	Fabricate work square, true, straight, and accurate to required size, with joints closely fitted and properly secured.
		3.2.2	Where possible, fit and shop assemble work, ready for erection.
		3.2.3	Ensure exposed welds are continuous for length of each joint. File or grind exposed welds smooth and flush.
3.3	Welding	3.3.1	Welding shall be undertaken by a company approved by the CWB to the requirements of CSA W47.1, Division 3 or better.
		3.3.2	All welding shall be done in accordance with procedures approved by the Canadian Welding Bureau (CWB) and CSA W59
		3.3.3	Provide evidence that all welders and welding operators to be employed on the work are currently qualified by CWB in the processes in which they are to be employed.
		3.3.4	Welding of stainless steel in accordance with AWS D1.6/AWS D1.6M.
		3.3.5	Use low hydrogen filler, fluxes and low hydrogen welding practices throughout.
		3.3.7	Field welding:

SUPPLEMENTARY CONTRACT		SECTION 05 53 00S SS 37
SPECIFICATIONS	METAL FABRICATIONS	2025
	 When the ambient air temperature is welded shall be preheated and shelte ambient air temperature is below 0° unless hoarding and heating acceptal Administrator is provided. 	ered from wind. When the C, welding will not be permitted
	 Welding completed near or adjacent rubber components shall be protected damaged during field welding shall be Contract Administrator, at Contracto 	ed. All existing components e repaired, as determined by the
	 Field welding will only be permitted a accepted by the Contract Administra completed by a company certified to 	tor. Field welding to be

3.4	Clean Up	3.4.1	Leave Work area clean at end of each day.
		3.4.2	Final Cleaning: upon completion remove surplus materials, rubbish, tools and equipment to the satisfaction of the Contract Administrator.
		3.4.3	Waste Management: separate waste materials for reuse and recycling.
		3.4.4	Remove recycling containers and bins from site and dispose of materials at appropriate facility.
3.5	Protection	3.5.1	Protect installed products and components from damage during construction.
		3.5.2	Repair damage to adjacent materials caused by metal fabrications installation.

shall be considered full compensation for all work required to complete the installation as shown on the Contract Drawings and as described in the Contract Documents. Work includes, but is not limited to, all submittals, removal of existing joint sealants, cleaning and surface preparation, supply and installation of the joint sealants. Payment will include all equipment, labour, materials, waste disposal, and everything supplied and done in connection therewith.

Payment for this item includes all applicable materials, specifications, and work described in 1.4.1.

2.0 PRODUCTS

2.1 Materials Add 2.1.1 Grout materials for joints shall be in accordance with Section 03 30 53S – Structural Cast-in-Place Concrete

Add 2.1.3

Add 2.1.2 Steel for joints shall be in accordance with Section 05 53 00S – Metal Fabrications.

Compression seals shall be as shown on the Contract Drawings and shall be installed in accordance with the manufacturer's specification. The use of alternate equivalent compression seals requires acceptance by the Contract Administrator based on documentation provided by the Contractor.

Add 2.1.4 Materials for joint sealant shall be as follows:

- Vertical Joint Seams: Sealant shall be Sikaflex 1A or approved equivalent.
- Horizontal Joint Seams: Sealant shall be Wabo Silicone Seal or approved equivalent.

Add 2.1.5 All certified material test reports for the joints shall be submitted to, and accepted by, the Contract Administrator prior to installation.

3.0 EXECUTION

3.1 Site Conditions Add 3.1.1 Proceed with installation of pourable joint sealants only when:

- Ambient and substrate temperature conditions are within limits permitted by joint sealant manufacturer or are above 4.4 degrees C.
- 2. Joint substrates are dry.
- Conform to manufacturer's recommended temperatures, relative humidity, and substrate moisture content for application and curing of sealants including special conditions governing use

Add 3.1.2 Proceed with installation of joints only where joint widths are more than those allowed by joint manufacturer for applications indicated

3.2 Installation Add 3.2.1 The Contractor shall form or excavate for each deck joint as shown in the Contract Drawings.

Add 3.2.2 Each joint seal shall be supplied in a single length, without splices. Vulcanized locations for rubber seals shall be submitted to the Contractor

Administrator for review prior to installation.

Add 3.2.3 Following the removal of the existing seal, the surfaces of the concrete or steel to receive the new seal shall be cleaned of any residual that may be present by blast cleaning or other approved mechanical means. Ensure

joint surfaces are dry and frost free. Following the cleaning, the joint

- Add 3.2.4 The seal shall be installed in accordance with the manufacturer's recommendations, including requirements for lubricant adhesive.
- Add 3.2.5 After installation, deck joints shall be water tested by the Contractor in accordance with the Contract Drawings and to the approval of the Contract Administrator who shall be present for the tests. Contractor shall ensure joints are watertight. If joints are not watertight, joint seal shall be removed, reinstated, and retested.

Add 3.2.6 Flood Test

Deck joints to be flooded by the Contractor will have the Contract Administrator present and be checked for leaks to ensure they are watertight. The requirements for flood testing the joints are as follows:

- The air, concrete, and deck joint assembly temperature shall be 2 °C or higher at time of testing.
- After the epoxy has set and prior to acceptance, the joint shall be water tested over its entire length when there are no upturns. When there are upturns, the joint shall be tested between the gutter lines.
- 3. The water shall be continuously ponded for a minimum of one hour, maintaining a minimum depth of 25 mm along the tested length and a minimum depth of 100 mm above the deck joint assembly at the gutter lines. For superelevated decks, only the lower gutter line requires the testing at a depth of 100 mm.
- The width shall extend 50 mm beyond the concrete dams on both sides of the deck joint assembly.
- When the staging of traffic is required, the joint shall be tested in overlapping sections. The Contract Administrator shall be present for the entirety of the test.

Leakage of water through the deck joint assembly during this test, including the interface between the preformed seal and the seal retainers, concrete to steel interfaces, and the concrete construction joints, shall constitute failure of the deck joint assembly.

If such failure occurs, the deck joint assembly shall be repaired or replaced and the water test repeated. The method of repair shall be submitted in writing to the Contract Administrator for review prior to commencement of repair work.

The water test and any related corrective work shall be completed prior to any seasonal shutdowns. When this is not feasible, a proposal detailing an alternative solution shall be submitted to the Contractor Administrator for approval.

Pour test

Sidewalk joints to be water tested by the Contractor will have the Contract Administrator present and be checked for leaks to ensure they are watertight. The requirements for water testing the joints are as follows:

- Contractor shall pour water over each completed joint and note any water leaks below the joint.
- 2. A minimum of 5 litres of water shall be used in joint testing.

SUPPL CONTE	EMENTARY RACT		SECTION 07 91 00S SS 41
SPECIF	ICATIONS		JOINTS 2025
			 Water shall be poured over the entire length of the joint. A passing test will only be given if no water is observed passing through the joint from the underside of the bridge. If water ingress is observed, the contractor shall reset the joint seal.
3.3	Surface Preparation	Add 3.3.1	Examine joint sizes and conditions to establish correct depth to width relationship for installation of backup materials and sealants.
		Add 3.3.3	Do not apply sealants to joint surfaces treated with sealer, curing compound, water repellent, or other coatings unless tests have been performed to ensure compatibility of materials. Remove coatings as required.
3.4	Priming	Add 3.4.1	Where necessary to prevent staining, mask adjacent surfaces prior to priming and caulking.
		Add 3.4.2	Prime sides of joints in accordance with joint manufacturer's instructions immediately prior to installation.
		Add 3.4.1	Apply bond breaker tape where required to manufacturer's instructions.
			Install joint filler to achieve correct joint depth and shape, with approximately 30% compression.
3.5	Application	Add 3.5.1	Sealant:
			 Apply sealant in continuous beads. Apply sealant using gun with proper size nozzle. Use sufficient pressure to fill voids and joints solid. Form surface of sealant with full bead, smooth, free from ridges, wrinkles, sags, air pockets, embedded impurities. Tool exposed surfaces before skinning begins to give slightly concave shape. Remove excess compound promptly as work progresses and upon completion
		Add 3.5.2	Curing
			 Cure sealants in accordance with sealant manufacturer's instructions. Do not cover up sealants until proper curing has taken place.
3.6	Protection	Add 3.6.1	Protect installed products and components from damage during construction.
		Add 3.6.2	Repair damage to adjacent materials caused by joint sealant installation.

2.0 PRODUCTS

2.3 Pit Run Gravel

Add to 2.3.2

The use of recycled concrete shall be approved by the Contract Administrator and the City prior to use.

Add 2.3.3

Asphalt millings free from contamination and other extraneous material, conforming to the specified gradations may be used as pit run gravel. The use of asphalt millings shall be approved by the Contract Administrator and the City prior to use.

2.7 Granular Pipe Bedding and Surround Material Add to 2.7.1

All recycled or other extraneous materials shall be approved by Contract Administrator and the City prior to use.

2.10 Granular Base

Delete 2.10.2 and replace with the following All 25 mm minus granular base is to conform to the following gradation specifications for Collector / Arterial Roads:

Sieve Designation (mm)	Percent Passing (%)
25	100
19	80-100
12.5	75-90
9.5	50-85
4.75	35-70
2.36	25-50
1.18	15-35
0.30	5-20
0.075	0-5

Add 2.10.4

The intention of the Gradation Chart is to identify the desired mix of size of aggregate in the granular base. The Target Percentage Passing is the middle of the shown Range.

Tests that show sieve values of Percent Passing that are consistently low or consistently high in two (2) or more consecutive tests will be considered to be non-conforming.

2.11 Recycled Aggregate Material

Delete 2.11.1 and replace with the following Recycled aggregates may be used with approval from the Contract Administrator and the City, provided they meet all specification requirements and do not compromise construction quality. Only clean aggregates, crushed concrete, or asphalt free of impurities are permitted.

SUPPLEMENTARY

CONTRACT

SS 43

SPECIFICATIONS

CLEARING AND GRUBBING

SECTION 31 11 01S

SS 43

SPECIFICATIONS

CLEARING AND GRUBBING

2025

1.4 Measurement and Payment

Delete 1.4.1 and replace with the following Payment for all work performed under this section, unless listed in the Schedule of Quantities and Prices, will be incidental to payment for Work described in other Sections.

Clearing and grubbing includes removal and offsite disposal of all branches, stumps, trees, debris, hedges, timbers, logs and vegetation to access and complete the Work and as shown on the Contract Drawings or as directed by the Contract Administrator. Works include cutting branches affected by Work to create the necessary clearance to accommodate the construction and intended function of the Work, and as shown on Contract Drawing.

Payment includes trimming of small branches from trees or hedges as required to provide minimum 2.5m vertical and 0.5m horizontal clearance from edge of new road or rail. Branch cutting/pruning to have a clean-cut flush to branch collar and use of an approved tree paint to repair damage to surviving vegetation where branches have been removed.

1.0	GENERAL		
1.8	Limitations of Open Trench	Replace last sentence with the following	If circumstances do not permit complete backfilling of all trenches, and where permitted by the Contract Administrator and the City, adequately protect all open trenches or excavations with approved fencing or barricades and, where required, with flashing lights. Temporary road plates may be installed with the approval of the Contract Administrator. Contractors are to refer Appendix A – Traffic Management Detail Specifications for installation requirements.
2.0	PRODUCTS		
2.2	Use of Specified Materials	Delete 2.2.1.2	Delete Pit Run Sand
		Delete 2.2.3.3	Delete Pit Run Sand
3.0	EXECUTION		
3.3	Excavation	Delete 3.3.1.2 and replace with the following	Connections to existing waterworks systems are to be made by the Contractor under the inspection / supervision of the Contract Administrator and the City.
3.6	Surface Restoration	Delete 3.6.2.4 and replace with the following	Restore lawns with approved topsoil and sod to match existing lawn.
		Delete 3.6.3.1 and replace with the following	Restore surface with a minimum 100 mm of 19 mm granular road base material.
		Delete 3.6.7.5 and replace with the following	Restore Pavement as detailed on Coquitlam Standard Detail Drawing COQ-G4. Temporary patch shall be a minimum thickness of 50 mm thickness. Permanent restoration to existing asphalt thickness (minimum of 75 mm) with a 35 mm key where existing thickness permits. A 50 mm key is required on Arterial and Collector Roadways. Dry if necessary and paint clean, dry edge with asphalt emulsion (tack coat).

1.0 GENERAL

1.8 Measurement and Payment

Delete 1.8.4 and replace with the following Payment under this item will only apply to removal of the components included in this item under a separate operation as shown on the Contract Drawings or as directed by the Contractor Administrator. No payment will be made under this item for removal of these components as part of the operation for common excavation, and such removal will be treated as common excavation.

Payment will be made at the respective unit prices bid in the Schedule of Quantities and Prices and will include all labour and equipment required to complete the work, including offsite disposal. It is the responsibility of the contractor to locate and verify all utilities.

Delete 1.8.5 and replace with the following Payment for Common Excavation includes:

- Unless noted in the Schedule of Quantities and Prices as removal in square meters, common excavation will be measured in cubic metres calculated from measurements taken by the Contract Administrator in the areas of excavation (stripping inclusive).
- Cross-sections will be taken after clearing and grubbing and stripping of existing topsoil immediately prior to excavation of material to be incorporated into work.
- Cross-section will be taken after excavation to design elevation and prior to placement of fill.
- Where determined by the Contract Administrator that truck box volume will be used to determine excavation quantities, the table below will be used.

Truck Type	Material Type	Volume (m³)
Tandem	ordinary material	7
Tandem	asphalt/concrete/pipe	4
Triaxle	ordinary material	8
Triaxle	asphalt/concrete/pipe	5
Tandem and Pony	ordinary material	11
Tandem and Pony	asphalt/concrete/pipe	7.5
Triaxle and Pony	ordinary material	13
Triaxle and Pony	asphalt/concrete/pipe	9
Tandem and Transfer	ordinary material	19
Tandem and Transfer	asphalt/concrete/pipe	13

- Contractor to provide truck slips detailing location type of common excavation, time loaded and location of dump site. The slips are to be given to Contract Administrator by the end of shift or Contract Administrator can deny quantities subsequently submitted.
- 6. Payment for on-site reuse includes grading, adjustment of moisture content and compaction of the reused material

Payment will be made at the respective unit prices bid in the Schedule of Quantities and Prices and will include all labour and equipment required to complete the work, including offsite disposal. It is the responsibility of the contractor to locate and verify all utilities.

Delete 1.8.10 and replace with the following Payment for replacement of areas of unsuitable granular base, granular subbase or sub-grade revealed during proof rolling will include excavation with off-site disposal, installation & compaction of granular base material (19 mm minus), and all remedial work required to achieve a suitable base. Payment with be based on the cubic meter volume removed.

2.0 PRODUCTS

SUPPLEMENTARY CONTRACT SPECIFICATIONS		ROADWAY EXCAVATION, EMBANKMENT AND COMPACTION	SECTION 31 24 13S SS 46 2025
2.2	Specified Materials	Delete 2.2.1.3	
		Delete 2.2.1.4	
		Delete 2.2.2	
			END OF SECTION

SUPPLEMENTARY		SECTION 32 11 23S
CONTRACT		SS 47
SPECIFICATIONS	GRANULAR BASE	2025

1.4	Measurement and Payment	Delete 1.4.1 and replace with the following	Measurement for granular base of variable thickness will be for actual quantity placed based on weigh tickets provided to Contract Administrator as loads are delivered.
		Delete 1.4.2 and replace with the following	Measurement for granular base for each specified thickness will be for the actual area placed.
		Delete 1.4.3 and replace with the following	Payment for Subsection 1.4.1 & 1.4.2 above includes supply, placement and compaction of granular base material, adjustment of moisture content, road reshaping, and boning to establish the road cross-section, shall be included in the unit price bid in the Schedule of Quantities and Prices.
		Delete 1.4.4 and replace with the following	Payment for removal of unsuitable subgrade including disposal off-site prior to direct placement of granular base will be made under Section 31 24 13S $-$ 1.8.10.
2.0	PRODUCTS		
2.1	Granular Base	Add 2.1.1.3	25 mm minus crushed gravel conforming to the gradation specifications under Section 31 05 17S $-$ 2.10.2.
3.0	EXECUTION		
3.5	Proof Rolling	Delete 3.5.1 and replace with the following	For proof rolling, use fully loaded single axle, to 80 kN (18, 000 lb.) minimum, dump truck.
		Add 3.5.7	Prior to asphalt concrete paving, the base surface shall be checked by the Contract Administrator and the City, for deflections utilizing a Benkelman Beam, in order to ensure that the final rebound requirements can be obtained with the asphalt pavement. In the event that such deflection is in excess of those required to produce the final standards, then the base shall be adequately strengthened by additional gravel or asphalt concrete to ensure that final deflections as follows are not exceeded.
			The Benkelman spring rebound value of the completed pavement surface shall not at any point exceed 0.75 mm for arterial industrial roads and lanes, 1.15 mm for collector roads, and 1.5 mm for local roads and lanes as determined in the procedures outlined in the Transportation Association of Canada publication "Pavement Management Guide."

SUPPLEMENTARY CONTRACT			SECTION 32 1	2 13.1S SS 48
	ICATIONS	ASPHALT TACK COAT		2025
1.4	Measurement and Payment	Delete 1.5.1 and replace with the following	Payment for asphalt tack coat will be incidental for all portions of existing pavement to be tack coated in preparation for placement of hot mix asphaltic concrete.	
		Delete 1.5.2 and replace with the following	Payment for pavement surface cleaning, as per section 32 01 11, and all other work is incidental to the application of tack coat.	
3.0	EXECUTION			
3.2	Application	Add to 3.2.3	Asphalt tack coat to be applied using a truck mounted spray bar unless otherwise approved by the Contract Administrator and the City. Contractor shall demonstrate, to the Contract Administrator and the City, prior to application that all spray nozzles are operational and providing a consistent application.	

1.0 GENERAL

1.4 Submission of Mix Design

Delete 1.4.1 and replace with the following

Submit asphalt concrete mix design, including RAP content and trial mix test results to Contract Administrator for review at least two weeks prior to commencing work.

1.5 Measurement and Payment

Delete 1.5.1 and replace with the following Payment for asphaltic concrete paving for East Approach Crack Repair & CB Lead and Manhole Installation (as shown in Contract Drawings by Associated Engineering) includes all construction joint preparation, asphaltic surface milling to tie into existing asphalt, saw cutting, supply and placing of the asphaltic concrete, tack coat, compaction and cleaning frames, covers and lids of castings affected, protection of existing curb and gutter, and taped temporary pavement markings.

Measurement for asphaltic concrete paving for the specified design mixes will be made at the respective unit prices bid in the Schedule of Quantities and Prices and incorporated into Work will be asphalt concrete actually based on weigh tickets provided to the Contract Administrator as loads are delivered.

The contractor will not receive any additional compensation above the respective unit prices bid in the Schedule of Quantities and Prices for Hand Work, Special Equipment & Machinery to complete the Hot Mix Asphaltic Paving Work as shown on the Contract Drawings or as directed by the Contract Administrator.

For measurement and payment purposes, Contract Administrator may calculate payment on actual area paved to the thickness specified in the Schedule of Quantities and Prices and as shown on the Contract Drawings. Asphalt density of 2.45 tonne/m³ shall be used for tonnage calculated from actual area paved.

Delete 1.5.3 and replace with the following

Payment for asphaltic concrete sidewalks for Sidewalk Regrading (as shown in Contract Drawings by Associated Engineering) includes all construction joint preparation, saw cutting, supply and placing of the asphaltic concrete, compaction and cleaning frames, covers and lids of castings affected, adjusting existing catch basins to accommodate proposed grades, and temporary removal, protection, and reinstallation of existing noise barriers as required to complete the work as shown in the Contract Drawings.

Measurement for asphaltic concrete paving for the specified design mixes for will be made at the respective unit prices bid in the Schedule of Quantities and Prices and incorporated into Work will be asphalt concrete actually based on weigh tickets provided to the Contract Administrator as loads are delivered.

For measurement and payment purposes, Contract Administrator may calculate payment on actual area paved to the thickness specified in the Schedule of Quantities and Prices and as shown on the Contract Drawings.

Payment for this item includes all applicable materials and work described in 1.5.1.

Add 1.5.9

The Contractor or the Owner may request adjustment of the unit prices submitted for Asphalt Pavement if the Composite Rack Posting (CRP) varies by more than 5.0% from Tender Closing Date to the time the asphalt paving is actually performed.

2025

The CRP is a composite of the available Rack Postings for PG 64-22 FOB Langley BC.

Requests for asphalt pavement unit price adjustment must be made prior to commencing asphalt paving. The Contractor must provide the supporting documents as required by the Contract Administrator. Payment for asphalt paving performed prior to a request for price adjustment will be made at the unit price submitted.

Unit prices will be increased or decreased as applicable using the following formula:

Adjustment = (CRPwork - CRPtender) x ACvolume

Adjustment amount in dollars per tonne the unit price is modified CRP work is the CRP at the time paving is performed CRP tender is the CRP at the Tender Closing Date AC volume is the mixture design percent asphalt content, by volume.

1.6 Inspection and Testing Add 1.6.3 Test cores will be taken by the Contract Administrator in the areas of new paving and will include cores along construction joints to ensure compliance with the required design and compaction.

- 2.0 **PRODUCTS**
- Add 2.1.2.1 2.1 Materials

Usage of recycled asphalt shingles will not be permitted.

Add 2.1.2.2

Usage of softening agents, rejuvenators, or recycling agents will not be permitted.

2.2 Mix Design Delete 2.2.2 and replace with the following

Mix may contain up to a maximum of 15 % by mass of RAP for Upper Course Asphalt and 20 % by mass of RAP for Lower Course Asphalt without a special mix design. The Contract Administrator and the City may approve higher proportion of RAP if Contractor demonstrates ability to produce mix meeting requirements of the specification.

Delete 2.2.3.2 and replace with the following

Marshall Stability at 60oC for both lower and upper courses to be 10 KN min.

- 3.0 **EXECUTION**
- 3.3 Delete 3.3.3 Preparation

and replace with the following

The Contractor is responsible for adjusting all utility manhole frames, existing catch basins, junction boxes, and valve boxes, belonging to Coquitlam and/or other agencies that are affected by the road works and sidewalk regrading work. All adjustments to utilities must be completed to the satisfaction of the utility owner. Utility adjustment within the paved surface will be considered incidental to the Work unless otherwise noted in the Contract Documents.

The Contractor should note that certain utility owners may decide to complete their own adjustments. The Contractor will be required to cooperate with any utility company providing their own adjustments.

The Contractor shall be responsible to contact the appropriate utility company within minimum of seventy-two (72) hours of the work. No adjustment shall be made without the written approval of the utility company.

SUPPLEMENTARY CONTRACT SPECIFICATIONS	нот-м	SECTION 32 12 16S SS 51 IIX ASPHALT CONCRETE PAVING 2025
		All manholes must be vertically adjusted a minimum of twenty-four (24) hours prior to paving. The use of riser rings for adjusting manhole frames and value boxes will not be permitted.
3.7 Joints	Delete 3.7.5 and replace with the following	Construct butt joints at locations as shown on the Contract Drawing and as directed in the field by the Contract Administrator and the City.
		END OF SECTION

1.0 GENERAL

1.2 Scope Delete 1. and repla

Delete 1.2.1 and replace with the following Pavement Markings: Miscellaneous taped temporary and permanent pavement markings including pedestrian crosswalk, merge and diverge markings, stop lines, solid and broken line road lane markings including edge lines of merge and diverge markings, bike symbols, etc. to be provided as shown on the Contract Drawing.

1.5 Measurement and Payment

Delete 1.5.2 and replace with the following All permanent markings shall be marked with extruded thermoplastic road markings as specified under Section 32 17 23S, 2.1 Materials, unless shown otherwise in the Schedule of Quantities and Prices.

Delete 1.5.3 and replace with the following

Payment for Permanent MMA Pavement Markings including on Parapet will be made at the lump sum amount indicated, unless shown otherwise, in the Schedule of Quantities and Prices. The amount provided shall be considered full compensation for all work required to complete line paint reinstatement for concrete approaches removed as part of expansion joint and joint sealant replacements, removal of stop bars and paint lines via hydro removal, and all other pavement marking installation as shown on the Contract Drawings by R.F. Binnie.

Payment for permanent thermoplastic pavement markings will not be made until all temporary pavement markings and reflective devices have been removed.

Delete 1.5.4 and replace with the following

Payment for signage includes all sign poles, bases, sleeves, sign relocations and sign installations (complete). The City will supply signs to supplement existing signs as required. Payment includes all labor, materials and incidentals to complete the work.

Installation of each new sign pole, cap, sleeve and trapezoidal base includes all costs to supply all materials, labour and equipment and incidentals, as shown on Standard Detail Drawings SS-E11.1 & SS-E11.2, necessary to the install sign structure as shown on the Contract Drawings and as directed by the Contract Administrator.

Installation of each new sign pole, cap, sleeve, galvanized steel bracket for no post barrier, as per MOT Drawing # SP635-3.8.3, includes all costs to supply all materials, labour and equipment and incidentals necessary to the sign structure as shown on the Contract Drawings and as directed by the Contract Administrator.

The unit price payment is for each city supplied aluminum sign installed on a sign pole including sign mount clamps & all costs to supply all materials, labour and equipment and incidentals necessary to install each sign as directed by the Contract Administrator.

Installation of each aluminum sign on a lamp standard pole or sign pole includes sign mount clamps and all costs to supply all materials, labour and equipment and incidentals necessary to install each sign as directed by the Contract Administrator.

Add 1.5.5

Payment for the supply and installation of the specified delineator will include all labour, equipment, and materials required to complete the work as per manufacturer's specifications.

2.0 PRODUCTS

2.1 Materials

Delete 2.1.1 and replace with the following All permanent paint markings shall be marked with thermoplastics manufactured by LAFRENTZ Road Markings.

Delete 2.1.7 and replace with the following

Thermoplastic material

- .1 Material composition shall be at the discretion of the manufacturer subject to the approval of the Contract Administrator and the City. Each formulation shall be identified by a code number.
- .2 No retained water when tested by ASTM D-570.
- .3 Specific gravity of the supplied product shall be within 3 % of that specified for the selected formulation.
- .4 Material shall not deteriorate upon contact with deicing chemicals, gasoline, diesel fuel or grease dropped by traffic.
- .5 Material shall not break down, deteriorate, scorch or discolour, if held within the application temperature range specified by the manufacturer for a period of four hours and it must be able to be reheated from room temperature to the application temperature four (4) times without showing any of these detrimental effects.
- .6 When applied at the temperature recommended by the manufacturer and at a film thickness of 2 to 4 mm, the material shall set solid and show no tracking under traffic after elapsed times as follows:
 - .1 Two (2) minutes at an air temperature of 10° C, relative humidity less than 75 %, and road surface temperature from 10° C to 20° C.
 - .2 Five (5) minutes at an air temperature of 32° C, relative humidity less than 75 %, and road surface temperature from 35° C to 50° C.
 - .3 The drying time under conditions intermediate between the two air temperatures shall be interpolated using a straight-line model
- .7 The quantity, type, and gradation of the component reflecting glass spheres premixed in the thermoplastic material shall be at the discretion of the manufacturer but shall provide retroreflection levels specified below.

Add 2.1.10 Pavement Markings on All Concrete Surfaces Including Parapets:

- .1 Material approved shall be MMA (Methyl Methacrylate).
- .2 The MMA Skid Resistant Material shall meet the following requirements:
 - .1 Be Ultra-Violet Stable
 - .2 Be ISO Certified Durable Road Marking Material
 - .3 Utilize 0.5mm 1mm aggregate within the MMA to create skid resistance of 49 BPN.
 - .4 Red and Yellow Color (Pantone #) to be approved prior to application.
- .3 Product details and specification to be submitted to Contract Administrator for final approval.

3.0 EXECUTION

3.3 Application

Add to 3.3.1.3

Temporary raised pavement markings (TRPMs) are to be provided on all multi-lane roadways as directed by the Contract Administrator and the City.

SUPPLEMENTARY		SECTION 32 17 23S
CONTRACT		SS 54
SPECIFICATIONS	PAINTED PAVEMENT MARKINGS	2025

Delete 3.3.3.3 and replace with the following Thermoplastic material shall be heated in the melter to a temperature of 382 $^{\circ}\text{F}.$

10 GENERAL

1.0	GENERAL		
1.6	Measurement and Payment	Delete 1.6.1 and replace with the following	Payment for Storm Sewer Drainpipes will be at the lump sum amount indicated, unless shown otherwise, in the Schedule of Quantities and Prices. The amount provided shall be considered full compensation for all work required to complete installation as shown on the Contract Drawings.
			Measurement for storm sewers will be made horizontally from manhole centreline to manhole centreline after surface work has been completed or on the total lineal metres of installed pipe, from inlet to outlet, along the centreline.
		Delete 1.6.2 and replace with the following	Payment for storm sewers includes location and exposure of existing utilities, saw cutting pavement, trench excavation, dewatering, bypass pumping, disposal of all surplus excavated material, bedding, import backfill, road subbase and base, disposal of existing storm pipe, support of adjacent piping, supply and installation of all pipe, fittings and related materials, tie-ins to new/existing storm pipe, inserta tee, sanded stub, manhole rebenching as required, ramping, existing catchbasin or lawnbasin lead tie-ins to new storm, construction joints, temporary asphalt patching, temporary surface restorations, cleaning and flushing, testing (if applicable), videoing and all other work and materials necessary to complete installation as shown on Contract Drawings and specified under this Section.
		Add to 1.6.3	Payment for storm service connection includes all applicable materials and work described in 1.6.2 and 150mm SDR28 PVC pipe, shear band couplers, bends, sanded stubs, inserta tee, increaser, stubs and all related fittings and components specified and/or shown on Standard Detail Drawings.
		Delete 1.6.5 and replace with the	Payment for catchbasin leads include all applicable materials and work described in 1.6.2.
		following	Measurement for catchbasin leads, lawn basin or communication box will be made horizontally from tie-in point to centreline of catchbasin or lawn basin for each pipe size installed with no regards to depth range.
		Add to 1.6.6	Payment for solid or perforated pipe includes all applicable materials and work described in 1.6.2.
			Measurement for solid or perforated pipe will be made horizontally from start of new solid or perforated pipe to tie-in point installed with no regards to depth range.
2.0	PRODUCTS		
2.2	PVC Pipe, Mainline Smooth Wall	Delete 2.2.1 and replace with the	200 mm dia. – 375 mm dia. to ASTM D3034 450 mm dia. – 1,200 mm dia. to ASTM F679
		following	
2.3	PVC Pipe, Mainline Profile	Delete 2.3	
2.6	Service Connections	Delete 2.6.1 and replace	Storm service connections to be PVC DR 28 152 mm diameter minimum or as specified on Contract Drawings.

with the following

SUPPLE CONTR	MENTARY ACT		SECTION 33 40 015 SS 56	
SPECIFI	CATIONS		STORM SEWERS 2025	
		Delete 2.6.8.1		
		Delete 2.6.8.2 and replace with the following	Connections to PVC pipe to be made with a performed wye fitting where mainline pipe is 300 mm diameter or smaller. For connections to PVC mainline pipes larger than 300 mm diameter an insertable tee for PVC pipe is permitted.	
		Add 2.6.8.3	Insertable tee fitting shall have a rubber collar which inserts into the mainline pipe to form a tight seal and shall have stainless steel band to secure the tee insert. The tee insert shall be a standard bell end with depth control lugs. The joint shall provide a minimum seal of 90 kPa on concrete and polyethylene pipe, and 190 kPa on PVC pipe.	
2.9	Granular Pipe Bedding and Surround Material	Delete 2.9.3	Pipe bedding shall be 19 mm clear crushed rock or as approved by the Contract <i>Administrator</i> and the City.	
3.0	EXECUTION			
3.8	Connections to Existing Mainline Pipe	Delete 3.8.3 and replace with the following	New connections to existing, smooth wall or profile, mainline sewers 300 mm and smaller, shall be made by removal of the section of the main and replacement with a preformed PVC wye fitting complete with stubs and double hub PVC couplings for PVC mains and approved shear band couplings for other mainline materials. For new connections to existing mainlines greater than 300 mm, use of insertable tee is permitted.	
3.10	Service Connection Installation	Delete 3.10.3 and replace with the following	Inspection chambers shall be provided on all storm service connections as per Standard Detail Drawing S7. If inspection chamber is located in driveway, lane, or paved surface, Series 37 Brooks concrete box with lid shall be installed as per Standard Detail Drawing S9.	
3.12	Inspection and Testing		The contractor shall video inspect completed storm sewers under 900 mm in diameter and all service connections following completion of the installation. The video inspection report shall be in a form specified by the Contract Administrator and the City. Copies of the video DVD and written report shall be forwarded to the Contract Administrator and the City. Refer to Section 33 01 30.1 and 33 01 30.1S CCTV Inspection of Pipelines.	
3.16	Permanent Capping of Service Connections	Add 3.16.1	Permanent capping of existing storm sewer connections to be completed as per Coquitlam Standard Detail Drawing COQ-S18.	
		Add 3.16.2	A trenchless method of permanently capping a service may be required on an arterial road or on a road which has been paved within 5 years, as directed by the Manager. The trenchless technology used to cap the service must be approved by the Manager.	

SUPPLEMENTARY CONTRACT				SECTION 33 44 01S SS 57
	ICATIONS	MAN	HOLES AND CATCHBASINS	2025
1.0	GENERAL			
1.1	Related Work	Add 1.1.6	Hot Mix Asphalt Concrete Pavement	Section 32 12 16
		Add 1.1.7	Portland Cement Concrete Paving	Section 32 13 13
1.5	Measurement and Payment	Delete 1.5.1.1 and replace with the following	Payment for manhole includes supply and installat concrete riser, concrete barrel, donut ring, concrete cover, ladder rung and all components to comple specified invert to finishing level. Payment include locating/daylighting existing storm sewer inverts coordinating with the Contract Administrator and invert elevations, temporary asphalt patching, ba concrete work, bedding, import backfill, subbase preparation to accommodate new sewer installat equipment and necessary work for installing the incontract Drawing and as described on Standard D	ete frame, metal frame, te the manhole from es pre- prior to construction and I Engineer to determine se preparation, all in-situ and base, manhole ion, all labor, material, manhole as shown on
			Payment includes all labor, material and equipme of manhole.	ent required for benching
		Delete 1.5.2 and replace with the following	Payment includes supply and installation of new of described in Schedule of Quantities and Prices inconcrete barrel, concrete riser, PVC sanded stub, H20 rated concrete frame/lid, metal frame, top in trapping hood and all labor, material and equipm the work from specified invert to finishing level a Drawing as described in Schedule of Quantities are includes excavation, disposal of surplus excavated preparation, bedding, import backfill, catchbasin/to accommodate catchbasin/lawnbasin connections situ concrete work, all labor, material, equipment installing the catchbasin/lawnbasin.	cluding catch basin base, donut ring, off-set sump, allet and grate, aluminum ent required to complete and as per Standard Detail and Prices. Payment di material, base (lawnbasin preparation on, installation of all in-
			Payment for Catchbasin/lawnbasin lead work will 33 40 01S	be made under Section
2.0	PRODUCTs			
2.1	Materials	Add 2.1.7.3	Any frame and cover assembly creating a point lo rings will not be permitted.	ad on the concrete riser
		Delete 2.1.12 and replace with the following	Catchbasin lids manufactured to ASTM C478M	
		Delete 2.1.16.2		
		Delete 2.1.17		
3.0	EXECUTION			
3.1	Excavation and Backfill	Add 3.1.2	For manholes, when base gravels are complete, e and manhole frame assembly. Do not disturb the beyond the excavation requirement.	
3.3	Manhole Installation	Delete 3.3.12.2 and replace with the following	Allowable products are precast concrete risers an system. Individual riser heights shall be 50mm, 7	

SECTION 33 44 01S

These Supplementary Contract Specifications must be read in conjunction with the Specifications contained in the Master Municipal Construction Documents, Volume II, Printed 2009 and the City of Coquitlam Supplementary Specifications and Detailed Drawings

SUPPLEMENTARY

CONTRA	CT		SS 58	
SPECIFIC	CATIONS	MANHOLES AND CATCHBASINS		
		Delete 3.3.12.5 and replace with the following	Proper layer of grout between the spacers, covering the entire surface of the rings, should be utilized.	
		Delete 3.3.15 and replace with the following	Install drop structures as shown on the Contract Drawings to Coquitlam Standard Detail Drawing COQ-S4 and Standard Detail Drawing S3. Maximum allowable inside ramp shall be 250 mm invert to invert.	
		Delete 3.3.17 and replace with the following	Ensure frames conform to design contour of pavement or existing surface. Manhole lids left raised in preparation for overlay paving shall have a rubberized protector ring or asphalt ramp. The use of riser rings for adjusting manhole frames will not be permitted.	
3.5	Catchbasin Installation	Delete 3.5.1 and replace with the following	Install catchbasins as shown on Coquitlam Standard Detail Drawings COQ-S11A, COQ-S11B and Standard Detail Drawing S11, to general standards and installation procedures described under 3.3 of this Section.	

SECTION 33 44 01S

SUPPLEMENTARY

CONTR			SECTION 34 41 13S SS 59
SPECIFI	CATIONS		TRAFFIC SIGNALS 2025
1.0	GENERAL		
1.3	Shop Drawings	Delete 1.3.4 and replace with the following	Shop drawings for pole structures, where required, to be sealed by a Professional Engineer registered in British Columbia.
1.4	Electrical Energy Supply	Add 1.4.4	The Electrical <i>Contractor</i> will process a letter of application to the City of Coquitlam for the Utility Company and attain all required permits.
1.5	Contractor Qualifications	Add 1.5.3	All on-site traffic signal installations shall be under the responsibility of a primary journeyman electrician with IMSA Level 2 Signal Certification and have successfully completed at least five (5) traffic signal system installations. This primary journeyman electrician is expected to have to be at the <i>Place of Work</i> and report work progress to City of Coquitlam's Traffic Operations staff, in addition to reporting to the <i>Contract Administrator</i> .
		Add 1.5.4	Fibre Optic Cable:
			.1 All fibre optic cable installations workmanship, material and/or installation practices and activity will be equal to or better than the standards established by the CAN/CSA T529-530-M90 Standards and the Canadian Electrical Code.
			.2 Those retained to complete the work must be authorized, trained and certified by the manufacturers they represent. They must have a minimum of two (2) years experience installing and testing multimode and single mode cables of all types as well as experience with LC and SC connectors.
			.3 Those retained to complete the work must have experience installing cabling for FDDI (Distribution System Data Interface) compliant 100 Mbit/sec, SONET, ATM, Token Ring or Ethernet networks using industry accepted systems and practices. Experience with leading manufactures fiber products and systems would be beneficial.
			.4 Those retained to complete the work must be prepared, trained and equipped to properly test the fibre cabling system, including the fibre transmission media and connectors. Each optical fibre of each section of cable will be tested using an "Optical Time Domain Reflectometer" (OTDR) and will meet the specifications before installation. After installation an "Optical Light-loss Testing Sets" (OLTS) will be mandatory to determine cable length, locate any fibre breaks or anomalies, measure attenuation of fibre's, connectors and assess fibre uniformity. Those retained to complete the work will provide a report showing all values measured during these tests.
1.6	Permits and Tests	Add 1.6.5	Contractor shall provide the BC Safety Electrical Permit, and arrange all inspections with the City. The inspection entails, but not limited to, Coquitlam's "Intersection and Cabinet Start-up Checklist", which can be obtained from Coquitlam's Traffic Operations staff.
1.8	Record Drawings	Add 1.8.2	Final payment(s) will be withheld until record drawings are received.
1.9	Measurement and Payment	Delete 1.9.2 and replace with the following	The traffic signal lump sum price includes all labour, equipment, and materials to complete the works as shown on the Contract Drawings and as specified in the Contract Documents. This shall consist of all permits and fees for electrical inspections, testing, other costs associated with

specifications.

electrical works undertaken by others, import backfill, temporary and permanent asphalt restoration within conduit trench as described in the Contract Drawings and as described in these supplementary contract

Products.

Refer to the City of Coquitlam's List of Approved Materials and

LED Signal Modules

Delete 2.17 and

replace with the

following

2.17

CONTRA SPECIFIC			TRAFFIC SIGNALS 20
2.19	Signal Mounting Hardware	Add 2.19.8	Primary signal head safety cable to be 3/32" galvanized steel aircraft cable.
		Add 2.19.9	Refer to the City of Coquitlam's List of Approved Materials and Products.
2.20	Audible Signals	Delete 2.20 and replace with the following	Refer to the City of Coquitlam's List of Approved Materials and Products.
2.21	Pedestrian /Cyclist Pushbuttons	Delete 2.21 and replace with the following	Refer to the City of Coquitlam's List of Approved Materials and Products.
		Add 2.21.1	Pedestrian (PYRO) and bicycle (ZELT) eco-counters are to be manufactured together, to form a pedestrian and bicycle eco-counter (MULTI).
2.22	Luminaires	Add 2.22.6	Refer to the City of Coquitlam's List of Approved Materials and Products.
2.29	Illuminated Crosswalk Signs	Delete 2.29 and replace with the following	Refer to the City of Coquitlam's List of Approved Materials and Products. Illuminated sign safety cable to be 3/32" galvanized steel aircraft cable.
3.0	EXECUTION		
3.1	General	Add 3.1.5	During the installation of the traffic signal system, maintain the existing traffic signal and/or signs as noted on the <i>Contract Drawing</i> . If temporary or permanent relocations of related traffic signal equipment or signs are required, such equipment shall be reinstated as required under the <i>Contract Documents</i> or as directed by the <i>Contract Administrator</i> .
3.3	Concrete Bases	Add 3.3.7	Concrete service bases detailed on Standard Detail Drawings CE1.3 and CE1.4, Type C1 and C3 service bases shall have five (5) conduits. See Coquitlam Standard Detail Drawing SS-E7.3.
		Add 3.3.8	Lifting cables on concrete controller bases shall be removed after base installation.
		Add 3.3.9	All concrete bases shall be pre-cast concrete only, unless noted on Contract Drawing or directed by the Contract Administrator.
3.4	Junction Boxes and Vaults	Delete 3.4.1 and replace with the following	Install junction boxes as shown on Standard Detail Drawings E2.2 to E2.4. Install vaults as shown on Coquitlam Standard Detail Drawing SS-E2.5.
		Add 3.4.5	Bell end fittings shall be installed in all conduits entering junction boxes or vaults.
		Add 3.4.6	Junction boxes requiring 3 or more sections must be approved by the City of Coquitlam's Traffic Operations staff.
		Add 3.4.7	All junction boxes shall be provided with RPVC bars to support electrical connections and fuse holders. The RPVC bars shall be attached into the junction box side walls with the electrical connections/fuse holders tie-wrapped in place and installed in the up-right position.
3.5	Underground Conduit	Delete 3.5.2 and replace with the following	Minimum cover over conduits to be 600 mm in boulevard areas and 900 mm in roadway areas.

SECTION 34 41 13S

SUPPLEMENTARY

		Delete 3.5.3 and replace with the following	Place trench marker tape 300 mm above installed conduit in trench. Trench marker tape not required for conduits installed via trenchless technology.
		Delete 3.5.5 and replace with the following	Empty conduits shall have a No. 8 HB Yellow/Green Mk pull string and capped at both ends.
		Add 3.5.6	Conduit run shall contain no more than the equivalent of $4-90$ degree bends.
		Add 3.5.7	Conduits shall be blown out with compressed air, from both ends if necessary, then swabbed out to remove stones, dirt, water and other material which may have entered during installation.
		Add 3.5.8	All conduits entering poles and cabinets shall be sealed with "Duct Seal".
		Add 3.5.9	Conduit depth of bury to be recorded when a trenchless technology method is used.
		Add 3.5.10	Traffic signal communications conduit shall enter and leave junction boxes through bell end fittings in the horizontal position (no bends) and shall run straight through the junction box unless a change in alignment occurs, or as otherwise specified on the <i>Contract Drawing</i> .
		Add 3.5.11	Conduit shall not be bent in the field. Only factory bends will be accepted.
3.7	Traffic Signal and Pedestrian Head Mounting	Delete 3.7.1 and replace with the following	Install traffic signal and pedestrian signal heads as shown and Standard Detail Drawings E5.2 and E5.9 only. Banding straps shall be used for primary signal heads.
		Add 3.7.5	Primary traffic signal heads shall be safety cabled to the traffic signal pole arm using 3/32" galvanized steel aircraft cable looped through the traffic signal backboard and fastened with a rope clip.
3.8	Audible Signals	Delete 3.8.1 and replace with the following	Install audible signal in accordance with Coquitlam Standard Detail Drawing SS-E5.12.
3.10	Luminaires and Photocells	Add 3.10.4	NEMA wattage label shall be visible at the bottom of the luminaire on all fixtures.
3.13	Electrical Service Panels	Delete 3.13.1 and replace with the following	Mount electrical service panels in service base or on poles as shown on Standard Detail Drawings E7.2, E7.6 to E7.9, as well as Coquitlam Standard Detail Drawings SS-E7.3 to SS-E7.5.
3.14	Wiring	Delete 3.14.3 and replace with the following	With the exception of conductor spliced of detector loop wires to shield cables, make conductor splice in pole handholes. Make splices of detector loop wires to shielded cable in junction boxes.
		Delete 3.14.13 and replace with the following	Bond all signal heads and luminaires with No. 12 RW90 green conductor, and steel junction box lids with No. 8 RW90 green conductor.
		Add 3.14.14	Detector loop cable splices shall be soldered with rosin core solder (no acid core or acid flux) then cap with waterproof gel filled wire nut and tape with vinyl di-electric tape. Suspend and ty-wrap splices at top of junction box with open end of wire nut pointing down.

Loop shield drain conductor shall cut and be isolated from the

			Loop shield drain conductor shall cut and be isolated from the system ground. See Coquitlam Standard Detail Drawing SS-E8.4.
3.16	Traffic Controller	Add 3.16.8	Silicone sealant shall be applied to both sides of the rubber gasket, which is placed between the traffic signal cabinet and the concrete base to ensure a weather tight seal.
		Add 3.16.9	Traffic cabinet interior shall be kept dry during inclement weather.
3.17	Detector Loops	Delete 3.17.1 and replace with the following	Detector loops are to be round type or as specified on the <i>Contract Drawing</i> and approved by the City of Coquitlam's Traffic Operations staff. Install in accordance with Standard Detail Drawings E8.1, E8.3 and Coquitlam Standard Detail Drawings SS-E8.2 and SS-E8.4.
		Add 3.17.3	Loops in adjacent lanes shall be wound in opposite directions, i.e.; clockwise, counter clockwise, clockwise, etc.
		Add 3.17.4	Detector loops should be installed in the base lift of asphalt, unless otherwise specified by the Contract Administrator.
3.19	Advance Warning Signs	Add 3.19.2	Contrary to Standard Detail Drawing E10.3, Item A shall be a 300 mm signal head section with LED display.
		Add 3.19.3	Advance warning signs shall have yellow prismatic retro-reflective sheeting (3M [™] Scotchlite [™] Diamond Grade [™] VIP Reflective Sheeting Series 3990 or approved alternate).
3.20	Grounding & Bonding	Add 3.20.5	Ground plates and grounding conductors are to have a minimum of 5 meters clearance between them and other utility grounding.
		Add 3.20.6	Grounding rod or plate electrodes shall not be installed inside the traffic signal cabinet base.
		Add 3.20.7	Remove all paint around bonding studs on inside of pole to expose the galvanized or metal surface prior to bonding equipment.
3.22	Pole Finish Application	Delete 3.22 and replace with the following	.1 Prior to producing a powder finish product the supplier must provide a Certificate of Compliance indicating that they have met or exceeded the following specifications. The supplier will name their independent testing agency and this information will be submitted to the City for their files.
			.2 The application process will be as follows:
			.1 The pole or product will be hot dip galvanized.
			.2 Powder will only be applied after the product is completely fabricated. No welding or bending will take place after the powder is applied.
			.3 The pole or product will be thoroughly cleaned by brush blasting in accordance with SSPC-SP7. The brush blast will maintain a minimum profile of 0.5 mils. If brush blasting is done off site then the product will be covered and shielded from any dirt or moisture during its return to the powder applicators facility. Where poles or products are not kept clean and dry or have any signs of flash rust they will be returned for further brush blasting.
			.4 Once at the applicators facility the pole or product will be thoroughly cleaned and dried with an air gun. All hand marks or grease spots will be cleaned with a mild solvent.
			.5 After brush blasting the entire pole or product will be pre- baked in an oven at 220 degrees C for at least 30 minutes

to 1 hour, depending on steel thickness. The pre-baking

2025

must be done to prevent out-gassing during the curing

- .6 The base powder coat will then be applied electrostatically while the pole or product is cooling from the 220 degrees C pre-bake period to allow the powder to melt and fuse to the surface. The base coat will be a minimum of 3 mils in thickness.
- .7 After base coat is applied and set the topcoat will be applied to a thickness of 3 to 5 mils. The pole or product will be returned to the oven and heated to 190 to 220 degrees C (temperature will not exceed pre-bake) for a minimum of 25 minutes, depending on steel thickness. Thicker product material may require longer bake cycles to fully cure. Upon removal of the pole or product from the oven it will be left to rest until the pole or product is cool enough to the touch.
- .8 Once the topcoat has cured and the poles or product cooled, they will then be individually wrapped (min 4" overlapping method) with 1/8" foam wrap over the entire pole or product. The poles or product will be bundled together and separated with suitable wood dunnage to avoid contact between the poles, product or other bundles. All bundles themselves will be fully wrapped with foam and with stretch-wrap as noted above. The poles or products will be handled and shipped with great care to prevent damage; damaged product will be cause for rejection of the item(s).

.3 Testing process will be as follows:

- .1 Each run of product in an oven will have at least one sample tested for:
- .2 Adhesion The finished powder surface will have minimum pull-off strength exceeding 1000 PSI as tested in accordance with ASTM D4541.
- .3 Quality The finished powder surface will be free from any holidays (skips or misses) as tested in accordance with ASTM D4541. The product will also be free from wrinkles, orange peel, cracking, pinholes, fish eyes, blisters, etc by visual inspection.
- .4 Color The color will be verified to be within 3 DE of specialized color.
- .5 An independent firm such as CanSpec Testing who are qualified to test powder finish will do the testing at the supplier's expense. The result of tests must accompany the Certificate of Compliance and will be made available to the City or their representative upon request. A supplier who fails to test product as noted above will have their product rejected until the testing is completed and the product deemed acceptable by the testing agency.
- .6 Where the tested product fails on a given production run then a minimum of 30 % of the entire production run will be tested. If no other failures are found then the individual failed product will be stripped, reapplied and re-tested until it passes. If any of the 30% of product tested fails then the entire order will be stripped, reapplied and retested until it passes.

			or	eld repairs will be undertaken as required to fix any scratches r imperfections in the final finish. Field repairs will be done as ollows:
			.1	Feather the damaged area with sandpaper.
			.2	Clean area with solvent.
			.3	Let dry.
			.4	Neatly brush on an application of Aliphatic Urethane Acrylic Semi-Gloss High Build applied at 2-4 mils DFT over the entire sanded and damaged area. The ambient conditions will be dry and over 10 degrees C when the paint is applied.
			.5	The pole supplier will warranty the integrity of the surface for a minimum of 1 year from the date of installation. The warranty will include all labour and materials required to provide replacement product if required. The powder finish will be the responsibility of the pole supplier. The warranty will apply to fading, blistering, cracking or chipping of the surface.
3.26	Uninterruptable Power Supply	Add 3.26.2	the tra	erruptable power supply/cabinet to be installed on the side of ffic controller cabinet as detailed on the <i>Contract Drawing</i> and lam Standard Detail Drawing SS-E7.24.
3.28	Illuminated Street Name Signs	Add 3.28.1		illuminated street name signs as detailed on the <i>Contract</i> og and Coquitlam Standard Detail Drawing SS-E5.18
		Add 3.28.2		nated street name signs shall be safety cabled to the traffic pole arm using 3/32" galvanized steel aircraft cable.
3.29	Emergency Vehicle Pre-emption	Add 3.29.1		ency vehicle pre-emption system to be installed as detailed on entract Drawing and Coquitlam Standard Detail Drawing SS-
		Add 3.29.2	provide	shall be continuous with a minimum of 2m of cable slack to be ed at each end, with no splices. Cabinet termination to be eted by City.
3.30	PTZ/CCTV Cameras	Add 3.30.1	Drawin	CTV cameras to be installed as detailed on the <i>Contract</i> or
		Add 3.30.2	provide	shall be continuous with a minimum of 2m of cable slack to be ed at each end, with no splices. Cabinet termination to be eted by City.
3.31	Radio Communications Equipment	Add 3.31.1	Contra	communications equipment to be installed as detailed on the act Drawing. Contact the City of Coquitlam's Traffic Operations rior to installation.
		Add 3.31.2	provide	shall be continuous with a minimum of 2m of cable slack to be ed at each end, and with no splices. Cabinet termination to be eted by City.
3.32	Owner Supplied Materials	Add 3.32.1		retained to complete the work must notify the City in writing) 7 days prior to the time materials are required.
		Add 3.32.2	make a of the	otherwise noted, those retained to complete the work will all necessary arrangements and pay all costs for the collection materials and for delivery to the <i>Place of Work</i> . They will e responsibility for materials at the time they are picked up.

Add 3.32.3

Owner supplied materials generally consist of the following:

- .1 Traffic controller equipment and cabinet.
- .2 Uninterruptable power supply equipment and cabinet.
- .3 Emergency pre-emption equipment.

The exact list of materials supplied by the Owner to be confirmed with the City of Coquitlam Traffic Operations staff and *Contract Administrator*. In the case of private development projects requiring City supplied materials, the cost for supply and installation of these materials will be borne by the Developer.

- .1 Fibre optic cables will be terminated to a twelve (12) port LC coupler panel.
- .2 When installing Fibre Optic Communications Conduit, Fibre optic warning tape (150 mm wide orange plastic tape labelled "WARNING FIBRE OPTIC COMMUNICATIONS CABLE") and Detectable (Magnetic) marker tape is to be placed over all conduits containing fibre optic cable.
- .3 During installation of new boxes or with all existing boxes ensure that they have been cleared of any soil, sand or gravel and other materials that have accumulated in the base of the junction box. Ensure that all empty conduits have a proper RPVC coupling and cap inserted (friction fit - DO NOT GLUE) into each duct. Once the conduit is populated, replace cap with bell coupling and glue in place.
- .4 All communication conduits will be flushed with water and dried with compressed air. This process will be followed by pulling through a suitable size Blowing Mouse, a clean soft cloth and new No. 8 HB Yellow/Green Mk pull string
- .5 Perform a visual inspection of the proposed cable route and be aware of any potential problem areas. Locations in which cables will be terminated must be inspected and plans made for hardware and cable slack storage. Space and access for termination of the cable should be considered prior to starting the job. Develop a cable placement plan based upon the cable route survey and your available equipment and personnel resources. Submit a plan to the City for acceptance prior to starting work.
- .6 Be aware that any damage due to excessive pulling, bending, or crushing, may alter the cable's transmission characteristics to the extent that the cable section will have to be replaced at the Project's expense.
- .7 Fibre optic cables will be installed in continuous runs in conduit between the traffic signal controller cabinets (no splices are allowed).
- .8 DO NOT EXCEED THE MINIMUM BEND RADIUS OF THE FIBRE. During installation do not exceed the minimum bend radius as specified by the manufacture.
- .9 DO NOT IMPROPERLY PULL OR EXCEED THE CABLE'S RATED PULLING TENSION as specified by the cable manufacturer. Excess pulling may not actually break the fibre, but it can cause the fibre attenuation to increase so that the installed system may not operate within the specified requirements.

3.33 Fibre Optic Cable Add 3.33

2025

TRAFFIC SIGNALS

- .10 DO NOT EXCEED THE VERTICAL RISE SPECIFICATION as specified by the cable manufacturer unless intermediate tension relief is used. Secure the cable to new or existing supports wherever possible.
- .11 Take precautions to protect reeled and unreeled cable from any source of damage, whether attended or unattended. Be particularly careful with pre-connected sections of cable produced to meet specific length requirements as any damage to the cable may require replacement of the entire section.
- .12 If the cable must be unreeled during installation, the "figure--eight" configuration should be used to prevent kinking or twisting. Do not coil the cable in a continuous direction except for lengths of 30 meters or less. The preferred size of the "figure-eight" is about 4.5 meters in length, with each loop about 1.5 meters to 2.4 meters in diameter.
- .13 If a cable puller is used, ensure that the recommended pulling tension of the cable is not exceeded. Do not pull through junction boxes, especially 90-degree conduit fittings, unless precautions are taken to maintain the minimum bend radius.
- .14 When installing cable in conduits, ensure the conduit does not exceed the minimum bend radius. Avoid pull boxes unless the maximum bend radius can be maintained. In controller cabinets, fibre optic cables will be tied together with ty-wraps. Each cable will be labelled within 10 cm of the terminated ends with a tag and text stating the street intersection of the opposite cable end. Cables will be tagged in the controller cabinet and all other access points with "CAUTION, FIBRE OPTIC CABLE" tags. Leave enough cable slack at termination points to allow the cable to be routed through the termination hardware to a polishing/splicing table, plus a minimum of 3 meters additional slack. Cable slack will be coiled and secured with Velcro ties for breakaway protection. Cable to termination panel will be secured to cabinet with ty-wraps
- .15 If cable lubricants are necessary, ensure that they are compatible with the cable's outer sheath. Refer to the lubricant specification sheet to ensure compatibility. In all cases avoid the use of detergent-based lubricants, as these types of lubricants promote stress cracks.
- .16 Excess cable inside pull boxes will be coiled and mechanically secured in place with Velcro straps such that the minimum bend radius is not exceeded and the cable is suspended above the pull box. The Velcro straps are to provide `breakaway' protection in the event of an accidental dig-up between pull boxes.
- .17 Adhesive warning labels 3M 5016 FO type or accepted alternate will be affixed to each fibre optic cable in each access point. Access points include pull boxes and traffic signal controller cabinets. Decal strip holders, 3M 5012 or accepted alternate, will be used and will be secured in place using cable ties. Warning labels will be oriented so they are visible and are not blocked by other cables or equipment.
- .18 After installation, each segment of each fibre will be tested using an Optical Time Domain Reflectometer (OTDR) and power meter equipment. Testing will be done in each direction on each fibre and at both 1310nm and 1550nm wavelengths. Launch cable will

SUPPLEMENTARY
CONTRACT
SS 68
SPECIFICATIONS
TRAFFIC SIGNALS
SECTION 34 41 13S

be used as per the OTDR manufacturer's specifications. Those retained to complete the work will provide a report detailing the results of each test including OTDR test results in graphical format, cable length, any fibre breaks or anomalies, attenuation of fibre's, connectors and fibre uniformity.

.19 Final testing and inspection of the cable installation will be conducted with the City on-site.

Appendix A -

Traffic Management Detail Specifications

Spec	ic Management Detail ifications			
Cont	ract 78035A		TRAFFIC MANAGEMENT	TMP
1.0	GENERAL	.1	This Traffic Management detail specification refers to the Contrappecific plans to identify project traffic risks affecting the <i>Work</i> , Traffic Control Plans, and to implement the traffic control for the passage of vehicles and pedestrian through the work zone.	provide
1.1	Related Works	.1	Traffic Control, Vehicle Access and Parking MMCD Section 01 55	5 00S.
1.2	References	.1	WorkSafe BC, Occupational Health and Safety (OHS) Regulation 18 – Traffic Control.	, Section
		.2	B.C. Ministry of Transportation and Transit (MOTT) Traffic Mana Manual for Work on Roadways.	igement
1.3	Project Requirements	.1	A Road and Sidewalk Closure Permit is required by Coquitlam for affecting traffic flow related to construction. A permit is require each specific construction interference with traffic flow. The Ro Sidewalk Closure Permit Request form is attached as Appendix document. A digital copy of the Road and Sidewalk Closure Permit can be obtained for use during the contract from the City's web	ed for ad and 1 to this nit form
			A Road and Sidewalk Closure Permit form application must be s to City's Traffic Operation Division 10 working days prior to star	
1.4	Measurement and Payment	.1	For this Contract, all work associated with Traffic Management (TMP) and Traffic Control will be as shown in the Schedule of Quand Prices.	
2.0	PRODUCTS			
2.1	Traffic Management Plan (TMP)	.1	The Contractor is required to assign a Traffic Manager for the C with the responsibility of preparing the Traffic Management Pla Traffic Control Plans, as well as the responsibility for continuing implementation of traffic control for the Work.	an and the
		.2	The Traffic Management Plan (TMP) will consist of the following components: .1 Category identification through risks and project categor assessment as per MOTI Traffic Management Manual for Roadways; .2 Traffic Control Plans for individual stages of the construct. 3 Incident Management Plan for the response to an unplar event and recording of incident information; .4 Category 3 TMP must be signed and sealed by a qualified Professional Engineer.	ry r Work on ction; nned
		.3	Submission of the TMP is to be made to the <i>Contract Administra</i> within five (5) days of the <i>Notice of Award</i> of the <i>Contract</i> , and rapproved by the <i>Contract Administrator</i> prior to start of the <i>Wo</i>	must be
		.4	Review of the TMP will be performed by the Contract Administr Comments for revisions to the TMP will be returned to the <i>Traff</i> <i>Manager</i> for implementations.	

- .5 The Contractor shall comply with all the requirements of applicable laws, rules, regulations, codes and orders of the municipal and other appropriate authorities concerned with work on streets or highways and shall post proper notices and/or signals, and provide necessary barriers, guards, lights, flagmen or watchmen as may be necessary for proper maintenance of traffic and protection of persons and property from injury or damage. All costs involved in respect to the above requirements will be deemed to be included in the Contract Price.
- .6 The Contractor, during the progress of the work, shall make adequate provision to accommodate the normal traffic along streets and highways immediately adjacent to or crossing the work so as to cause the minimum of inconvenience to the general public.
- .7 The Contractor is required to maintain local traffic and driveway access during all stages of construction. This includes maintaining a 1.5m width walkway or pathway through the construction site for pedestrians.
- 8 Where existing streets or roads are not available as detours, all traffic shall be permitted to pass through the work with as little inconvenience and delay as possible unless otherwise provided or authorized by the Contract Administrator. If half the street only is under improvement, the other half shall be conditioned and maintained as detour.
- 2.2 Incident Management and Reporting
- .1 The Contractor shall facilitate incident response vehicles and staff and move traffic safely and expeditiously through or around an incident on site and provide assistance to emergency response personnel as required. An incident includes, but is not limited to, motor vehicle accidents, emergency road repairs, disabled vehicles, and debris on the road. The immediate response to an emergency shall by necessity make use of available devices and equipment.
- .2 If an incident occurs on site, the Contractor will be required to submit a report to the Contract Administrator documenting details of the incident including event, location, date, time, action taken, duration and restoration of site.
- 2.3 Traffic Control Plans
- .1 The Contractor shall designate a qualified Traffic Control Supervisor for the works, per the requirements of WCB regulations Section 18.

The designated Traffic Control Supervisor may be the same individual that is designated as the Traffic Manager, or may be a separate individual qualified for the responsibilities of this function.

- .2 The Contractor shall prepare weekly the anticipated traffic control activities, locations, and durations for the upcoming week.
- Permissible delays shall only be considered outside Peak Hours. Permissible delays are categorized as follows:
 - a) Minor Delays Less than two (2) minutes in duration; for occasional interruption due to construction activities. These delays shall be coordinated with available breaks in the traffic flow.

Traffic Management
Detail Specifications
Contract No. 78035A

TRAFFIC MANAGEMENT

TMP 3

- b) Major Delays Maximum five (5) minutes in duration; for occasional interruption of traffic for construction activities if traffic volumes permit.
- .4 The Contractor is responsible for ensuring that the flow of traffic is unimpeded by construction-related activities.

3.0 EXECUTION

- 3.1 Traffic Control Plan
- .1 A copy of the approved <u>current</u> Traffic Plan and Road and Sidewalk Closure Permit must be held on site by both the Site Superintendent as well as the person/company responsible for the traffic control implementation.
- .2 Failure to produce a valid approved Traffic Plan on site, or having work not follow the Traffic Control Plan will result in immediate shut-down of the work. The Contractor will be required to safely restore facility conditions to allow traffic flow at their expense. The Contractor must take all steps to acquire an approved Traffic control Plan before work can re-start on site. No claim will be accepted by the Owner for costs associated with this work shut-down.
- 3.2 Traffic Control Personnel & Equipment
- .1 The Contractor shall supply all necessary traffic control devices required to perform traffic control services for the project. Signs and traffic control devices not applying to existing conditions shall be removed. Where operations are carried out in stages, only those traffic control devices that apply to the current stage are to be left in place.
- There must be sufficient Traffic Control Persons (TCPs) on site to appropriately and safely direct traffic in all sections of the Work.

3.3 Signage

Supply, installation, maintenance and removal of all works-related signs shall be the responsibility of the Contractor. The location and type of each sign shall be indicated on the approved Traffic Control Plan, for each stage of the works.

Traffic control signs and devices must be positioned and used as specified in the Traffic Control Plan and signs and devices must be located so as to allow traffic to move by or through the work area in a controlled manner and, if necessary, to come to a controlled stop with due regard for the prevailing weather and road conditions.

Signs shall be checked daily for legibility, damage, suitability and location. Signs and delineators shall be cleaned as frequently as necessary to ensure full legibility and reflectance.

3.4 Detours

Any proposed detours must be approved by the Contract Administrator and conducted in accordance with the approved Traffic Plan and the Traffic Control Manual for Work on Roadways.

Traffic Management Detail Specifications						
Cont	ract No. 78035A	TRAFFIC MANAGEMENT	TMP 4			
3.5	Abrupt Changes in Surface Elevations	The Contractor shall minimize any abrupt changes in roadway ele exposed to traffic during both working and non-working hours.	evation left			
		The use of road plates to cover excavations and restore travel land permitted in late Fall, Winter or if forecast indicates temperature 2 degrees Celsius, unless otherwise permitted by the Contract Ad	equal or below			
		Where construction necessitates the use of road plates, the Contresponsible for properly securing them (either pinned or recessed pavement) and a wedge of asphalt must be used as a transition to differences in travelled areas and have a slope of 4:1 or less. The Cresponsible for repairing any pavement damage related to the plate.	into the o vertical Contractor is			
3.6	Cyclist and Pedestrian Access	The Contractor shall make provision for pedestrians, wheel chairs and bicycles to have safe access across the work zone at all times. If this cannot be readily accommodated then acceptable detours and appropriate signs shall be provided.				
3.7	Temporary Pavement Markings	The Contractor shall be responsible for the application and removal of all temporary pavement markings and reflective devices.				
		All temporary markings must be removed after installation of permanent markings.				
4.0	TRAFFIC RESTRICTIONS					
4.1	Road and Sidewalk Closure Permits	.1 A Road and Sidewalk Closure Permit is required for each in be valid for a maximum period of one (1) week and, if still Road and Sidewalk Closure Request is required. The permit project.	necessary, re-submitta			
		A copy of the approved Road and Sidewalk Closure Permit both the Site Superintendent and the person/company res control implementation.				
		.2 Contractor to refer to Clause 5.2 Road Specific Consideration	ons below.			
		.3 Detours will only be permitted as approved by the Contrac have a complete Traffic Control Plan indicating detour rou Detours will not be allowed without sufficient lead time for operation to react appropriately to detour information pro	te, signing, and duration reta			
4.2	Lane Closure Restrictions	.1 For each of the road sections affected:				

- Road and Sidewalk Closures will be reviewed for appropriateness during the allowable hours of work.
- Access to properties to be maintained
- Sufficient Traffic Control Persons are required for each Road and Sidewalk Closure (or any work activities), including side street intersections, to safely guide traffic through the work site.
- 4.3 Hours of Work
- .1 Refer to Clause 5.2
- 2 Some allowances may be made for paving operations, depending on a proposal acceptable to the Contract Administrator.

These supplementary Specifications must be read in conjunction with the Master Municipal Specifications contained in the Master Municipal Construction Documents (Platinum), Volume II, 2009.

4.4 LIQUIDATED DAMAGES
FOR NON-COMPLIANCE
TO TIME OF DAY
RESTRICTIONS

All lanes of traffic must be opened to traffic on or before the designated restricted hours and schedule. An amount of **\$1,500.00** per **15**-minute delay beyond the restricted hours and schedule specified in Clause 5.2, unless otherwise approved in writing by the Contract Administrator, shall be deducted by the Owner from any monies owing to the Contractor for the work.

5.0 CONSTRUCTION OPERATIONS

- 5.1 Truck Routes
- .1 The Contractor is restricted to the City's designated Truck Routes. The current Truck Route Map is available on the City's website at https://www.coquitlam.ca/171/Trucks-Goods.
- 5.2 Road Specific Considerations
- .1 Ensure that Traffic Management Plan accommodates businesses and residences during construction activities.
- . 2 The Work is to be completed overnight only. The Contractor is responsible for coordinating with the Contract Administrator and City Traffic Operations immediately after Notice to Proceed to discuss the Traffic Management Plan. Road closures for Mariner Way and the bus depot transit ramp are restricted to the following hours.


	ALLOWARIE TIME	
LOCATION	ALLOWABLE TIME (includes set-up and take down)	COMMENTS
		Minimum 1-lane traffic in each direction must be maintained. Pedestrian traffic must be rerouted to use controlled road crossings.
Mariner Way Overpass	Monday to Saturday 9:00PM to 6:00AM	All sidewalks and traffic lanes must be reopened during the day in safe conditions. Steel road plates can be installed over trenches, where permitted by the Contract Admnistrator, and the Contractor must provide asphalt ramps to plates (per Clause 3.5) and speed control/uneven surface warning signage.
Transit Ramp	Monday to Saturday 8:00PM to 5:00AM	Full ramp closure permitted. Contractor must inform CMBC, immediately after Notice to Proceed, and provide detour signage for inbound/outbound traffic to utilize accesses on Barnet Hwy and Lougheed Hwy.
		Access to Park-And-Ride Lots and Rona Business must be maintained at all times.
Park-And-Ride Access Road (Off Mariner Way, adjacent to Rona)	Monday to Saturday 9:00PM to 6:00AM Or	Day shift hours may be approved at the sole discretion of the Contract Administrator.
(On Mariner way, aujacent to Kona)	Day Shift 7:00AM to 7:00PM As needed	No-post barriers at driveway accesses may be temporarily relocated, reinstated in exact location, and edge of road protected, at Contractor's expense.

These supplementary Specifications must be read in conjunction with the Master Municipal Specifications contained in the Master Municipal Construction Documents (Platinum), Volume II, 2009.

Deta	ic Management Il Specifications ract No. 78035A	TRAFFIC MANAGEMENT	TMP 6
5.3	Work stoppage due to traffic	The City will not control or direct traffic control activities of the C require an immediate stop to any work where, in the sole opinior Administrator, the provided traffic management plan is ineffecti	of the Contract
5.4	Construction Activity and Signage	The Contractor will be responsible to place other construction information signs as required to inform the public of constructio activities, and ensure safe travel through the work site.	n
5.5	Changeable Message Sign (CMS) Board	The following locations will require Changeable Message Signs (Control of the project: 1. Eastbound on Mariner Way at Dewdney Trunk Rd 2. Southbound on Johnson St at Conley Cres 3. Eastbound on Barnet Hwy at Aberdeen Ave 4. Westbound on Barnet Hwy, East of Johnson St	
		Exact locations to be discussed at the pre-construction meeting to be in service at least five normal work days prior to construct advance warning to motorists. CMS must be able to handle min page/screen.	ion start to provide
5.6	Construction Zone Information Signs	The Contractor is required to provide, one week prior to start of vinform traffic of existing and anticipated conditions.	vork, stationary signs
		Ensure that signs and locations are addressed in the Traffic Mana to be located at least 3m away from any travelled roadway edge sidewalk or travelled shoulder edge with minimum head clearand be removed at the end of the construction period on each location	and 0.6m away from ce of 2m. All signs are
		Exact locations to be determined on site by Contract Administrat • Southbound, Northwest corner of Mariner Way and Dev	

- Southbound, Northwest corner of Mariner Way and Dewdney Trunk Rd
- Northbound, Southeast corner of Dewdney Trunk Rd and Dacre Ave
- Westbound, bottom of Transit Ramp

Construction Zone Information Signs to follow specifications below. Draft must be submitted to Contract Administrator prior to sending to production:

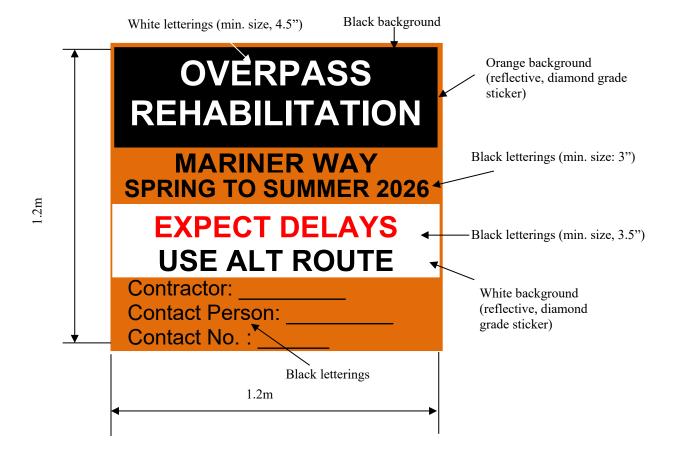

Traffic Management Detail Specifications Contract No. 78035A

TRAFFIC MANAGEMENT

TMP 8

APPENDIX 1

Coquitlam

City of Coquitlam Road and Sidewalk Closure Permit Request

Traffic and Street Use Management Section

3000 Guildford Way, Coquitlam BC V3B 7N2

Phone: 604-927-6250 Email: StreetPermits@coguitlam.ca

Initial Permit: \$150 🗆 Renewal Permit: \$75 🖯	
Application Date: City	Project or Film Permit Number (if applicable): 78035A
 An Initial Permit is required for all new appl traffic controls change from what was appreminimum of 10 business days prior to the in A Renewal Permit extends the rights and principles. 	lications and when the location, type of work, or the type of oved for the Initial Permit. The application needs to be received a
Development Site Address (if applicable):	
Work location (street name, block number, to/fro	m, at, etc.)
Contact Information	
Applicant Company Name:	
Applicant (person completing application form)	
Name:	Title:
Phone:	Email:
Applicant's Signature:	
Company Name (Prime Contractor):	
Site Superintendent	
	Title:
Phone: Mobile:	Email:
Permit Information	
Start Date: End Date:	
	rednesday □ Thursday □ Friday From: 00:00 To: 00:00
Specific Lanes: ☐ Curb ☐ Inside/Centre Lane ☐ All Lanes ☐ Sidewalk/MUP	□ Left Turn Lane □ Right Turn Lane □ Parking Lane □ Bicycle Lane
Direction : ☐ Northbound ☐ Southbound ☐ W	Vestbound □ Eastbound
Purpose of Work: ☐ Concrete Pour ☐ Utility Ins	tallation Curb Installation Other
This permit is related to: ☐ City Design and Cons☐ Development ☐ Ex	struction City Parks External Environmental cternal/Utilities
City Contact (if applicable):	
Office Use Only	
Permit Conditions/Comments:	
Approved by	Date

These supplementary Specifications must be read in conjunction with the Master Municipal Specifications contained in the Master Municipal Construction Documents (Platinum), Volume II, 2009.

Traffic Management
Detail Specifications
Contract No. 78035A

TRAFFIC MANAGEMENT

TMP 9

Application Checklist
The following information must be provided. Incomplete applications will not be reviewed.
1. ☐ Traffic Management Plan (TMP); OR
☐ Traffic Management Manual for Work on Roadways Figure Number:
2. Project Category Determination (per 2020 Traffic Manual for Work or Roadways).
☐ Initial Project Category Assessment
☐ Project Risk Analysis ☐ Category 1 ☐ Category 2 ☐ Category 3
3. Prime Contractor Designation Letter
4. □ City of Coquitlam Certificate of Insurance
 5. □ Notification Letter and Map (required for all full road closures). A Notification Letter must be provided to all affected residents and businesses. □ Yes □ No □ Not Applicable
6. Traffic Control Persons (flag persons) required? All operations within the road right-of-way must comply with WorkSafe BC regulations and BC Ministry of Transportation standards for work on roadways. Yes No If yes, how many?
7. Bus routes/stops impacted? Applicant is to contact Coast Mountain Bus Company (with a minimum of 3 days' notice) <u>Temporary Transit Changes Request Form</u> . General information can be found by visiting <u>Temporary Transit Changes</u> .
8. City of Coquitlam Solid Waste has been contacted? Coquitlam Environmental Services contacted regarding impact to garbage/recycling routes and pick up Phone: 604-927-4300 Email: wastereduction@coquitlam.ca Yes No
Are operations impacted? □ Yes □ No If Yes:
 a plan to ensure continuous collection has been provided: Yes No Day(s) of the week impacted: p.m. Time(s) of the day impacted: p.m.
 Pedestrian / Bike Lanes impacted? Please describe sidewalks and/or bicycle facilities that will be impacted by the proposed work.
10. Is the work on, or will it impact a road along our Major Road Network? Yes No

Additional information

- Only vehicles actively engaged in the performance of cleaning, clearing, maintenance, repair, construction or
 other work are permitted within work zones. Vehicles being used by Superintendents, Traffic Control Persons,
 and other construction personnel that are not actively engaged in work described above are not permitted
 within the work zone and are not permitted parking /stopping prohibitions.
- Closures of sidewalks, cycling facilities, lanes, and full road closures are only permitted during the time periods
 indicated on the approved permit. Traffic controls are not permitted outside of these approved permit hours.

Appendix B - As-builts

STRUCTURAL AS-BUILT





PROVINCE OF BRITISH COLUMBIA
MINISTRY OF TRANSPORTATION AND HIGHWAYS

PROJECT No. 05854

MARINER WAY

JOHNSON - MARINER CONNECTOR

IMPORTANT:

HYDRO, GAS AND TELEPHONE **ARE NOT LOCATED** ON THE CITY OF COQUITLAM AS-BUILTS.

CONTACT BC HYDRO, TERASEN GAS AND TELUS FOR CURRENT AS-BUILTS PERTAINING TO THESE UTILITIES.

NOTE:

LOCATION OF EXISTING UTILITIES SHOWN ARE
APPROXIMATE ONLY AND SHOULD BE CONFIRMED BY A
PIPE LOCATOR AND MANUAL DIGGING. ALL OR ANY
EXISTING STRUCTURES ARE NOT NECESSARILY SHOWN.

THIS PHOTOCOPY IS SUPPLIED BY THE CITY OF COQUITLAM FOR GENERAL INFORMATION ONLY AND THE ACCURACY OF INFORMATION CONTAINED ON THE DOCUMENT IS NO WAY GUARANTEED BY THE CITY.

DRAWING LIST

DWG. No.	DESCRIPTION	REV.	DATE
2927-100	KEY MAP AND DRAWING LIST	Α	SEPT. 96
2927-101	SITE PLAN	Α	SEPT. 96
2927-102	PROFILE	A	SEPT. 96
2927-103	MAIN BRIDGE GENERAL ARRANGEMENT	D	SEPT. 96
2927-104	EAST RAMP GENERAL ARRANGEMENT	C	SEPT. 96
2927-105	SOUTH ABUTMENT	М	SEPT. 96
2927-106	SOUTH ABUTMENT REINFORCING DETAILS	G	SEPT. 96
2927-107	SOUTH ABUTMENT APPROACH SLAB	C	SEPT. 96
2927-108	SOUTH ABUTMENT END FILL AND PAVING	F	SEPT. 96
2927-109	NORTH ABUTMENT SHT. 1	D	SEPT. 96
2927-110	NORTH ABUTMENT SHT. 2	D	SEPT. 96
2927-111	NORTH ABUTMENT REINFORCING DETAILS	D	SEPT. 96
2927-112	NORTH ABUTMENT APPROACH SLAB	D	SEPT. 96
2927-113	NORTH ABUTMENT WINGWALL DETAILS	D	SEPT. 96
2927-114	EAST ABUTMENT DETAILS SHT. 1	Н	SEPT. 96
2927-115	EAST ABUTMENT DETAILS SHT. 2	D	SEPT. 96
2927-116	EAST ABUTMENT REINFORCEMENT DETAILS	E	SEPT. 96
2927-117	PLAN AND PILING LAYOUT	Ε	SEPT. 96
2927-118	PILING SCHEDULE No. 1	F	SEPT. 96
2927-119	PILING SCHEDULE No. 2	Ε	SEPT. 96
2927-120	INTERMEDIATE SUPPORT DETAILS	F	SEPT. 96
2927-121	RAIL SPAN	Ε	SEPT. 96
2927-122	SOUTH END DECK DETAILS SHT. 1	F	SEPT. 96
2927-123	SOUTH END DECK DETAILS SHT. 2	G	SEPT. 96
2927-124	PIER REINFORCING DETAILS SHT. 1	G	SEPT. 96
2927-125	PIER REINFORCING DETAILS SHT. 2	D	SEPT. 96
2927-126	NORTH END DECK DETAILS SHT. 1	J	SEPT. 96
2927-127	NORTH END DECK DETAILS SHT. 2	E	SEPT. 96
2927-128	NORTH END DECK DETAILS SHT. 3	E	SEPT. 96
2927-129	EAST RAMP DECK DETAILS SHT. 1	D	SEPT. 96
2927-130	EAST RAMP DECK DETAILS SHT. 2	D	SEPT. 96
2927-131	EAST RAMP DECK DETAILS SHT. 3	С	SEPT. 96
2927-132	EXPANSION JOINT DETAILS	D	SEPT. 96
2927-133	SUPERSTRUCTURE PRECAMBER	С	SEPT. 96
	l l		

DRAWING LIST

DWG. No.	DESCRIPTION	REV.	DATE
2927-134	MISCELLANEOUS DETAILS SHT. 1	Н	SEPT. 96
2927-135	MISCELLANEOUS DETAILS SHT. 2	D	SEPT. 96
2927-136	MISCELLANEOUS DETAILS SHT. 3	Ε	SEPT. 96
2927-137	MISCELLANEOUS DETAILS SHT. 4	Ε	SEPT. 96
2927-138	MISCELLANEOUS DETAILS SHT. 5	В	SEPT. 96
2927-139	DECK CONSTRUCTION SEQUENCE SHT.	1 A	SEPT. 96
2927-140	DECK CONSTRUCTION SEQUENCE SHT.	2 A	SEPT. 96

STANDARD MINISTRY DRAWINGS

DWG. No.	DESCRIPTION	REV.	DATE
2784-1	STANDARD BRIDGE PARAPET	Ň	
2784-2	TRANSITION	G	,
2785-2	COUGARAIL	A	



AUG 0 7 199

_						
		ASSOCIATED ENGINEERING			rovince of British ISTRY OF TRANSPORTATION BRIDGE ENGINEERING	AND HIGHWAYS
\$	CALE AS	NOTED DESIGNED D.I.H. CHECKED D.I.H. DRAWN 8.F.	DATE DEC. 95 DATE DEC. 95 DATE DEC. 95		SOUTH COAST REGION MARINER WAY OVERHEAD	
Rev	Date	Description	init	JOHNSON MA	ARINER CONNECT	OR NO 2927
A	SEPT.96	AS CONSTRUCTED			AP AND DRAWN	
)		PREPARED BY	RECOMMENDED -	ACCEPTED FOR CONSTRUCTION
				DATE	DIRECTOR OF BIRDGE ENGINEERING DATE	CHIEF INGHILLY ENGINEER
	L	REVISIONS		/ FILE No.	NEGATIVE No. REI	2927-100 A

 \oplus

LOCATION MAP

JOHNSON-MARINER CONNECTOR

 \oplus

6


 \oplus

CANCEL PRINTS BEARING PREVIOUS (LETTER

L-LINE
Rc1 275.000
Rc2 350.000
Δ 54'29'11.6"
Δc1 20'00'00.0"
Δ.0. 172.16'7; (BACK)
A.D. 190.096 (AHEAD)
Arc1 95.993
Arc2 170.894
P.I. 6+63.246 | L-100 | Rc | 475.000 | Δ | 21°11'00" | Tc | 88.820 | Arc | 175.6166 | 20 | Ec | 8.233 | P.I. | 107+69.887 | E | 1077-741 | 1777-741 | 1777-741 | 1 STA. 5+90.801 O/S. 16.543 - P.I. 302+50.822 [**1923-42] - E.C. 108+56.683[**433-42] = L-P.O.I. 8+55.635 o/s 8.3m Rt. LUMBERLAND STA. 6+80.000 STA. 8+39.879 O/S. 18.064 L-LINE STA Ls 35 Os 2'51'53.2" STA. 7+37.692 0/S. 22.300 57.801302 STA. 5+91.341 O/S. 12.934 STA 7+81 250 0/8 18.634 Rt. STA 202+24.782 0/s 6.640 Rt. E.C. 301+85.821 L-B.C. 9+1/2.803 B.C. 301+39.991 L-E.C. 9/-35.959 \oplus E.C. P.O.T. 301+00.000 -STA. 8+60.000 0/S. 29.000 L=300 (A) (L=3α)
Rc 30.000 Rc
Δ 86'\$7'21'8" Δ
Τc 28.447 Τc
Αrc 48.530 Arc
Ec 11.343 Ec
P 301+68.436 P.J. 150,000 5'46'14-2' 7.360 15:107 0.190 302 +50.882 STA. 8+90.000 0/S. 27.000 **IMPORTANT:** HYDRO, GAS AND TELEPHONE ARE NOT LOCATED ON THE CITY OF COOUTLAM AS-BUILTS. CONTACT BC AYORO, TERASEN GAS AND TELUS FOR CURRENT AS-BUILTS PERTAINING TO THESE UTILITIES. NOTES: Φ. 1. SURVEY BY : M.O.T.H 2. DATE : 1987 - 1991 3. DATUM : GEODETIC LOCATION OF EXISTING UTILITIES SHOWN ARE H0013-01 APPROXIMATE ONLY AND SHOULD BE CONFIRMED BY A PIPE LOCATOR AND MANUAL DIGGING. ALL OR ANY Province of British Columbia MINISTRY OF TRANSPORTATION AND HIGHWAYS EXISTING STRUCTURES ARE NOT NECESSARILY SHOWN BRIDGE ENGINEERING BRANCH DESIGNED D.I.H. DATE JAN. 98
CHECKED D.I.H. DATE JAN. 98
DRAWN C.C. DATE JAN. 98 SCALE AS NOTED SOUTH COAST REGION THIS PHOTOCOPY IS SUPPLIED BY THE CITY OF COQUITLAM FOR MARINER WAY OVERHEAD ey Dote JOHNSON MARINER CONNECTOR NO GENERAL INFORMATION ONLY AND THE ACCURACY OF SEPT.96 AS CONSTRUCTED 4.0 SITE PLAN INFORMATION CONTAINED ON THE DOCUMENT IS NO 201+00.000 WAY GUARANTEED BY THE CITY. "你说 REVISIONS

PROFILE OF L-LINE - MARINER WAY

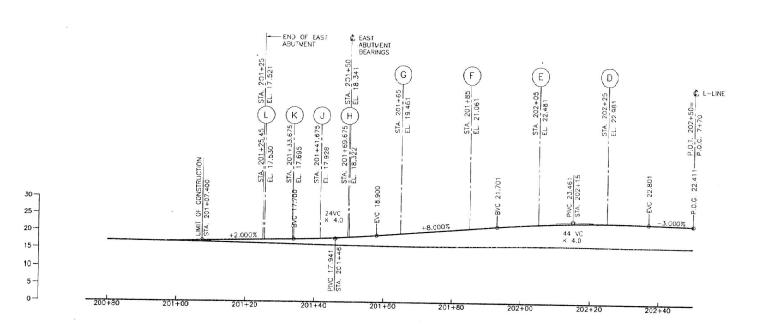

PROFILE OF L-200 - B.C. TRANSIT EXIT RAMP

IMPORTANT:

HYDRO, GAS AND TELEPHONE **ARE NOT LOCATED** ON THE CITY OF COQUITLAM AS-BUILTS.

CONTACT BC HYDRO, TERASEN GAS AND TELUS FOR CURRENT AS-BUILTS PERTAINING TO THESE UTILITIES.

NOTE:

LOCATION OF EXISTING UTILITIES SHOWN ARE
APPROXIMATE ONLY AND SHOULD BE CONFIRMED BY A
PIPE LOCATOR AND MANUAL DIGGING. ALL OR ANY
EXISTING STRUCTURES ARE NOT NECESSARILY SHOWN.

THIS PHOTOCOPY IS SUPPLIED BY THE CITY OF COQUITLAM FOR GENERAL INFORMATION ONLY AND THE ACCURACY OF INFORMATION CONTAINED ON THE DOCUMENT IS NO WAY GUARANTEED BY THE CITY.







	ASSOCIATED ENGINEERING	A	**************************************		Province of Brit	TION	AND HIGHWAYS
SCALE Rev Dot A JUL	Description	OESIGNED O.L.H. CHECKED O.L.H. DRAWN C.C.	DATE JAN. 96 DATE JAN. 96 Init	JOHNSON	SOUTH COAST REGI MARINER WAY OVERH MARINER CONNE PROFILE	EAD	OR NO. 2927
				PREPARED BY	RECOMMENDED		ACCEPTED FOR CONSTRUCTION
_				DATE	DIRECTOR OF BRIDGE ENGINEERING DATE		CHIEF HIGHWAY ENGINEER
SCHOOL STATE AND	REVIS	0 N S		FILE No.	NEGATIVE No.	REG.	2927-102 A

CANCEL PRINTS BEARING PREVIOUS LETTER

 \oplus

 \oplus

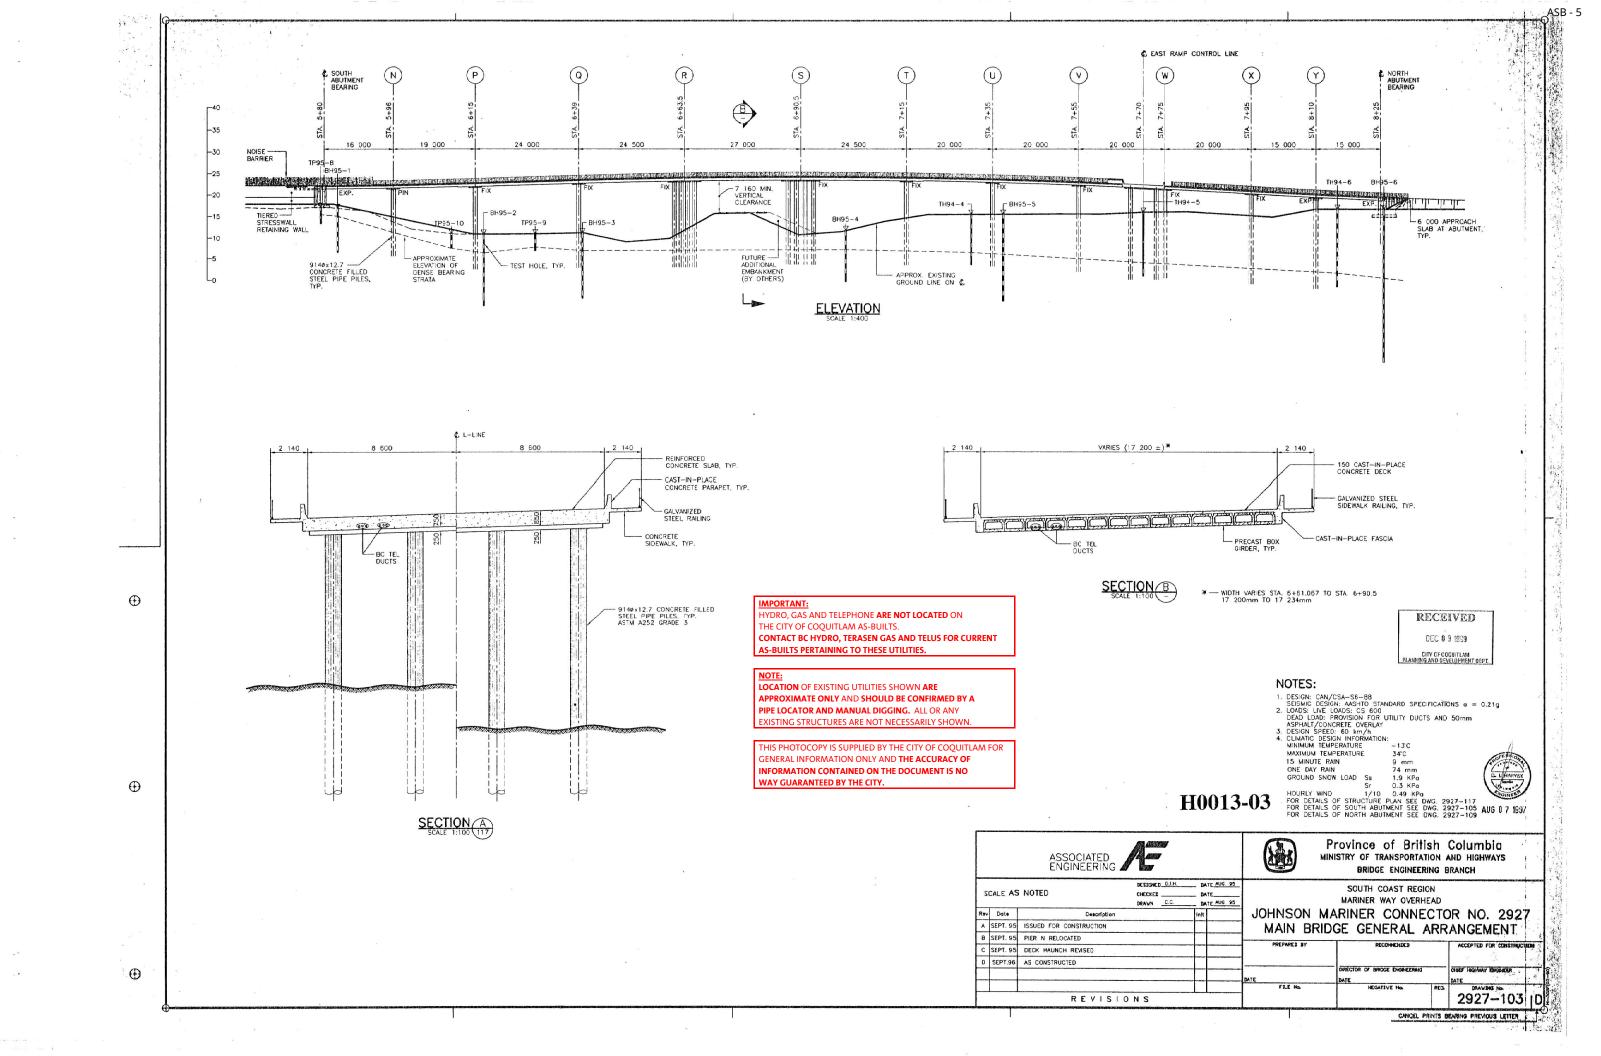


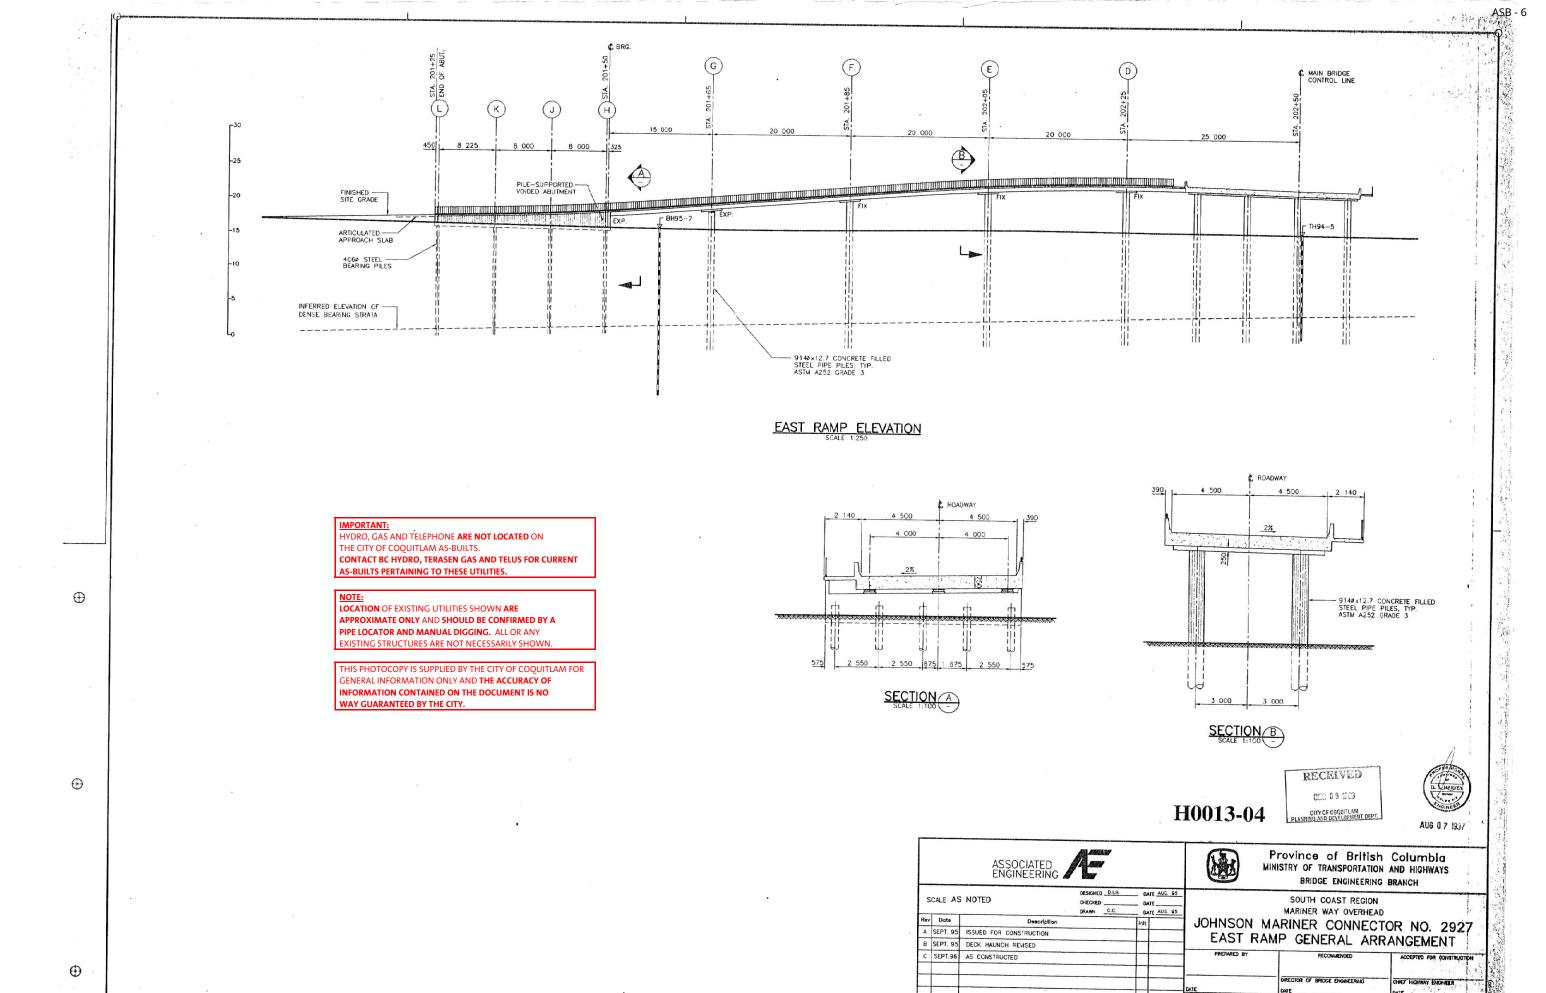



CANCEL PRINTS DEMENO PREVIOUS LETTER


2927-104


REVISIONS

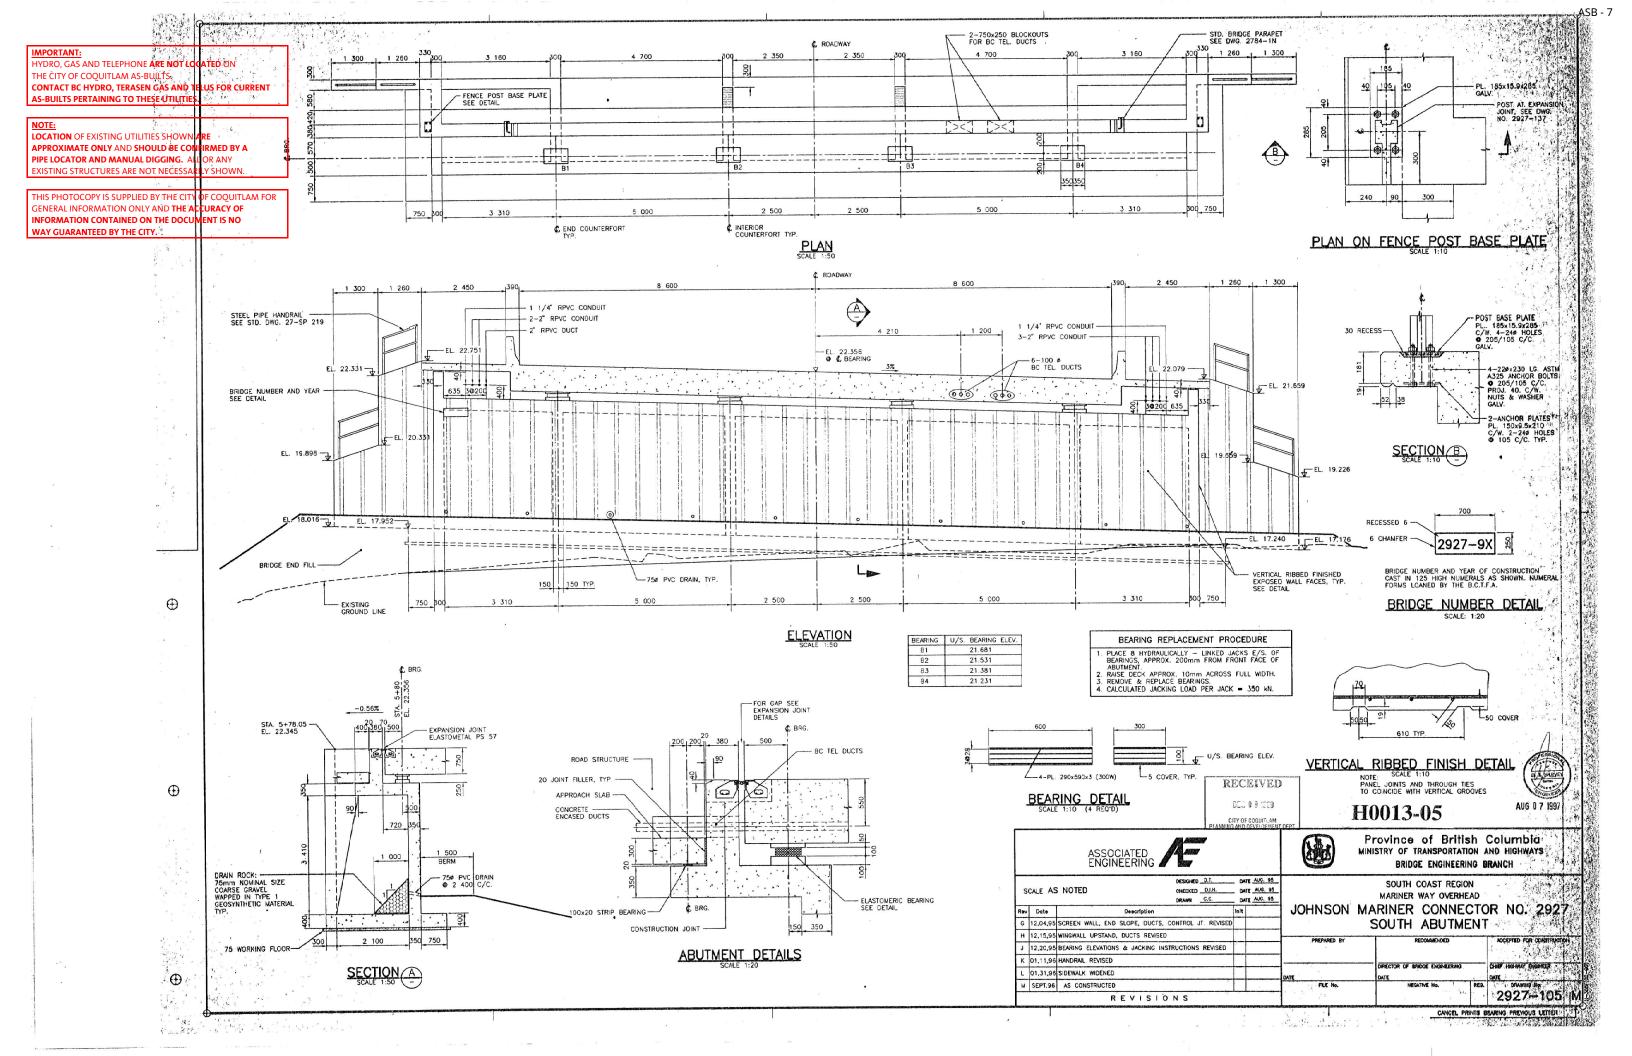


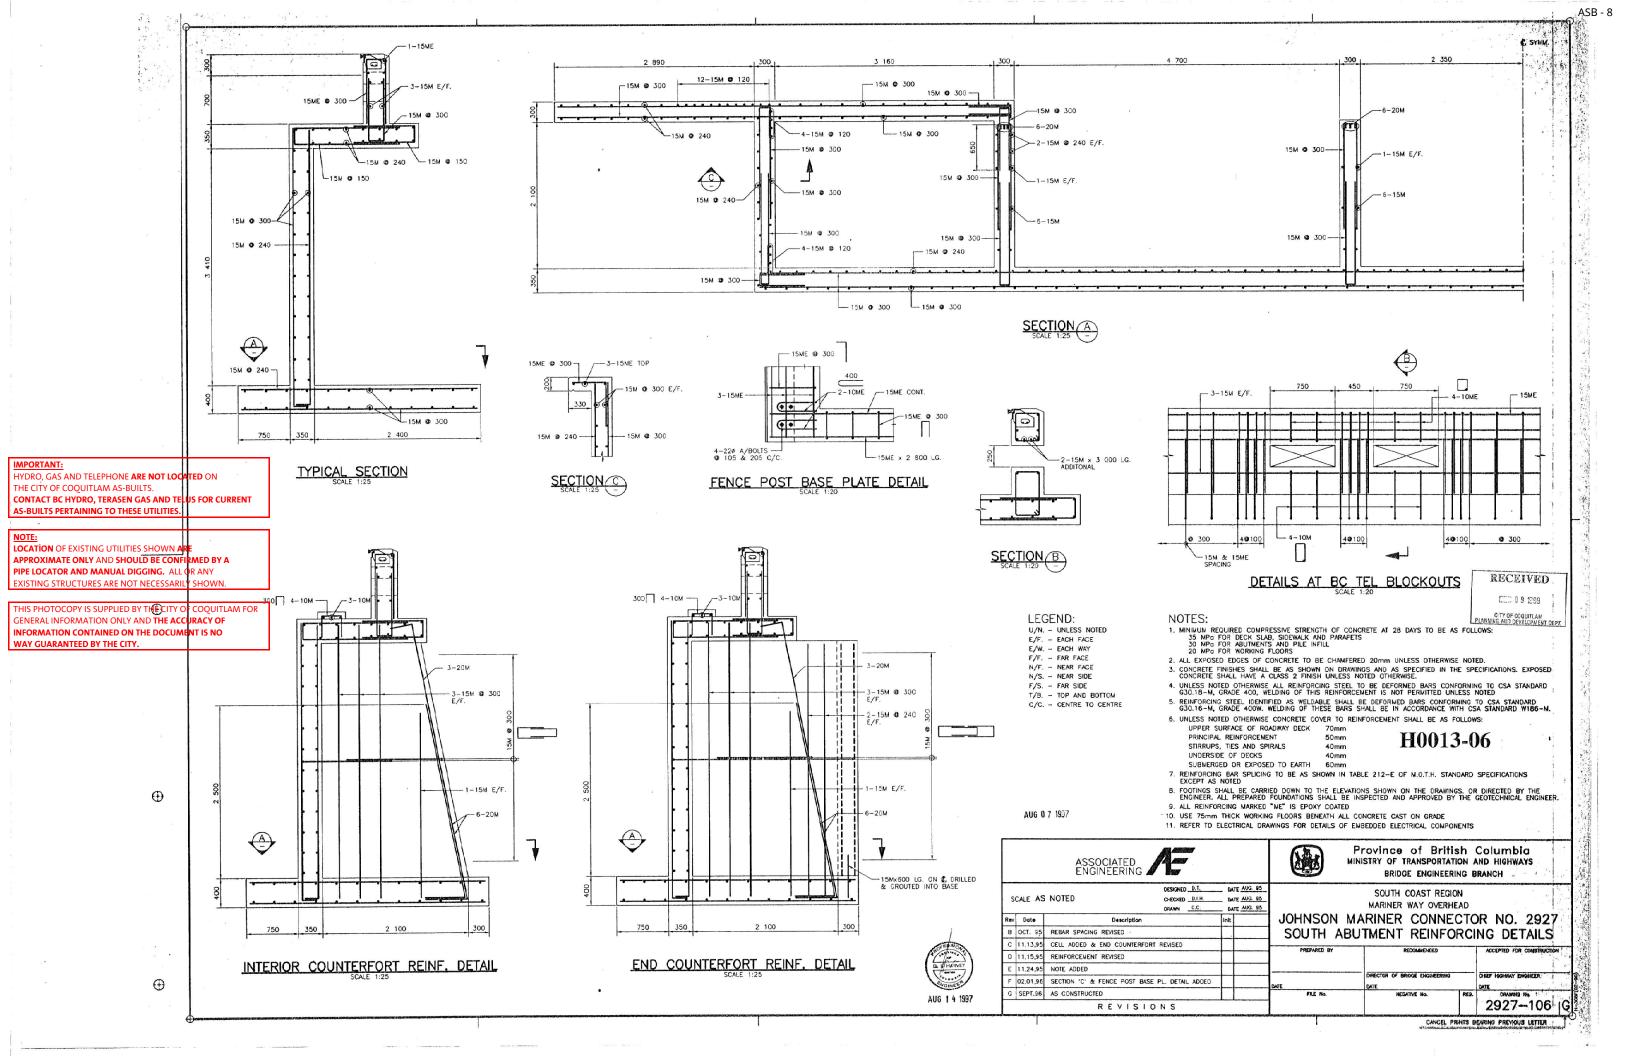


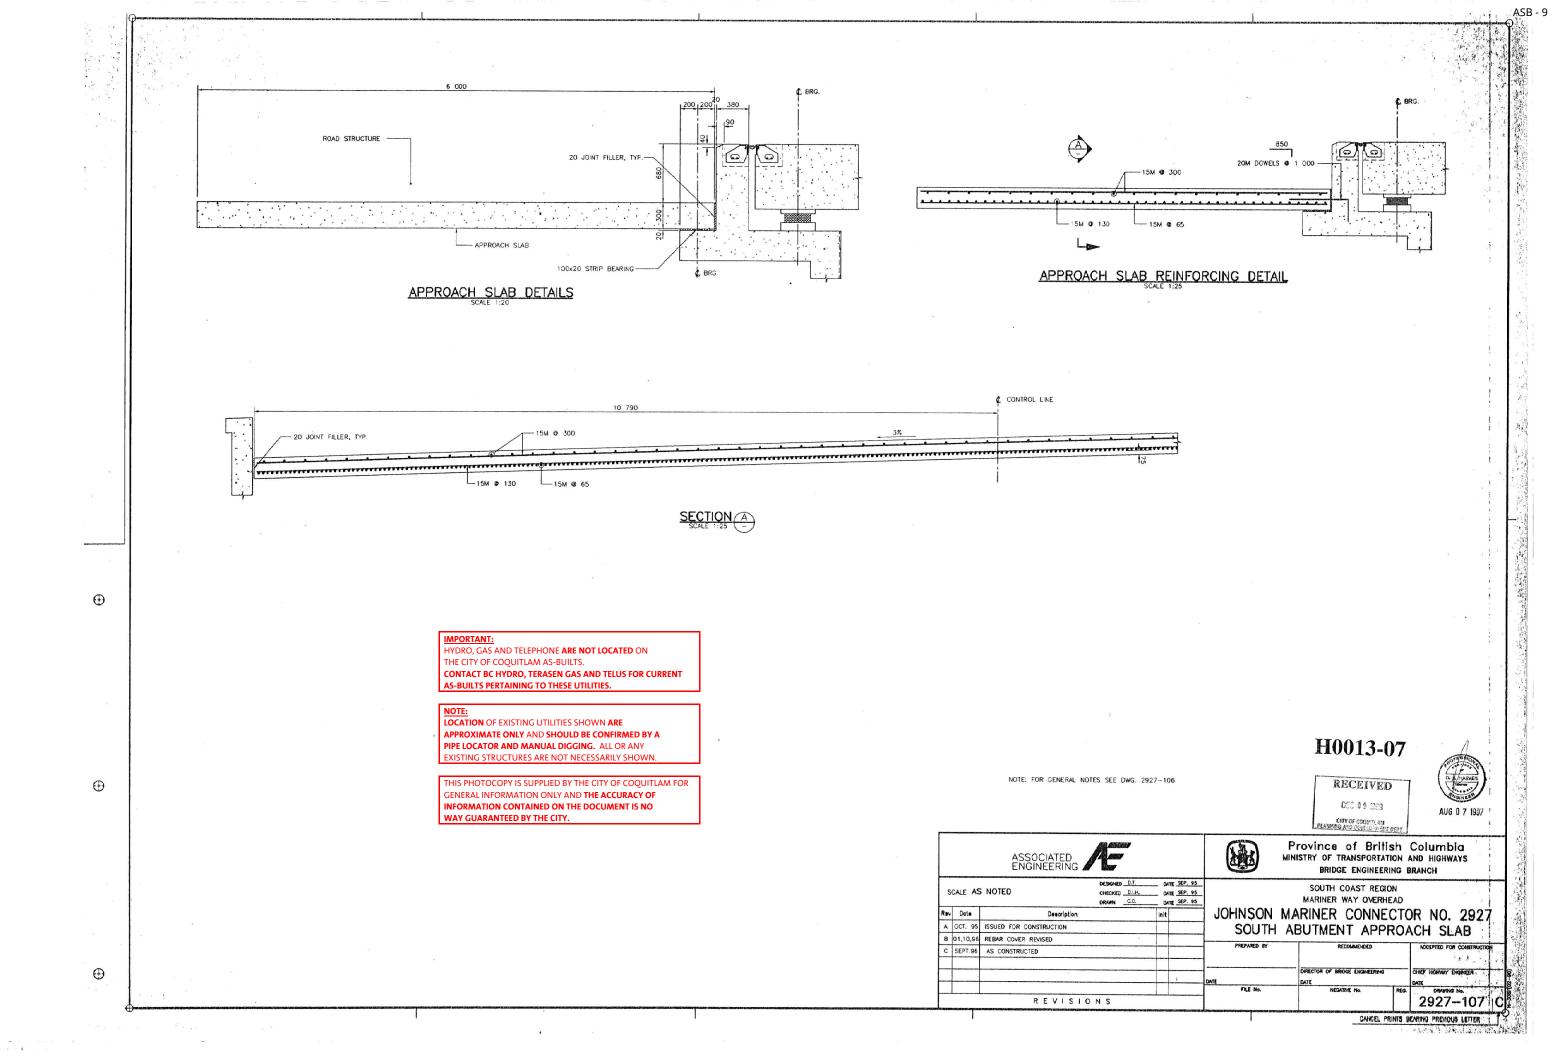


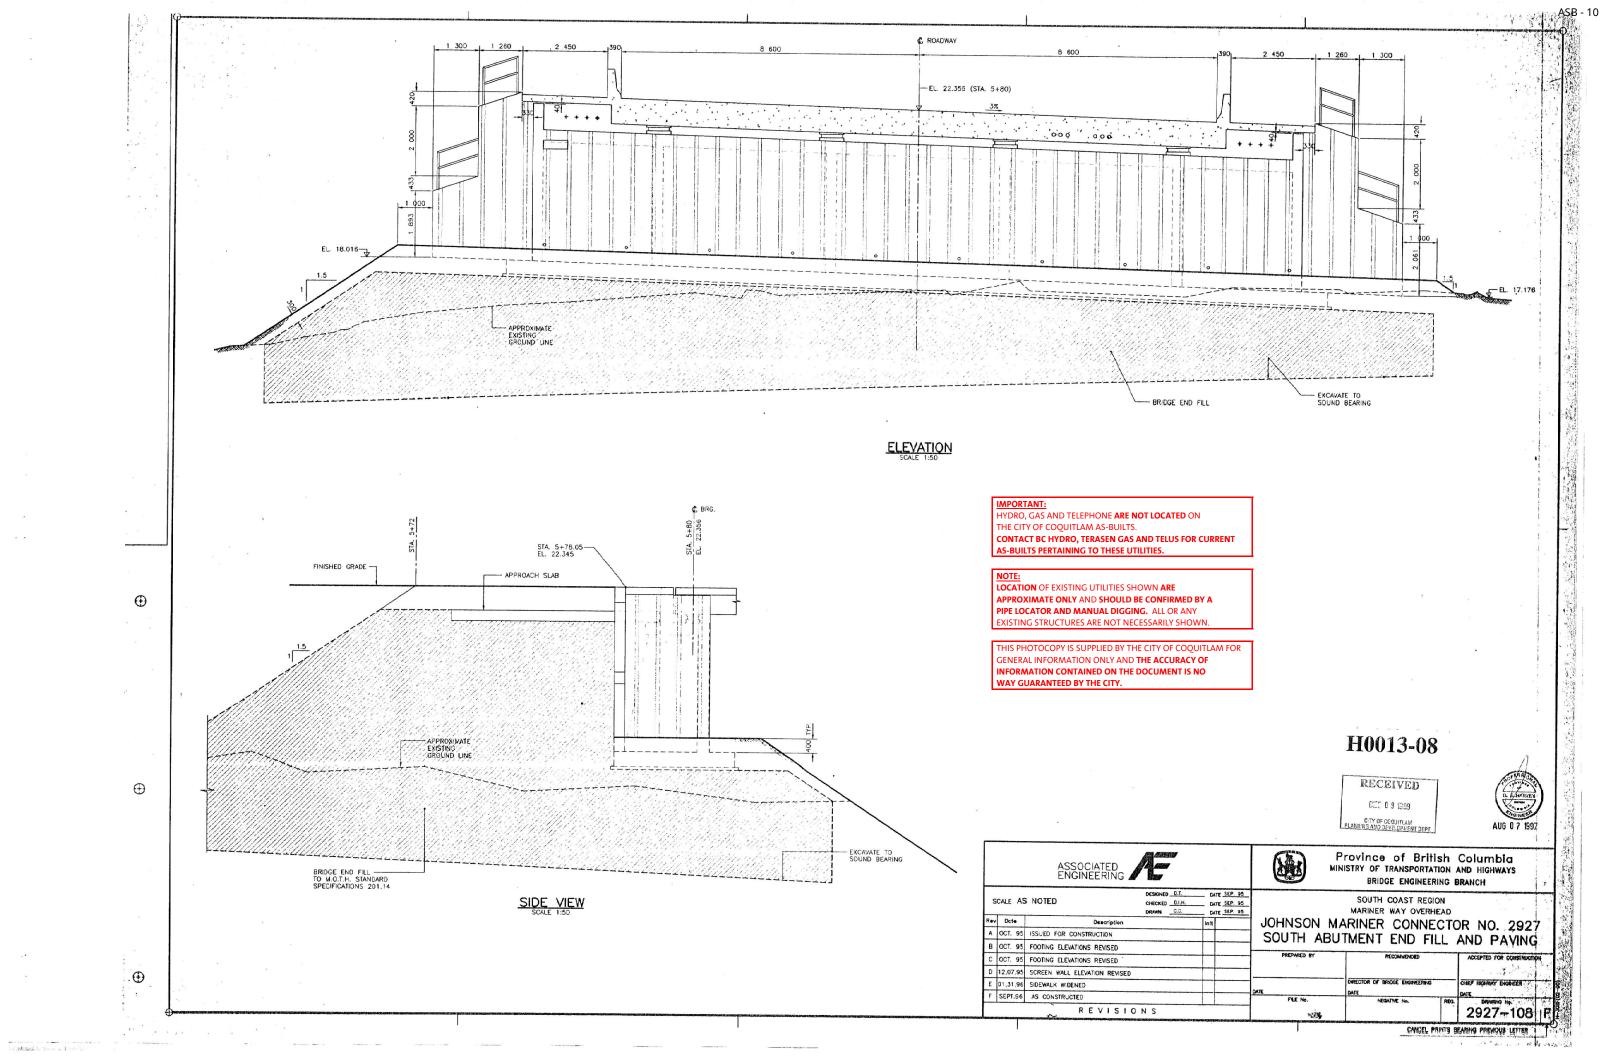


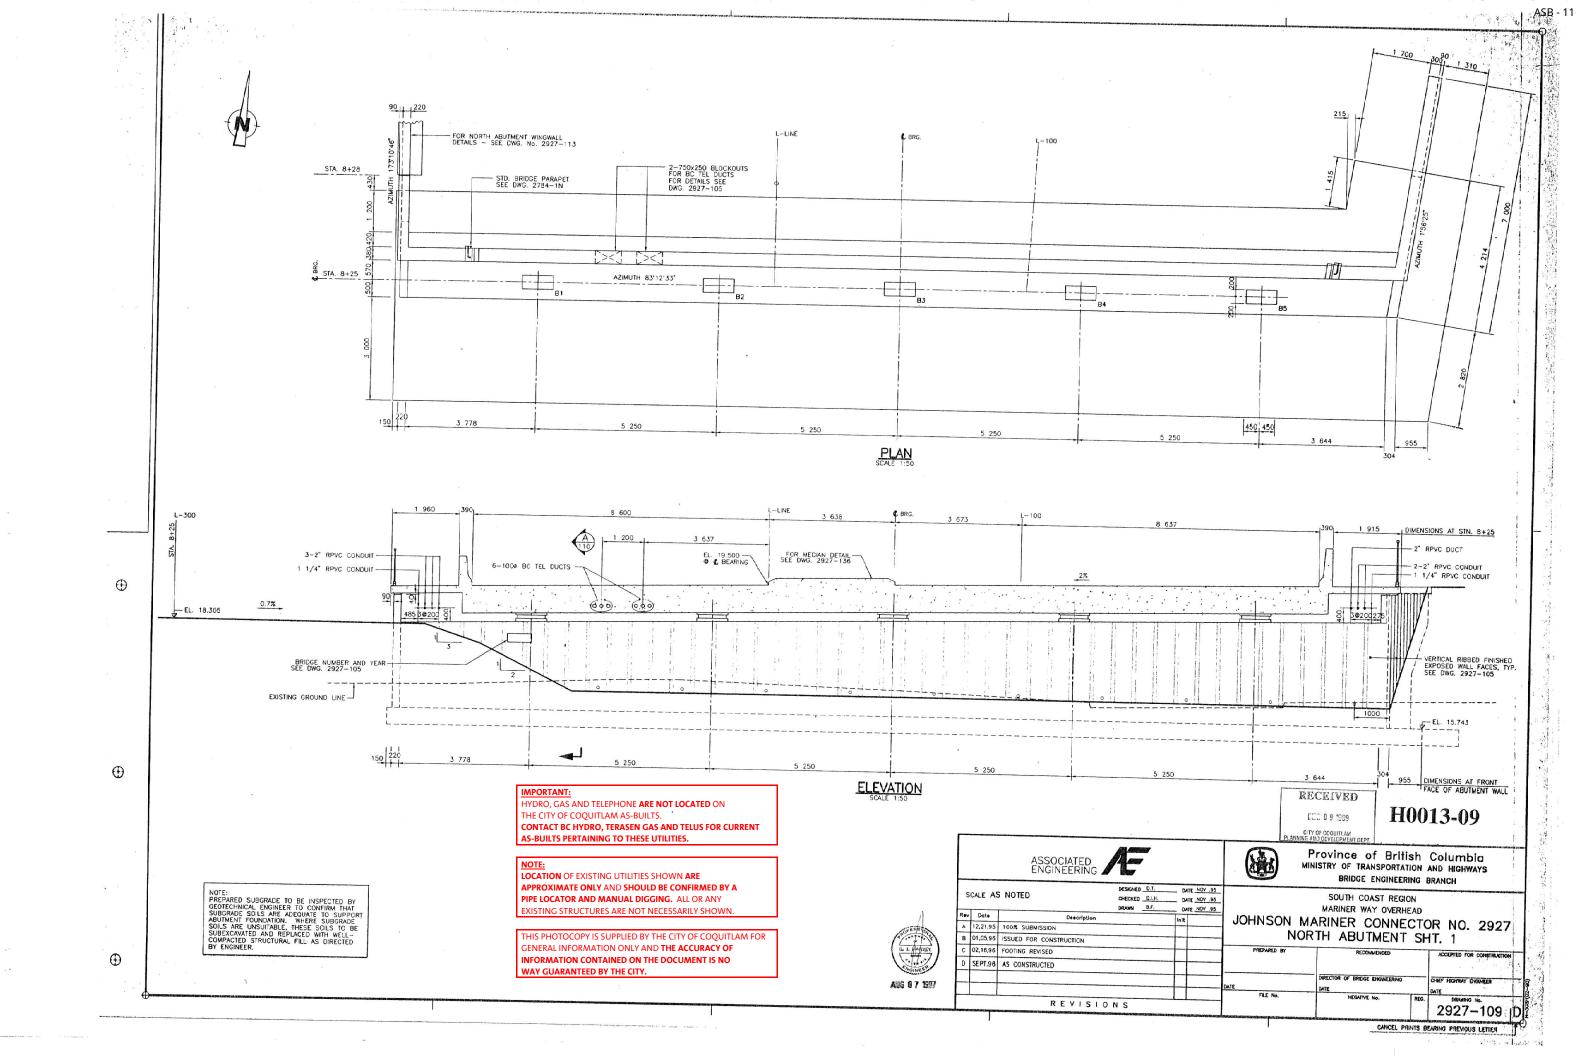


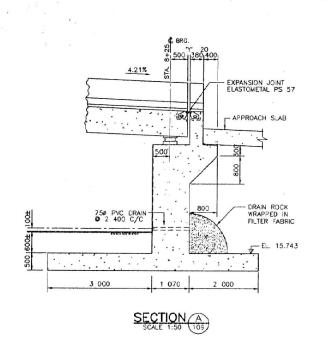

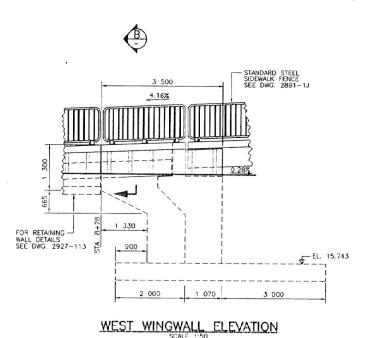

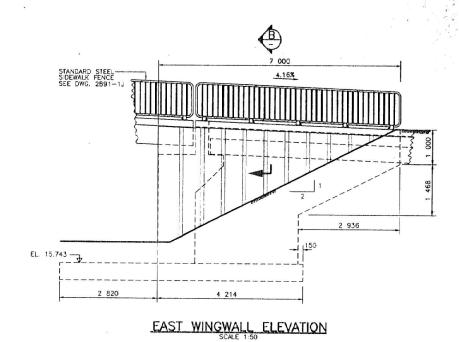

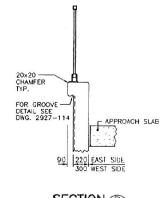

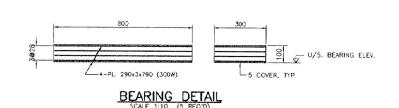

BEARING	U/S. BEARING ELEV.
B1	18.463
B2	18.568
83	18.673
84	18.778
B5	18.883

	BEARING REPLACEMENT PROCEDURE
1.	PLACE 10 HYDRAULICALLY - LINKED JACKS E/S. OF BEARINGS, APPROX. 350mm FROM FRONT FACE OF ABUTMENT.
	RAISE DECK APPROX. 10mm ACROSS FULL WIDTH.
	REMOVE & REPLACE BEARINGS. CALCULATED JACKING LOAD PER JACK = 450 kN

IMPORTANT:

HYDRO, GAS AND TELEPHONE **ARE NOT LOCATED** ON THE CITY OF COQUITLAM AS-BUILTS. CONTACT BC HYDRO, TERASEN GAS AND TELUS FOR CURRENT AS-BUILTS PERTAINING TO THESE UTILITIES.

NOTE: LOCATION OF EXISTING UTILITIES SHOWN ARE APPROXIMATE ONLY AND SHOULD BE CONFIRMED BY A PIPE LOCATOR AND MANUAL DIGGING. ALL OR ANY EXISTING STRUCTURES ARE NOT NECESSARILY SHOWN

THIS PHOTOCOPY IS SUPPLIED BY THE CITY OF COQUITLAM FOR GENERAL INFORMATION ONLY AND THE ACCURACY OF INFORMATION CONTAINED ON THE DOCUMENT IS NO WAY GUARANTEED BY THE CITY.

H0013-10

ASB - 12







ASSOCIATED Province of British Column MINISTRY OF TRANSPORTATION AND HIGH BRIDGE ENGINEERING BRANCH							AND HIGHWAYS		
	SCALE AS	NOTED	DESIGNED D.T. CHECKED D.I.H. DRAWN B.F.	DATE_N DATE_N			SOUTH COAST REGION MARINER WAY OVERHEA	D	
Re	Date	Description		init		JOHNSON M	MARINER CONNEC	TC	OR NO. 2927
A	12,21,95	100% SUBMISSION					RTH ABUTMENT		
8	01,05,96	ISSUED FOR CONSTRUCTION					THE ABOUTELY	J	11. 2
C	02,16,96	FOOTING REVISED				PREPARED BY	RECOMMENDED		ACCEPTED FOR CONSTRUCTION
D	JUL. 97	AS CONSTRUCTED							
						DATE	DIRECTOR OF SRIDGE ENGINEERING DATE		CHIEF HIGHWAY ENGINEER
_		8 (8)				FLE No.		REG.	DRAMINO No.
	THE RESIDENCE OF THE PARTY OF T	R E V I S I O	NS	Constitution of the Consti					2927-110 D


CANCEL PRINTS BEARING PREVIOUS LETTER


 \oplus


 \oplus

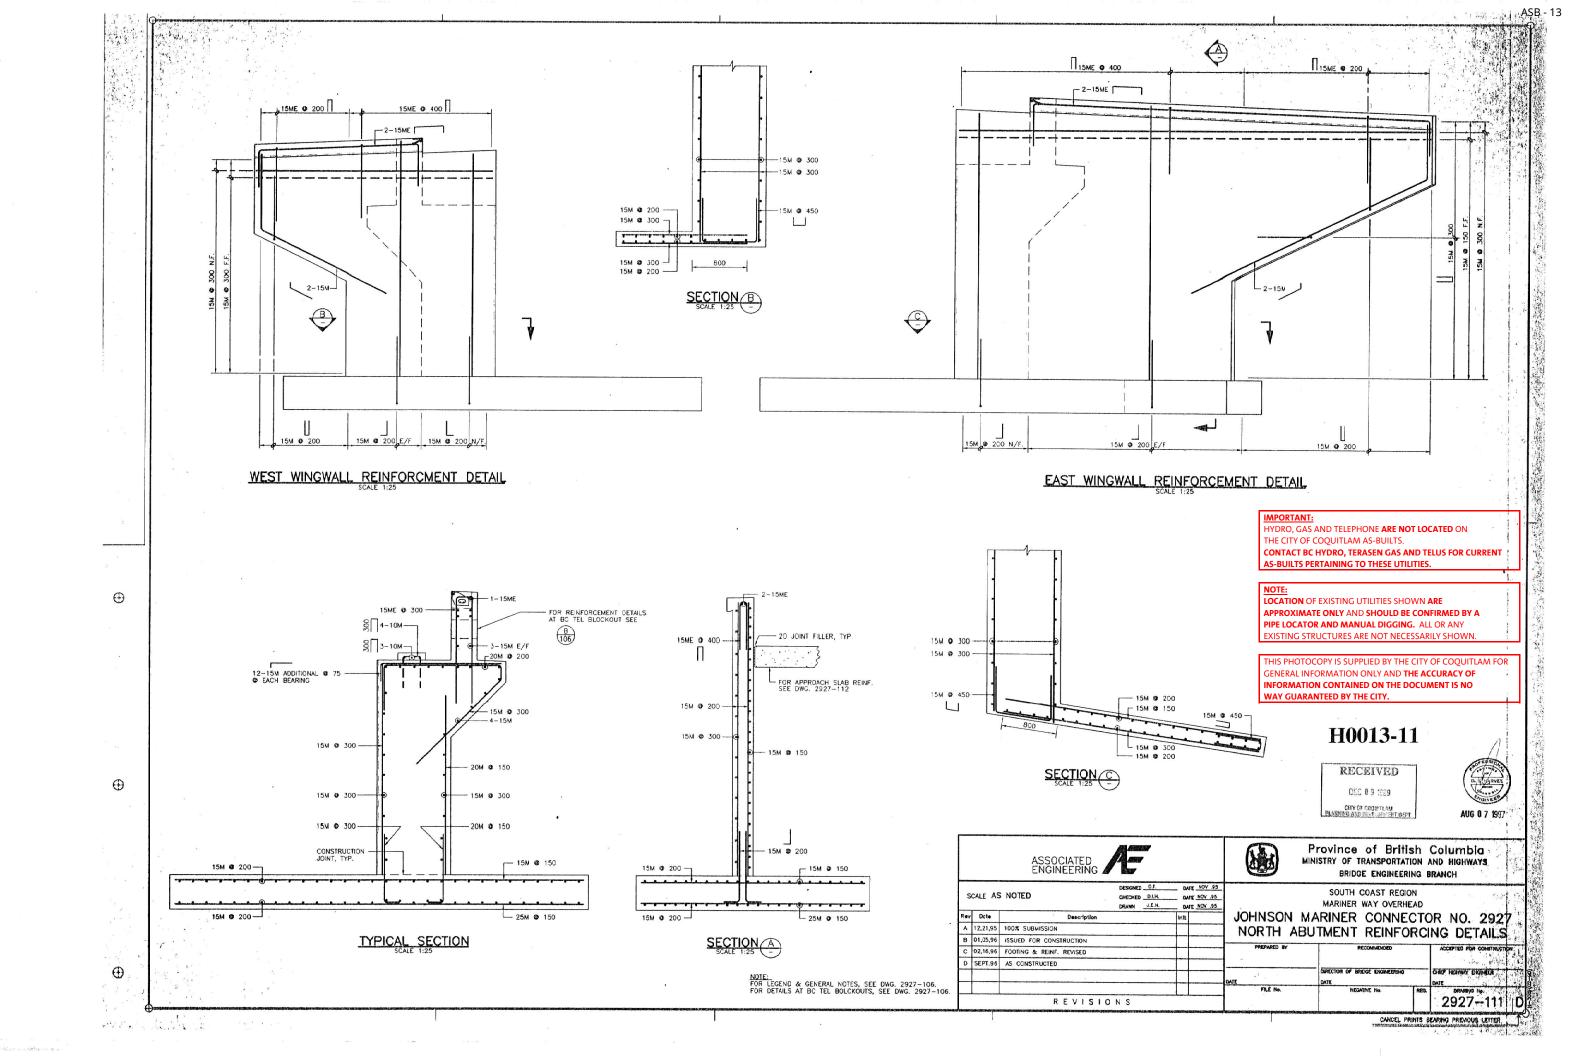


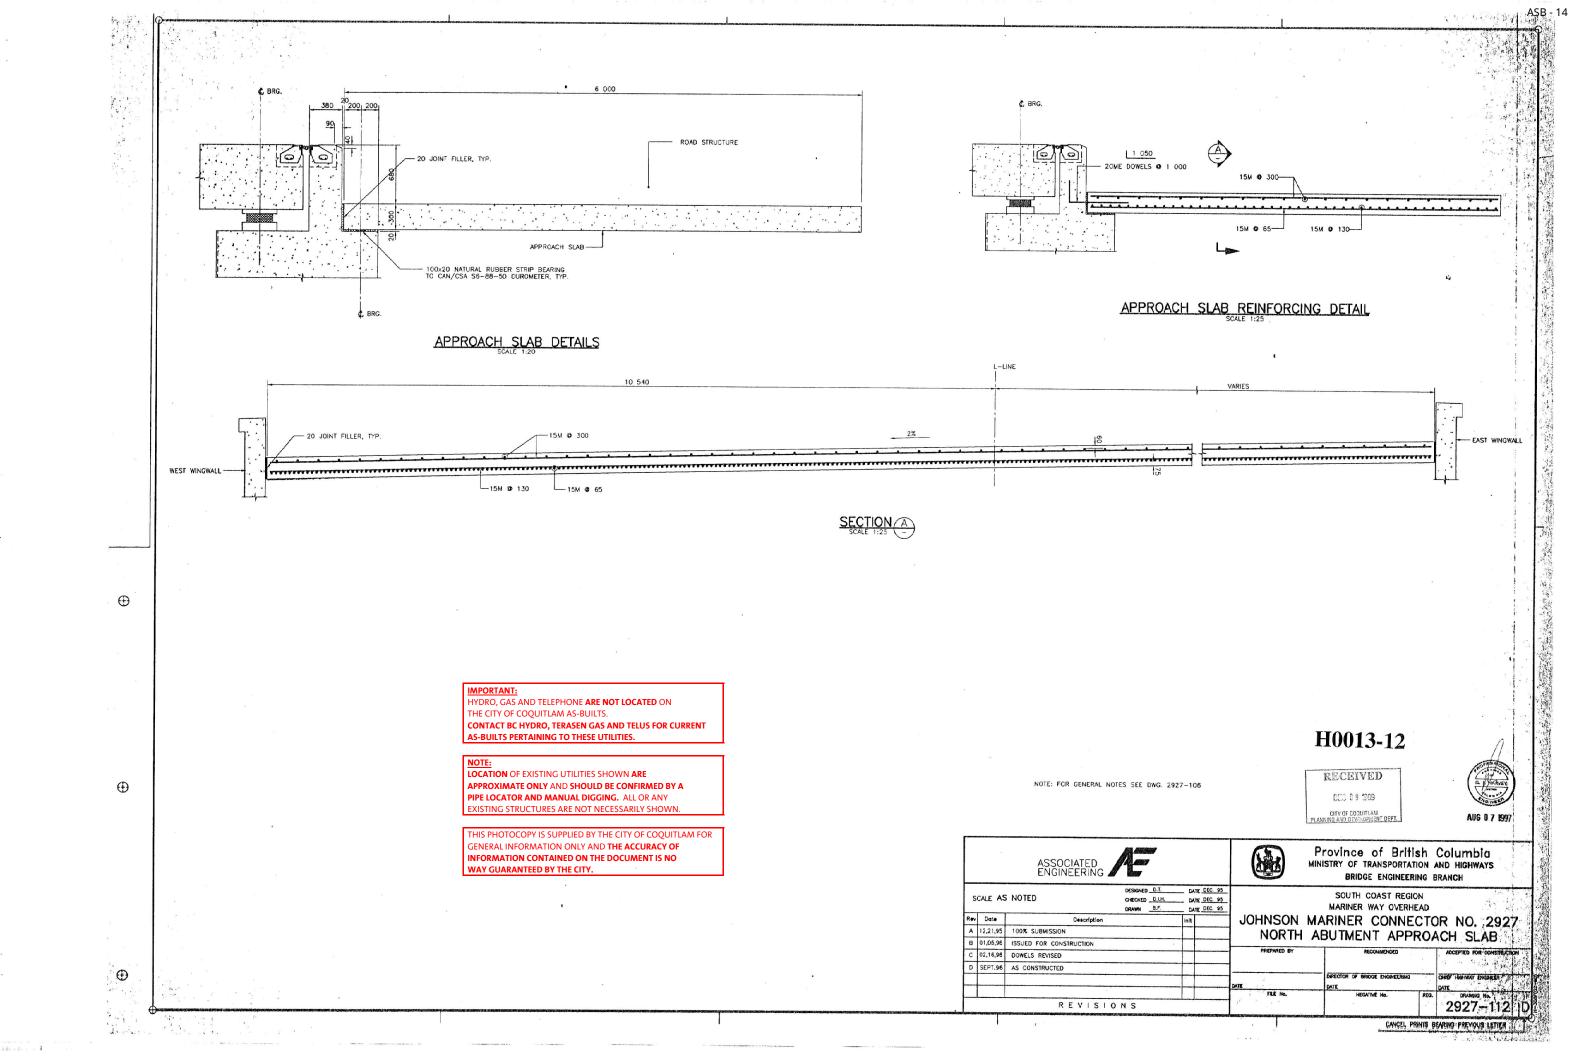


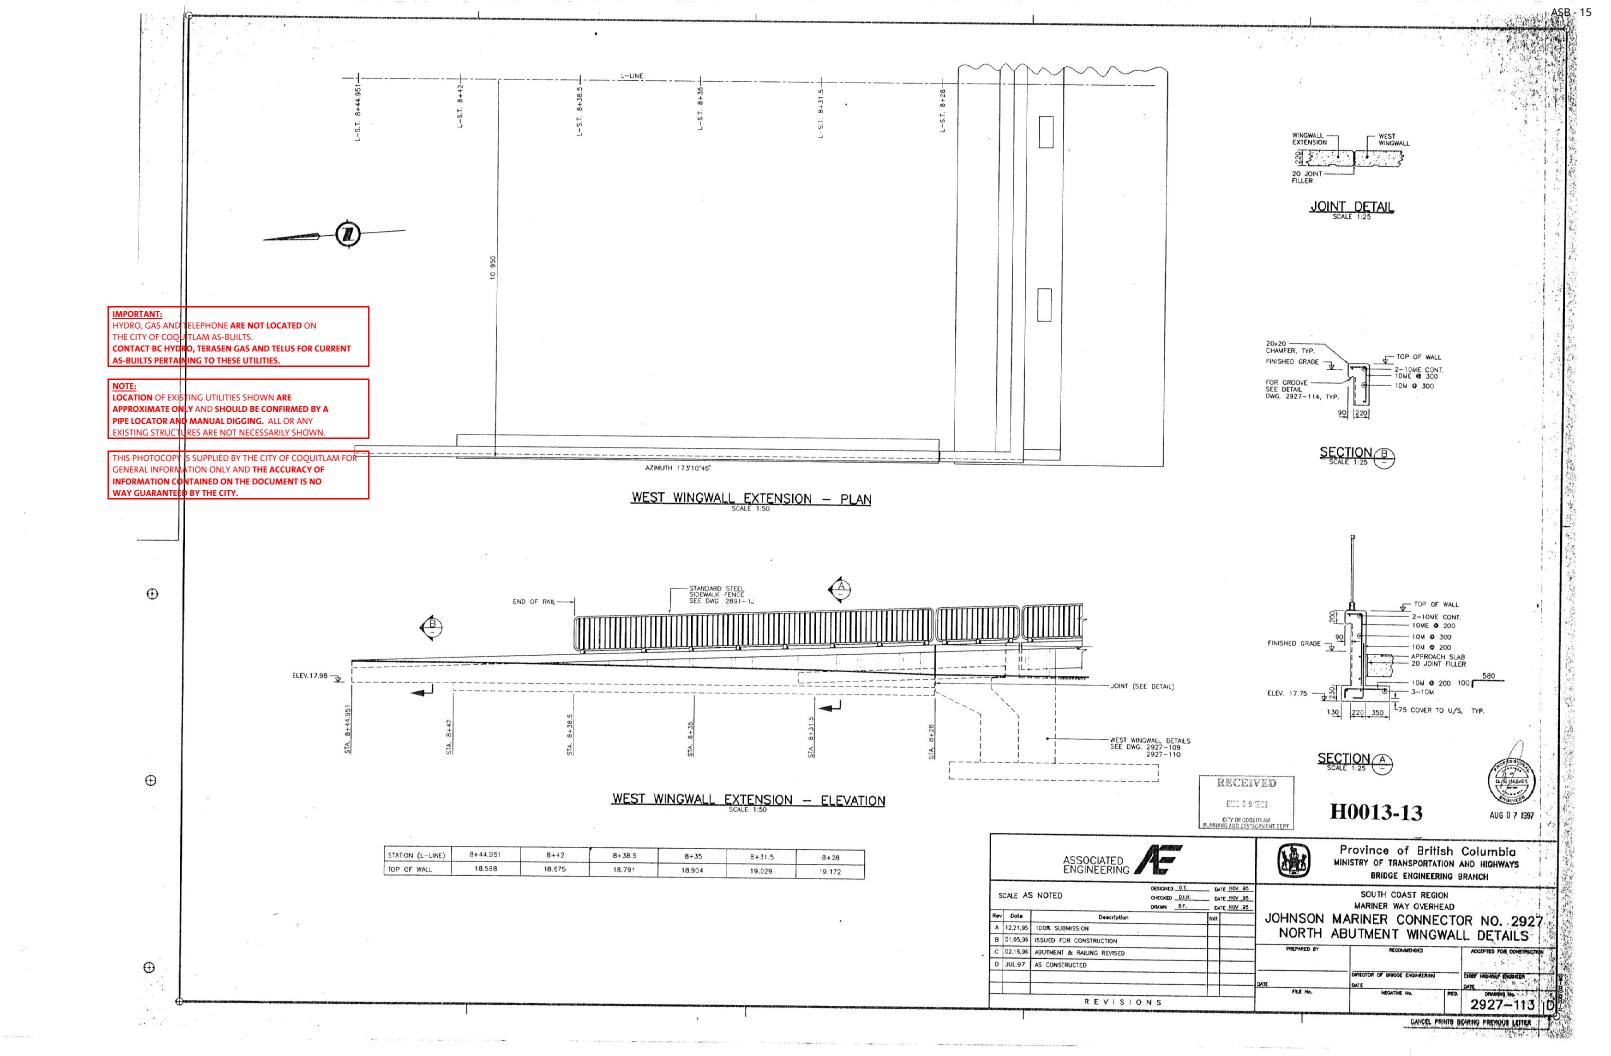

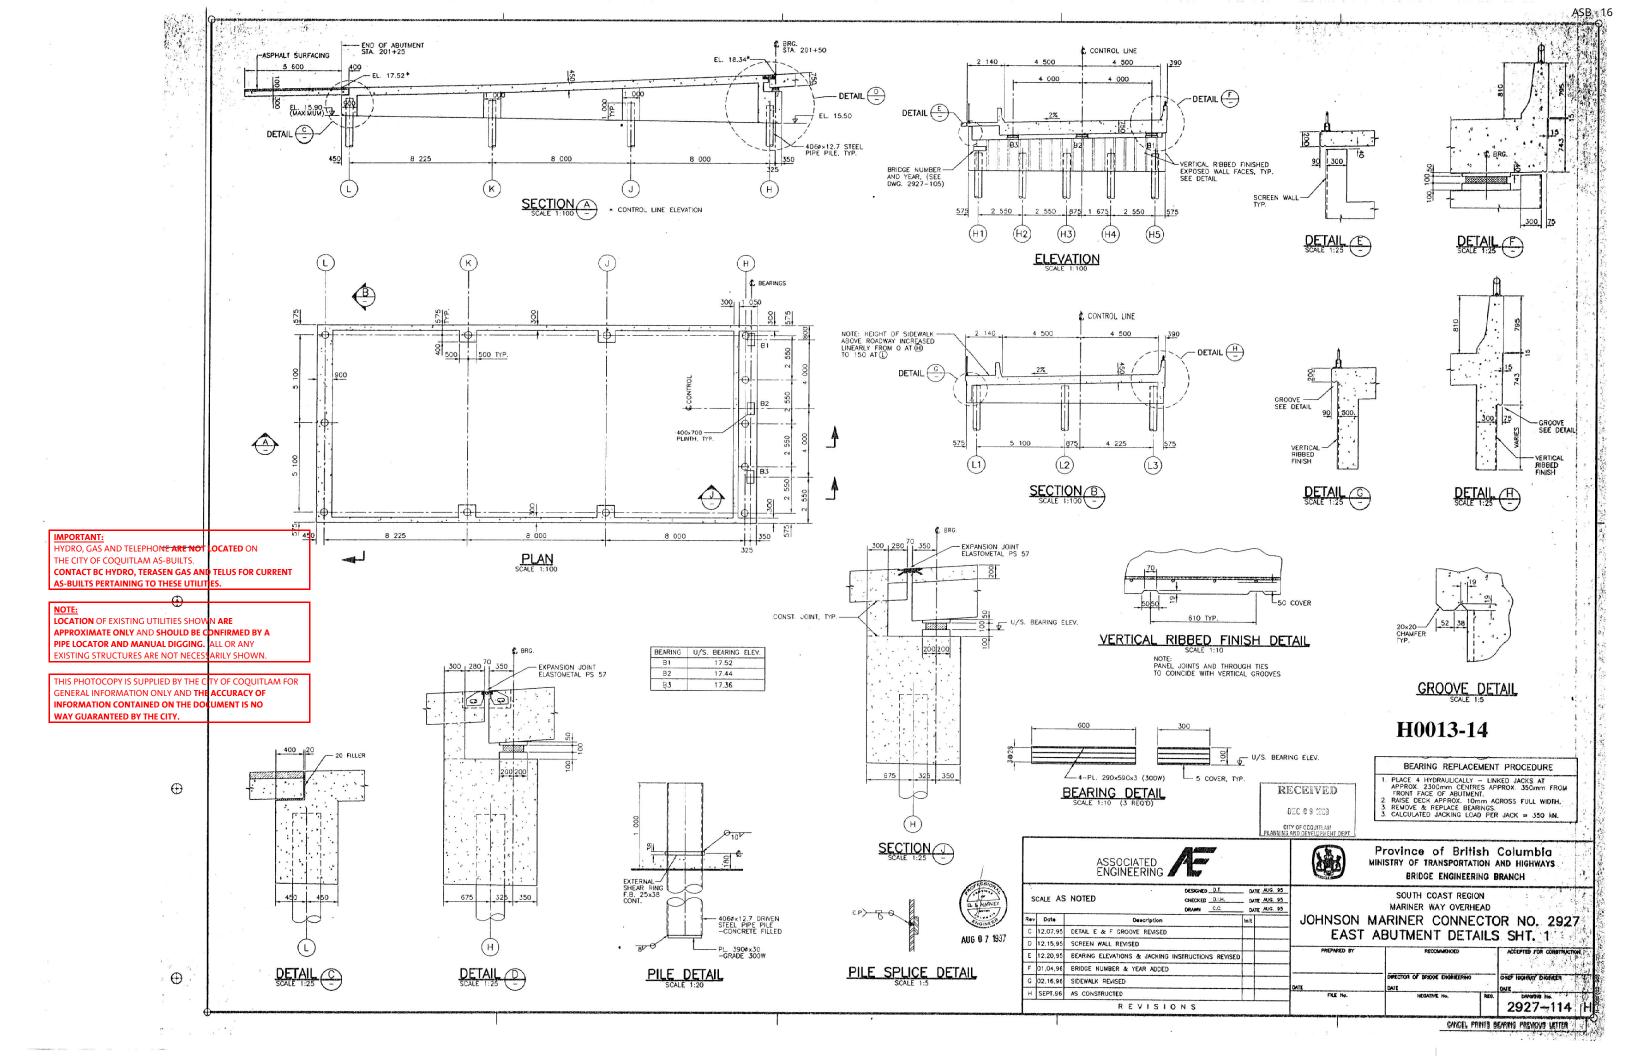

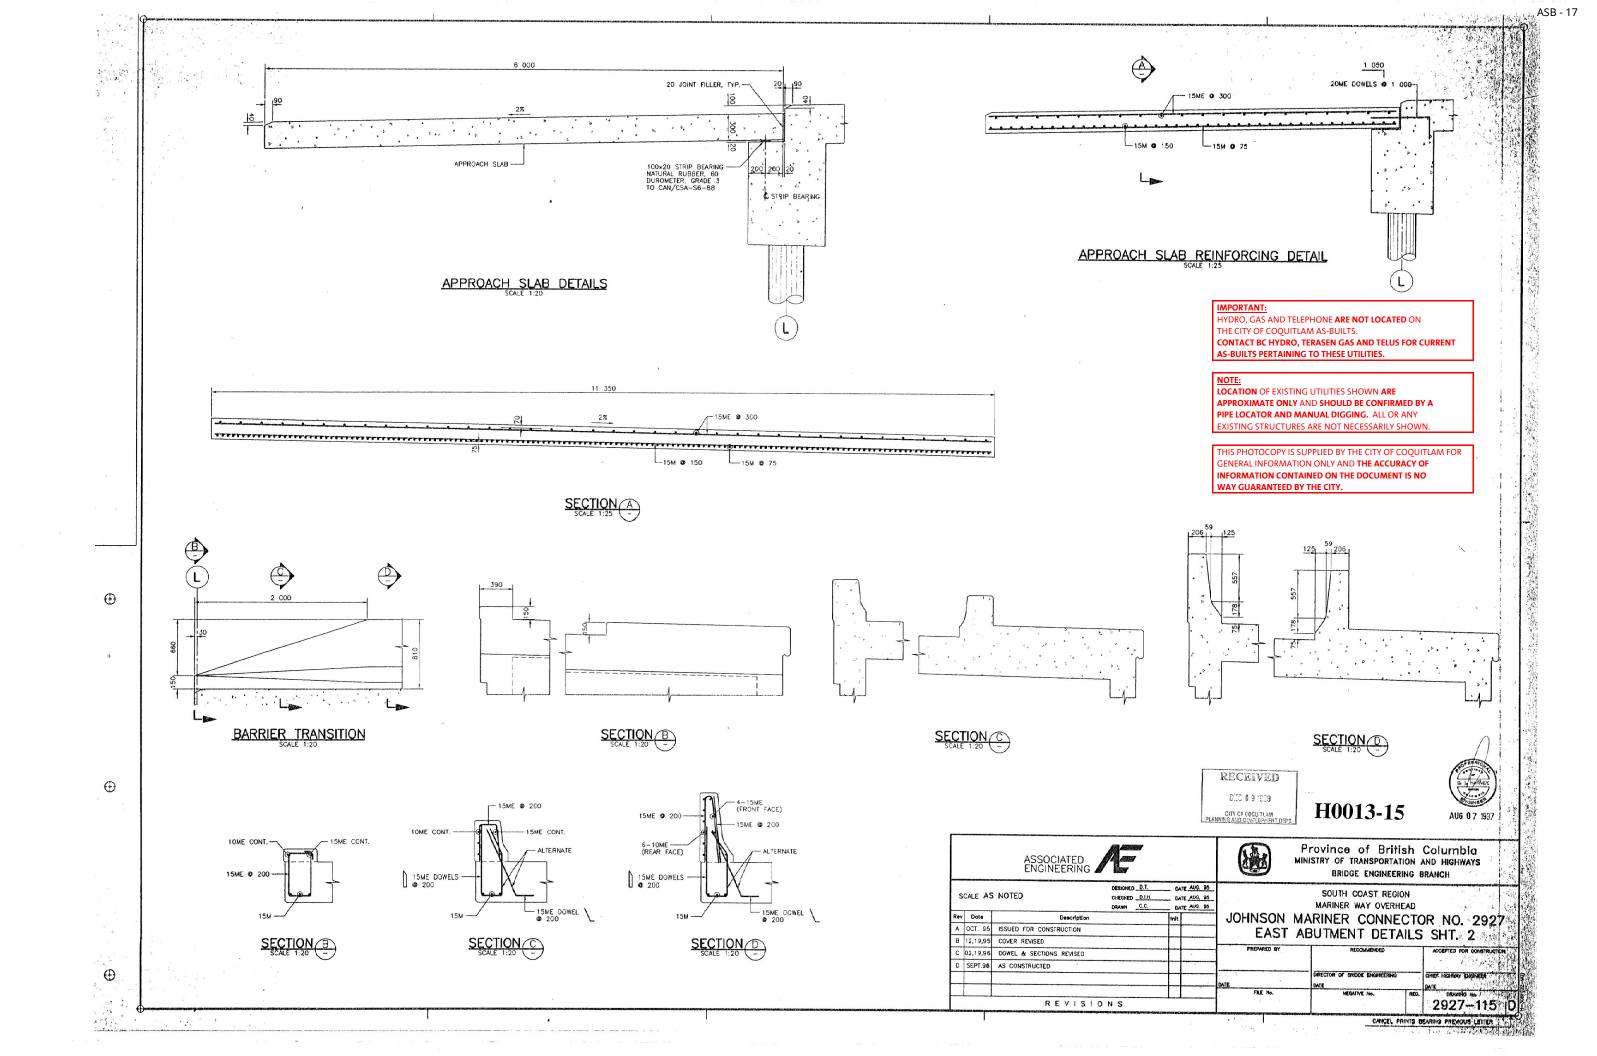

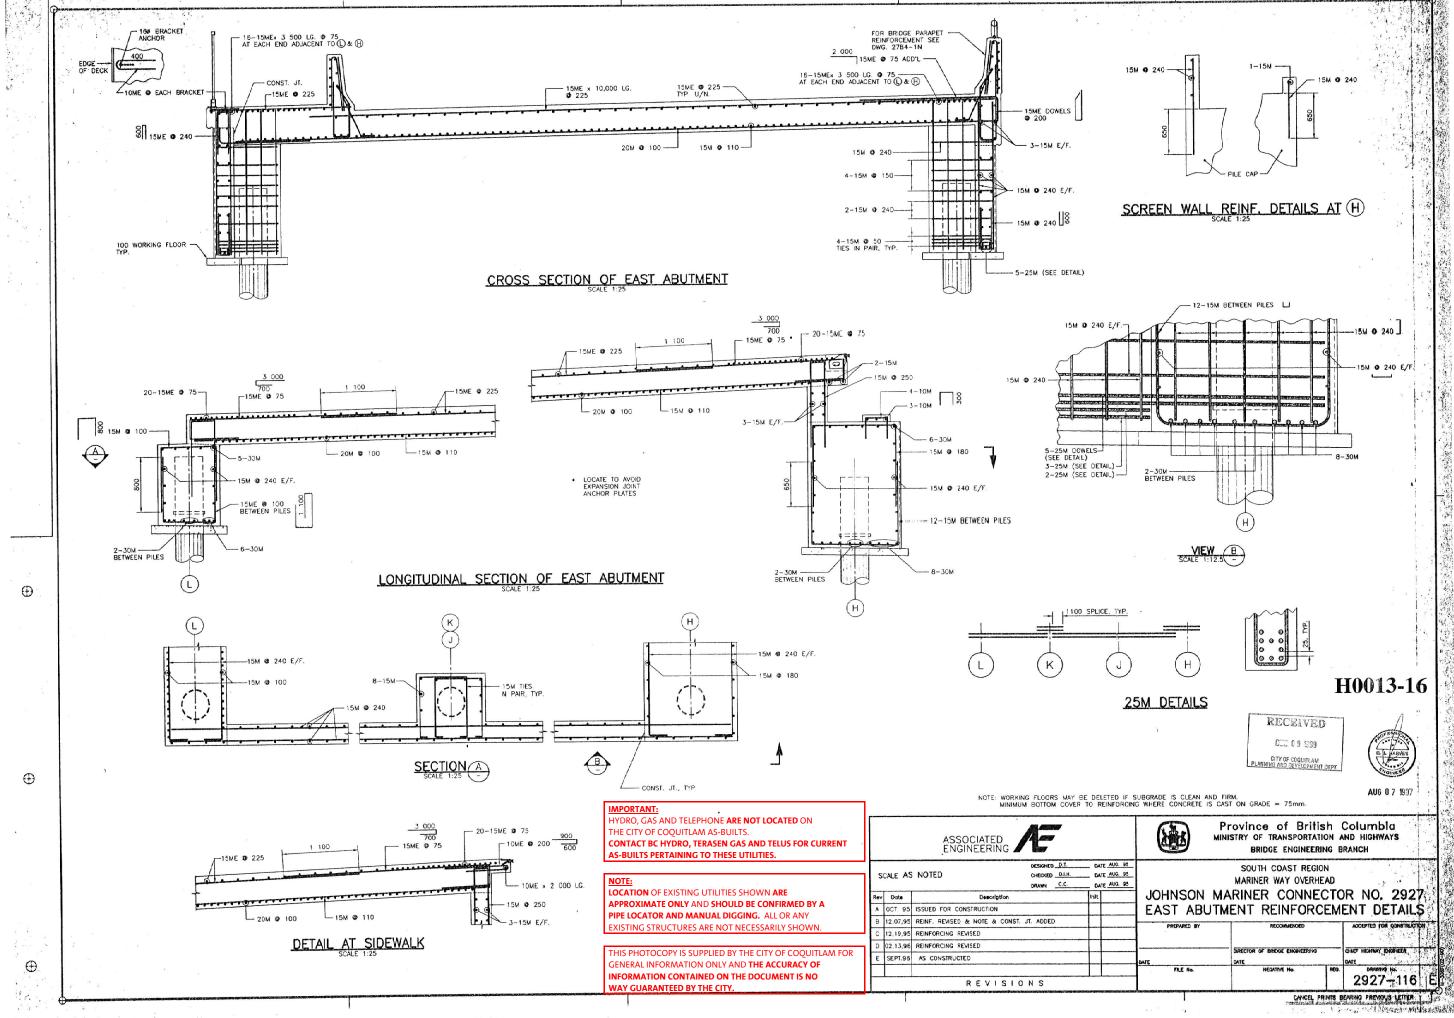

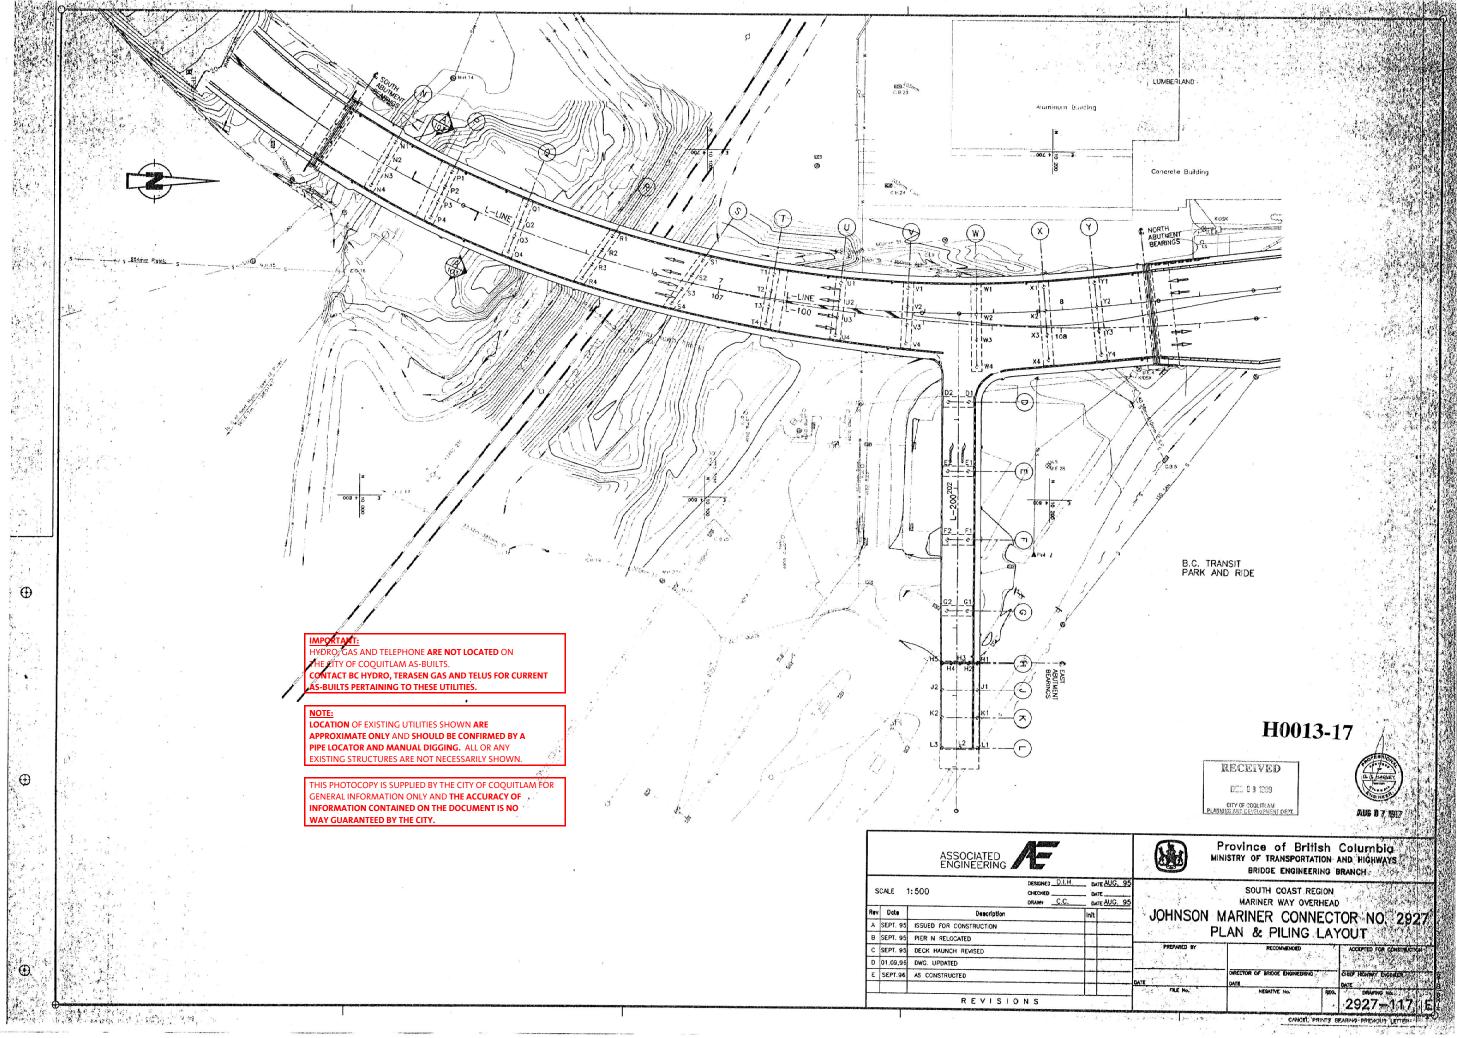

							PILING SC	HEDULE No.	1			and the state of the control of the
		PILE No.	PILE SIZE (mm)	NORTH	EAST	MAXIMUM WORKING LOAD (kN)	MINIMUM ULTIMATE CAPACITY (kN)	FINISHED DECK ELEVATION (m)	PILE CUT-OFF ELEVATION (m)	TILL EMBEDMENT (m)	PILE . TIP ELEVATION (m)	TILL PLUG (m)
		N1	914ø x 12.7	10009.669	4698.559	2800	7500	22.326	21.116	6.00	6.66	1.45
1 1	۲.	N2	914ø x 12.7	10007.455	4702.563	2800	7500	22.468	21.258	6.25	4.81	1.35
	BENT "N"	N3	914ø x 12.7	10005.153	4706.654	2800	7500	22.610	21.400	6.25	3.25	1.50
1 L		N4	914ø x 12.7	10002.809	4710.828	2800	7500	22.752	21.542	5.80	2.76	1.20
П		P1	914ø x 12.7	10026.100	4707.056	3350	9000	22.760	21.935	4.30	1.38	1.60
	L 5	P2	914ø x 12.7	10024.162	4711.239	3350	9000	22.902	22.077	5.50	0.20	1.65
	BENT "P"	P3	914ø x 12.7	10022.126	4715.589	3350	9000	23.044	22.219	4.00	1.70	1.00
ΙL		P4	914ø x 12.7	10020.150	4719.798	3350	9000	23.186	22.361	5.00	-1.00	1.55
		Q1	914ø x 12.7	10047.745	4716.236	4000	10200	23.472	22.647	5.00	2.25	1.90
	Σ'n	Q2	914ø x 12.7	10046.096	4720.667	4000	10200	23.614	22.789	5.75	1.39	1.60
	BENT "Q"	Q3	914ø x 12.7	10044.314	4725.059	4000	10200	23.756	22.931	5.10	2.28	1.73
		Q4	914ø x 12.7	10042.630	4729.494	4000	10200	23.898	23.073	6.50	3.68	2.30
П	BENT "R"	R1	914ø x 12.7	10072.553	4724.652	3600	9800	24.017	23.192	5.90	1.42	1.52
		R2	914ø x 12.7	10069.577	4728.858	3600	9800	24.138	23.313	5.00	1.96	1.5
Z		R3	914ø x 12.7	10066.276	4733.590	3600	9800	24.282	23.457	5.25	2.83	1.5
SPAN		R4	914ø x 12.7	10064.066	4736.982	3600	9800	24.378	23.553	5.00	1.97	1.85
		S1	914ø x 12.7	10098.851	4731.713	3800	10300	24.143	23.318	3.75	2.38	1.70
MAIN	ا اد کار	S2	914ø x 12.7	10095.863	4735.820	3800	10300	24.291	23.466	3.60	2.31	2.40
	BENT "S"	S3	914ø x 12.7	10092.769	4740.298	3800	10300	24.444	23.619	3.50	1.73	1.85
		S4	914ø x 12.7	10089.916	4744.198	3800	10300	24.579	23.754	3.25	2.21	2.35
		T1	914ø x 12.7	10119.609	4735.529	3800	10000	23.937	23.112	5.15	-1.25	1.79
	5.	T2	914ø x 12.7	10118.813	4740.333	3800	10000	24.083	23.258	3.70	0.82	1,75
	BENT T	Т3	914ø x 12.7	10118.045	4745.138	3800	10000	24.230	23.405	4.05	2.64	1.98
		T4	914ø x 12.7	10117.250	4749.953	3800	10000	24.376	23.551	3.60	3.18	2.25
		U1	914ø x 12.7	10138.987	4737.934	3150	8100	23.507	22.782	2.50	4.15	1.50
	ا ا	U2	914ø x 12.7	10138.456	4742.968	3150	8100	23.660	22.935	4.50	1.73	1.80
	BENT C.T	U3	914ø x 12.7	10137.906	4748.050	3150	8100	23.813	23.088	3.65	2.86	1.58
		U4	914ø x 12.7	10137.401	4753.035	3150	8100	23.966	23.241	3.60	3.02	1.80
		V1	914ø x 12.7	10158.331	4739.267	3200	8500	22.845	22.120	2.65	3.08	2.10
	BENT "<"	V2	914ø x 12.7	10158.174	4744.789	3200	8500	23.008	22.283	3.40	2.50	1.43
	BE.	V3	914ø x 12.7	10158.123	4750.071	3200	8500	23.170	22.445	4.50	1.53	3.77
		V4	914ø x 12.7	10157.912	4755.535	3200	8500	23.333	22.608	3.75	2.15	3.03


H0013-18



HYDRO, GAS AND TELEPHONE **ARE NOT LOCATED** ON THE CITY OF COQUITLAM AS-BUILTS. CONTACT BC HYDRO, TERASEN GAS AND TELUS FOR CURRENT AS-BUILTS PERTAINING TO THESE UTILITIES.

LOCATION OF EXISTING UTILITIES SHOWN **ARE** APPROXIMATE ONLY AND SHOULD BE CONFIRMED BY A PIPE LOCATOR AND MANUAL DIGGING. ALL OR ANY

THIS PHOTOCOPY IS SUPPLIED BY THE CITY OF COQUITLAM FOR GENERAL INFORMATION ONLY AND THE ACCURACY OF INFORMATION CONTAINED ON THE DOCUMENT IS NO WAY GUARANTEED BY THE CITY.

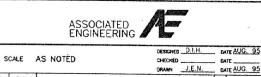

REVISIONS

A SEPT. 95 ISSUED FOR CONSTRUCTION

B SEPT. 95 PIER N RELOCATED

C SEPT. 95 PILE DETAILS REVISED

F SEPT.96 AS CONSTRUCTED

D OCT. 95 CUT-OFFS, R3 REVISED

E 11,23,95 S3 PILE RELOCATED & ELEVATIONS REVISED

Province of British Columbia MINISTRY OF TRANSPORTATION AND HIGHWAYS BRIDGE ENGINEERING BRANCH

> SOUTH COAST REGION MARINER WAY OVERHEAD

DIIC 0 9 1999

CITY OF COQUITLAM
PLANNING AND DEVELOPMENT DEPT.

JOHNSON MARINER CONNECTOR NO. 2927 PILING SCHEDULE No. 1

2927-118 |F

CANCEL PRINTS BEARING PREYIOUS LETTER

 \oplus

 \oplus

		PILING SCHEDULE No. 2										
-	Z ARNIANING KENING	PILE No.	PILE SIZE (mm)	NORTH	EAST	MAXIMUM WORKING LOAD (kN)	MINIMUM ULTIMATE CAPACITY (kN)	FINISHED DECK ELEVATION (m)	PILE CUT-OFF ELEVATION (m)	TILL EMBEDMENT (m)	PILE TIP ELEVATION (m)	TILL PLUG (m)
		W1	914ø x 12.7	10178.106	4739.507	3900	9900	21.953	21.228	3.60	-0.39	1.26
1	BENT "W"	W2	914ø x 12.7	10178.247	4746.865	3900	9900	22.175	21.450	3.30	-0.43	1.65
	B.	W3	914ø x 12.7	10178.352	4754.268	3900	9900	22.396	21.671	3.75	-0.12	1.70
		W4	914ø x 12.7	10178.460	4761.669	3900	9900	22.618	21.893	3.75	-0.66	1.35
AN		X1	914ø x 12.7	10197.625	4738.611	3500	8900	20.847	20.122	3.70	-2.14	1.70
MAIN SPAN	BENT "X,"	X2	914ø x 12.7	10198.154	4745.647	3500	8900	21.043	20.318	4.45	-2.30	1.60
Z	BE .	X3	914ø x 12.7	10198.652	4752.632	3500	8900	21.243	20.518	3.75	-2.13	0.90
Ž		X4	914ø x 12.7	10199.219	4759.668	3500	8900	21.442	20.717	4.00	-2.27	1.83
		Y1	914ø x 12.7	10212.406	4737.178	2500	6700	20.058	18.808	4.60	-3.27	0.46
	Ľ.	Y2	914ø x 12.7	10213.144	4744.222	2500	6700	20.198	18.948	4.70	-3.44	0.60
	BENT "Y"	Y3	914ø x 12.7	10213.868	4751.204	2500	6700	20.338	19.088	4.88	-3.83	2.02
		Y4	914ø x 12.7	10214.665	4758.176	2500	6700	20.479	19.229	3.80	-2.55	1.80
	BENT "D"	D1	914ø x 12.7	10176.297	4771.643	3050	7900	22.921	22.196	4.00	-1.12	1.65
		D2	914ø x 12.7	10170.300	4771.660	3050	7900	23.041	22.316	4.60	-0.87	1.70
RAMP	BENT "E"	E1	914ø x 12.7	10176.389	4791.615	3200	8700	22.421	21.696	4.00	-2.28	2.00
RA	BE.	E2	914ø x 12.7	10170.397	4791.624	3200	8700	22.541	21.816	3.00	-0.03	2.15
ST	BENT "F"	F1	914ø x 12.7	10176.403	4811.615	3200	8700	21.001	20.276	3.60	-2.58	1.90
E	. BE	F2	914ø x 12.7	10170.422	4811.656	3200	8700	21.121	20.396	3.60	-1.58	1.50
	BENT "G"	G1	914ø x 12.7	10176.425	4831.917	3050	8100	19.379	18.209	4.50	-2.97	1.50
	B .	G2	914ø x 12.7	10170.501	4831.631	3050	8100	19.521	18.351	3.60	-2.02	2.00
		H1	406ø x 12.7	10179.535	4846.949	930	2450		16.500	2.40	-0.72	
	_	H2	406ø x 12.7	10176.985	4846.958	930	2450	THE REST OF THE PERSON NAMED AND ADDRESS.	16.500	2.00	-0.28	The Section 2011 Co. 11 (1981) 18 1 19 1 19 1 19 1 19 1 19 1 19 1
	BENT	Н3	406ø x 12.7	10174.435	4846.966	930	2450	SE EMPLOYER DE DECIDIO DE RESE	16.500	1.25	0.32	
Į.	<u> </u>	H4	406ø x 12.7	10171.885	4846.975	930	2450	t BB et en e	16.500	1.95	-0.31	as were sent to recognize a standard or seconds are
ABUTMENT		H5	406ø x 12.7	10169.335	4846.984	930	2450	* 16.5 s over	16.500	2.00	-0.34	of attending to the state of th
BU	BENT "Ç"	J1	406ø x 12.7	10179.563	4854.949	760	2050		16.630	1.75	-0.09	
1	H .	J2	406ø x 12.7	10169.363	4854.984	760	2050		16.630	2.00	-0.64	
EAST	BENT K	K1	406ø x 12.7	10179.590	4862.949	810	2150		16.760	2.20	-0.50	
Ш	8,	K2	406ø x 12.7	10169.390	4862.984	810	2150	6 8 6 800 B 1 165 C	16.760	1.95	-0.99	
	⊨.	L1	406ø x 12.7	10179.618	4871.174	820	2250		16.890	1.75	-1.06	
	BENT "L"	L2	406ø x 12.7	10174.518	4871.191	820	2250		16.890	1.20	-0.81	
		L3	406ø x 12.7	10169.418	4871.209	820	2250		16.890	2.00	-1.24	

H0013-19

IMPORTANT:

 \oplus

 \oplus

HYDRO, GAS AND TELEPHONE ARE NOT LOCATED ON THE CITY OF COQUITLAM AS-BUILTS.

CONTACT BC HYDRO, TERASEN GAS AND TELUS FOR CURRENT

AS-BUILTS PERTAINING TO THESE UTILITIES.

NOTE:

LOCATION OF EXISTING UTILITIES SHOWN ARE
APPROXIMATE ONLY AND SHOULD BE CONFIRMED BY A
PIPE LOCATOR AND MANUAL DIGGING. ALL OR ANY
EXISTING STRUCTURES ARE NOT NECESSARILY SHOWN.

THIS PHOTOCOPY IS SUPPLIED BY THE CITY OF COQUITLAM FOR GENERAL INFORMATION ONLY AND THE ACCURACY OF INFORMATION CONTAINED ON THE DOCUMENT IS NO WAY GUARANTEED BY THE CITY.





Province of British Columbia MINISTRY OF TRANSPORTATION AND HIGHWAYS BRIDGE ENGINEERING BRANCH

SOUTH COAST REGION MARINER WAY OVERHEAD

DESIGNED D.I.H. DATE AUG. 95

SCALE AS NOTED

A SEPT. 95 ISSUED FOR CONSTRUCTION
B SEPT. 95 PILE DETAILS REVISED

D 11,20,95 G1 PILE RELOCATED & ELEVATIONS REVISED

REVISIONS

C OCT. 95 CUT-OFFS REVISED


E SEPT.96 AS CONSTRUCTED


Rev Date


JOHNSON MARINER CONNECTOR NO. 2927 PILING SCHEDULE No. 2


PREPARED BY		RECO	MEHDED		ACC	EPTED FO	R CONS	TRUCTI	*
	DIRECTOR	OF BRIDGE	ENGENEERING		CHIEF	BOHWAY I	CKANEE	١.	भ
FILE No.		HEGATIVE	No.	REQ.	100	227.		a	3 12


CANCEL PRINTS BEARING PREVIOUS LETTER!

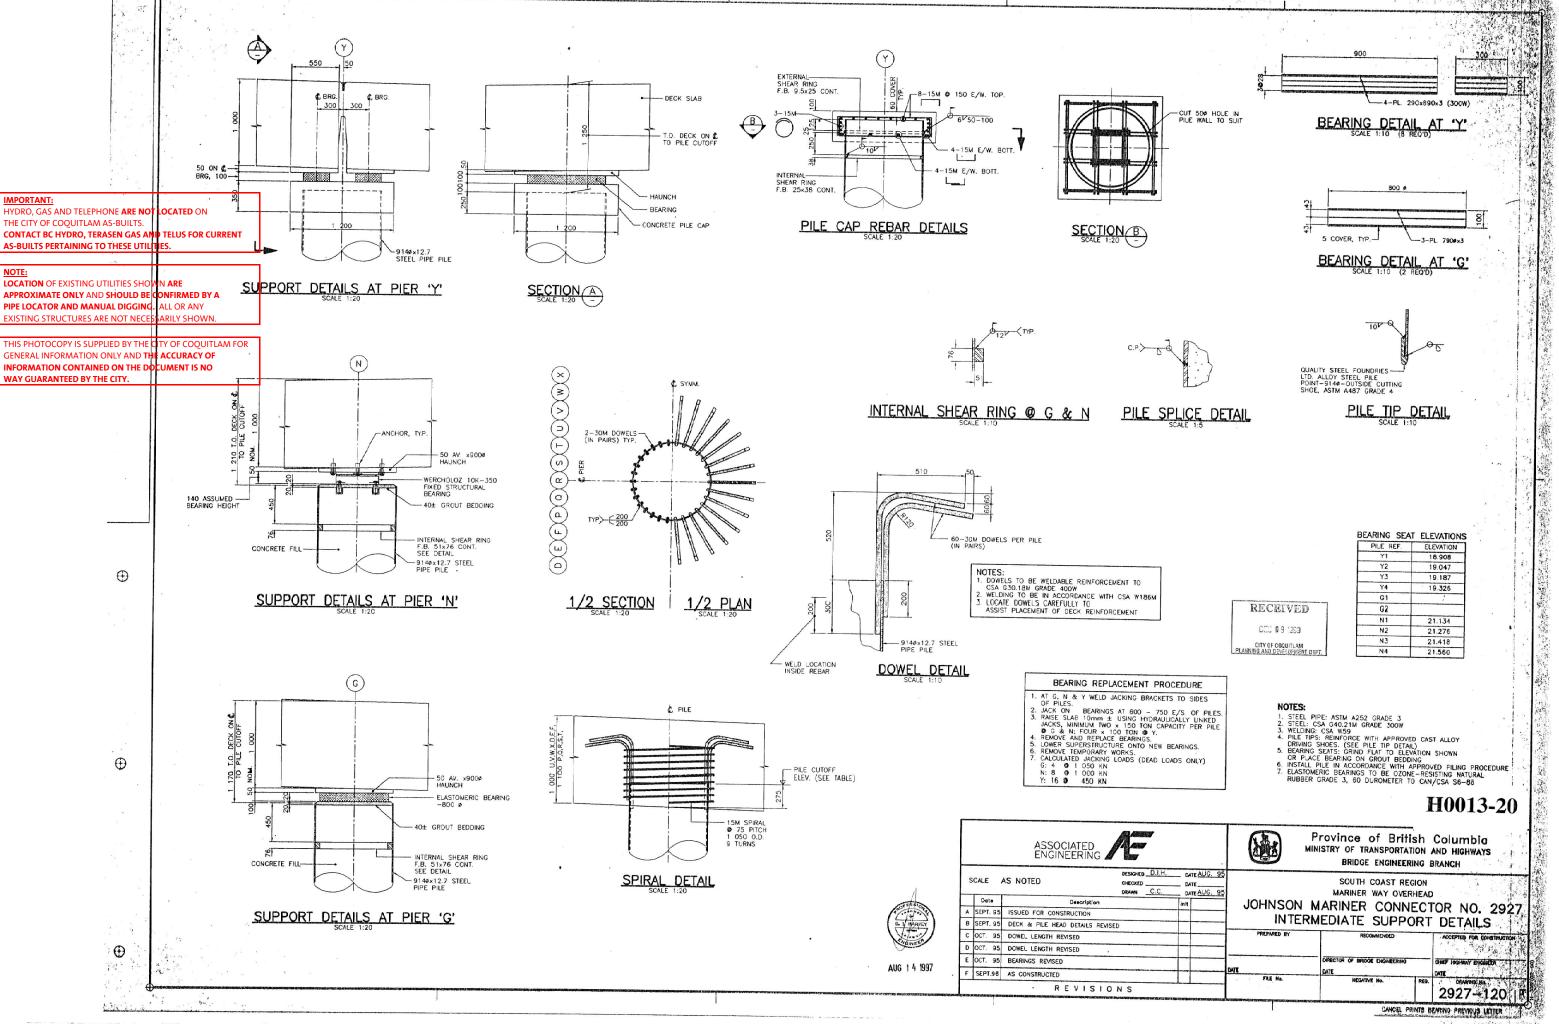


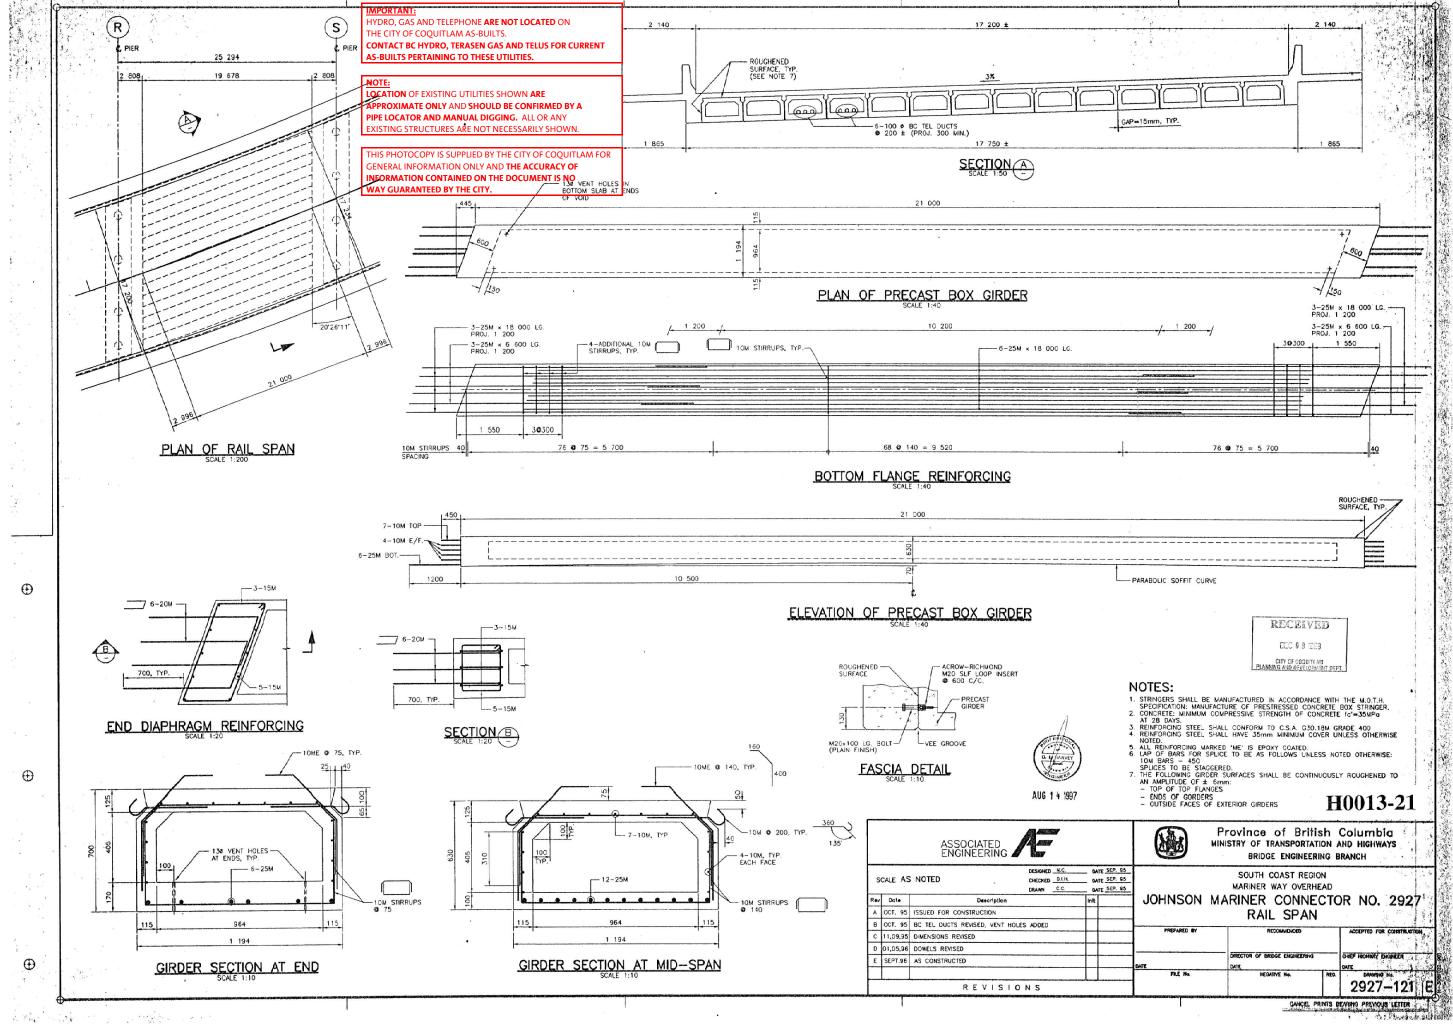

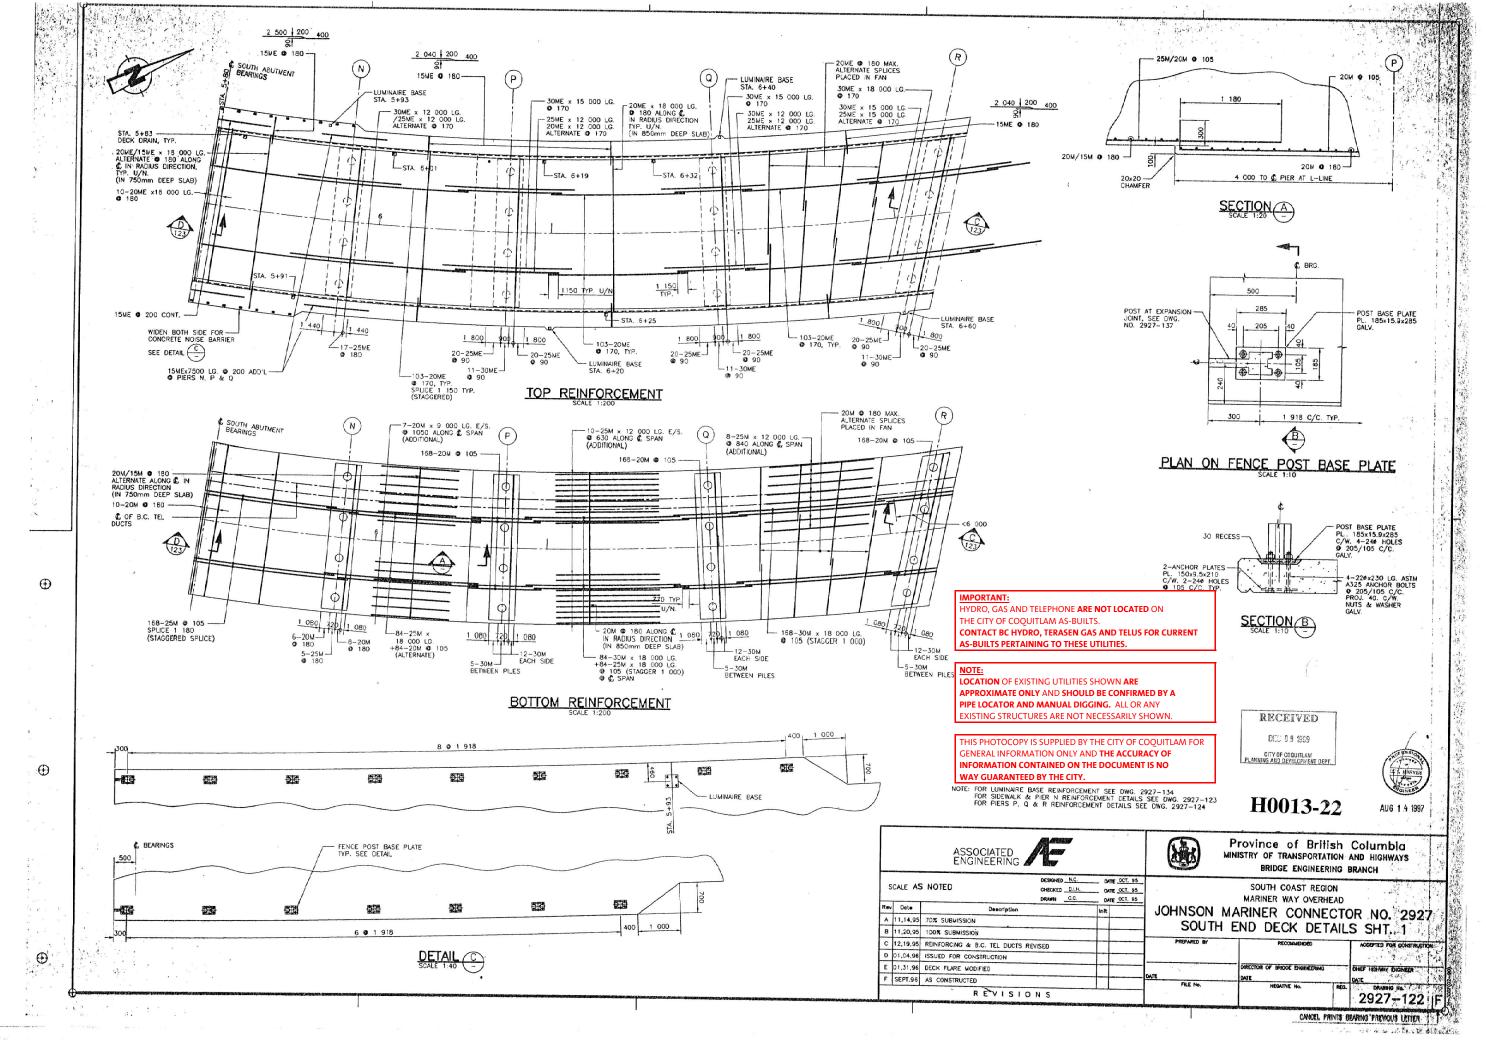

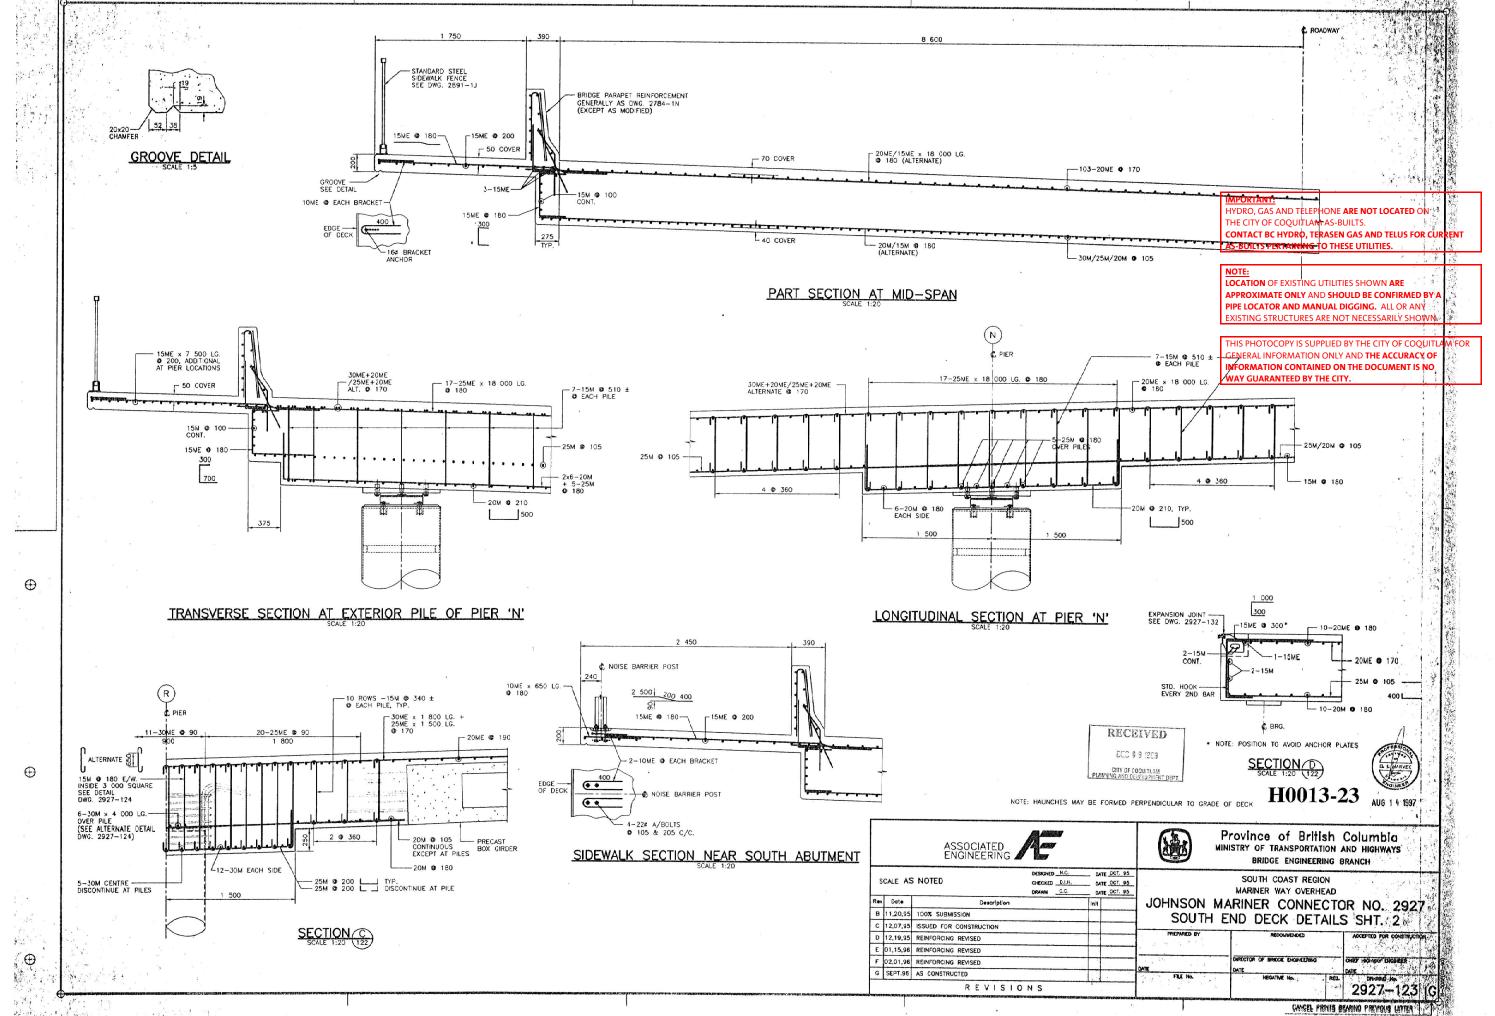


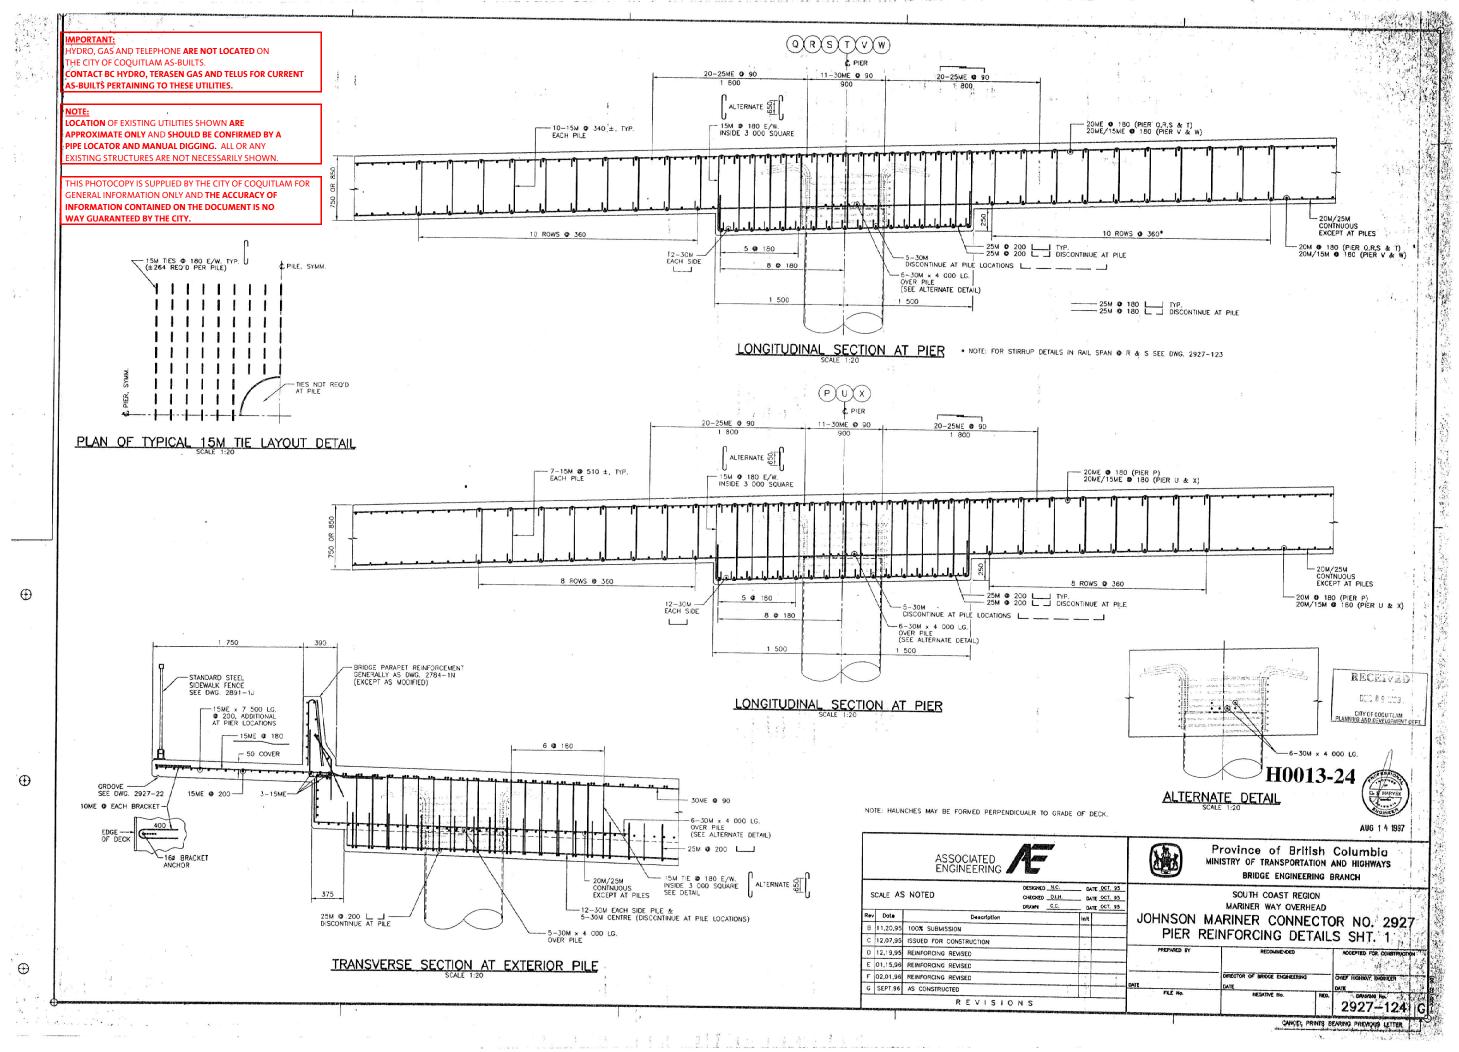

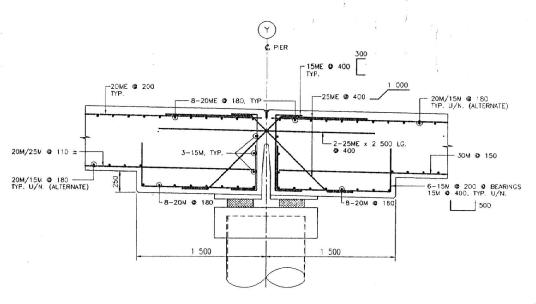


LONGITUDINAL SECTION AT PIER 'Y'


NOTE: HAUNCHES MAY BE FORMED PERPENDICULAR TO GRADE.

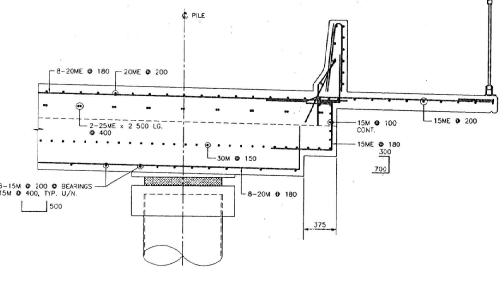


TRANSVERSE SECTION AT EXTERIOR PILE OF PIER 'Y'

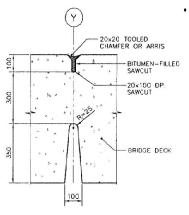

HINGE DETAILS

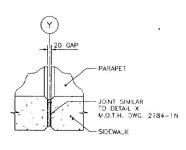

SIDWALK DETAIL AT Y

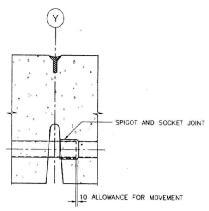

BC TEL DUCT DETAIL AT HINGE

H0013-25



DDC 0 9 1999 CITY OF COQUITLAM
PLANNING AND DEVELOPMENT DEPT

RECEIVED



AUG 1 4 1997

HYDRO, GAS AND TELEPHONE **ARE NOT LOCATED** ON THE CITY OF COQUITLAM AS-BUILTS. CONTACT BC HYDRO, TERASEN GAS AND TELUS FOR CURRENT AS-BUILTS PERTAINING TO THESE UTILITIES.

LOCATION OF EXISTING UTILITIES SHOWN ARE APPROXIMATE ONLY AND SHOULD BE CONFIRMED BY A PIPE LOCATOR AND MANUAL DIGGING. ALL OR ANY


GENERAL INFORMATION ONLY AND THE ACCURACY OF INFORMATION CONTAINED ON THE DOCUMENT IS NO WAY GUARANTEED BY THE CITY.


		ASSOCIATED ENGINEERING	1	2		Province of British MINISTRY OF TRANSPORTATION BRIDGE ENGINEERING	AND HIGHWAYS
	CALE AS	NOTED	DESIGNED N.C. CHECKED D.I.H. DRAWN C.C.	DATE OCT. 95 DATE OCT. 95 DATE OCT. 95		SOUTH COAST REGION MARINER WAY OVERHEAD	40.00
Rev	Dote	Description		Init	JOHNSON	MARINER CONNECT	OR NO. 2927
A	11,20,95	100% SUBMISSION			PIFR	REINFORCING DETAIL	S SHT 2
В	12,07,95	ISSUED FOR CONSTRUCTION					-5 5mm. & 7m
C	12,22,95	REINFORCING REVISED			PREPARED BY	RECOMMENDED	ACCEPTED FOR CONSTRUCTION
D	SEPT.96	AS CONSTRUCTED					· Parti
					DATE	DIRECTOR OF BRIDGE ENGINEERING	CHEP HOHMAY ENGRICER
		REVISIO	N S		FILE No.	NEGATIVE No. RE	


 \oplus

 \oplus

 \oplus

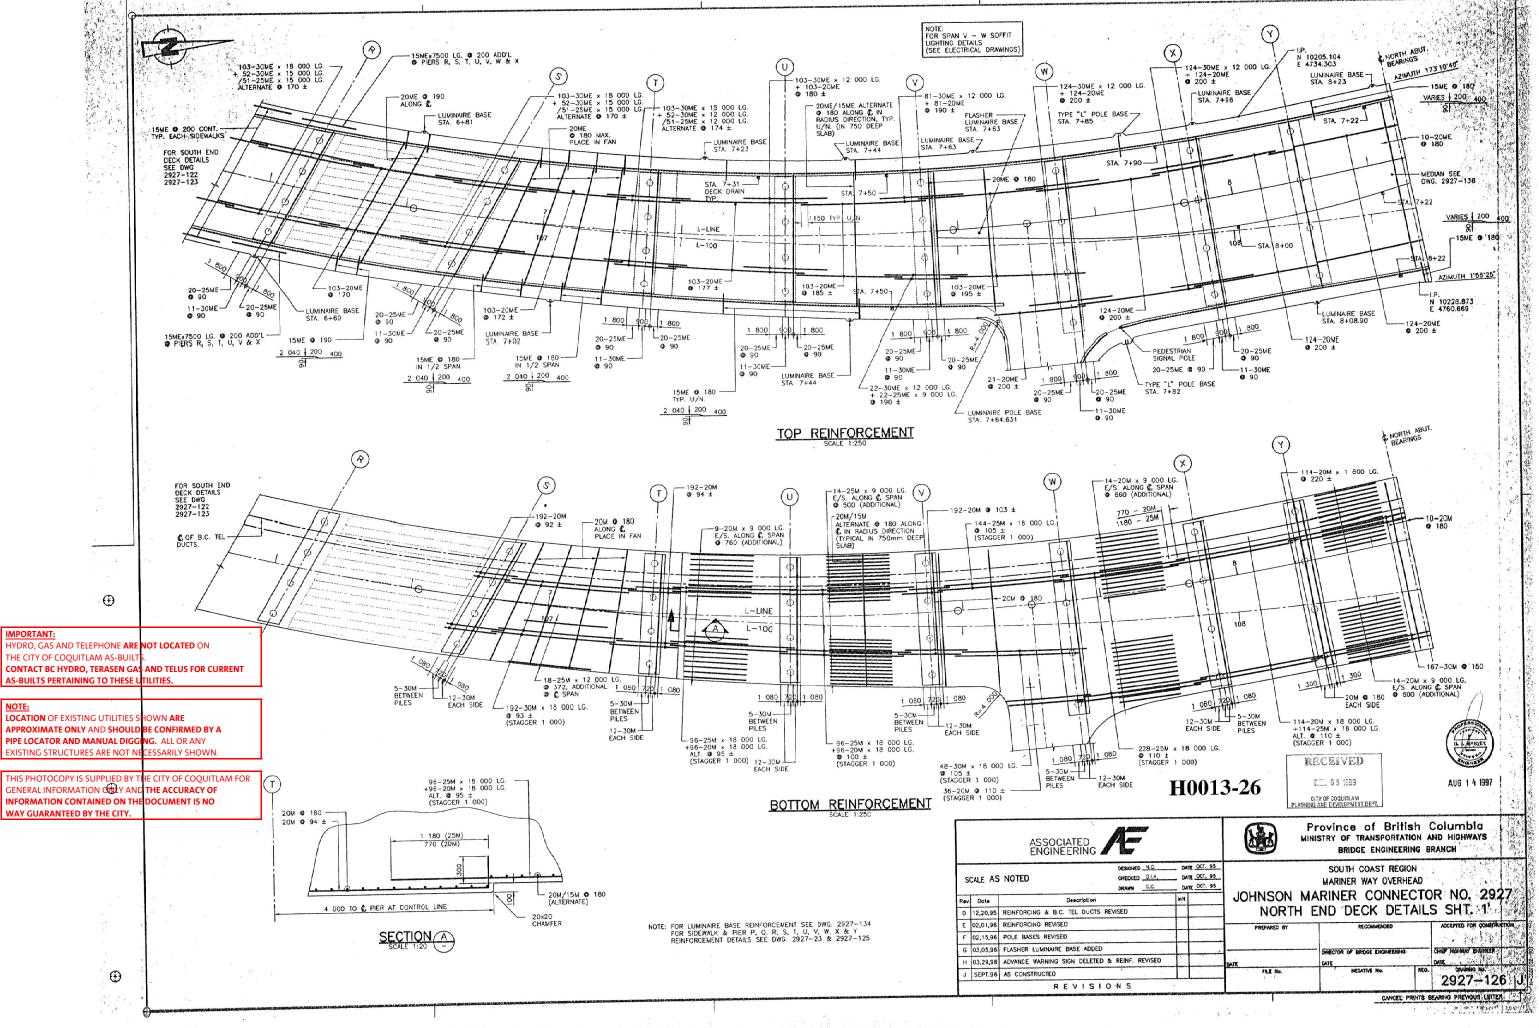

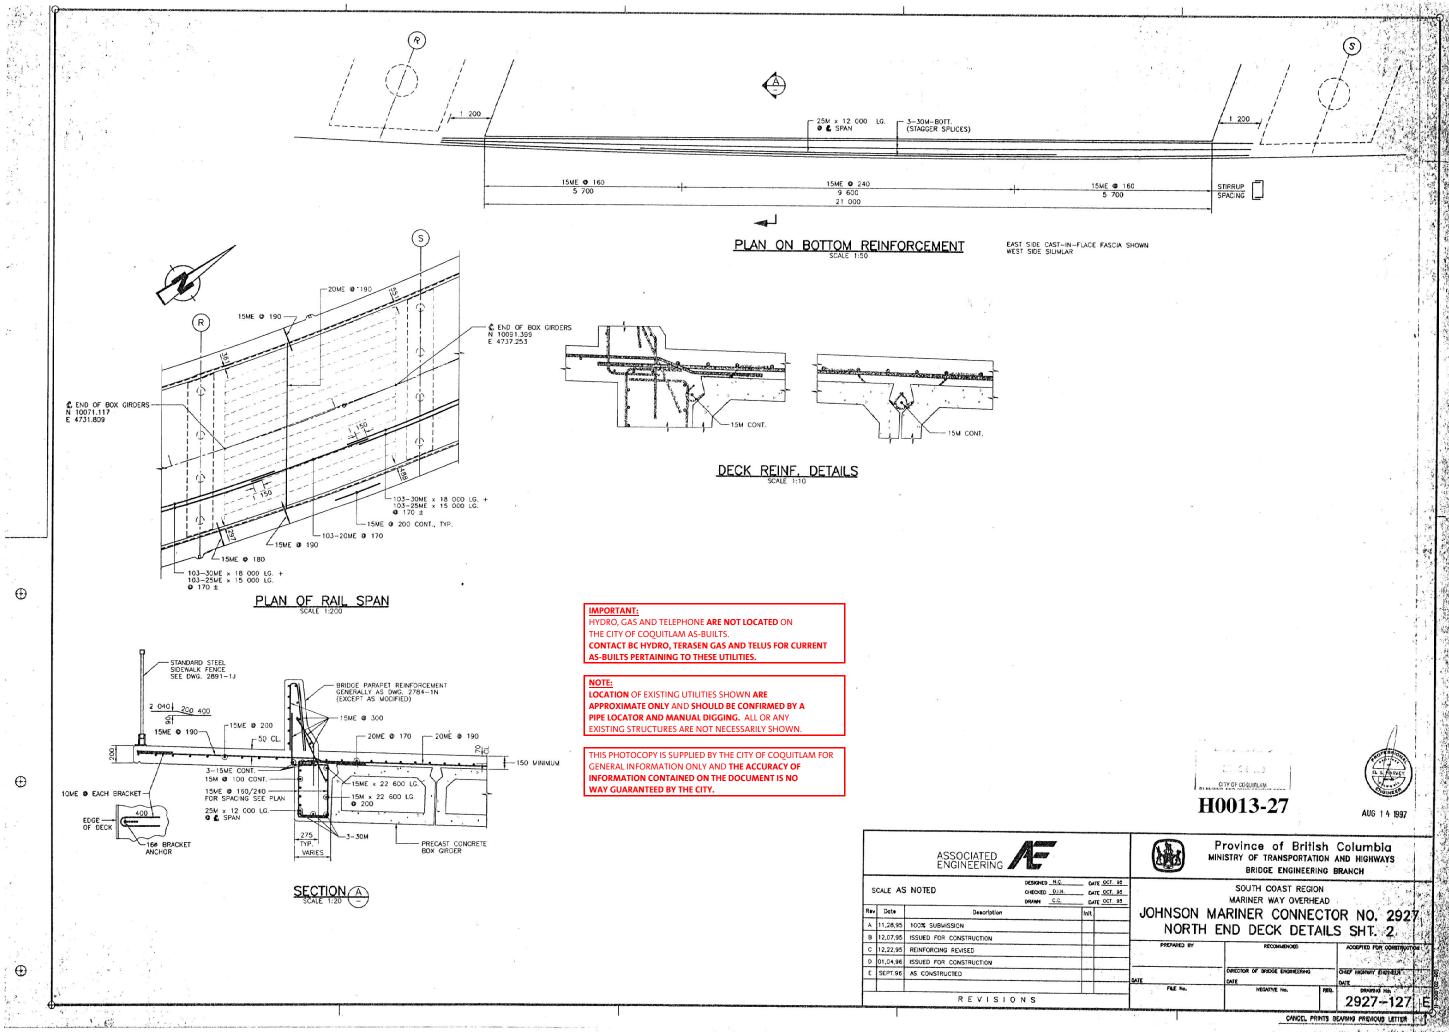

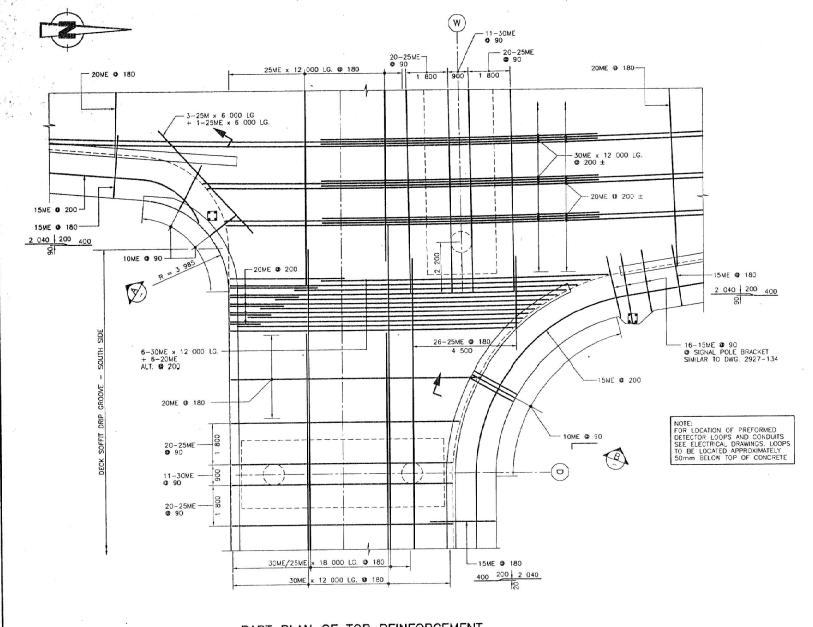

3-15ME 15M © 100 SECTION A 15M © 100 20M © 105 ± 3-15ME 15M © 200 CONT. 15M © 100 CONT. SPLICE 820 10ME © 820 10ME © 180 10ME © 180

SECTION B SCALE 1:20 - VARIES

390

5ME @ 200

- 50 CL.

PART PLAN OF TOP REINFORCEMENT

 \oplus

 \oplus

 \oplus

IMPORTANT:

HYDRO, GAS AND TELEPHONE ARE NOT LOCATED ON THE CITY OF COQUITLAM AS-BUILTS.

CONTACT BC HYDRO, TERASEN GAS AND TELUS FOR CURRENT AS-BUILTS PERTAINING TO THESE UTILITIES.

NOTE:

LOCATION OF EXISTING UTILITIES SHOWN ARE

APPROXIMATE ONLY AND SHOULD BE CONFIRMED BY A

PIPE LOCATOR AND MANUAL DIGGING. ALL OR ANY

EXISTING STRUCTURES ARE NOT NECESSARILY SHOWN.

THIS PHOTOCOPY IS SUPPLIED BY THE CITY OF COQUITLAM FOR GENERAL INFORMATION ONLY AND THE ACCURACY OF INFORMATION CONTAINED ON THE DOCUMENT IS NO WAY GUARANTEED BY THE CITY.

H0013-28

RECEIVED

DEC 0 9 1999


CITY OF COQUITLAM
PLANNING AND DEVELOPMENT DEPT.




AUG 1 4 1997

		ASSOCIATED ENGINEERING				The City Co.	rovince of Britis istry of transportation bridge engineerin	ON A	ND HIGHWAYS		
s	CALE AS	NOTED	_ DA	TE NOV. 95 TE NOV. 95 TE NOV. 95	SOUTH COAST REGION MARINER WAY OVERHEAD						
Rev	ev Date Description			init		JOHNSON MARINER CONNECTOR NO. 2927					
Α	11,28,95	100% SUBMISSION				NORTH END DECK DETAILS SHT. 3					
В	B 12,07,95 ISSUED FOR CONSTRUCTION					PREPARED BY RECONVENCED ACCEPTED FOR CONSTR					
C	12,19,95	LOOP NOTE ADDED							1.39		
D	01,04,96	REBAR SIZE REVISED					DRECTOR OF BRIDGE ENGINEERING		CHIEF HIGHWAY ENGINEER 3		
Ε	SEPT.96	AS CONSTRUCTED] _{OATE}	DATE	3	DATE		
						FILE No.	NEGATIVE No.	REQ.	DRAWING NA.		
		REVISIO	NS						2927-128 E		



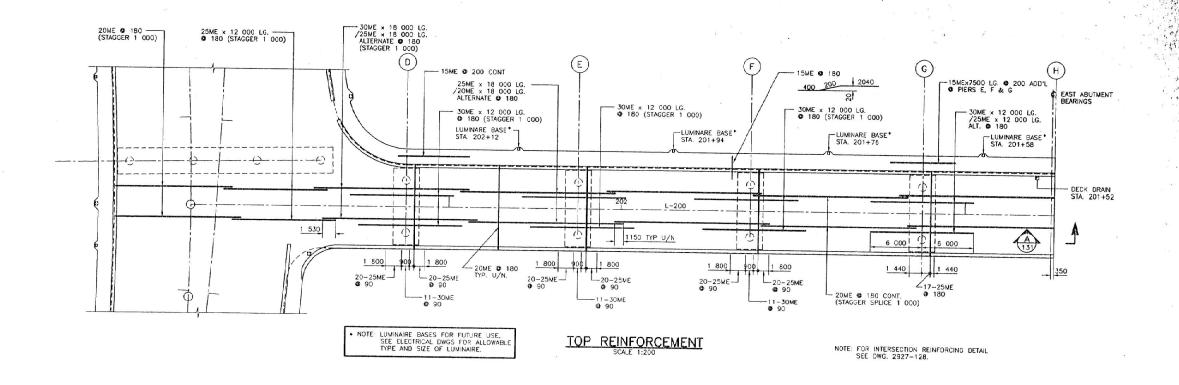

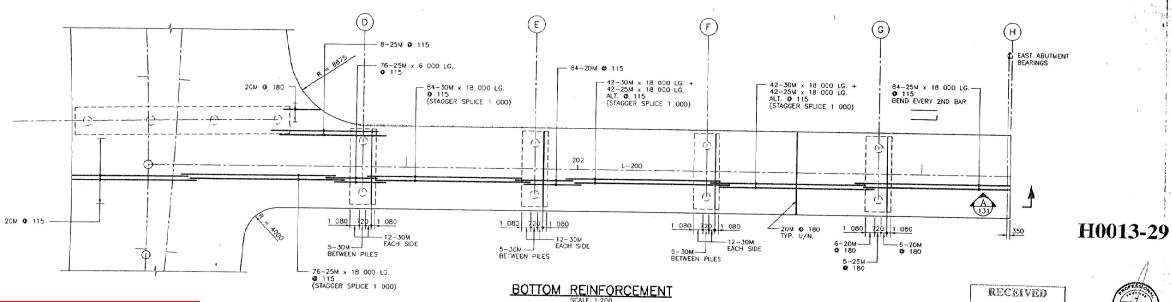

SCALE AS NOTED

A 11,28,95 100% SUBMISSION

D SEPT.96 AS CONSTRUCTED

B 12,07,95 ISSUED FOR CONSTRUCTION

REVISIONS


C 01,04,96 SPLICE NOTE REMOVED

Rev Date

HYDRO, GAS AND TELEPHONE **ARE NOT LOCATED** ON THE CITY OF COQUITLAM AS-BUILTS. CONTACT BC HYDRO, TERASEN GAS AND TELUS FOR CURRENT AS-BUILTS PERTAINING TO THESE UTILITIES.

LOCATION OF EXISTING UTILITIES SHOWN ARE APPROXIMATE ONLY AND SHOULD BE CONFIRMED BY A PIPE LOCATOR AND MANUAL DIGGING. ALL OR ANY XISTING STRUCTURES ARE NOT NECESSARILY SHOWN

GENERAL INFORMATION ONLY AND THE ACCURACY OF INFORMATION CONTAINED ON THE DOCUMENT IS NO WAY GUARANTEED BY THE CITY.

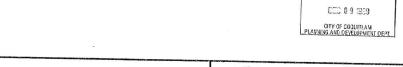

AUG 1 4 1997

Province of British Columbia MINISTRY OF TRANSPORTATION AND HIGHWAYS BRIDGE ENGINEERING BRANCH CHECKED D.I.H. DATE NOV. 95
DRAWN C.C. DATE NOV. 95 SOUTH COAST REGION

MARINER WAY OVERHEAD JOHNSON MARINER CONNECTOR NO. 2927 EAST RAMP DECK DETAILS SHT. 1

2927-129


CANCEL PRINTS BEARING PREVIOUS LETTER


 \oplus

19.


 \oplus

•

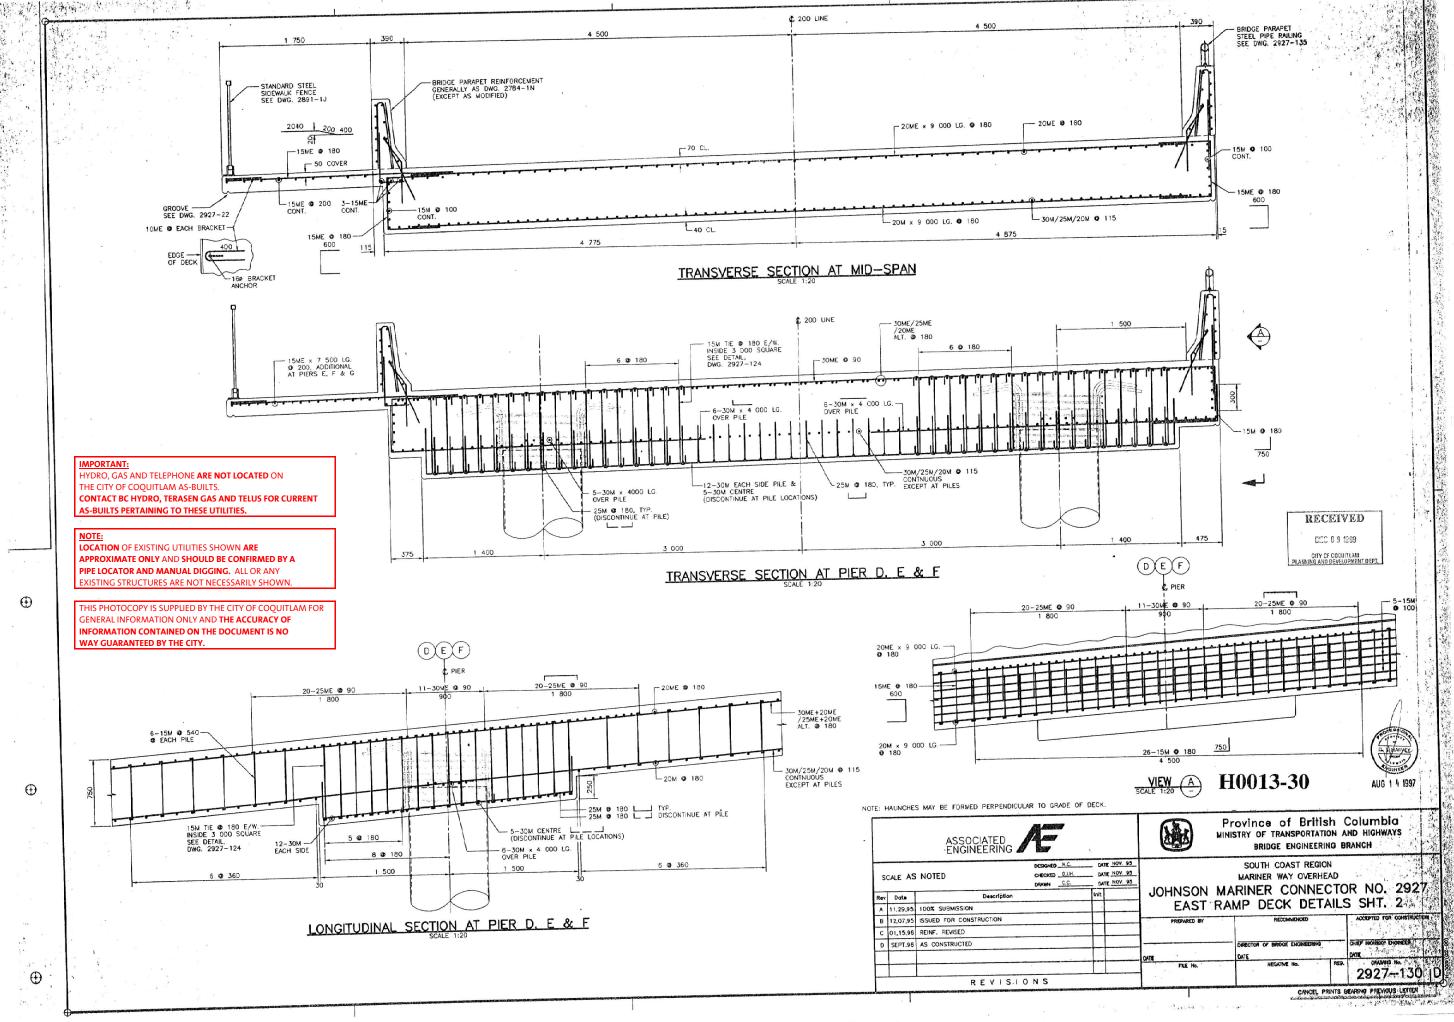

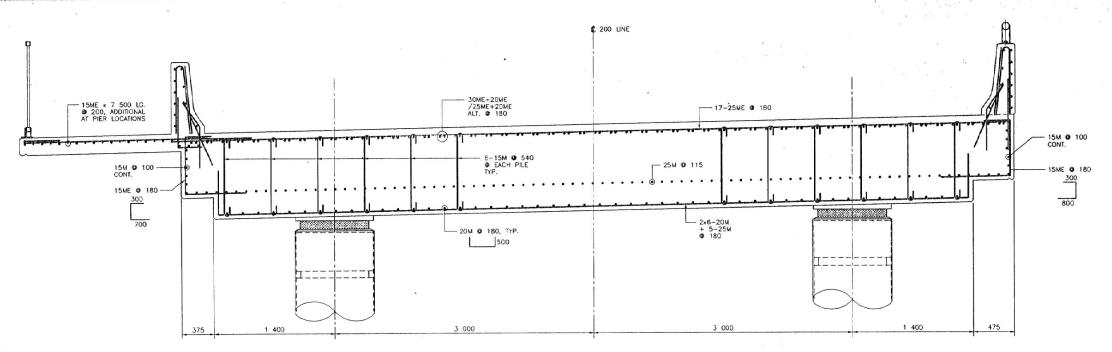

TRANSVERSE SECTION AT PIER G

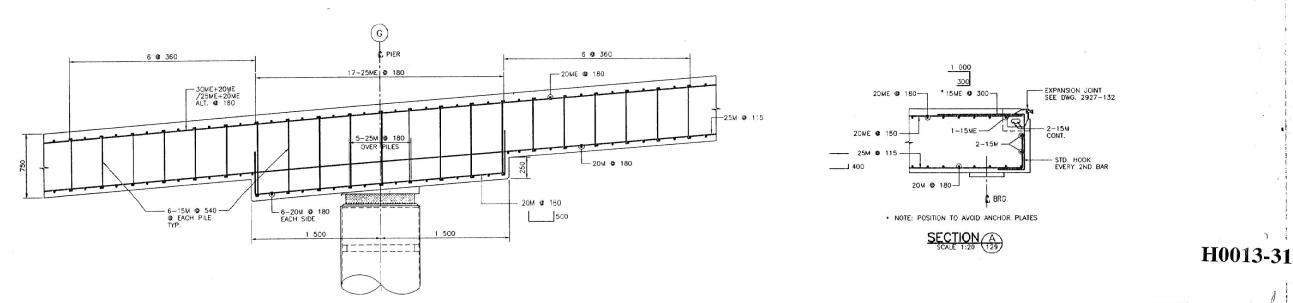

LONGITUDINAL SECTION AT PIER G

IMPORTANT:
HYDRO, GAS AND TELEPHONE ARE NOT LOCATED ON
THE CITY OF COQUITLAM AS-BUILTS.
CONTACT BC HYDRO, TERASEN GAS AND TELUS FOR CURRENT

AS-BUILTS PERTAINING TO THESE UTILITIES.

NOTE

LOCATION OF EXISTING UTILITIES SHOWN ARE
APPROXIMATE ONLY AND SHOULD BE CONFIRMED BY A
PIPE LOCATOR AND MANUAL DIGGING. ALL OR ANY
EXISTING STRUCTURES ARE NOT NECESSARILY SHOWN.

THIS PHOTOCOPY IS SUPPLIED BY THE CITY OF COQUITLAM FOR GENERAL INFORMATION ONLY AND THE ACCURACY OF INFORMATION CONTAINED ON THE DOCUMENT IS NO WAY GUARANTEED BY THE CITY.

NOTE: HAUNCHES MAY BE FORMED PERPENDICULAR TO GRADE.







		ASSOCIATED ENGINEERING				rovince of British ISTRY OF TRANSPORTATION A BRIDGE ENGINEERING E	AND HIGHWAYS
SCALE AS NOTED OESGRED N.C. DATE NOV. 95 OFFICIAL DATE NOV. 95 OFFICIAL DATE NOV. 95 OFFICIAL DATE NOV. 95 MARINER WAY OVERHEAD							
Rev	Date	Description	Init		JOHNSON MA	ARINER CONNECTO	OR NO. 2927
A	11,29,95	100% SUBMISSION			EAST RA	MP DECK DETAILS	S SHT. 3
В	12,07,95	ISSUED FOR CONSTRUCTION			PREPARED BY	RECOMMENDED	ACCEPTED FOR CONSTINUCTION
С	SEPT.96	AS CONSTRUCTED .			T COLUMN III	RECOMMENDED	note it to the constitution
					1		
					DATE	DATE	CATE
		w.			FILE No.	NEGATIVE No. REG.	DRAWING No.
Г		REVISIONS			1		2927-131 C

CANCEL PRINTS BEARING PREYOUS LETTER

 \oplus

 \oplus

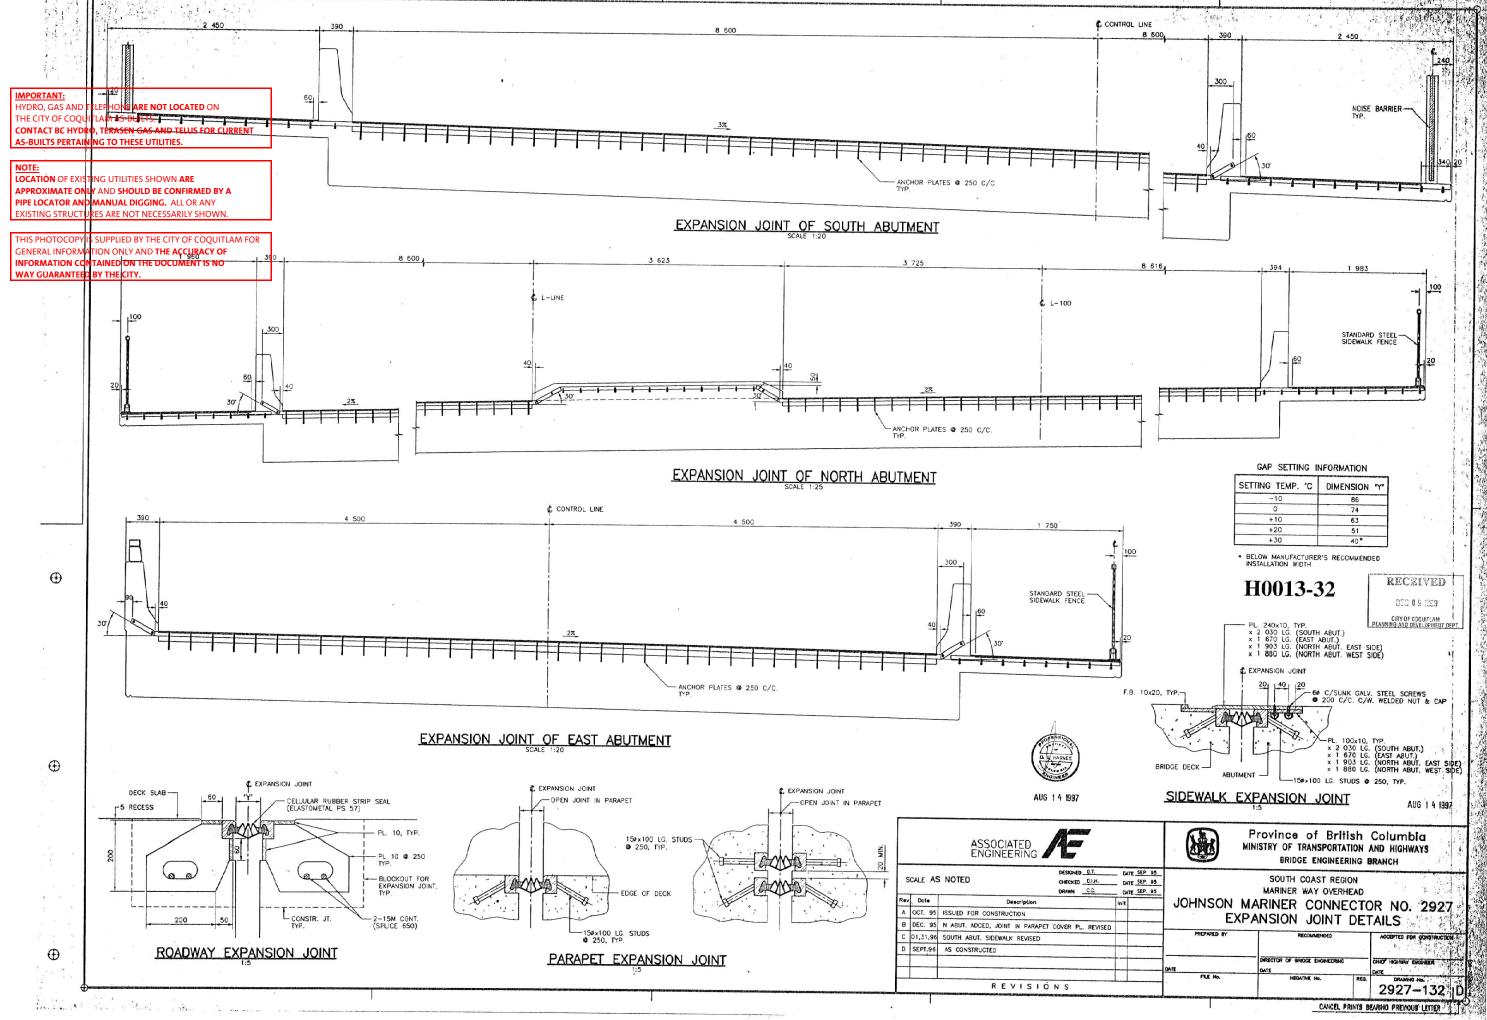

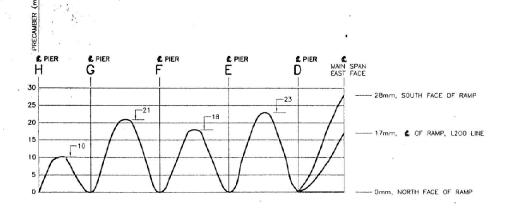


EAST RAMP PRECAMBER

HORIZONTAL SCALE = 1:500 VERTICAL SCALE = 1:0.5

 \oplus

 \oplus

⊕

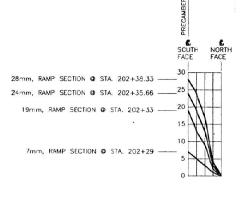

INTERSECTION DETAIL HORIZONTAL SCALE = 1:500


VERTICAL SCALE = 1:0.5

IMPORTANT:

HYDRO, GAS AND TELEPHONE **ARE NOT LOCATED** ON THE CITY OF COQUITLAM AS-BUILTS. CONTACT BC HYDRO, TERASEN GAS AND TELUS FOR CURRENT AS-BUILTS PERTAINING TO THESE UTILITIES.

LOCATION OF EXISTING UTILITIES SHOWN **ARE** APPROXIMATE ONLY AND SHOULD BE CONFIRMED BY A PIPE LOCATOR AND MANUAL DIGGING. ALL OR ANY EXISTING STRUCTURES ARE NOT NECESSARILY SHOWN

HIS PHOTOCOPY IS SUPPLIED BY THE CITY OF COQUITLAM FOR GENERAL INFORMATION ONLY AND THE ACCURACY OF INFORMATION CONTAINED ON THE DOCUMENT IS NO WAY GUARANTEED BY THE CITY.

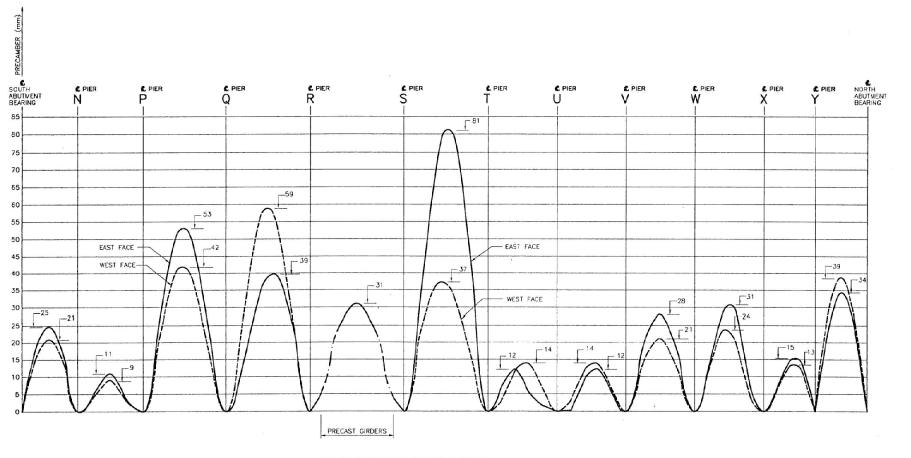


RECEIVED

DEC 0 9 1999

CITY OF COOUTLAM
PLANNING AND DEVELOPMENT DEPT.

NOTES:

- EAST/WEST FACE REFERRING TO FAR EAST/WEST POINT
ON THE BOTTOM OF THE BRIDGE DECK.
- DEFLECTION ARE CONSTANT IN ANY CROSS SECTION IN
RAMP EXCEPT IN SECTION BETWEEN PIER D TO INTERSECTION,
SEE INTERSECTION DETAIL.
- IN ANY CROSS SECTION ON THE MAIN SPAN DEFLECTION IS
LINEAR BETWEEN EAST AND WEST FACE.

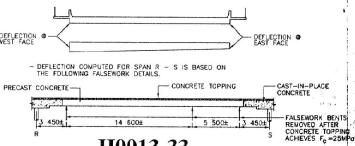

H0013-33

AUG 1 4 1997

MAIN BRIDGE PRECAMBER

HORIZONTAL SCALE = 1:500 VERTICAL SCALE = 1:0.5



ASSOCIATED ENGINEERING DESIGNED N.C. DATE DEC. 95 SCALE AS NOTED DATE DEC. 95 DATE DEC. 95 Rev Date Description A 12,22,95 100% SUBMISSION B 01,05,96 ISSUED FOR CONSTRUCTION C SEPT.96 AS CONSTRUCTED

REVISIÓNS


Province of British Columbia MINISTRY OF TRANSPORTATION AND HIGHWAYS BRIDGE ENGINEERING BRANCH


SOUTH COAST REGION MARINER WAY OVERHEAD JOHNSON MARINER CONNECTOR NO. 2927


SUPERSTRUCTURE PRECAMBER


DEFECTOR OF BRIDGE FINGRIFFRING 2927-133


CANCEL PRINTS BEARING PREVIOUS LETTER

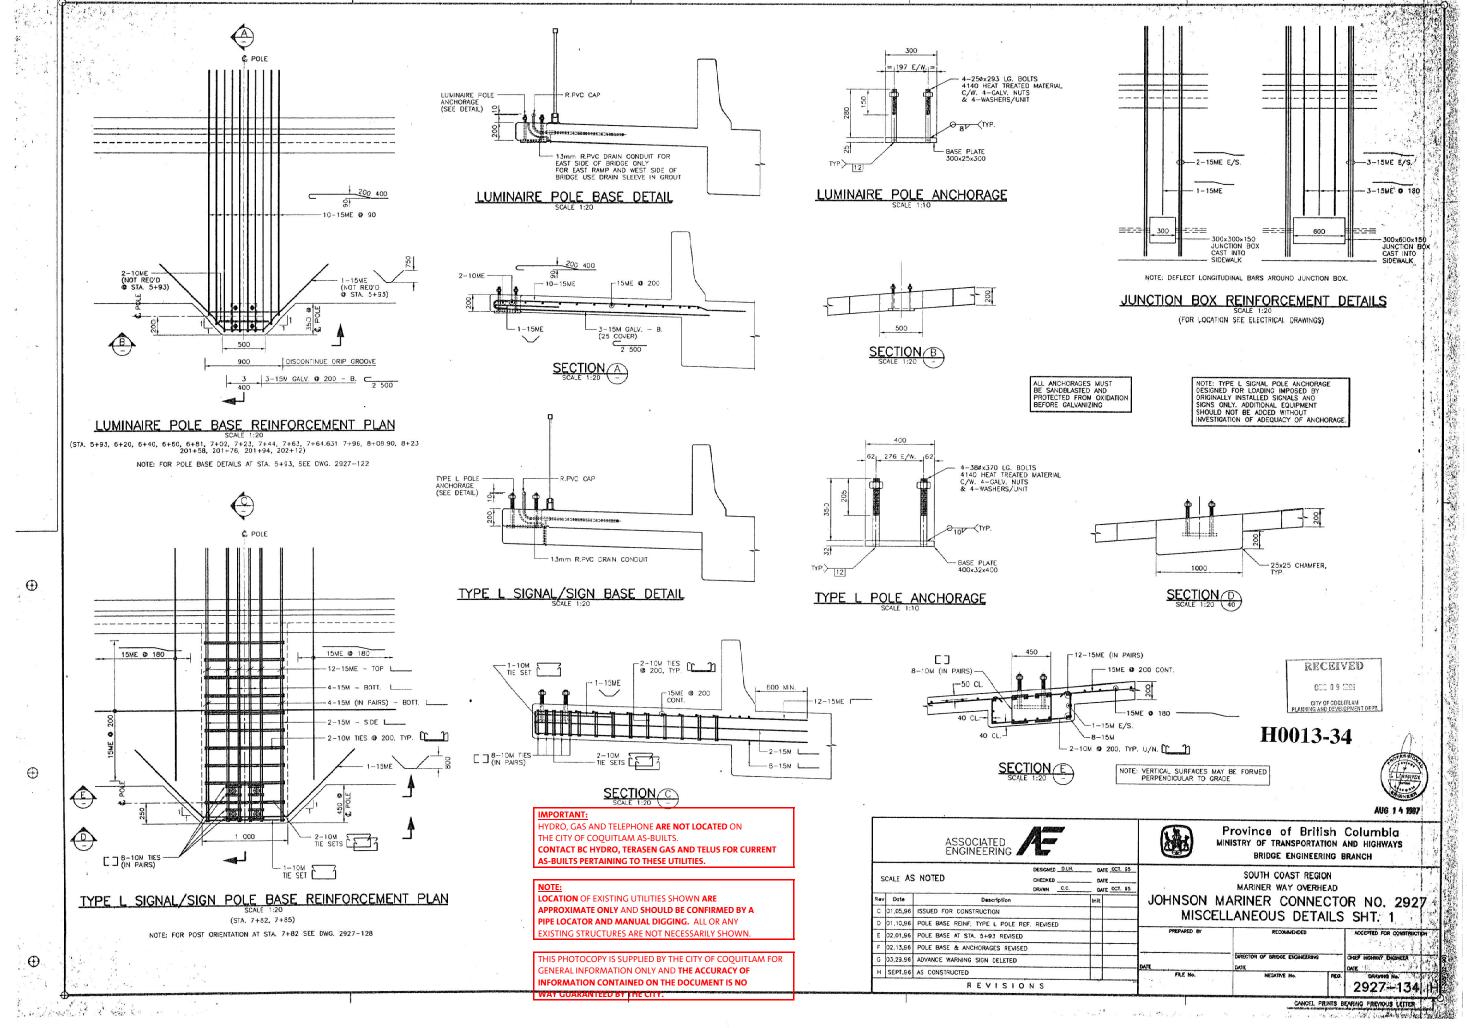


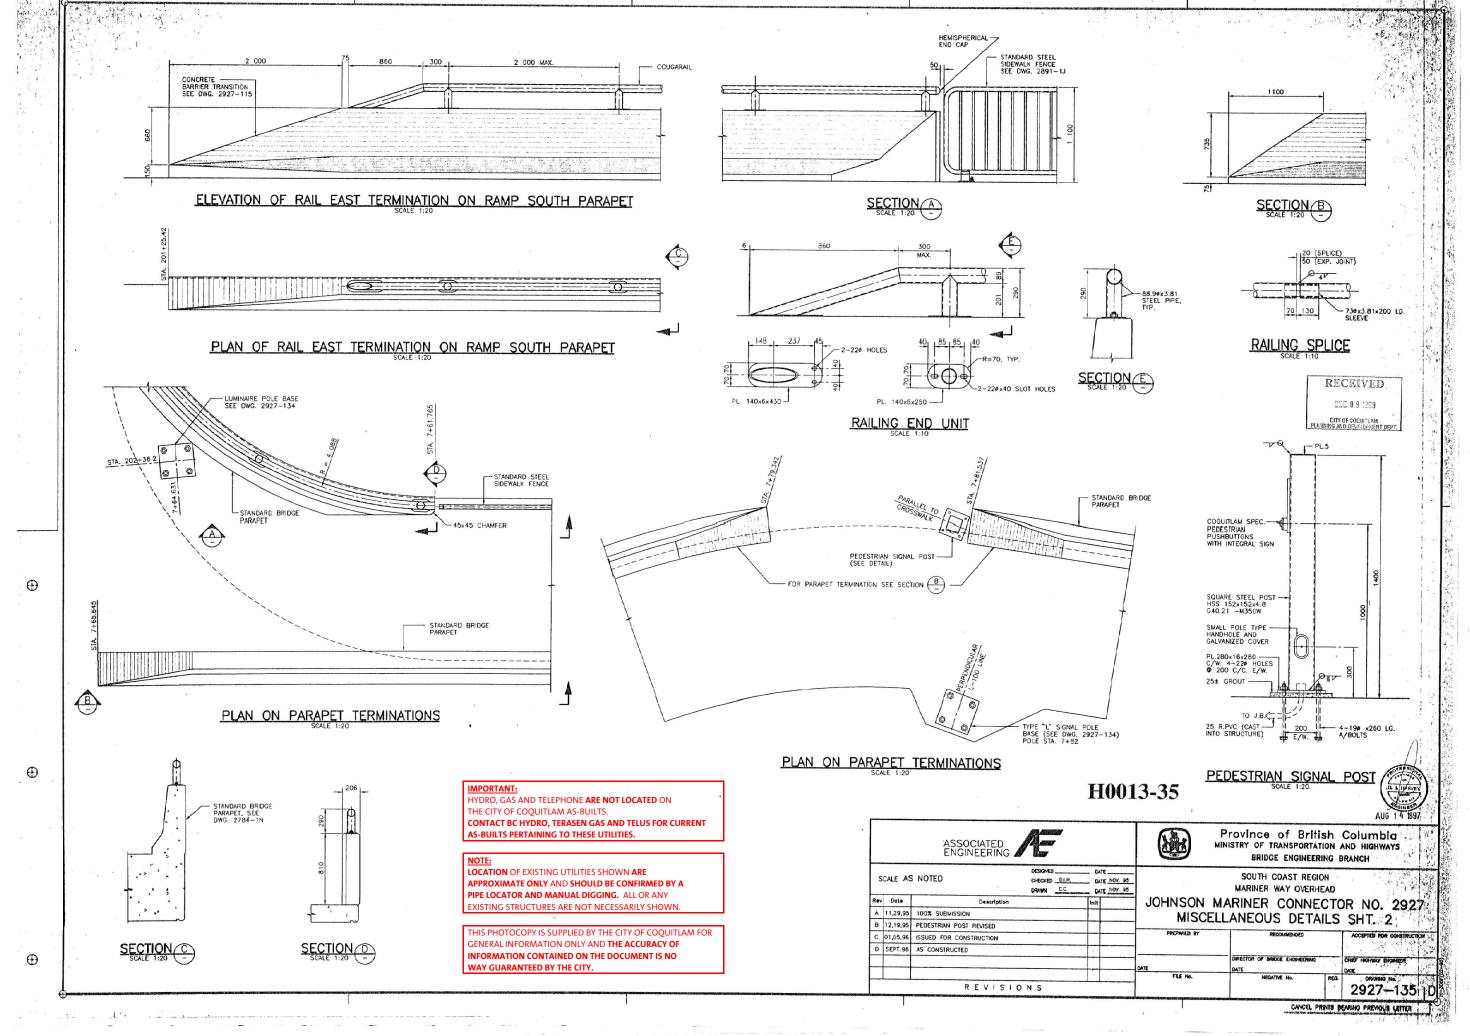

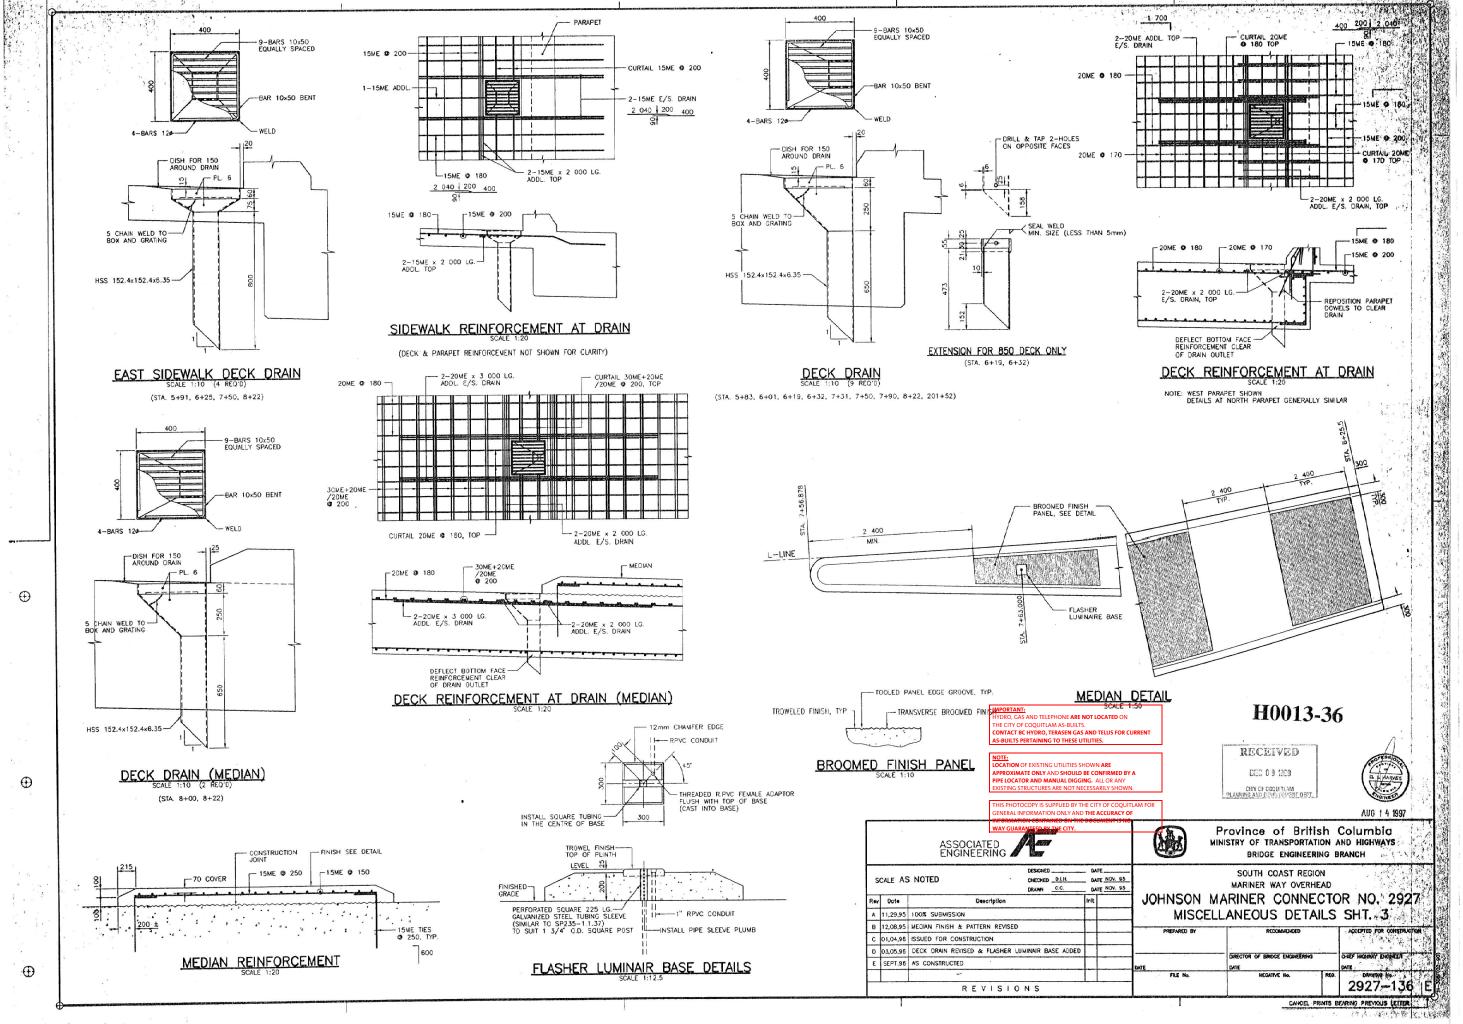

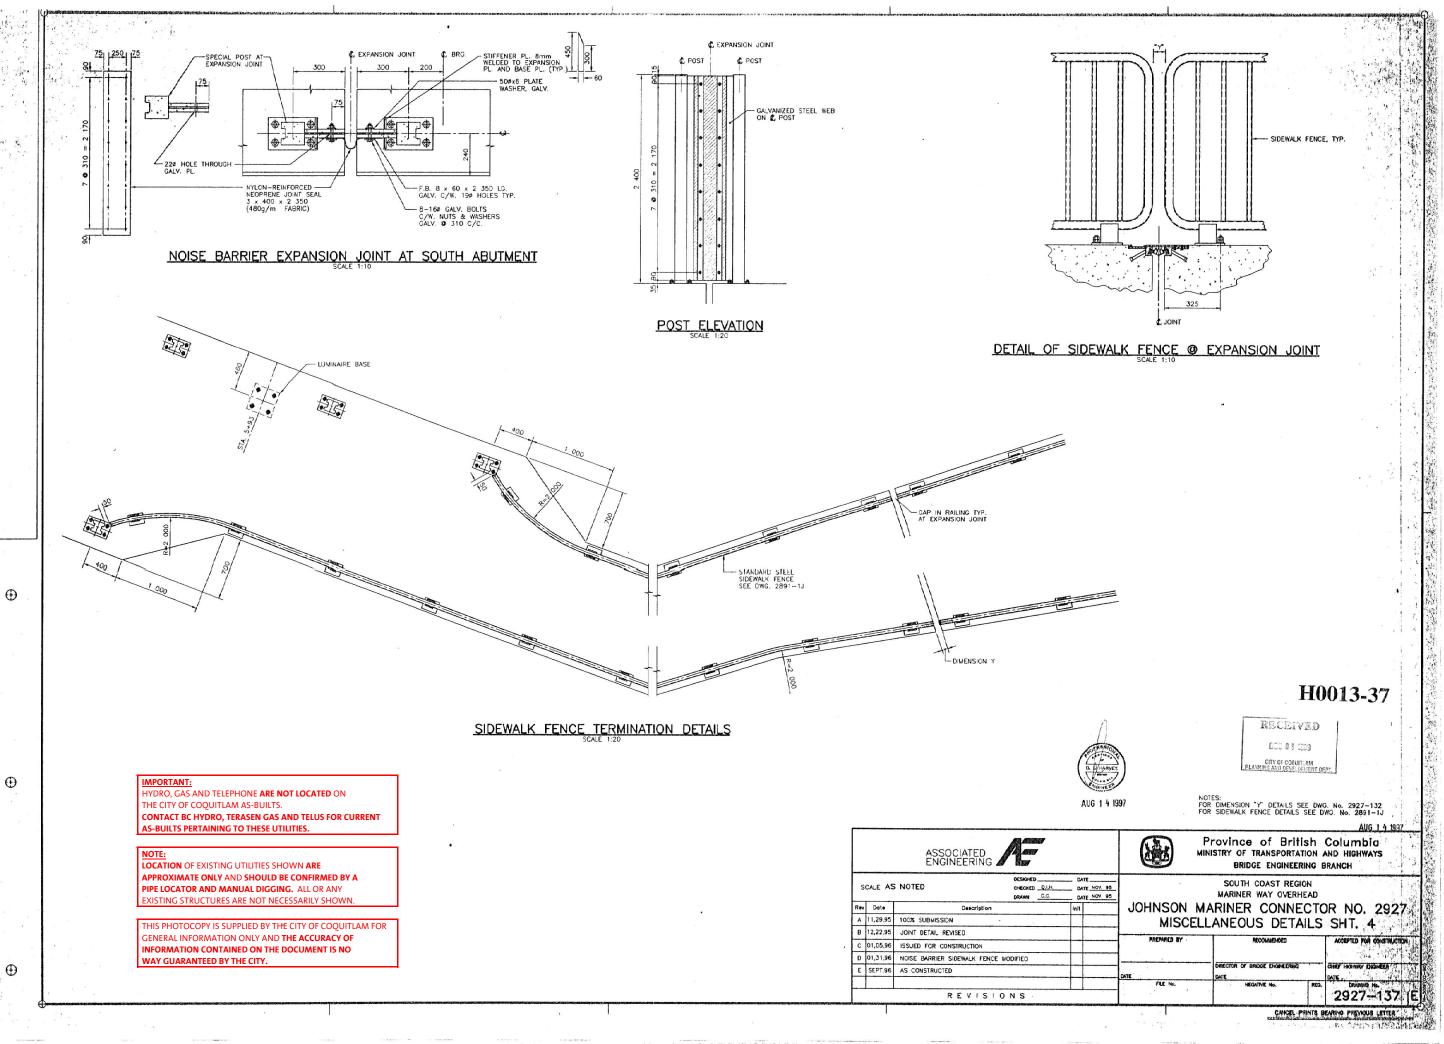

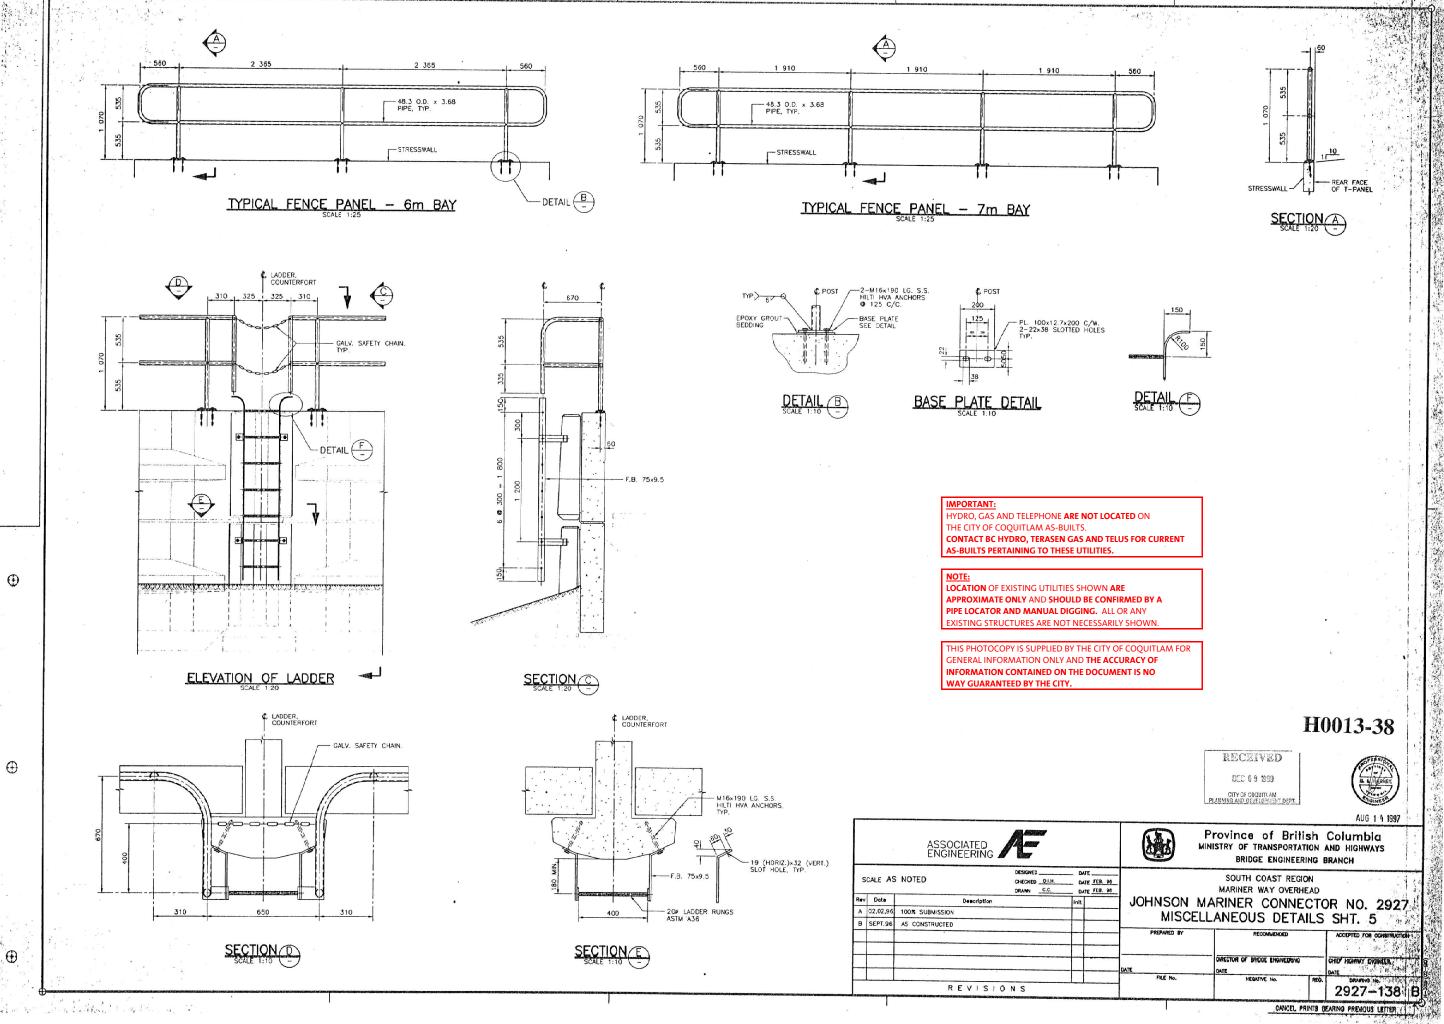

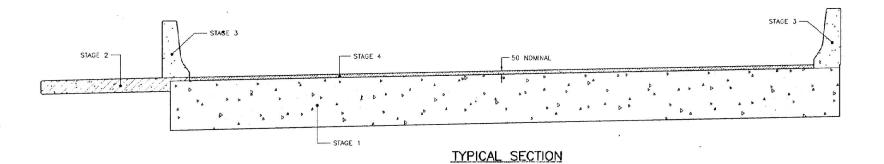

STAGE 3 STAGE 2-STAGE 4 _ 50 NOMINAL PRECAST BOX GIRDERS

- CONCRETE KEYWAYS

RAIL SPAN

STAGES OF CONCRETE PLACEMENT

HYDRO, GAS AND TELEPHONE **ARE NOT LOCATED** ON THE CITY OF COQUITLAM AS-BUILTS.

CONTACT BC HYDRO, TERASEN GAS AND TELUS FOR CURRENT AS-BUILTS PERTAINING TO THESE UTILITIES.

NOTE: LOCATION OF EXISTING UTILITIES SHOWN ARE APPROXIMATE ONLY AND SHOULD BE CONFIRMED BY A PIPE LOCATOR AND MANUAL DIGGING. ALL OR ANY EXISTING STRUCTURES ARE NOT NECESSARILY SHOWN.

THIS PHOTOCOPY IS SUPPLIED BY THE CITY OF COQUITLAM FOR GENERAL INFORMATION ONLY AND THE ACCURACY OF INFORMATION CONTAINED ON THE DOCUMENT IS NO WAY GUARANTEED BY THE CITY.

NOTES:

1. STAGE 2 MUST FOLLOW STAGE 1 BY AT LEAST 24 HOURS
2. STAGES 3 AND 4 MAY BE PLACED WHEN FALSEWORK IS RELEASED ON AFFECTED SPAN AND AJACENT SPANS

H0013-39






		ASSOCIATED ENGINEERING				Province of British INISTRY OF TRANSPORTATION BRIDGE ENGINEERING	AND HIGHWAYS
SC	CALE AS	NOTED	DESIGNED D.I.H. CHECKED DRAWN C.C.	DATE JAN. 95 DATE JAN. 95		SOUTH COAST REGION MARINER WAY OVERHEAD	
Rev	Date	Description		Init	JOHNSON M	MARINER CONNECT	TOR NO. 2927
G	SEPT.96	AS CONSTRUCTED			DECK CONSTRUCTION SEQU		
					PREPARED BY	RECOMMENDED	ACCEPTED FUR CONSTRUCTION
					DATE	DIRECTOR OF BRIDGE ENGINEERING DATE	CHIEF ING MUCE BACHREER ,
		REVISIO	N S	<u> </u>	FILE No.	NEGATIVE No. Pr	2927-139


 \oplus


 \oplus

 \oplus

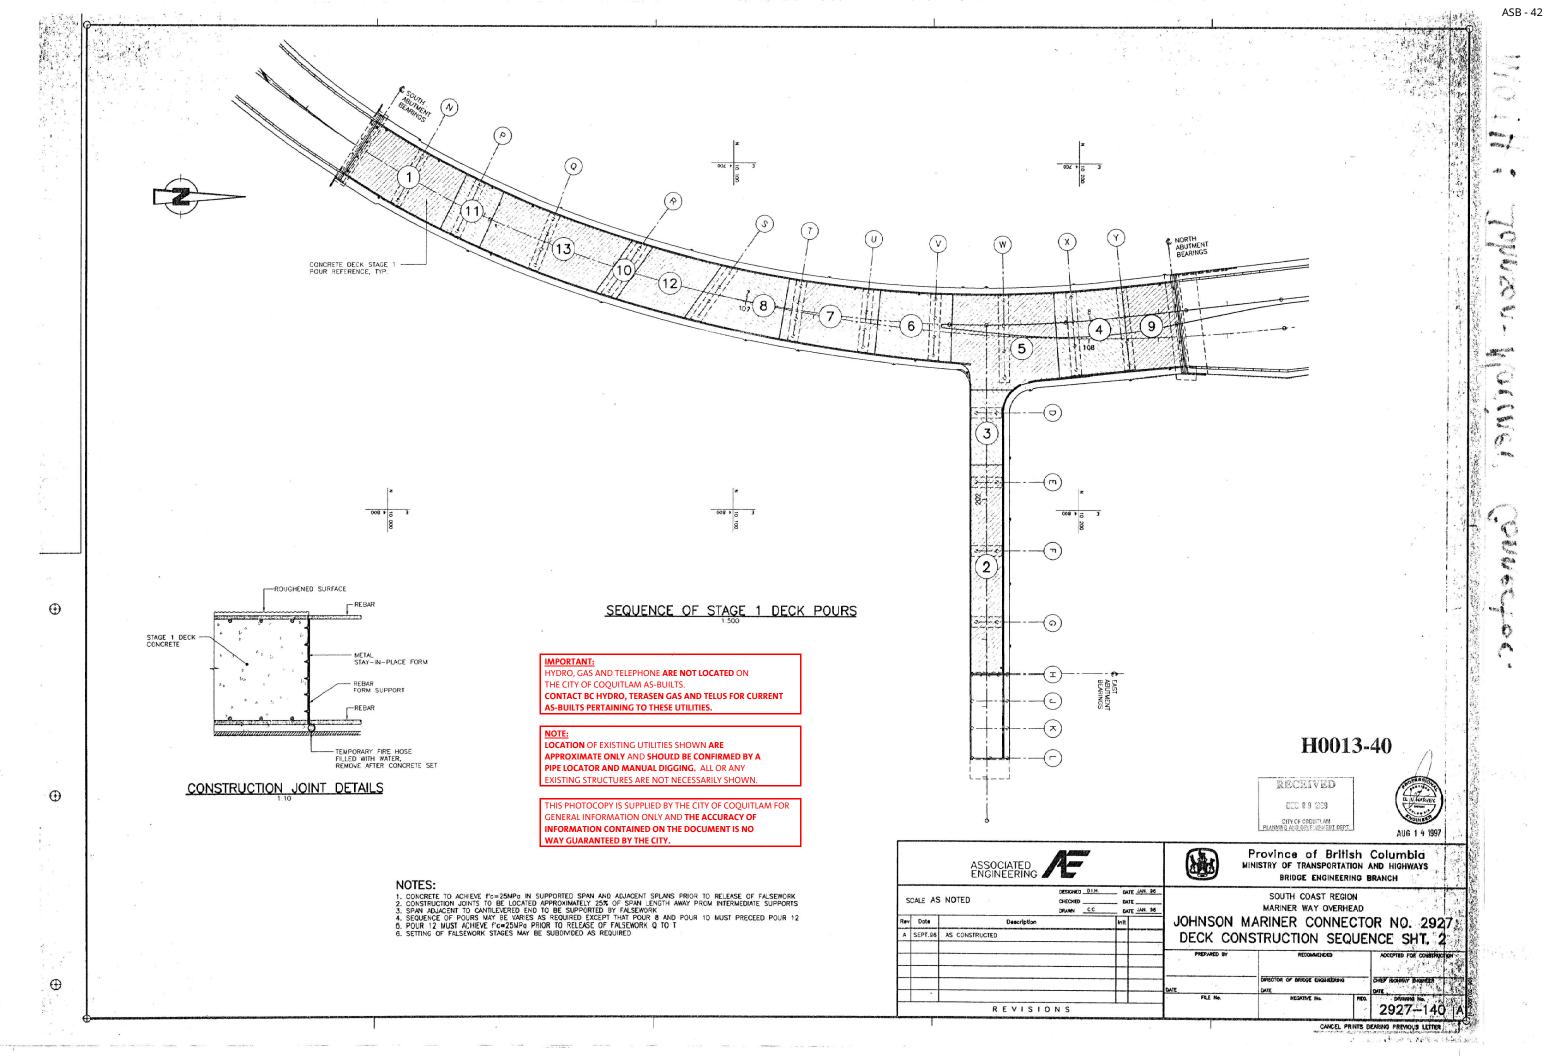


SIDEWALK PAVEMENT AS-BUILT

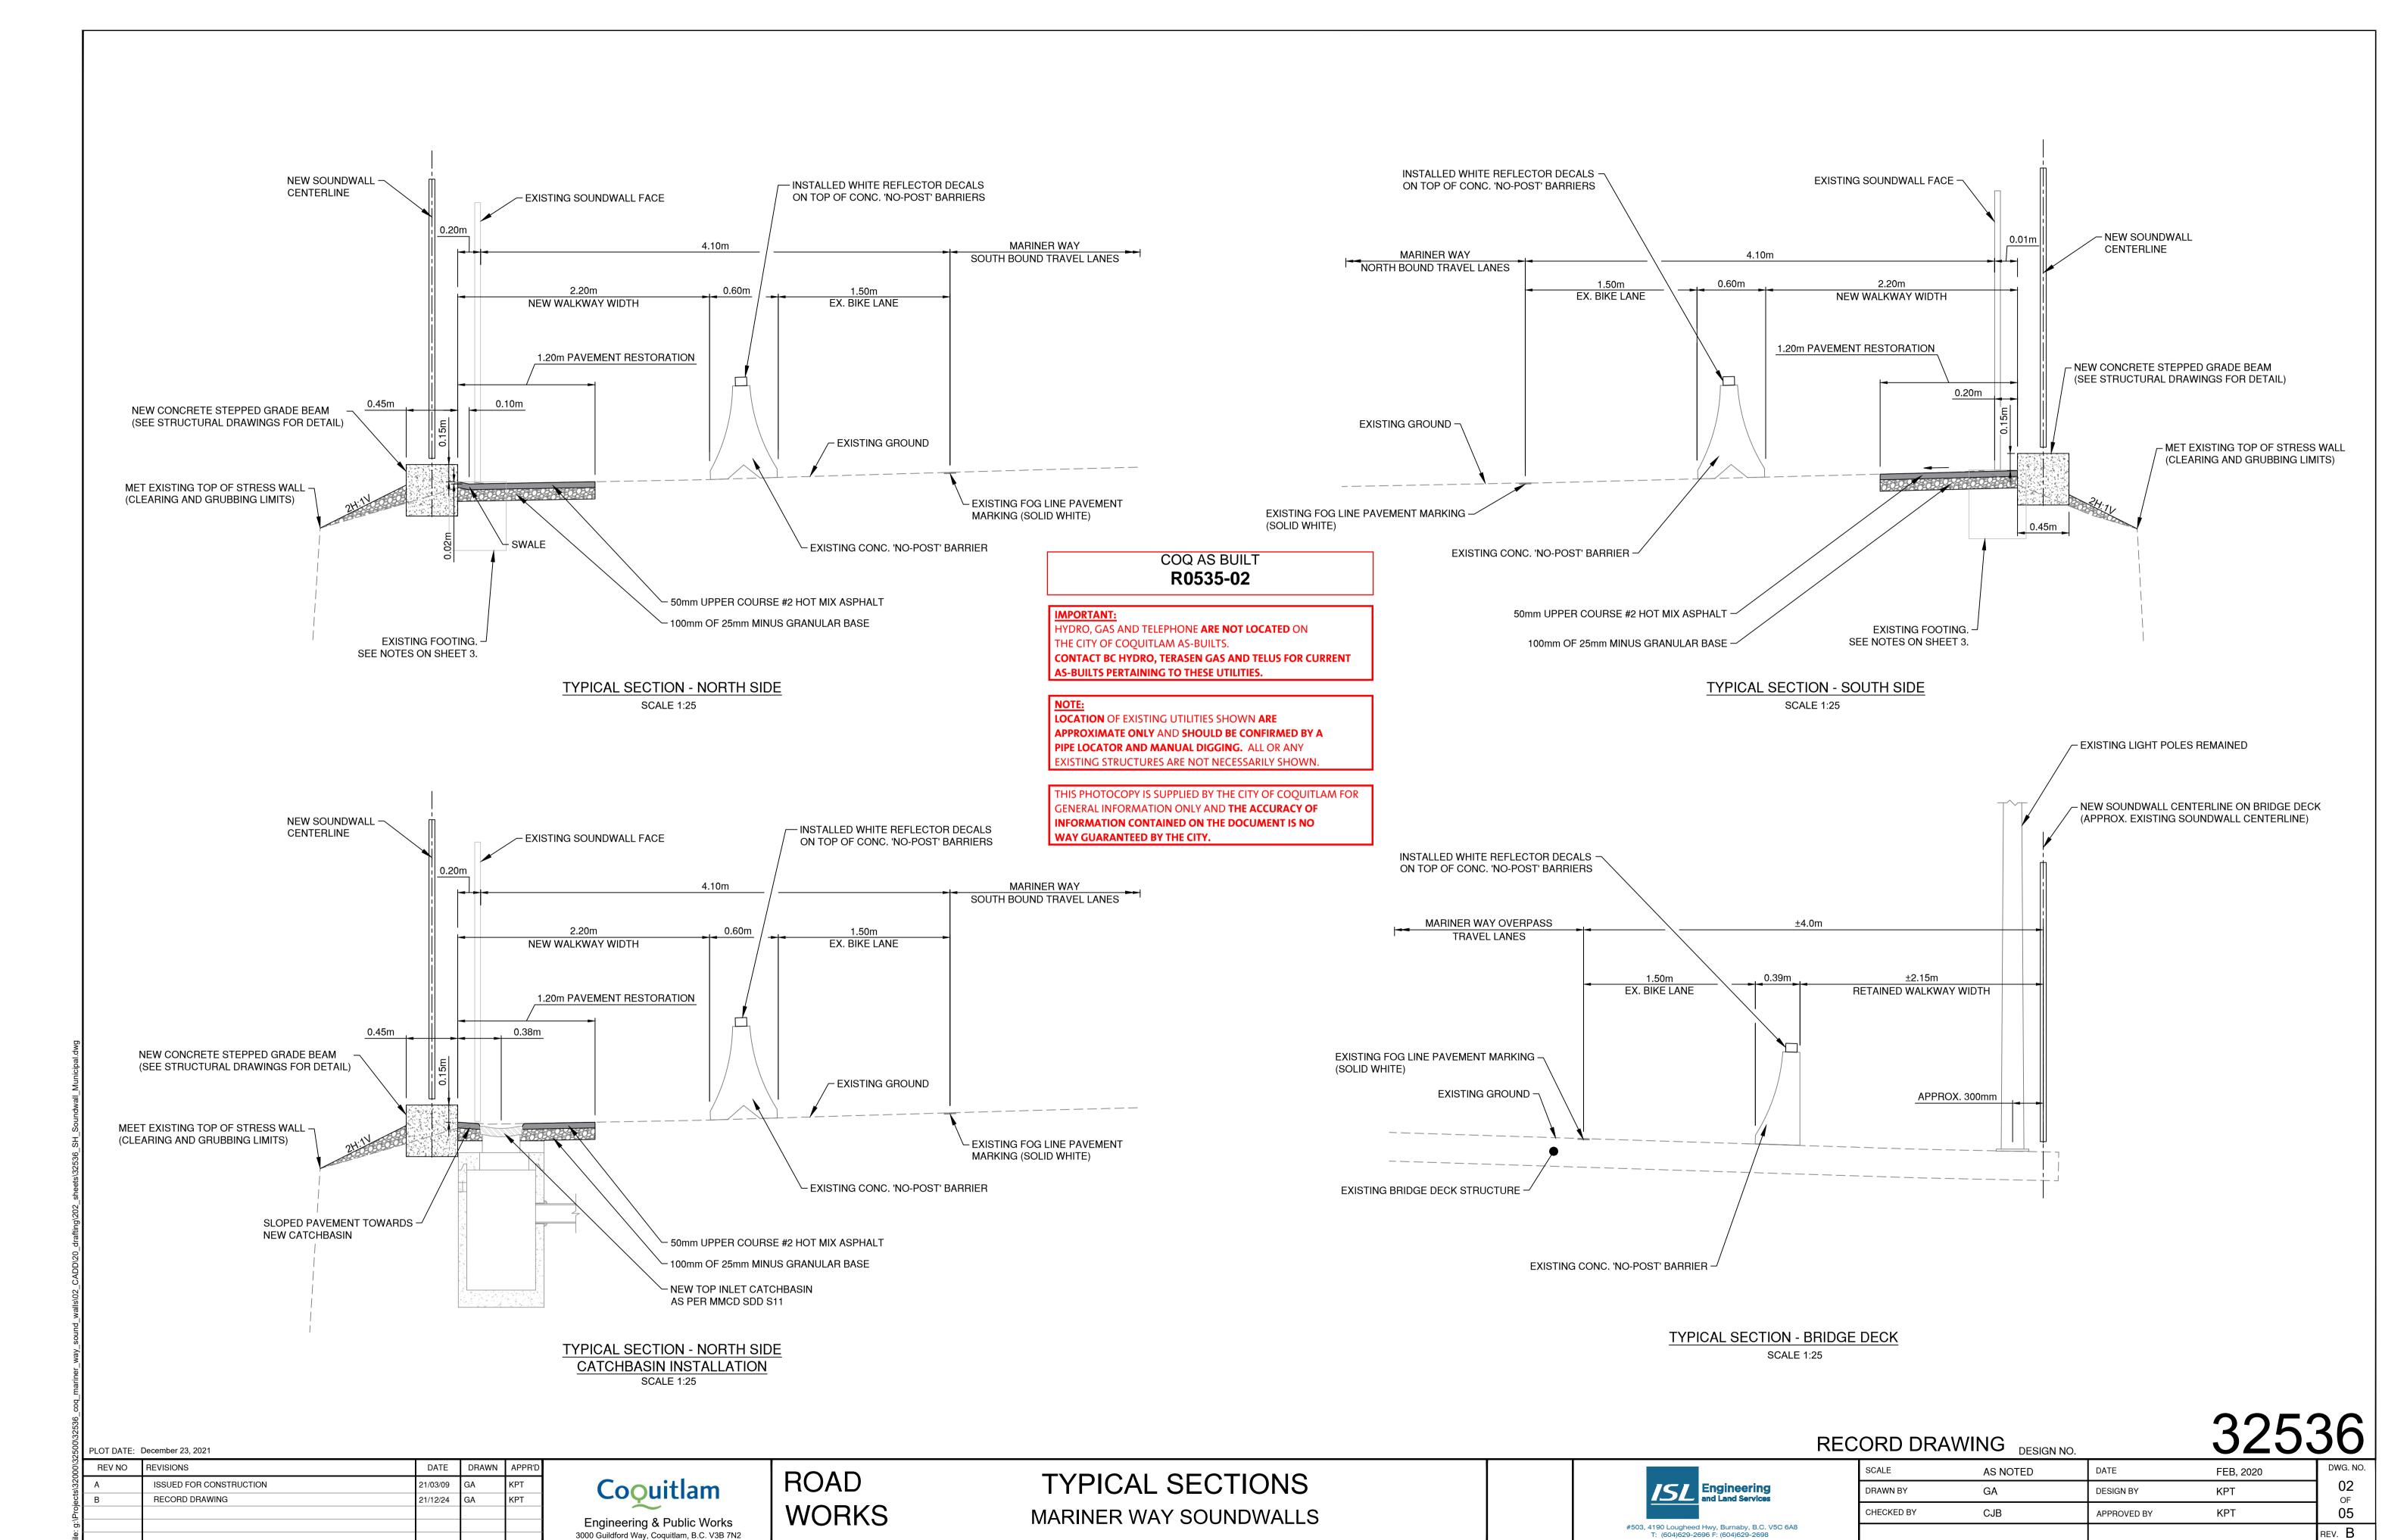


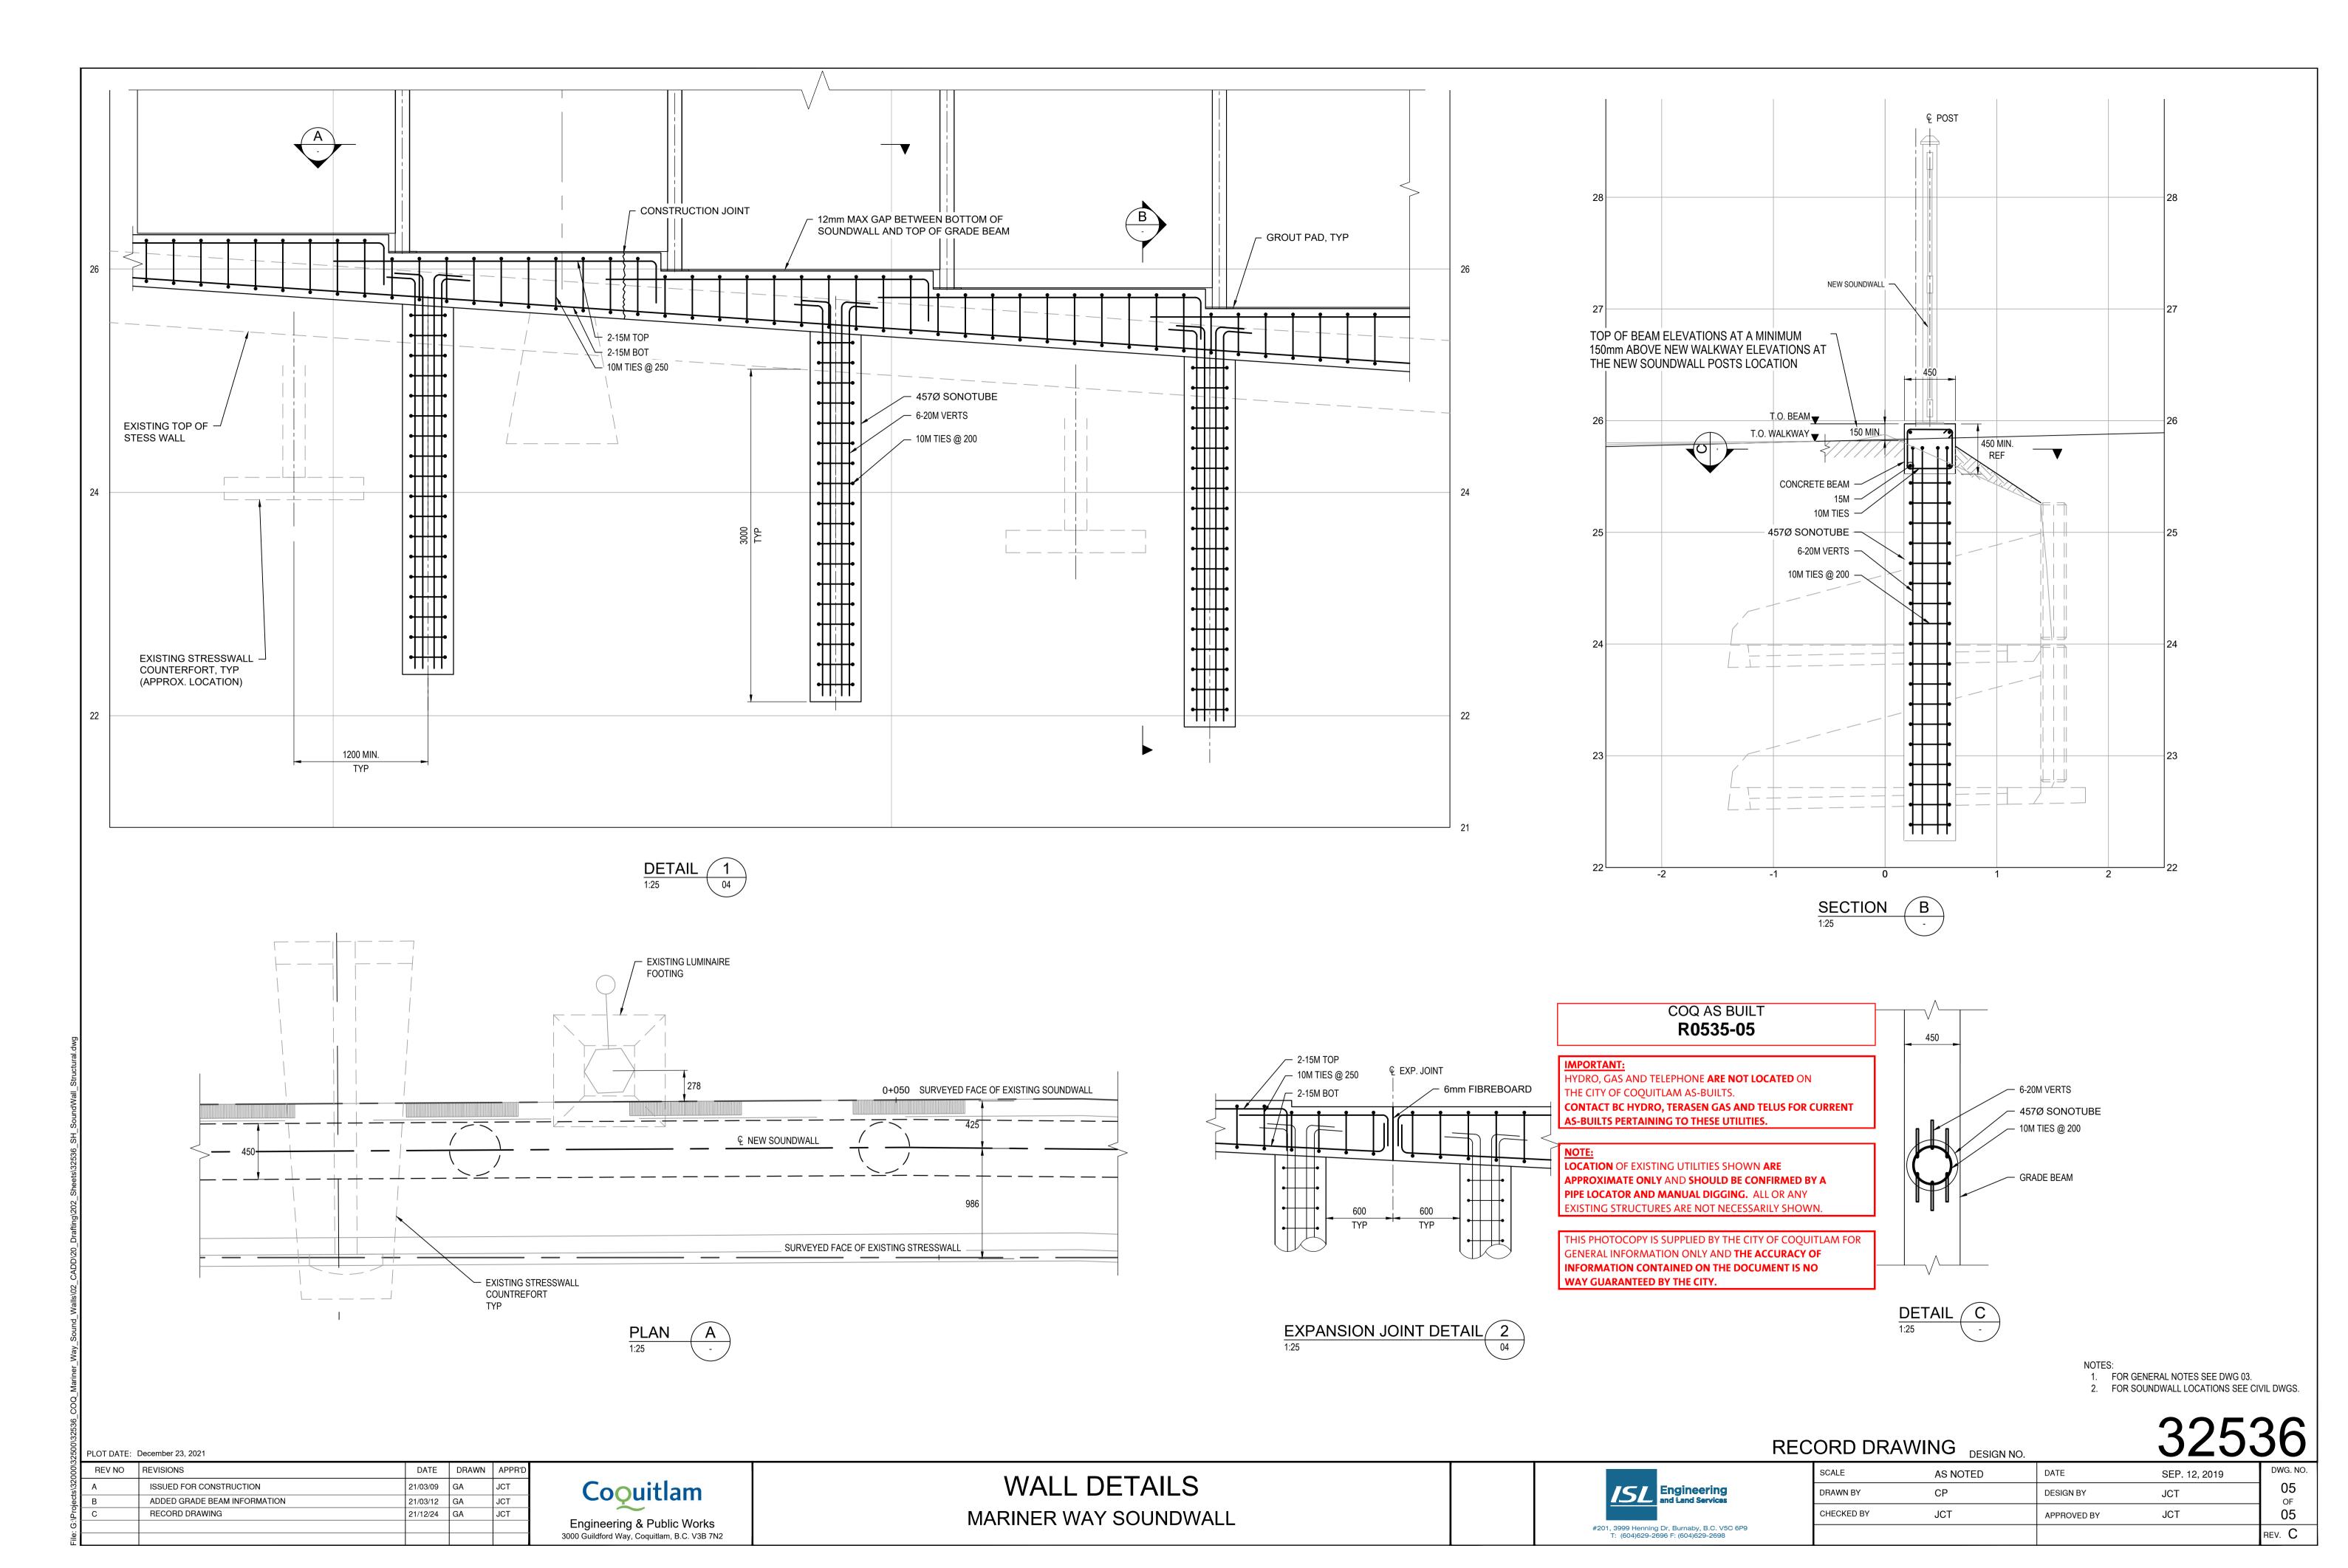

ELECTRICAL AS-BUILT

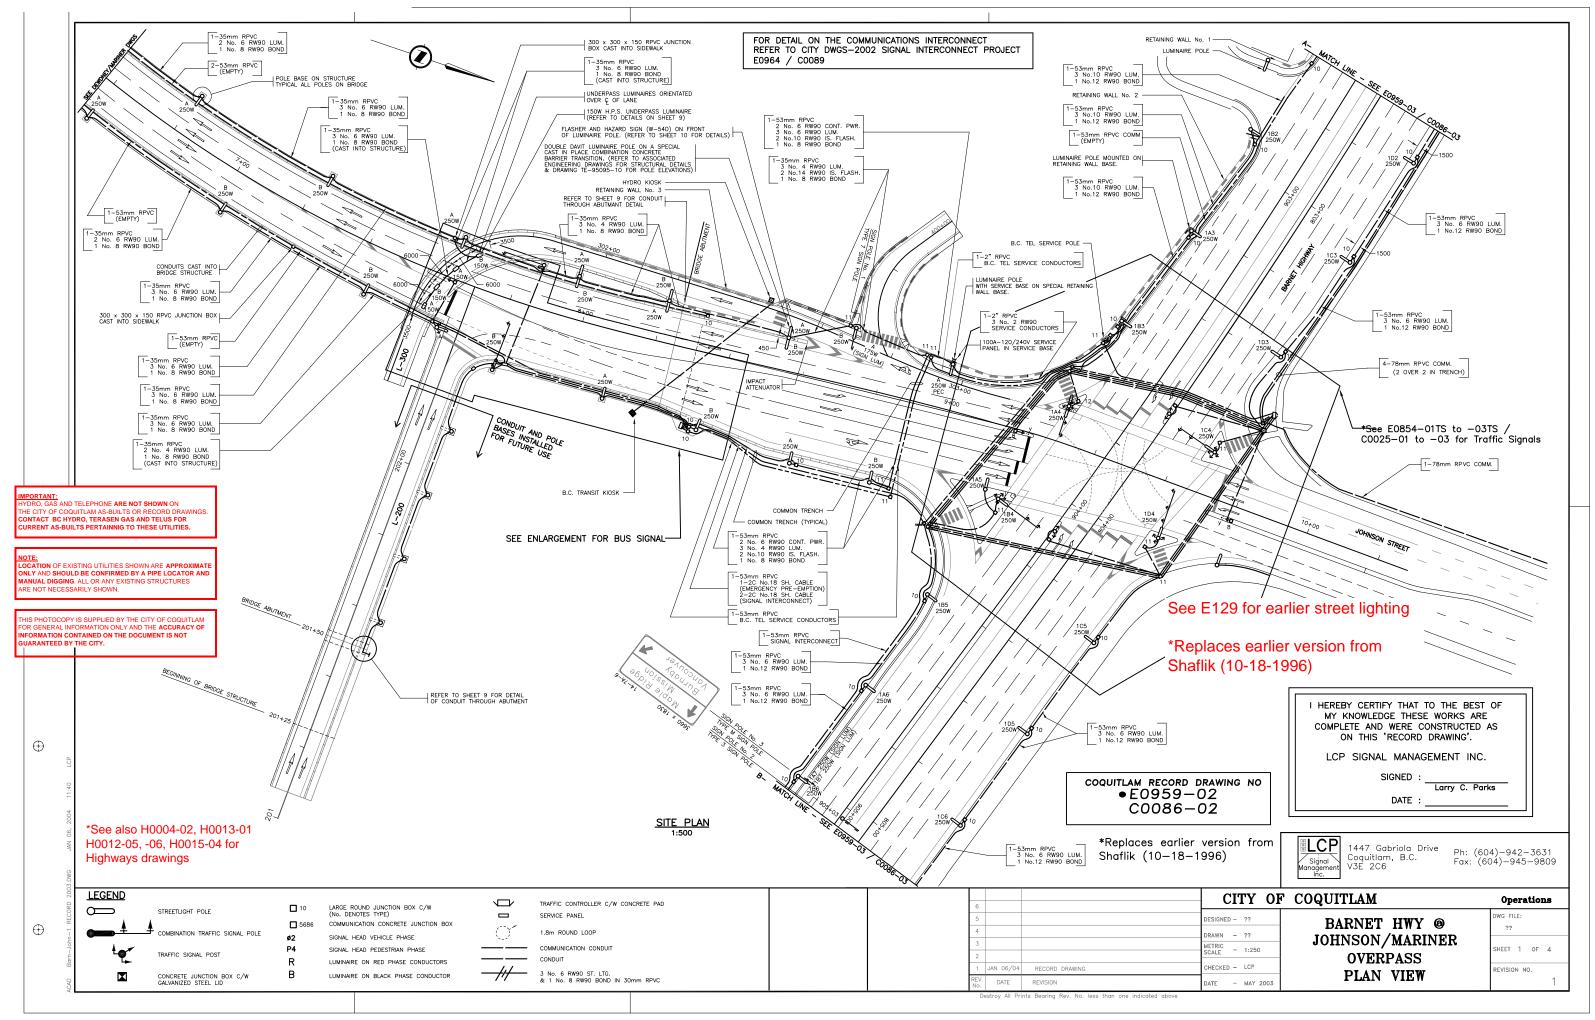

DRAINAGE AS-BUILT

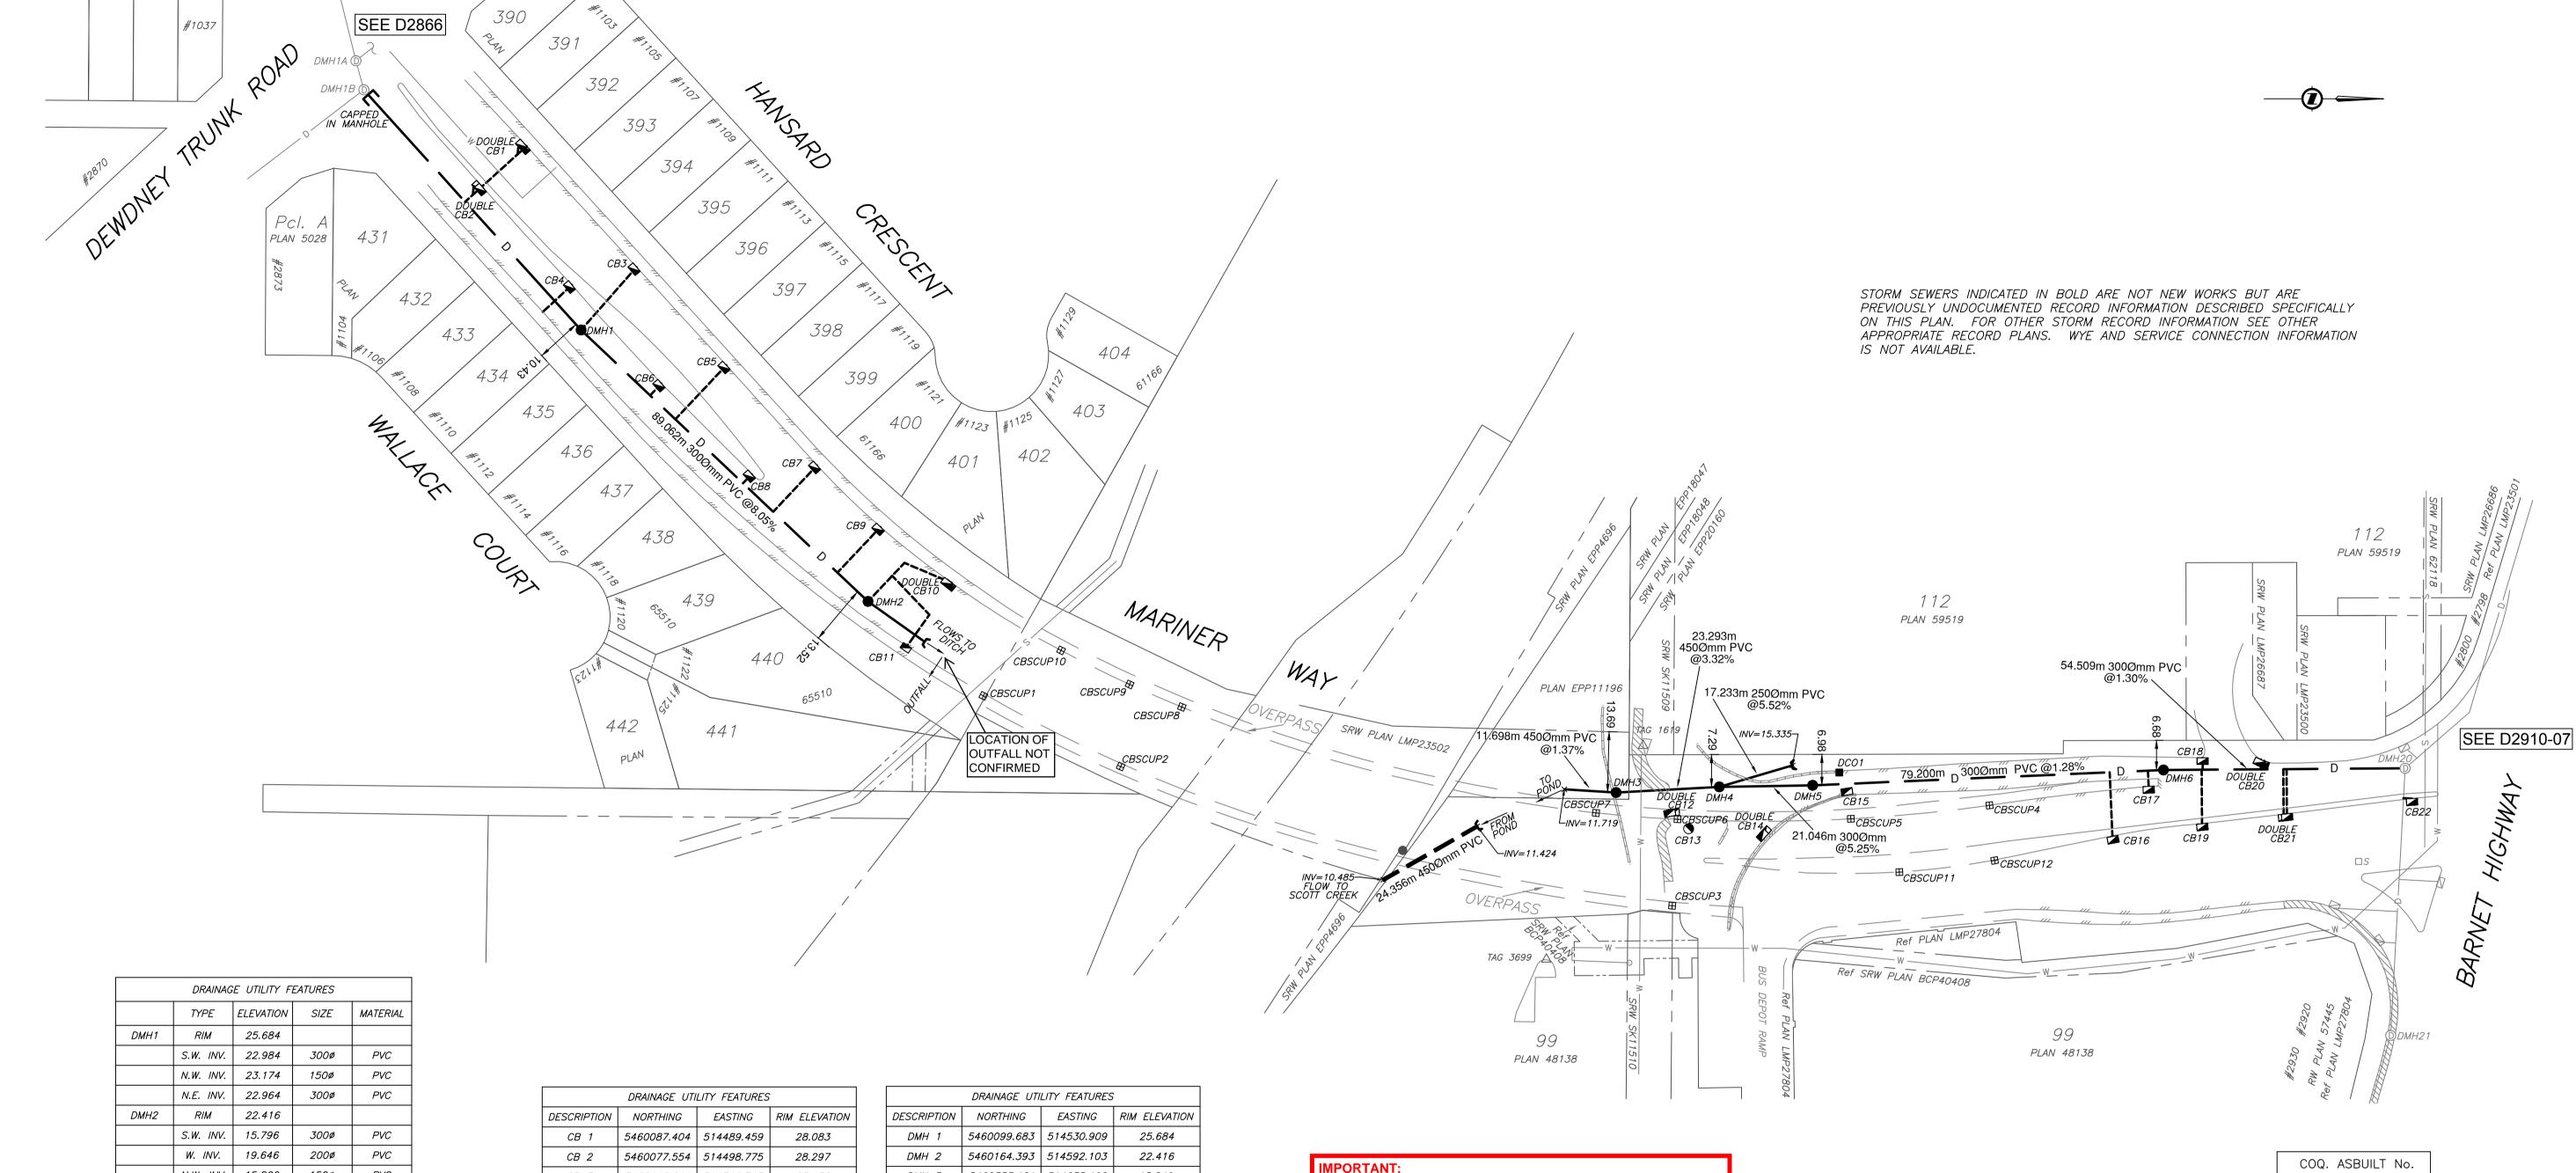

	TYPE	ELEVATION	SIZE	MATERIAL
DMH1	RIM	25.684		
	S.W. INV.	22.984	300ø	PVC
	N.W. INV.	23.174	150ø	PVC
	N.E. INV.	22.964	300ø	PVC
DMH2	RIM	22.416		
	S.W. INV.	15.796	300ø	PVC
	W. INV.	19.646	200ø	PVC
	N.W. INV.	15.866	150ø	PVC
	N.E. INV.	15.736	300ø	PVC
DMH3	RIM	15.849		
	W. INV.	13.369	250ø	PVC
	N. INV.	11.889	450ø	PVC
	S. INV.	11.879	450ø	PVC
DMH4	RIM	15.873		
	W. INV.	12.663	450ø	UNKNOWN
	N.W. INV.	14.383	250ø	PVC
	N. INV.	12.693	300ø	UNKNOWN
	E. INV.	12.853	300ø	PVC
	S. INV.	12.663	450ø	PVC
DMH5	RIM	15.968		
	N. INV.	13.808	300ø	PVC
	E. INV.	13.808	250ø	UNKNOWN
	S. INV.	13.798	300ø	UNKNOWN
DMH6	RIM	17.871		
	N. INV.	14.841	300ø	PVC
	S. INV.	14.821	300ø	PVC
DMH20	RIM	18.022		
	N.W. INV.	15.622	300ø	PVC
	E. INV.	15.582	250ø	PVC
	S. INV.	15.552	300ø	PVC

DRAINAGE UTILITY FEATURES						
DESCRIPTION	NORTHING	EASTING	RIM ELEVATION			
CB 1	5460087.404	514489.459	28.083			
CB 2	5460077.554	514498.775	28.297			
CB 3	5460112.211	514516.713	25.458			
CB 4	5460097.634	514520.749	26.134			
CB 5	5460132.458	514538.858	23.687			
CB 6	5460117.802	514542.967	24.307			
CB 7	5460152.913	514561.413	22.465			
CB 8	5460138.176	514563.382	23.027			
CB 9	5460167.206	514575.325	22.043			
CB 10	5460183.284	514587.891	21.950			
CB 11	5460172.934	514602.553	22.473			
CB 12	5460346.193	514640.412	15.672			
CB 13	5460349.452	514643.339	15.457			
CB 14	5460367.318	514644.573	15.506			
CB 15	5460385.274	514635.718	16.182			
CB 16	5460445.052	514645.077	18.343			
CB 17	5460453.209	514633.810	17.944			
CB 18	5460465.389	514627.338	17.681			
CB 19	5460465.252	514642.199	17.965			
CB 20	5460478.512	514627.724	17.669			
CB 21	5460483.660	514640.078	17.855			
CB 22	5460512.574	514636.543	18.148			

	DIVAINAGE OIT	LIII I LATONLS	
DESCRIPTION	NORTHING	NORTHING EASTING	
DMH 1	5460099.683	514530.909	25.684
DMH 2	5460164.393	514592.103	22.416
DMH 3	5460333.121	514635.190	15.849
DMH 4	5460356.378	514633.904	15.873
DMH 5	5460377.421	514633.552	15.968
DMH 6	5460456.545	514630.093	17.871
DMH 20	5460511.053	514629.711	18.022
DMH 21	5460507.810	514689.939	18.679

	DRAINAGE UTIL	LITY FEATURES	
DESCRIPTION	NORTHING	EASTING	RIM ELEVATION
CB SCUP 1	5460190.420	514613.383	22.607
CB SCUP 2	5460221.384	514629.308	23.396
CB SCUP 3	5460345.763	514660.689	23.409
CB SCUP 4	5460417.332	514638.071	19.142
CB SCUP 5	5460386.052	514641.103	20.941
CB SCUP 6	5460346.975	514641.205	22.860
CB SCUP 7	5460328.566	514639.774	23.396
CB SCUP 8	5460235.175	514615.894	23.089
CB SCUP 9	5460223.401	514610.805	22.746
CB SCUP 10	5460207.936	514603.125	22.249
CB SCUP 11	5460396.992	514653.111	20.665
CB SCUP 12	5460418.471	514650.490	19.436

IMPORTANT:
HYDRO, GAS, TELEPHONE AND CABLE ARE NOT SHOWN ON
THE CITY OF COQUITLAM AS-BUILTS OR RECORD DRAWINGS.
CONTACT BC HYDRO, FORTIS BC, TELUS AND SHAW FOR

CURRENT AS-BUILTS PERTAINING TO THESE UTILITIES.

NOTE:
LOCATION OF EXISTING UTILITIES SHOWN ARE
APPROXIMATE ONLY AND SHOULD BE CONFIRMED BY A PIPE
LOCATOR AND MANUAL DIGGING. ALL OR ANY EXISTING
STRUCTURES ARE NOT NECESSARILY SHOWN.

THIS PHOTOCOPY IS SUPPLIED BY THE CITY OF COQUITLAM FOR GENERAL INFORMATION ONLY AND THE ACCURACY OF INFORMATION CONTAINED ON THE DOCUMENT IS NOT GUARANTEED BY THE CITY.

NOTES:

SUPPLEMENTARY LEGEND

Catch basin, scup

1. ELEVATIONS ARE DERIVED FROM G.P.S. OBSERVATIONS. DATUM IS [CGVD28 (GVRD 2005)]

2. THIS PLAN SHOWS HORIZONTAL GROUND LEVEL MEASURED DISTANCES.
PRIOR TO COMPUTATION OF NAD83 U.T.M. COORDINATES MULTIPLY BY THE
COMBINED FACTOR 0.9995887. DATE OF SURVEY COMPLETION IS OCT 05,
2017.

FIELD WORK DONE BY RANDY COLOMBO

3. THE LOCATION OF EXISTING UNDERGROUND UTILITIES ARE INDICATED IN THE PUBLIC ROAD ALLOWANCE ONLY AND ARE SHOWN APPROXIMATE. THE CONTRACTOR SHALL DETERMINE THE EXACT LOCATION OF ALL EXISTING UTILITIES BEFORE COMMENCING WORK. BC ONE—CALL PROVIDES UNDERGROUND UTILITY LOCATIONS (1—800—474—6886).

4. BASEMAP WAS IMPORTED FROM CITY OF COQUITLAM G.I.S. COORDINATE GEOMETRY. ACCURACY IS ESTIMATED AT ± 0.15 m.

Edge of pavement		-	Sanitary service—
Watermain and valve	———————Water air valve		Sanitary cleanout
Drainage sewer, MH		\Diamond	Utility pole(joint p
Drainage ditch — —	——— Water service———	₩	Utility pole with li
Sanitary sewer, MH	——————————————————————————————————————		Streetlight, davit
Sanitary forcemain	——————————————————————————————————————		Streetlight, post t
Gasmain and valve	—————————————————————————————————————	\oslash	Comb signal pole
Hydro duct, MH	——————————————————————————————————————	Ð	Traffic signal pole
Telephone duct, MH	────────────────────────── T ─── Drainage cleanout		Junction box

DCO1 RIM 18.109

Canitary service———	
Canitary cleanout	
tility pole(joint pole) 🗢	
Itility pole with light 💝	
treetlight, davit ⊶	
treetlight, post top 🜼	
`omb signal pole ®─▽	
raffic sianal pole 🌵	

Hydro Guy Wire

Hydro Kiosk

Vegetation Conifer

Vegetation Deciduous

Vegetation Shrub

Survey Traverse Hub

Survey Iron Pin

Survey Lead Plug

Survey Monument

1	$\overline{}$		1	
١	\dashv		+	
۱	\dashv			
١				
١				
l	No.	Date	Ву	Revisions

	Design by	Date
Ш	Drawn by L.P.	Date 30-NOV-2017
	Checked by	Date
	Approved by	Date



Engineering & Public Works
3000 Guildford Way, Coquitlam, B.C. V3B 7N2

Scale horiz.	1:750	Scale vert.
Sheet of	1	1
Eng. Pro	ject No.	

MARINER WAY - DEWDNEY
TRUNK ROAD TO BARNET HWY

Description Storm Sewer

File: 17Mariner07212130A0

Appendix C -

Archaeological Chance Find Procedures

Archaeological Chance Find Procedures City of Coquitlam

DRAFT 2

November 2021 (version 2)



Table of Contents

Introduction	3
Purpose	3
Archaeological Sites in British Columbia	4
HCA Legislation and Policies	4
First Nation Cultural Heritage Management	4
Potential to Encounter Archaeological Sites	6
Types of Archaeological Sites	6
Archaeological Chance Find Procedure	6
Archaeological Chance Find Procedure - Suspected Ancestral (Human) Remains	7
Management Options	7
Best Practices for CFP Implementation	8
Contact List	10
Archaeological Site and Materials Identification	10
Artifacts	10
Beads	12
Indigenous Historical Artifacts	12
Hearths	13
Fire-Altered Rock	13
Shell and Non-Shell Midden	14
Surface Features	15
Rock Shelters and Caves	15
Ancestral (Human) Remains	15
Petroglyphs and Pictographs (Rock Art)	16
Fish Weirs and Traps	17
Wet Sites	17
Culturally Modified Trees (CMTs)	18
Additional Resources	19
References Cited	10

Introduction

This document is presented as an accompaniment to Kwikwetlem Cultural Heritage and Archaeology Chance Find Procedures training provided by Brown & Oakes Archaeology to City of Coquitlam (or the "City") staff and contractors.

The Chance Find Procedure (CFP) is intended to provide City planners and onsite project personnel guidelines for the appropriate response to an unanticipated discovery of known or suspected archaeological or cultural heritage materials during City operations. A CFP is NOT a substitute for professional archaeological assessment of project areas considered to hold archaeological potential. Thorough archaeological assessment will always reduce project risk of harms to protected archaeological sites and minimize the potential for encountering unanticipated material. This CFP training is intended to promote the preservation and proper management of heritage resources that are unexpectedly encountered during City activities.

The document presents a summary of archaeology site protection legislation, steps to follow in the case of suspected or observed archaeological materials, a list of appropriate authorities to contact in the case of archaeological site encounters, and a guide to archaeological site and materials recognition. Information on Kwikwetlem culture history and connections to traditional lands is not presented in this document and this information is best shared via virtual or in-person presentations.

Purpose

The purpose of CFP documentation is to aid in the protection and proper management of archaeological materials encountered during City of Coquitlam activities. Many land-altering activities have the potential to expose and/or negatively impact undocumented archaeological materials.

The purpose of this document is to:

- Ensure project personnel are aware that undocumented archaeological sites are likely to be present in the City of Coquitlam.
- Promote awareness of activities that may lead to the exposure of archaeological materials, including excavations, vegetation clearing, field survey and inspections, and more.
- Provide personnel the appropriate steps to follow if suspected or observed archaeological resources are encountered during work or personal activities.
- Provide education and resources to assist recognition of archaeological site types and materials in the lower Fraser River region.

Archaeological Sites in British Columbia

Archaeological sites are places that exhibit physical evidence of past human activity. Archaeological sites in British Columbia are automatically protected under the *Heritage Conservation Act* (HCA) when located on provincial, crown, municipal, or private land¹. The vast majority of archaeological sites in BC include places and belongings of Indigenous peoples. Some post-1846 sites related to newcomer history may also be registered and protected under the HCA if of significance to a place, industry, or region, for example. HCA protection is extended to ship and plane wrecks more than 2 years old.

Many First Nations consider the widely accepted definition of an archaeological site as a place featuring only the material remains of human activity too restrictive and instead advocate for the recognition and protection of a wider range of "cultural heritage" site types, including places of spiritual significance, named locales, known travel routes, and other places of cultural value.

The majority of the City of Coquitlam has not been surveyed for archaeological sites and it is reasonable to expect that many archaeological sites are buried and/or undetected. These sites are collectively referred to as undocumented archaeological sites.

HCA Legislation and Policies

Archaeological sites are automatically protected under the terms of the *Heritage Conservation Act* whether known or undocumented. Sites are protected whether previously disturbed by historic activities or intact. The HCA prohibits the alteration or disturbance of archaeological sites in whole or in part, on provincial public and private lands, whether impacts are intentional or inadvertent, and irrespective of previous land disturbance.

The HCA provides substantial penalties for the destruction or unauthorized disturbance of archaeological sites including imprisonment for up to two years and fines of up to \$1,000,000.

Alterations to archaeological sites may proceed under appropriate HCA permits held by professional archaeologists following provincial assessment guidelines². Work plans and methodologies related to archaeological site investigations must meet provincial regulatory standards and are expected to conform to participating First Nation cultural heritage policies and best-practice standards.

Archaeological materials on federally managed lands may be protected by other legislation and policies. Many federal agencies will adhere to the requirements outlined in the *HCA* when managing archaeological sites.

2021-09-15, vers. 1 Page 4

_

¹ http://www.for.gov.bc.ca/archaeology/index.htm.

² The HCA is administered by the Archaeology Branch, Ministry of Forests, Lands, Natural Resources and Rural Development.

First Nation Cultural Heritage Management

Many BC First Nations maintain cultural heritage policies and/or heritage permitting systems to assert oversight over Indigenous cultural heritage management and to ensure a high standard of archaeological practice. Contact should be made with locally affected Nations prior to any heritage study or project work with the potential to encounter cultural heritage materials to ensure adherence to Nation-preferred heritage protections, permits, and policy.

Potential to Encounter Archaeological Sites

Any project involving ground alterations has the potential to expose undocumented archaeological sites. Common forms of ground disturbances that have led to site discoveries include land grading, vegetation clearing/grubbing, excavation, asphalt/concrete removal, geotechnical drilling, access road or trail building, foundation demolition, heavy equipment movement, habitat planting, stream and pond channeling or dredging.

Other kinds of work activities where teams may encounter undocumented archaeological sites include field teams working in proximity to natural, undeveloped or minimally disturbed terrain. Teams involved in field surveys, field inspections, or inventories of natural ground and waterways, riparian areas, municipal parks and trails, forested areas, cut bank or erosion area, and so on may encounter exposed archaeological materials.

City workers or contractors engaged in any activity that may result in archaeological materials identification should be made aware of HCA site protection legislation and field supervisors properly versed CFP procedures.

Types of Archaeological Sites

The following site types are well-known across the lower Fraser River region and may be encountered in the City of Coquitlam. The following site types may contain a range of artifact types and sediment signatures.

- Stone tool sites containing isolated artifacts or accumulations of stone tool working debris
- Habitation sites show accumulations of food remains, tools, and evidence such as hearths
 indicating short term and seasonal camps and settlements used for travel and resource
 procurement as well as large and permanent villages.
- **Surface features** such as cultural depressions created by former habitations, earthen fortifications, burial mounds, and rock cairns.
- Wet sites contain preserved organic materials like woven basketry or wood tools in addition to other cultural material; these sites form under special preservation conditions typically anaerobic water saturated sediments along waterways and floodplains.
- Culturally Modified Trees (CMTs) include bark stripped trees, planks, and territory markers.
- Rock art including pictographs (painted rock images) and petroglyphs (images carved or pecked into rockfaces or boulders).

Archaeological Chance Find Procedure

In the event of found or suspected archaeological material, follow the procedures outlined below.

STEP 1: WATCH for potential archaeological materials

- ⇒ Know that undocumented archaeological sites are expected throughout Coquitlam.
- ⇒ Know that archaeological materials are protected by law and must be reported.
- ⇒ If you believe you may have encountered archaeological materials (either intact or disturbed) follow the steps outlined below.

STEP 2: STOP work in proximity to the material

- ⇒ If known or suspected archaeological materials are encountered, STOP work in the immediate vicinity.
- ⇒ Do not disturb, move, relocate, or collect the material.

STEP 3: REPORT observed materials

- ⇒ Alert the site supervisor that suspected archaeological materials have been observed.
- ⇒ The site supervisor will ensure appropriate contact is made with City managers who will in turn reach out to archaeological professionals.

STEP 4: CONTACT archaeological professionals

- ⇒ Seek immediate advice from an archaeological professional.
- ⇒ Teams may be advised to protect the area with flagging or cones until the area can be assessed by the appropriate representative.
- ⇒ Teams may be requested to provide locational details or photographs of the material.

STEP 5: AWAIT advisement

- ⇒ Wait for instructions from the appropriate representative; do not begin ground disturbing work until cleared to do so.
- ⇒ Prepare and submit an incident report to ensure compliance with appropriate regulators and interest groups.

Archaeological Chance Find Procedure - Suspected Ancestral (Human) Remains

In the event of found or suspected human remains, follow the procedures outlined below*.

- **STEP 1: STOP** all activity at the job site immediately, including the removal of backfill. Do not rebury the remains.
- STEP 2: REPORT to the City Project Manager. The Project Manager will contact an archaeological professional and determine the appropriate course of action. In most cases, the archaeology professional will visit the site to determine if the materials are reasonably expected to be human and archaeological. If warranted, the consultant will notify the Archaeology Branch and the RCMP, the Office of the Coroner, and affected First Nations. The Coroner will affirm whether the remains are archaeological and not of forensic concern. The archaeologist will inform the Archaeology Branch and First Nations will be consulted to determine culturally appropriate handling protocols and subsequent project management options.
- **STEP 3: PROTECT** the affected location with flagging or cones to prevent additional disturbance and for privacy. Do not photograph the material.
- **STEP 4: TREAT** the remains with dignity and respect. Do not allow bystanders to take photographs or video.
- STEP 5: AWAIT advisement.
- * If it is reasonable to think the human remains are not archaeological but forensic in nature, an immediate call to the RCMP is required.

Management Options

If determined that an archaeological or cultural heritage site (intact or disturbed) is present, an archaeologist will coordinate communications with the City, local affected First Nations, and the Archaeology Branch to evaluate management options. Archaeology Branch and First Nations approval and additional permitting may be required prior to the implementation of management options.

Examples of potential management options are provided below. Options will vary based on site characteristics, proponent needs, and Archaeology Branch and First Nation requirements.

Option A: Site avoidance through project redesign or relocation. Site avoidance is always preferred. Avoidance minimizes impacts to irreplaceable archaeological sites and reduces cost and schedule impacts.

Option B: Systematic data recovery through controlled archaeological excavation or other method. Data recovery is destructive to archaeological sites and will entail consideration of costs and schedule coordination.

Option C: Monitoring of construction activities by a professional archaeological team. Monitoring is appropriate where project impacts cannot be evaluated before construction (due to impenetrable surfaces or underground facilities, for example) or where potential to encounter archaeological materials is present following impact assessment or systematic data recovery.

Best Practices for CFP Implementation

- A Chance Find Procedure is best applied as an outcome stemming from archaeological assessment – as a last step verification that archaeological materials have not been overlooked in project area assessments, or where there is a professional assessment that documents a low expectation for encountering archaeological materials in a work area.
- A Chance Find Procedure is not an acceptable replacement for a professional archaeological overview (AOA) or archaeological impact assessment (AIA) or a welldesigned and implemented archaeological construction monitoring plan for many areas. Engagement with professional archaeological teams, affected First Nations, or the Archaeology Branch will assist in appropriate heritage study approaches.
- Chance Find Procedure training must be delivered by professional archaeologists and local area First Nations who wish to contribute to CFP presentations.
- Chance Find Procedures should be summarized regularly as part of job or project requirements, and CFP training repeated by the archaeological and First Nation team for new employees, project teams, and subcontractors.
- Chance Find Procedures do not supersede any requirements or policies pertaining to cultural heritage management by First Nations with interests in the area. Proponents are encouraged to seek input from interested First Nations on area-specific CFPs as part of any project engagement process.

Contact List

Archaeology Branch

Paula Thorogood	Planning and Assessment Manager	250-953-3300	Paula.Thorogood@gov.bc.ca
Nathan Friesen	Planning and Assessment Supervisor	250-953-3306	Nathan.P.Friesen@gov.bc.ca
City of Coquitlam			
Main Reception		604-927-3000	
Police and Coroner			
RCMP (Non-emergency)	Coquitlam	604-945-1550	
BC Coroners Service	Lower Mainland Region	604-660-7708	
Area First Nations			
Kwikwetlem First Nation		604-540-0680	
Katzie First Nation		604-465-8961	
Kwantlen Nation		604-888-2488	
Musqueam Indian Band		604-263-3261	
Stó:lō Nation		604-824-2420	
Tsleil Waututh Nation		604-929-3454	

Archaeological Site and Materials Identification

The following archaeological sites and artifacts are common to the lower Fraser River region. This guide is to assist in the recognition and protection of archaeological materials found by chance. If you identify any archaeological material, stop work immediately and contact a professional archaeologist.

Artifacts

Artifacts are objects made or modified by humans and may be formed of stone, bone, antler or wood. Bone, antler and wood tools were produced in abundance, but stone artifacts are the most common artifacts found in the lower Fraser region because of the preservation durability of stone. Bone and antler were fashioned into a variety of items, including needles, knives, points, jewelry, awls and scrapers. Wood was used to make implements like spoons and bowls, handles, ceremonial objects, canoes, houses, and much more.





Photo Credit: RBCM, Archaeology Collection. Antler and wood tools (https://learning.royalbcmuseam.bc.ca)

Stone tools common to this region include projectile points, knives, adzes (axes), scrapers, mauls (hammers), net weights, beads, and more. Archaeologists distinguish chipped stone from ground stone artifacts, each distinguished by the mode of manufacture, either flaking scars or grinding and polishing marks. Stone flakes or 'debitage' is produced during the process of making stone tools. These flakes were sometimes used as tools themselves or were left behind at the stone tool working site. Culturally produced debitage shows features distinctive from naturally broken rock, gravel or crush, but these signatures can be difficult to identify to an untrained eye. Stone artifacts were produced from dacite, quartzite, slate and nephrite as well as obsidian, chert, and other materials. Stone was acquired locally or transported or traded over long distances; high-quality materials like obsidian has been traced to locations from Prince Rupert to Oregon and beyond.

Artifacts may be found as isolated finds or in association with other cultural materials.



Photo Credit: B&OA, Chipped stone artifacts from Coquitlam Lake.



Photo Credit (left): B&OA, Nephrite ground stone adze from Port Coquitlam. Photo Credit (right): RBCM, Archaeology Collection. Ground stone hand mauls (https://learning.royalbcmuseam.bc.ca)



Photo Credit: B&OA, Stone tool debitage from BC Interior.

Beads

Beads were made from a variety of materials including stone, shell, bone and glass (in more recent times). Shell and stone disc beads were used in jewelry, regalia and in mortuary practices across the Northwest Coast. On the Lower Fraser it is most common to find stone beads at archaeological sites fashioned from mud or silt stone, slate, or other softer stone. At some burial sites, individuals of rank were laid to rest with thousands of stone and shell beads.



Photo Credit: B&OA, Ground stone beads from near Agassiz.

Indigenous Historical Artifacts

Indigenous use of European materials in the years following contact are often found in early historic sites. Ceramics, glass, and metal were valued for their strength, durability, ease of access, or aesthetic properties. Glass was worked using traditional stone tool techniques in the same way as obsidian (a natural volcanic glass). Clay pipes were adopted by Indigenous peoples who several centuries earlier had introduced the practice of tobacco smoking to European traders. Glass beads were used by European fur traders to trade with Indigenous peoples; trade beads were initially valued for their vibrant colour and the expectation of beads as a wealth item. Photo Credit (left): B&OA, Worked glass and clay stone pipe, Coquitlam.



Photo Credit (middle): https://www.canadashistory.ca/explore/fur-trade/tobacco-pipes. Photo Credit: Oregon Museum of Natural and Cultural History, Glass trade beads (https://mnch.uoregon.edu/index.php/collections-galleries).

Hearths

Hearths are the remnants of fires identifiable by dense black charcoal, ash and heat oxidized sediments. While natural forest fires may also leave traces of burning, hearths tend to be more defined and frequently show concave bases, evidence of repeated use, and contain or are in proximity to burned bone, fire-altered rock, and artifacts.

Fire-Altered Rock

Fire-altered rock (FAR) is rock modified by repeated heating and cooling. Heating small, rounded river cobbles and immersing the hot stones in water filled baskets or boxes was a frequently used cooking technique called 'stone boiling'. Heated stones were also used to warm clothing and bedding. The repeated heating and cooling of FAR created distinctive fracture and colour patterns that are easily distinguished from naturally broken rock. FAR shows irregular breakage patterns, is frequently deeply pitted, is often deep rust or black in colour, and may be found mixed in charcoal and ash laden sediments. As FAR is often found in abundance around settlement areas or near cooking features and hearths, it is a frequent first indicator of the presence of archaeological sites. Often mixed in FAR deposits are boiling stones—small, rounded pebbles that have not yet been fractured by thermal processes





Photo Credit: B&OA, Fire altered rock, Coquitlam.

Shell and Non-Shell Midden

Midden deposits are generally indicative of camp or village sites. Middens accumulate through the repeated, ongoing use of an area where food remnants or the debris of daily living build up in layers at a site over time. In coastal areas, shellfish provided an abundant food source and, middens contain abundant fragmented or whole shell typically embedded in dark, greasy, sediments rich in charcoal, ash, fire cracked rock, burnt materials, and artifacts. Because shell neutralizes the acidity in soil, shell middens enhance preservation of organic food remains and tools, and fish and mammal bone, wood, antler, and botanical remains are often well-preserved in shell midden sites.

Non-shell middens are accumulations of living materials formed at camps and settlements away from marine waterways. Non-shell midden shows layered deposits of dark sediments, ash, and sometimes sand and clay in sediments with little to no shell. These deposits rarely contain bone, antler, or wood remains due to poorer preservation environments.

In Coquitlam, non-shell middens are the more common site type but there are a few examples of inland shell midden sites associated with camps or settlements where shellfish was transported to locations by travel or trade.



Photo Credit (left): B&OA, Non-shell stratified midden Port Coquitlam. Photo Credit (right): Shell midden, Vancouver Island (https://learning.royalbcmuseum.bc.ca/pathways/can-)

Surface Features

Surface features are non-portable cultural formations visible on the landscape. Features may include pits or depressions, earthen mounds or rock cairns, petroforms (rock arrangements) or trails. Cultural depressions may indicate the location of semi-subterranean winter dwellings, plank houses where midden accumulated around the outside of structures, cache pits used for tool or food storage, or pits and trenches used for food cooking or processing. Cultural depressions are identifiable by their uniform shape (usually round or rectangular), a berm may be present around the edge of features, the presence of associated artifacts, or concentrations of charcoal, ash, and fire altered rock.

Cultural mounds or rock cairns are other familiar surface features. Earthen burial mounds and rock cairns are part of a mortuary tradition found throughout the lower Fraser region over the past 1,500 years. Cultural mounds and cairns range in size from around a meter in diameter to more than 12 meters across. Individual occurrences or clusters of well-formed oval or circular mounds of earth and rock should trigger archaeological assessment.



Photo Credit: SFU Museum, Winter pit house village, Lilloeet.

Rock Shelters and Caves

Rock shelters were used, among other purposes, as camps, spiritual or burial locations, and storage caches. Shelters can be found associated with overhangs of large boulders, indentations in rock bluffs or in caves. Shelters often associate with artifacts, rock art, and hearth features.

Ancestral (Human) Remains

Human remains are especially sensitive and significant finds. Any potential human bone requires immediate implementation of the CFP. Ancestral remains are frequently present at archaeological locations and may be found articulated in a burial context or as scattered fragments.

Petroglyphs and Pictographs (Rock Art)

Northwest Coast rock art includes images depicted on boulders, rock overhangs, rock faces, or other exposed rock surfaces. Pictographs are drawings or designs painted on rock using pigments like ochre or charcoal mixed with grease. Petroglyphs are images incised or pecked into stone. Designs vary widely and often depict animals, humans, or an extensive variety of geometric shapes.



Photo Credit: B&OA, Portion of petroglyph panel at Petroglyph Provincial Park, Nanaimo.



Photo Credit: B&OA, Portion of pictograph panel at Pitt Lake.

Fish Weirs and Traps

Fish weirs are structures constructed to funnel and trap fish for harvesting. Traps were built in intertidal areas along marine and river shorelines and near stream mouths. Weirs vary in form and structure depending on water and shoreline conditions, fish species targeted for harvest, intended volume of harvest, and community preferences. Fish weir sites are identifiable by linear or patterned arrangements of wooden stakes protruding from beach or bank edges or boulder alignments along waterways.



Photo Credit: Washington State Archives, Yelm Jim Fish Trap 1885 (http://www.digitalarchives.wa.gov/Record/View/DAA73FC7A57E989D65B6DBEA419FC89E)

Wet Sites

Wet sites are special preservation environments that form in low oxygen water saturated environments along waterways, in bogs and on floodplains. These locations permit enhanced preservation of organic artifacts like wood, bark, and botanicals. Artifacts found in wet sites have included basketry, twine and rope, wooden tools and weapons, architectural structures, and ceremonial implements made of wood and bone.





Photo Credit (left): Mike Blake. Ground slate knife with wooden handle, Agassiz. Photo Credit (right): Katherine Bernick, Waterlogged and preserved basket, Coquitlam.

Culturally Modified Trees (CMTs)

Culturally Modified Trees are trees that have been utilized by Indigenous Peoples for a broad range of cultural uses. Wood was used to build houses, canoes, tools, and weapons. Branches, boughs, and leaves were used to fashion tools, for medicine and in cultural ceremony. Harvesting cedar bark and roots was undertaken regularly to make clothing, cordage, basketry, and sleeping mats, ceremonial regalia, and much more.

Triangular bark stripped cedars are the most common form of CMT; a long, linear triangular bark scar will show where bark was removed from the trunk of a living tree. The exposed scar will heal over time creating a seam on the outer tree bark. This form of sustainable harvesting allowed the same tree to be used multiple times for bark harvesting. CMTs can also show evidence of wood removal where wedges were used to pry rectangular planks of wood from standing, living trees.

Logging and clearing throughout much of Coquitlam municipality reduces the chance that archaeological CMTs remain in most forested areas today, but more recent CMTs where bark or wood was harvested from second-growth forest by Kwikwetlem for cultural uses may be present.





Photo Credit: B&OA, Bark stripped cedars, Coquitlam.

Additional Resources

Learning Portal, Royal BC Museum - https://learning.royalbcmuseum.bc.ca
SFU Museum of Archaeology & Ethnology - https://www.sfu.ca/archaeology/museum.html

References Cited

Archaeology Branch (1999). Found Human Remains. On file with the Archaeology Branch, Victoria, BC. From http://www.tca.gov.bc.ca/archaeology/policies/found_human_remains.htm

Archaeology Branch (2010). Heritage Conservation Act (RSBC 1996). On file with the Ministry of Tourism, Culture, and the Arts, Victoria, BC. From